

Addendum No. 02

Project Name: Jordan Learning Center

Project No.: 2024528.00

Bid Package: 1

Addendum No. 01 to the Construction Contract for the above referenced project:

All Contractors submitting proposals on the above captioned project shall be governed by the following changes and explanations to the Bid Documents, dated August 29, 2024, and shall submit their bids in accordance therewith:

Issued: 9/13/2024

Changes to the Project Manual

- 2.1 Section 084113 Aluminum-Framed Entrances and Storefront
 - Replace this section with the attached section.
- 2.2 Section 087110 Door Hardware
 - Replace this section with the attached section.
- 2.3 Section 088700 Security Glazing Films
 - Replace this section with the attached section.
- 2.4 Section 107516- Ground-Set Flagpoles
 - Replace this section with the attached section.
- 2.5 Section 116800 Play Field Equipment and Structures
 - Replace this section with the attached section.
- 2.6 Section 133123 Tension Fabric Structures
 - Replace this section with the attached section.

2.7 Section 220000 - Plumbing

• Remove HB-4 from specifications.

2.8 Section 27 4100 AUDIOVISUAL SYSTEMS

• CHANGES TO SECTION 2.4 EQUIPMENT REQUIRED PER ROOM TYPE. CHANGE THE FOLLOWING EQUIPMENT SCHEDULES:

TODDLER & COMMUNICATION EQUIPMENT SCHEDULE

HD U	DIGITALINX 'ARK' SERIES AV ROOM KIT WITH 4 HDMI INPUTS, USB 2.0	LIBERTY/DIGITALINK X	DL-ARK-573-4HC-2W- KT
CH D	TRANSFER, AND SECONDARY HDMI / 3.5MM AUX INPUT.		
TxH / Rx	DIGITALINX HDMI WALL PLAYTE EXTENSION SET. DECORA WALL PLATE SET WITH REMOTE POWER	LIBERTY/DIGITALINK X	DL HD50C WPKT W
R4	1X2 EQUIPMENT RACK, ABOVE CEILING 2 RU, RECESSED	CHIEF	CMS491

CS	WIRELESS COLLABORATION DEVICE (OFCI)	VIVI VIVI PRO (OFCI)	
----	--------------------------------------	----------------------	--

LEARNING STUDIOS EQUIPMENT SCHEDULE

HD	IGITALINX 'ARK' SERIES AV ROOM KIT	LIBERTY/DIGITALINK	
U	WITH 4 HDMI INPUTS, USB 2.0	X	KT
KP3	TRANSFER,		
CH	CONTROLLER (KP3) AND		
D	SECONDARY		
	HDMI / 3.5MM AUX INPUT.		
TP5	TOUCH PANEL, 5.5" DIAGONAL, POE	QSC	TSC-50-G3
	WALL MOUNT		
TP7	TOUCH PANEL, 7" DIAGONAL, POE	QSC	TSC-70-G3
	WALL MOUNT		
	BLOWER PANEL, 1RU, 100 CFM, 32DB	MIDDLE ATLANTIC	QBP-2

SCIENCE/ART/CTE EQUIPMENT SCHEDULE

	SOIEITSE//TITT/ STE EGGII TIEITT	00:125022	
HD	IGITALINX 'ARK' SERIES AV ROOM KIT	LIBERTY/DIGITALINK	DL-ARK-573-4HC-2W-
U	WITH 4 HDMI INPUTS, USB 2.0	X	KT
KP3	TRANSFER,		
CH	CONTROLLER (KP3) AND		
D	SECONDARY		
	HDMI / 3.5MM AUX INPUT.		
TP7	TOUCH PANEL, 7" DIAGONAL, POE WALL MOUNT	QSC	TSC-70-G3

TxH	HDMI INPUT, WALL PLATE	EXTRON	DTP HDMI 4K 230 Tx
	WITH DTP TRANSMITTER		

4K/60 HDMI DTP2 RECEIVER WITH AUDIO DE EMBEDDING	E- E	CTRON	DTP HDMI 4K 230 Rx
MULTIPURPOSE/STUDENT COMMO	NS EQUIPMEI	NT SC	HEDULE (1 OF 2)
BLOWER PANEL, 1RU, 100 CFM, 32DB	MIDDLE ATL	ANTIC (QBP-2
POWER AMPLIFIER, 4 CHANNEL X 150 WATTS (600 TOTAL), 70V	POWERSOFT	MEZ	ZO 604 A
LOUDSPEAKER, 4", PENDANT 150 DEGREE COVERAGE	QSC	AD-F	P4T
			<u> </u>
MULTI I/O DANTE NETWORK WALL-PLATE. BLUETOOTH, 3.5MM I/O		QSC	UND6IO-BT
	MULTIPURPOSE/STUDENT COMMO BLOWER PANEL, 1RU, 100 CFM, 32DB POWER AMPLIFIER, 4 CHANNEL X 150 WATTS (600 TOTAL), 70V LOUDSPEAKER, 4", PENDANT 150 DEGREE COVERAGE MULTI I/O DANTE NETWORK WALL-PLATE.	MULTIPURPOSE/STUDENT COMMONS EQUIPMENT BLOWER PANEL, 1RU, 100 CFM, 32DB MIDDLE ATL POWER AMPLIFIER, 4 CHANNEL X 150 WATTS (600 TOTAL), 70V LOUDSPEAKER, 4", PENDANT 150 DEGREE COVERAGE QSC	MULTIPURPOSE/STUDENT COMMONS EQUIPMENT SC BLOWER PANEL, 1RU, 100 CFM, 32DB MIDDLE ATLANTIC POWER AMPLIFIER, 4 CHANNEL X 150 WATTS (600 TOTAL), 70V LOUDSPEAKER, 4", PENDANT 150 DEGREE COVERAGE MULTI I/O DANTE NETWORK WALL-PLATE. QSC

CONFERENCE / TESTING ROOMS/WAITING EQUIPMENT SCHEDULE

HD	HDMI PASS-THROUGH WALL PLATE	C2G	#39710 (PROVIDE DECORA COVER)
D75	FLAT PANEL DISPLAY, 75" DIAGONAL, UHD 24/7 OPERATION, 350 NIT	PANASONIC	TH-75EQ1U
Т	FLAT PANEL TILT MOUNT, 14°, MAX 200LBS LOAD, 878 X 500 mm VESA, LANDSCAPE	CHIEF	LTM1U

Prior Approvals

The following manufacturers, trade names, and products are approved with the provision that they shall completely satisfy all and every requirement of the Drawings, Specifications, and all Addenda, and shall conform to the design, quality, and standards specified, established, and required for the complete and satisfactory installation and performance of the building and all its respective parts.

XXX	Xxxx
XXX	Xxxx

Mechanical Prior Approvals

The following manufacturers, trade names, and products are approved with the provision that they shall completely satisfy all and every requirement of the Drawings, Specifications, and all Addenda, and shall conform to the design, quality, and standards specified, established, and required for the complete and satisfactory installation and performance of the building and all its respective parts.

Electric unit heater	Berko
Ceiling Exhaust fan	Broar

ELECTRICAL PRODUCT APPROVALS:

Pending compliance to all specified requirements, the following manufacturers are approved to bid this project in addition to those shown on the electrical drawings or the electrical

specifications. Approval does not relieve the contractor of fulfilling all specified requirements regardless of what is contained in the prior approval packages submitted by various lighting agencies to the electrical engineer. Light fixtures specified on drawings shall be considered basis-of-design products; all light fixtures approved by addendum shall be equivalent in every respect to those currently specified on the drawings. Non-compliance to these requirements may later result in disapproval in which case the contractor shall be required to provide specified products at no additional cost to the Owner:

<u>TYPE</u>	SPECIFIED	B26 APPROVED	QUANTUM APPROVED	SSCO APPROVED
3PC2	CSL LIGHTING	-	SENSO	LIGHTOLIER
4PRW	PRUDENTIAL LIGHTING	LUMENWERX	-	AXIS (FILL)
5PC4	CSL LIGHTING	-	SENSO	LIGHTOLIER
6LBP	BETA CALCO	CURRENT/LUMEN WERX	-	-
22LR	LITELINE	GREEN IMAGE TECH	METALUX	NORA
22MR	LITELINE	GREEN IMAGE TECH	METALUX	NORA
A4H	METALUX	ILP	-	DAY-BRITE
A4M	METALUX	ILP	-	DAY-BRITE
В2Н	METALUX	ILP	-	DAY-BRITE
B2M	METALUX	ILP	-	DAY-BRITE
CUR2	LUMENWERX	-	PMC LIGHTING	AXIS
CVL	XICO	-	OPTIC ARTS	MODA
D4A	PRESCOLITE	-	HALO	LIGHTOLIER
L2HP	LUMENWERX	-	NEO-RAY	AXIS
L2HPP	LUMENWERX	-	NEO-RAY	AXIS
L2MPD	LUMENWERX	-	NEO-RAY	AXIS
L2PRD	LUMENWERX	-	PRU-LITE	AXIS
L2VPD	LUMENWERX	-	NEO-RAY	AXIS
L4HD	METALUX	GREEN IMAGE TECH	-	SLG
L4MD	METALUX	GREEN IMAGE TECH	-	SLG
L8MD	METALUX	GREEN IMAGE TECH	-	SLG
OC13	FC LIGHTING	-	TGS	GARDCO (SVPG)
OFW	LIGMAN	LUMUX	-	LUMASCAPE
OLDH	Q-TRAN	ACOLYTE	-	OMNI
OP2	LITHONIA	EXO	McGRAW- EDISON	GARDCO
OP4	LITHONIA	EXO	McGRAW- EDISON	GARDCO

OP24	LITHONIA	EXO	McGRAW- EDISON	GARDCO
OP44	LITHONIA	EXO	McGRAW- EDISON	GARDCO
OW340	LITHONIA	BEACON	McGRAW- EDISON	HE WILLIAMS
PBS	ZANEEN	-	CONTRACTOR ALLOWANCE \$3,900.00	CONTRACTOR ALLOWANCE \$3,900.00
S8OC	VERSALED	GREENCREATIVE	LUMENCIA	NORA
SL4C	METALUX	COLUMBIA	-	DAY-BRITE
SLF	ACOLYTE	-	Q-TRAN	OMNI + (ANGLE MOUNTS)
X1	EMERGI-LITE	BEGHELLI	-	EXITRONIX

LIGHTING CONTROL APPROVALS:

- 1. Avi-on Labs, Inc.
- 2. Cooper Lighting Control

Changes to the Drawings

Civil

C2.1 None.

Landscape

L2.1 Sheet AS101

- Updated playground equipment from manufacturer.
- Updated specification numbers for synthetic grass surfacing and playground protective surfacing.
- Added specification numbers for playground equipment, fabric shade structure, and site furnishings.
- Added linework to show reference note E12- irrigation backflow preventer to be protected.
- Revised detail, related details, and specification columns on reference note schedule.

L2.2 Sheet AS501

- Added detail C3- Fabric Shade Structure
- Revised detail, related details, and specification columns on reference note schedule.

L2.3 Sheet LI101

- Keynote LI-07 added.
- Lateral lines added into existing parking lot islands.

L2.4 Sheet LI501

Updated to notes on detail C3.

L2.5 Sheet LP101

- Updated linework to show back flow in SW corner of landscape area.
- Updated planting in SW landscape area to go around shade structure poles.
- Added plant labels.
- Updated reference note schedule to include stone mulch over weed barrier fabric.
- Revised plant schedule to replace crataegus laevigata with cornus florida.
- Revised plant schedule to include correct size requirements for catalpa speciosa and crataegus laevigata.

L2.6 Sheet LP501

- Removed planting schedule from sheet.
- Revised details D1, D3, E2, E3, to have 3" mulch depth requirements.
- Refined planting notes.

Structural

S2.1 Sheet SB101A

- Added HSS setback tube column next to existing opening.
- Added size tag for exterior canopy column.

S2.2 Sheet SB101B

• Added HSS setback tube column next existing opening.

S2.3 Sheet SB502

• Updated detail A3 for added furring concrete wall.

S2.4 Sheet SF101A

• Added setback tube columns and HHS lateral support to the opposite side of the CMU wall for canopy.

S2.5 Sheet SF102B

• Added setback tube columns and HHS lateral support to the opposite side of the CMU wall for canopy.

S2.6 Sheet SF201

 Added the additional setback tube columns and HSS lateral support per SF101A and B.

S2.7 Sheet SF401

Reflected the additional HSS lateral Support on Detail C1

S2.8 Sheet SF503

• Updated detail A3 and A4 to reflect the HSS lateral support on the opposite side of CMU wall to the canopy framing with through bolt embed connections.

S2.9 Sheet SF504

- Updated detail C3 to include HSS lateral support end connections.
- Revised references on details D1 and D2.

Architectural

A2.1 Sheet A101A

• Revised Drawing to show Callouts to added Details D1/A333 & E1/A333

A2.2 Sheet A333

Added Details B1/A333, D1/A333 & E1/A333

A2.3 Sheet A400

- Removed duplicate Seat Cover Dispensers from E1, E2, E3, D2 & D3. See attached revised drawing.
- Sink location shifted 6" to the North in WOMENS A149.
- Paper Towel Dispenser has been added to WOMENS A149 and MENS 150.

A2.4 Sheet A412

- Modified cabinet to include perforated metal panel in door from. See attached revised drawing C1/A412
- Revised Legend
- Sheet A412
- Sheet A412

A2.5 Sheet A600

Door B122: Revised to aluminum door and frame. Revised HW Set.

A2.6 Sheet A620

Revised GLAZING LEGEND. See the attached revised sheet A620.

A2.7 Sheet A640A

• Finish PL4 has been removed from the Countertop Finish Column at rooms A102 and A139.

Mechanical

Plumbing

P3.1 Sheet P401

- Piping in Room A145 is now showing
- Reference Note # 13 Remove reference to 'HB-4' and install per Detail 1/P603.

P3.2 Sheet P402

• Reference Note # 9 - Remove reference to 'HB-4' and install per Detail 1/P603.

P3.3 Sheet P501

• Remove HB-4 hose bibb from schedule.

Electrical

- E2.1 Sheet E001 (Update Sheet Attached)
 - Refer to the floor box schedule. Change both the FB01 and FB02 to a fourcompartment box, Wiremold Series RFBA4 (or equal). The descriptions in each remain the same.
- E2.2 Sheet E002 (Update Sheet Attached)
 - Lighting Fixture Schedule:
 - Fixture Type 5PC4- Revise Lumen Output from 4252 LM/FT to 2100 LM/FT. Revise wattage from 50W/FT to 25W/FT
 - Fixture Type L2VPD Revise Lumen Output from 1000 LM/FT to 900 LM/FT. Revise wattage from 11W/FT to 10W/FT
 - o Fixture Type S8OC Revise Voltage from 277V to 120V
- E2.3 Sheet E211A (Update Sheet Attached)
 - Storage A126; Circuit fixture type S8OC to 120V circuit L2-7.
 - Storage A116; Circuit fixture type S8OC to 120V circuit L6-21.
- E2.4 Sheet E21BA (Update Sheet Attached)
 - Storage B110; Circuit fixture type S8OC to 120V circuit L5-8.
 - Storage B115; Circuit fixture type S8OC to 120V circuit L5-4.
- E2.5 Sheet E311A (Update Sheet Attached)
 - Teacher Team A122. Change the circuit numbers on the four-plex receptacles along the west wall to L3-22 and 24, evenly distributed. Change the circuit numbers on the four-plex receptacles along the east wall to L3-28 and 30, evenly distributed. Change the circuit numbers on two of the four-plex receptacles along the south wall to L3-26.
 - Coach Team A139. Provide a 2 drop data outlet at the DP. Connect the DP to circuit L1-3.
 - Custodial A143. Provide a wireless access point.
 - Sensory A111. Provide a 2 drop data outlet adjacent to the duplex receptacle on the east wall.
- E2.6 Sheet E311B (Update Sheet Attached)
 - Student Commons B122. Provide a 2 drop data outlet adjacent to the duplex receptacle at Grid 4F. Provide a 2 drop data outlet adjacent to the duplex receptacle at Grid 4E.1.
 - Lobby B100. Provide a 2 drop data outlet adjacent to the duplex receptacle on the opposite side of the wall from Reception B103. Provide a DP for the monitor on the same wall with a 2 drop data outlet and connect the DP to circuit L5-15.

- Tech Specialist B101. Add four duplex receptacles on the south wall, evenly spaced, connect two to circuit L7-2 and two to circuit L7-4. Add two duplex receptacles on the east wall and connect to circuit L7-6. Verify the height of all outlets in this room with the shelving and the work surface.
- Provide a total of three data drops at the ATC panel in Mech B134.
- Provide two wireless access points in Teacher Team B128 at quarter points the length of the room.
- Provide a 2 drop data outlet in the sound rack located in Multipurpose B119.

E2.7 Sheet E360 (Update Sheet Attached)

- Switchboard 'MDP'. Delete the type 44-X feeder feeding nothing. The unmarked 225A beaker is spare. The 125A LSI breaker feeding ATS-1 is a 225A LSI breaker. Do not feed the ATS-1 with that breaker.
- Provide a 150A 3Pole LSI breaker (3VA61) in a 225A space. Provide a type 44 (copper) feeder to ATS-1. Change the feeder from the generator to ATS-1 to a type 44 (copper). Change the feeder from ATS-1 Panel 'EHL' back to a type 44 (copper).
- Change the 125A breaker in the generator to 60A. Change the generator to a 20KW.
- Feed panelboard 'L7' with the 225A Breaker not labeled. Provide a type 450 aluminum feeder.
- For the CT/MAIN SWITCH (MS), MDP and LDP, replace all labeling that is not correct and provide new labeling that reflects the designations shown.
- Set the trip rating of the 1600A main circuit breaker in 'LDP' to 1200A. the trip unit part number is PD63T120.
- Delete the reference to sheet keynote 6 for Panelboards 'L1' and 'L2'.

E2.8 Sheet E372 (Update Sheet Attached)

• Refer to attached drawing for requirements of Panelboard 'L7'.

E2.9 Sheet E411A (Update Sheet Attached)

• Provide cable tray to tee off the tray above Records A104 and extend east above the ceiling along Grid D.1 to the wall of Reception A154.

E2.10 Sheet E411B (Update Sheet Attached)

- Teacher Team B128. Reroute the cable tray to avoid running through the sky lights.
- Provide (2) 4" conduits from the end of the cable tray adjacent to Reception B103 above the ceiling of Lobby B100 to the tray in Reception A154.

E2.11 Sheet T002

• Delete "Low Voltage Scope of Work" Schedule. Refer to plans and specifications for scope of work.

E2.12 Sheet T223 (Update Sheet Attached)

- Change Learning Studio B123 Diagram Callout V254/T701 to V259/T701.
- Add Diagram Callout 1/T501 to Conference B118.
- Added 75" display to Lobby B100
- E2.13 Sheet T224 (Update Sheet Attached)
 - Added rack 'R4' to Toddler and Communication Rooms
- E2.14 Sheet T225 (Update Sheet Attached)
 - See clouded changes.
- E2.15 Sheet T311 (Update Sheet Attached)
 - Add intercom loudspeaker "IC4" to OFFICE A152
- E2.16 Sheet T501 (Update Sheet Attached)
 - Update racks 'R1' and 'R2 to include Blower Panels, and Amplifier 1E
- E2.17 Sheet T700 (Update Sheet Attached)
 - Updated Diagram V301
- E2.18 Sheet T701 (Update Sheet Attached)
 - Added Diagram V250
 - Updated Diagram V102

Attachments

Project Manual:

084113, 087100, 088723, 107516, 116800, 133123

Drawings:

Landscape

AS101, AS501, LI101, LI501, LP101, LP501

Structural

SB101A, SB101B, SB502, SF101A, SF101B, SF201, SF401, SF503, SF504

<u>Architectural</u>

A101A, A333, A400, A412, A600, A620, A640A


Mechanical

P401


Electrical

E001, E002, E101, E211A, E211B (Addendum 1), E311A, E311B, E360, E370 (Addendum 1), E371 (Addendum 1), E372, E411A, E411B, T223, T224, T225, T311, T501, T700, T701

End of Addendum 02

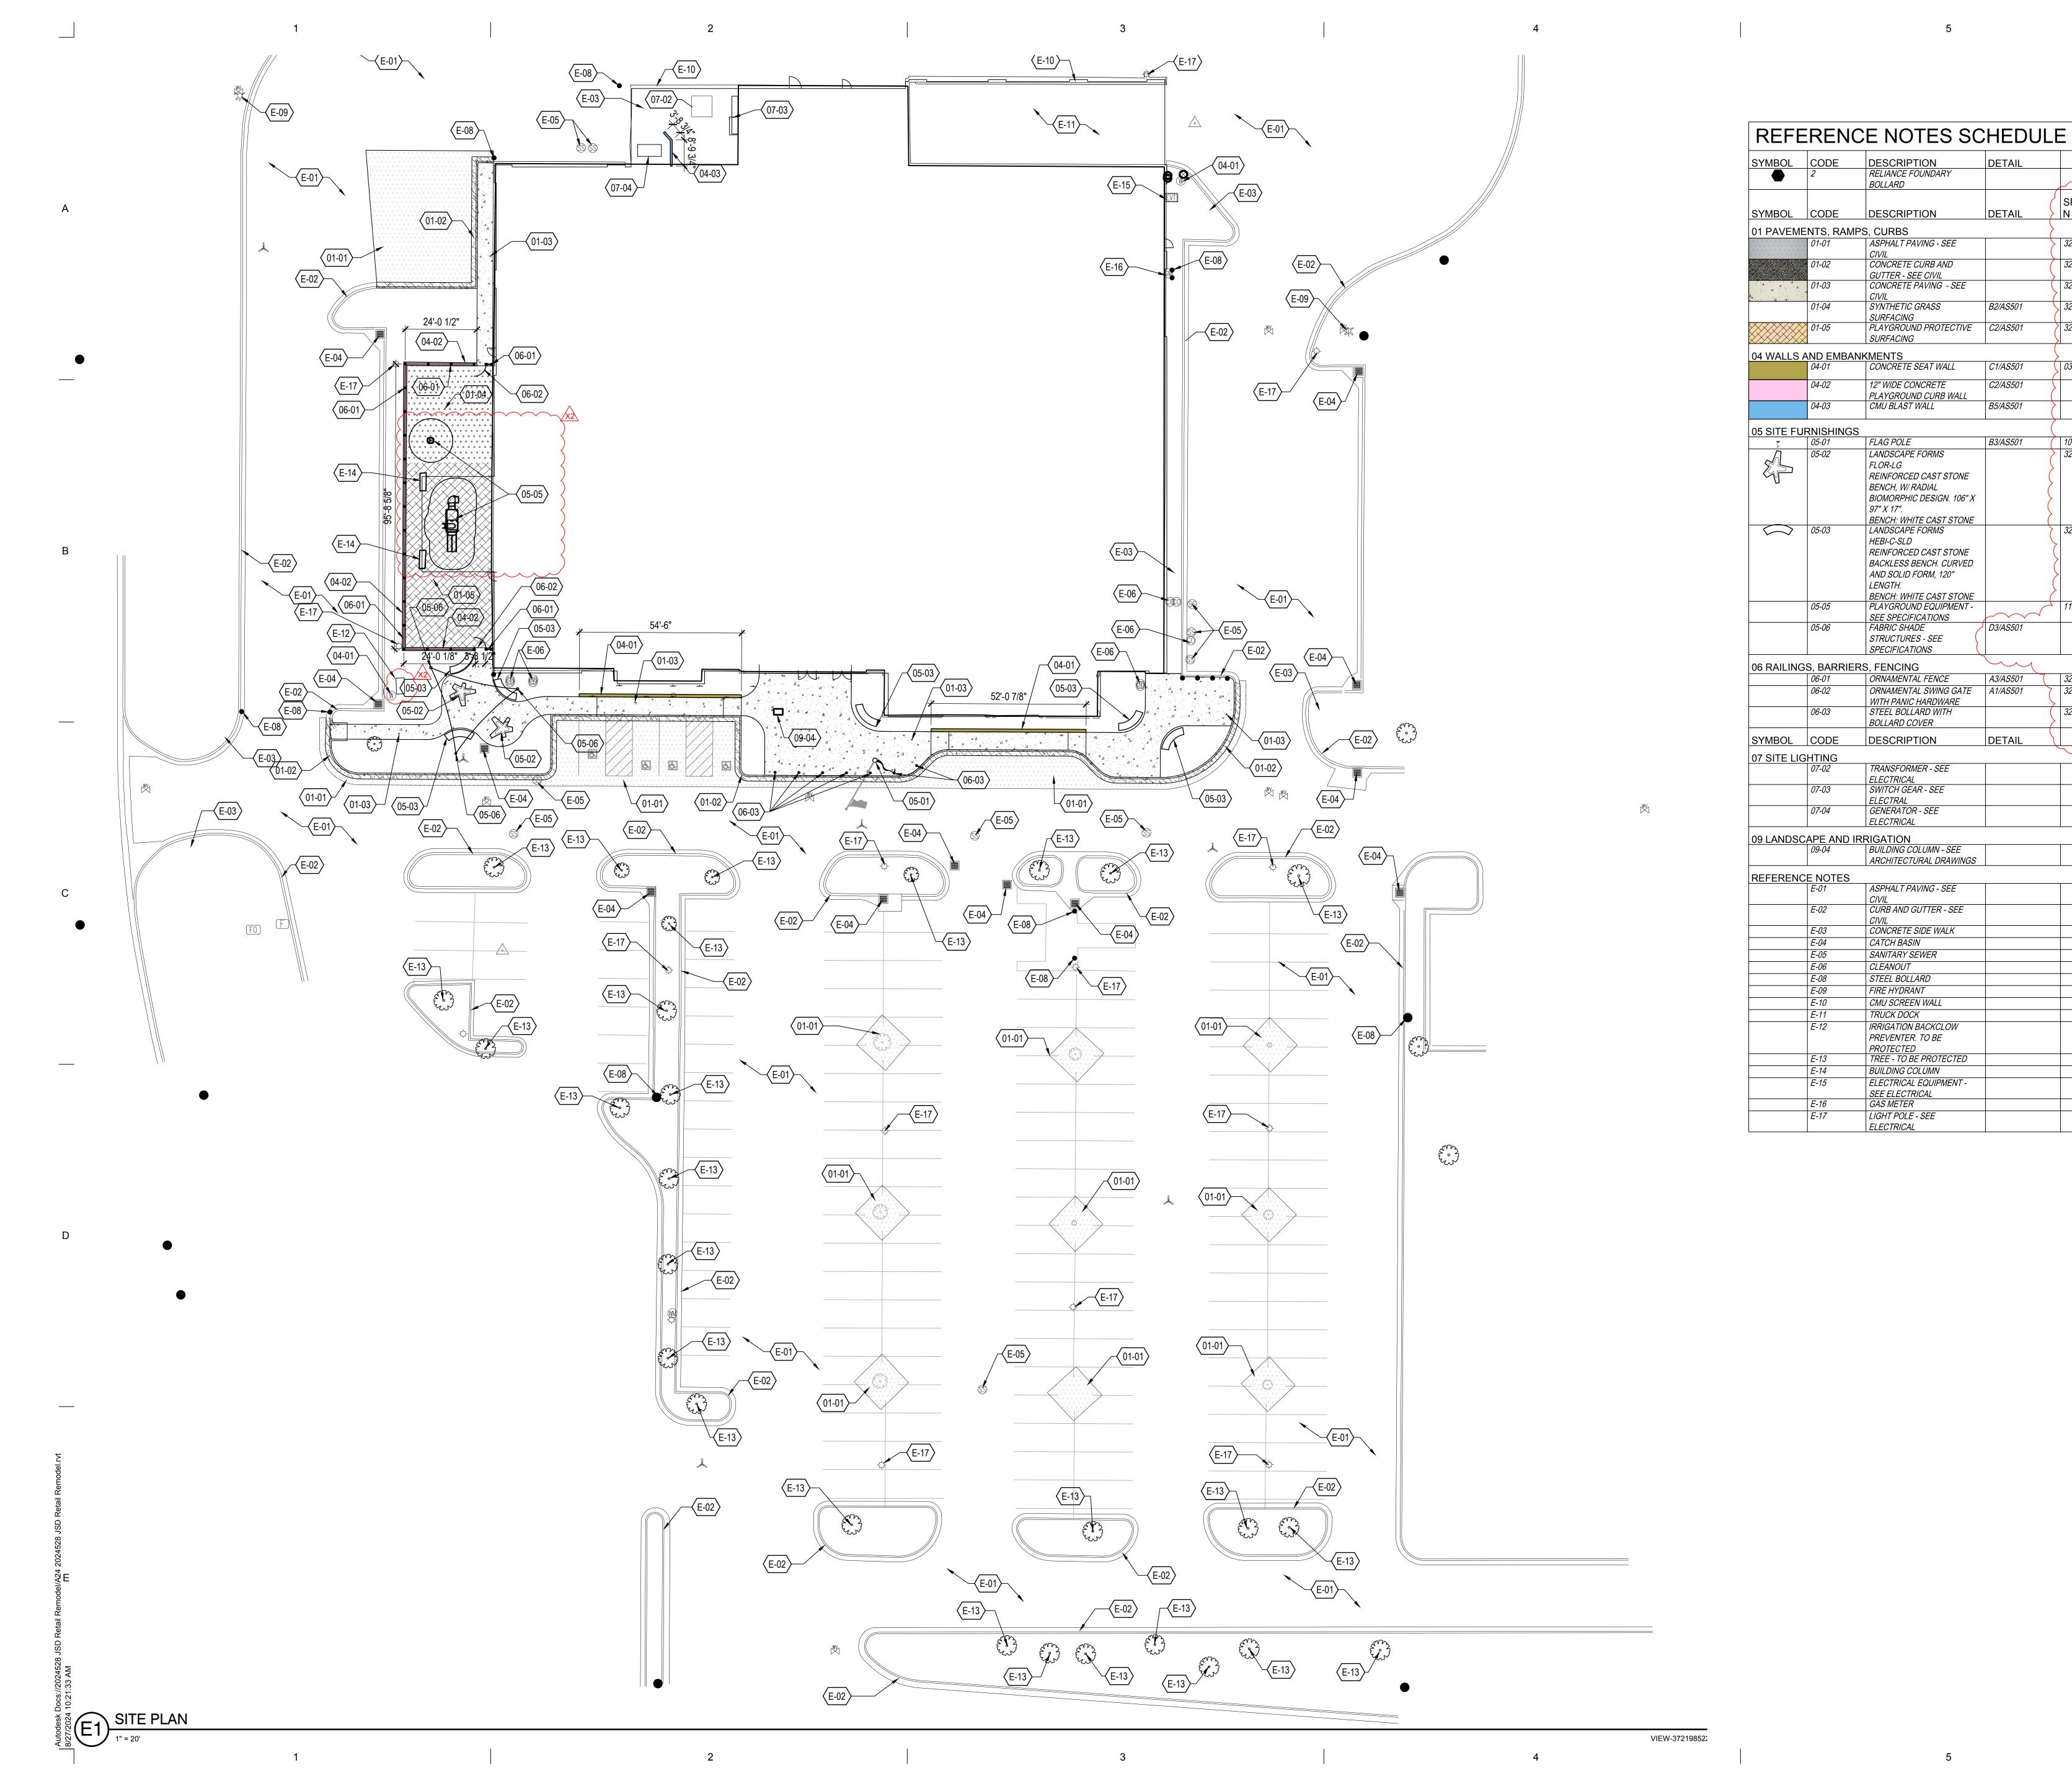



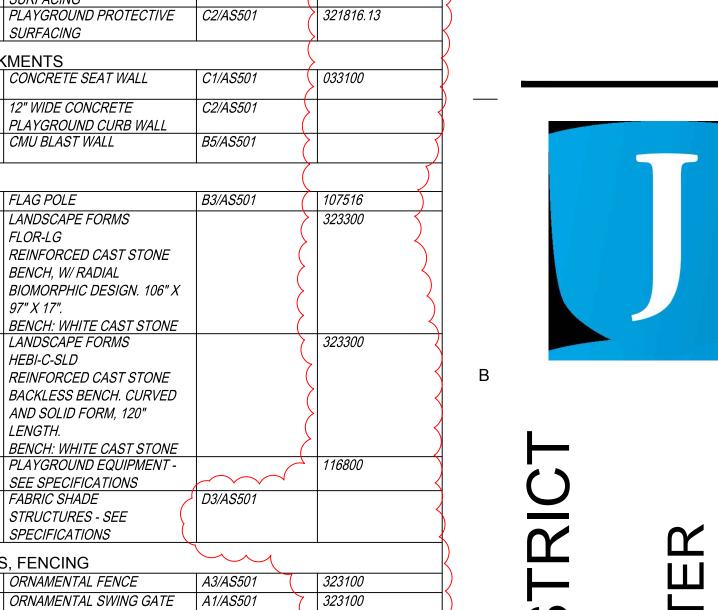

SPECIFICATIO

321818

DESCRIPTION RELIANCE FOUNDARY

ASPHALT PAVING - SEE

CONCRETE CURB AND

SYNTHETIC GRASS

12" WIDE CONCRETE

LANDSCAPE FORMS

BENCH, W/ RADIAL

HEBI-C-SLD

FLAG POLE

PLAYGROUND CURB WALL
CMU BLAST WALL

REINFORCED CAST STONE

BIOMORPHIC DESIGN. 106" X

BENCH: WHITE CAST STONE LANDSCAPE FORMS

REINFORCED CAST STONE BACKLESS BENCH. CURVED

AND SOLID FORM, 120"

BENCH: WHITE CAST STONE PLAYGROUND EQUIPMENT -

STRUCTURES - SEE SPECIFICATIONS

WITH PANIC HARDWARE
STEEL BOLLARD WITH

BOLLARD COVER

DESCRIPTION

TRANSFORMER - SEE ELECTRICAL SWITCH GEAR - SEE

ELECTRAL GENERATOR - SEE

ARCHITECTURAL DRAWINGS

ASPHALT PAVING - SEE

CURB AND GUTTER - SEE

| CIVIL | CONCRETE SIDE WALK

IRRIGATION BACKCLOW PREVENTER. TO BE

PROTECTED
TREE - TO BE PROTECTED

BUILDING COLUMN ELECTRICAL EQUIPMENT -

LIGHT POLE - SEE ELECTRICAL


CATCH BASIN SANITARY SEWER

CLEANOUT STEEL BOLLARD FIRE HYDRANT CMU SCREEN WALL TRUCK DOCK

GUTTER - SEE CIVIL CONCRETE PAVING - SEE

PLAYGROUND PROTECTIVE

DESCRIPTION

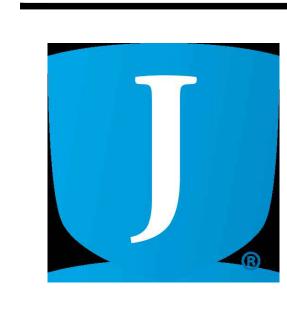

乙川 3706 WEST 9800 SOUTH SOUTH JORDAN, UT 84009

SCHOOL

©2023 MHTN ARCHITECTS, INC. Confidentiality Notice:
This document is intended for use on the Project identified herein by individuals and companies involved in the design, permitting, bidding and construction of the Project. MHTN Architects, Inc. grants limited rights to distribute and reproduce this document for this express purpose only. Distribution, printing or copying this document for purposes other than those indicated is strictly prohibited. If a digital copy of this document is received in error, please delete it.


15	TATE O	UTAN	1
(YV	INCENT OLCO	RULON	11
1-71	o. 481	2865	LG LG
1201	8-29-2 ANDSC	2024	<i>\\\\\\\\\\\\\\\\\\\\\\\\\\\\\\\\\\\\\</i>

REVISIO	NS	Do not scale contents of this drawing.
	CTOR TO VERIF VISION DATE.	Y DRAWINGS IN FIELD USE REFLECT
NO. \triangle	DATE	DESCRIPTION
X2	13 SEP. 2024	ADDENDUM 2

CONSTRUCTION DOCUMENTS AUGUST 29, 2024

ENLARGED SITE PLAN

AS101

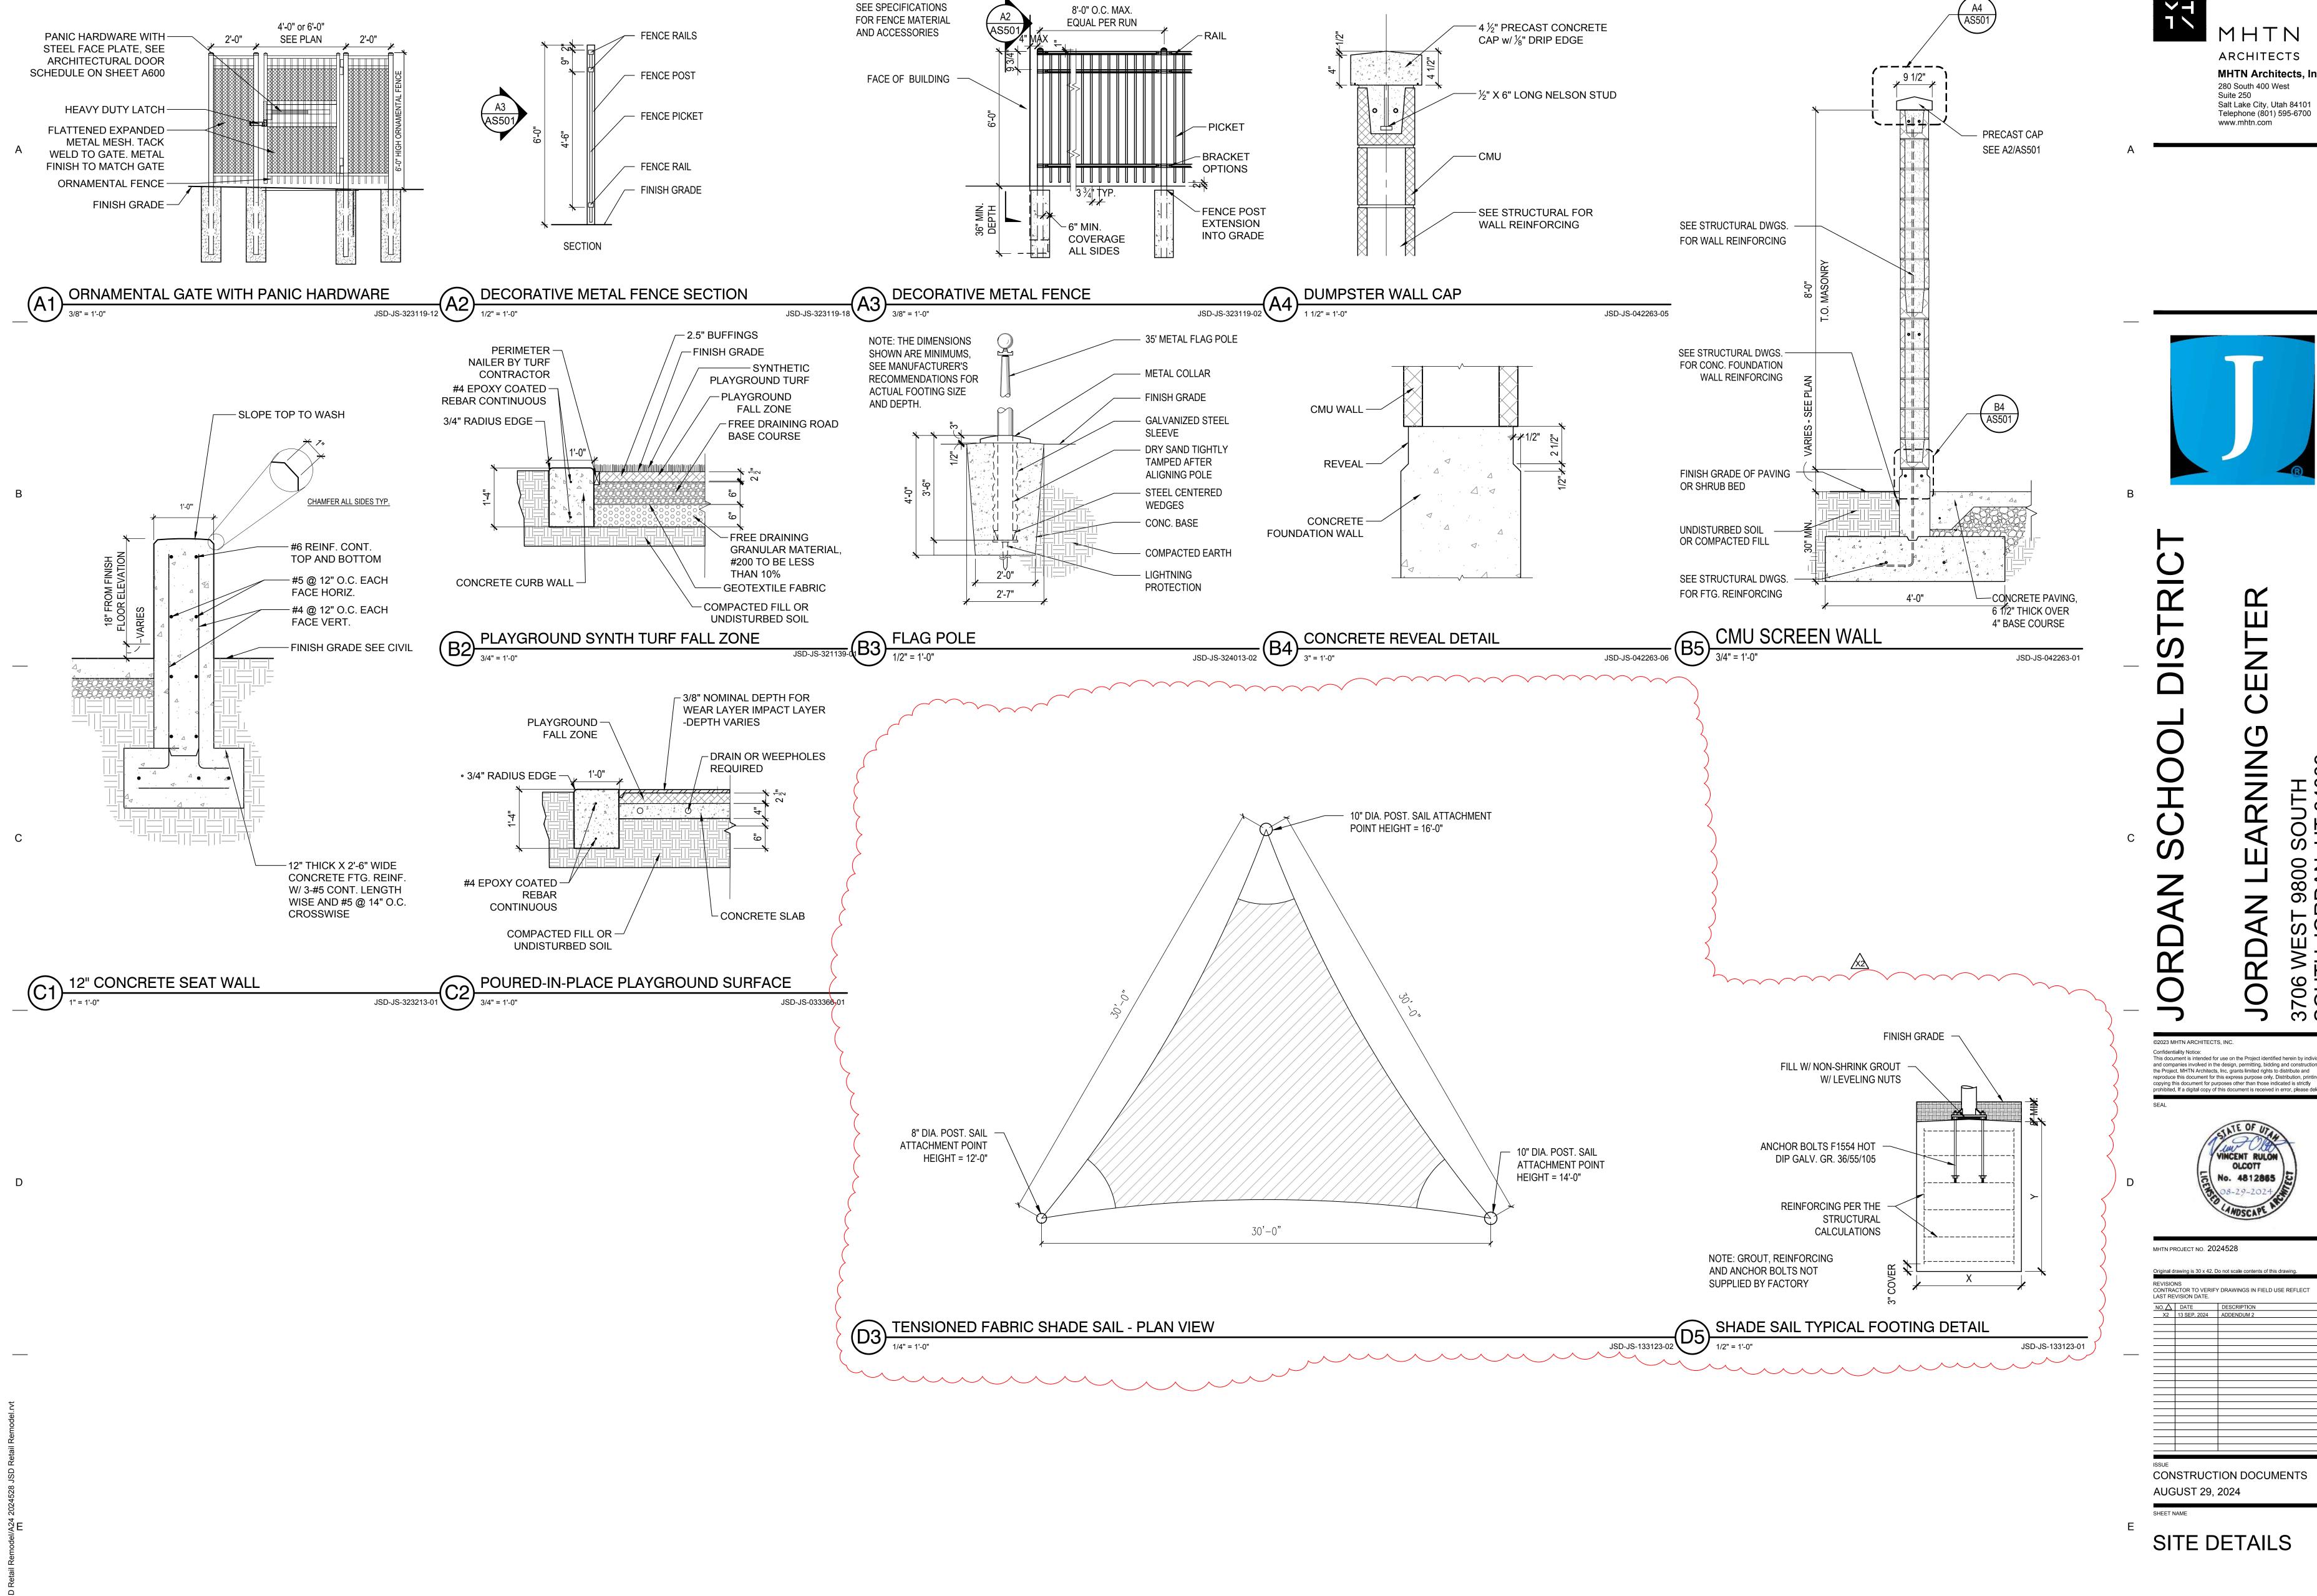

MHTN ARCHITECTS MHTN Architects, Inc.



Confidentiality Notice: This document is intended for use on the Project identified herein by individuals and companies involved in the design, permitting, bidding and construction of the Project. MHTN Architects, Inc. grants limited rights to distribute and reproduce this document for this express purpose only. Distribution, printing or copying this document for purposes other than those indicated is strictly prohibited. If a digital copy of this document is received in error, please delete it.



REVISIONS CONTRACTOR TO VERIFY DRAWINGS IN FIELD USE REFLECT LAST REVISION DATE.

AS501



Suite 250 Salt Lake City, Utah 84101 Telephone (801) 595-6700

www.mhtn.com

IRRIGATION SCHEDULE


MANUFACTURER/MODEL/DESCRIPTION RAIN BIRD XCZ-100-PRB-COM WIDE FLOW DRIP CONTROL KIT FOR COMMERCIAL APPLICATIONS. 1IN. BALL VALVE WITH 1IN. PESB VALVE AND 1IN. PRESSURE REGULATING 40PSI QUICK-CHECK BASKET FILTER. 5 GPM-20 GPM. AREA TO RECEIVE DRIPLINE NETAFIM TLCV-06-18 TECHLINE PRESSURE COMPENSATING LANDSCAPE DRIPLINE WITH CHECK VALVE. 0.6 GPH EMITTERS AT 18" O.C. DRIPLINE LATERALS SPACED AT 18" APART, WITH EMITTERS OFFSET FOR TRIANGULAR PATTERN. 17MM. MANUFACTURER/MODEL/DESCRIPTION EXISTING REMOTE CONTROL VALVE PROTECT AND REUSE EXISTING VALVE. CONTRACTOR TO VERIFY CONDITION.


EXISTING BACKFLOW PREVENTER 2"
BACKFLOW PREVENTER SHALL BE PROTECTED AND PRESERVED


IRRIGATION LATERAL LINE: PVC SCHEDULE 40

------ IRRIGATION LATERAL LINE: PVC CLASS 200

IRRIGATION MAINLINE: PVC SCHEDULE 40
SCHEDULE 40 PVC PIPE WITH SCHEDULE 40 FITTINGS
PIPE SLEEVE: PVC CLASS 200 SDR 21

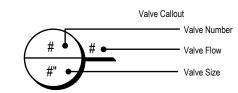

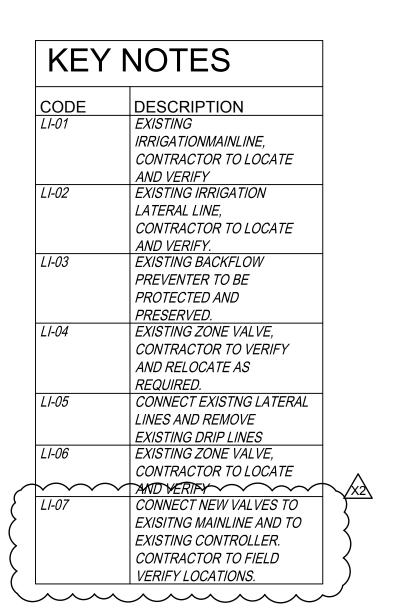

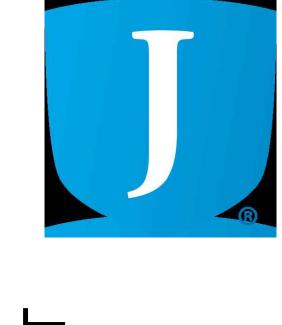

JORDAN LEARNING CENTER

STATE OF UTAN	
VINCENT RULON OLCOTT	1
No. 4812865	
CO LANDSCAPE NO	
(00)	

MHTN PI	ROJECT NO. 20	24528
Original d	rawing is 30 x 42. D	o not scale contents of this drawing.
		Y DRAWINGS IN FIELD USE REFLECT
NO. \triangle	DATE	DESCRIPTION
X2	13 SEP. 2024	ADDENDUM 2
	I	

CONSTRUCTION DOCUMENTS
AUGUST 29, 2024

^E IRRIGATION PLAN

LI101

IRRIGATION NOTES

ALL MAIN LINE PIPE SHALL BE NEW SCHEDULE 40 PVC PIPE WITH DEEP SOCKET FITTINGS ON ALL 3" TEES, ELBOWS AND 90'S. ALL LATERAL LINE PIPE SHALL BE SCHEDULE 40 PVC PIPE. FITTINGS ON ALL LATERAL LINES SHALL BE SCHEDULE 40 FITTINGS.

ALL GALVANIZED PIPE ON DETAILS SHALL BE NEW GALVANIZED STEEL PIPE.

LIVE SERVICE MAINS SHALL BE INSTALLED A MINIMUM OF 18" BELOW FINISH GRADE. BACKFILL TRENCH AROUND LIVE SERVICE MAIN WITH A MINIMUM OF 8" OF SAND. LATERAL LINES SHALL BE PLACED A MINIMUM OF 12" BELOW FINISH GRADE.

ALL MAIN LINES SHALL SLOPE TO DRAIN. IF FIELD CONDITIONS NECESSITATE ADDITIONAL DRAINS, THESE DRAINS SHALL BE INSTALLED FOR COMPLETE DRAINAGE OF THE ENTIRE MAINLINE. PROVIDE A 24" DIA. X 24" DEEP GRAVEL SUMP UNDER EACH DRAIN, WHICH DRAIN SHALL BE A MIN. OF 24" BELOW GRADE. ALL MANUAL DRAIN VALVES SHALL BE INSTALLED AS DETAILED ON THE DRAWINGS. INSTALL GEO-TEXTILE FABRIC AROUND EACH GRAVEL DRAIN.

THIS CONTRACTOR SHALL PROVIDE AND INSTALL AIR RELIEF VALVES ON THE MAINLINE AT ALL DEAD END RUNS AND AT ALL HIGH POINTS THROUGHOUT.

THE CONTRACTOR SHALL PRESSURE TEST THE MAINLINE AT 150 P.S.I. PRIOR TO INSTALLING ANY LATERAL LINES.

IRRIGATION SYSTEM IS DESIGNED SO THAT THE SYSTEM CAN BE WINTERIZED USING COMPRESSED AIR. DO NOT INSTALL AUTOMATIC DRAINS ANYWHERE ON THE SYSTEM.

THIS CONTRACTOR SHALL PROVIDE RECORD DRAWINGS OF THE IRRIGATION SPRINKLER SYSTEM IN CAD FORMAT SHOWING EXACT MEASURED AND DIMENSIONED LOCATIONS OF ALL VALVES, WIRE SPLICES NOT IN A VALVE BOX AND OTHER IRRIGATION EQUIPMENT. SEE SPECIFICATIONS. TIE DIMENSIONS TO PERMANENT FEATURES SUCH AS STRUCTURES.

THIS DRAWING IS DIAGRAMMATIC ONLY AND IS INTENDED TO CONVEY THE IDEA OF FULL COVERAGE OF THE IRRIGATION SPRINKLER SYSTEM. PRINTS SHALL NOT BE SCALED. THE IRRIGATION SYSTEM CONTRACTOR SHALL BE RESPONSIBLE FOR THE INSTALLATION LAYOUT OF THE SYSTEM IN ACCORDANCE WITH THE DRAWINGS TO PROPORTIONALLY COVER A GIVEN AREA AS SHOWN. THE LAYOUT MAY BE MODIFIED IF NECESSARY TO OBTAIN COVERAGE TO SUIT THE MANUFACTURERS STANDARD HEADS INDICATED. DO NOT DECREASE THE NUMBER OF HEADS INDICATED UNLESS THIS IS ACCEPTABLE TO THE LANDSCAPE ARCHITECT. THE SYSTEM SHALL BE TESTED FOR COMPLETE COVERAGE AND ALL NECESSARY PROPER ADJUSTMENTS MADE TO GET FULL AND PROPER COVERAGE PRIOR TO ACCEPTANCE BY THE OWNER.

WIRE SPLICES AND DRAIN VALVES NOT IN CONTROL VALVE VALVE BOXES. SHALL BE IN 10" ROUND VALVE BOXES.

ALL VALVES TO BE WIRED TO CONTROLLERS USING MULTI-STRAND. WIRE AND PEN-TITE WATER RESISTANT WIRE CONNECTORS. ALL VALVE WIRES UNDER PAVING SHALL BE INSTALLED IN A MINIMUM 2" SCHEDULE 40 PVC CONDUIT BURIED 24" DEEP. PROVIDE AND INSTALL A DIFFERENT COLOR VALVE WIRE FOR EACH CONTROLLER. RUN THREE EXTRA REQUIRED TWO HOT (BLUE COLOR) AND ONE COMMON WIRE (WHITE COLOR) . EXTRA WIRE FROM THE ADJACENT CONTROLLER TO EACH GROUP OF VALVES FOR FUTURE USE AND STUB INTO THE VALVE BOX.

ALL VALVE BOXES SHALL BE JUMBO SIZED PLASTIC BOXES, AMETEC OR EQUAL UNLESS OTHERWISE DETAILED.

ALL VALVES WILL BE LOCATED IN GROUPS 3' AWAY FROM WALKS AND CURBS-COORDINATE WITH MAINLINE LAYOUT. A DRAIN VALVE WITH SUMP SHALL BE PROVIDED AND INSTALLED AT EACH GROUP OF VALVES. A QUICK COUPLER SHALL BE PROVIDED AT EVERY VALVE MANIFOLD LOCATION. VALVES SHALL BE LOCATED 3'-0" AWAY FROM THE CURBS, WALKS OR MOWSTRIP.

VALVE MANIFOLD OR MAIN LINE TEE. ALL MAINLINE MANIFOLD TEES SHALL HAVE A 4" MINIMUM OUTLET.

A MAXIMUM OF FOUR VALVES SHALL BE INSTALLED ON EACH

THIS CONTRACTOR SHALL BE RESPONSIBLE FOR REPAIRING ANY SITE ITEMS DAMAGED DURING THE COURSE OF CONSTRUCTION.

IRRIGATION PRODUCT SUBMITTALS SHALL INCLUDE PIPE SLEEVING, CONDUIT, AND ASSOCIATED COMPONENTS

THIS CONTRACTOR SHALL BE RESPONSIBLE TO PROTECT ALL THE EXISTING TREES AND MINIMIZE DAMAGE TO ALL TREE ROOTS. INSTALL LATERALS TO HEADS IN A MANNER TO MINIMIZE ROOT DAMAGE TO ALL EXISTING TREES.

IRRIGATION REMODEL NOTES

THIS CONTRACTOR SHALL BE RESPONSIBLE FOR FIELD VERIFICATION OF THE EXISTING SPRINKLER IRRIGATION SYSTEM IN TERMS OF FLOW CAPACITY, VALVE WIRING, VALVE AND HEAD LAYOUT AND CONTROLLER CAPACITY.

THIS CONTRACTOR SHALL BE RESPONSIBLE FOR THE COMPLETE REMODEL OF A SECTION OF THE EXISTING IRRIGATION SYSTEM AS SHOWN AND FOR PROVIDING FOR FULL COVERAGE OF ALL SYSTEM HEADS AND FOR THE FULL AND COMPLETE OPERATION OF BOTH THE NEW AND EXISTING SYSTEM IN THE AREAS BEING MODIFIED INCLUDING AREAS ADJACENT TO THE SITE

THIS CONTRACTOR SHALL COORDINATE ALL DEMOLITION WORK AND TIMES WITH THE OWNER.

MAINTAIN AND PROTECT AS MUCH OF THE EXISTING IRRIGATION SYSTEM AS POSSIBLE AND FEASIBLE AND STILL PROVIDE FOR FULL COVERAGE OF THE ENTIRE AREA. KEEP ALL LAWN AREA HEADS ON A SEPARATE CIRCUIT FROM SHRUB AREA HEADS.


THE EXISTING IRRIGATION SYSTEMS NOTED TO REMAIN IN USE SHALL BE PATCHED AND REPAIRED AS NECESSARY. MAINTAIN OPERATION OF THE EXISTING SYSTEM AS REQUIRED TO PROTECT EXISTING PLANT MATERIAL. CONTRACTOR SHALL BE RESPONSIBLE FOR DAMAGE OR DEATH OF EXISTING PLANT MATERIAL.


ALL SALVAGED HEADS SHALL BE RETURNED TO THE OWNER.


THIS CONTRACTOR SHALL BE RESPONSIBLE FOR PROTECTING THE EXISTING VALVE WIRING AND RE-ROUTING AS SHOWN AND AS REQUIRED. MINIMIZE THE USE OF WIRE SPLICES. PROVIDE TEMPORARY WIRING AS REQUIRED TO KEEP THE EXISTING SYSTEM IN OPERATION.

REPAIR DAMAGE TO EXISTING IRRIGATION SYSTEM AND LAWN RESULTING FROM CONSTRUCTION OPERATIONS.

REMOTE CONTROL VALVE WITH DISC FILTER FINISH GRADE AND PRV - PVC SUPPLY HEADER BARK MULCH 10" ROUND VALVE BOX DRIP START CONNECTION (PVC TO ELL) DRIP TUBING LATERAL BURIED 2" BELOW **PVC COUPLING** TOPSOIL FINISH GRADE AREA PERIMETER AIR/VACUUM RELIEF VALVE (PLUMBED TO DRIPLINE AT EACH HIGH POINT PVC EXHAUST HEADER AIR/VACUUM RELIEF BLANK DRIPLINE TUBING (CENTERED ON MOUND OR BERM) PVC EXHAUST HEADER LINE FLUSHING VALVE - PERIMETER LATERALS 2"-4" FROM EDGE GEO TEXTILE FABRIC - LINE FLUSH VALVE PLUMBED TO PVC TYP. 1/2" TO 3/4" WASHED **GRAVEL UNDER ENTIRE**

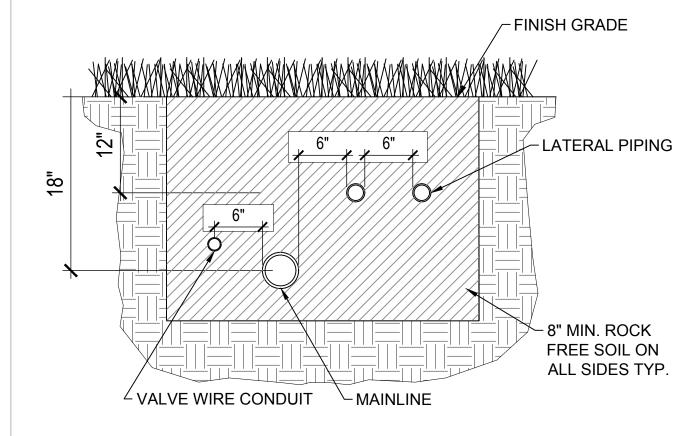

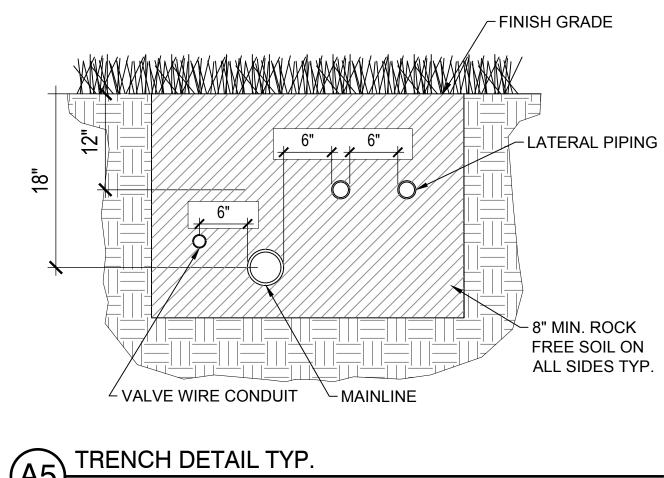

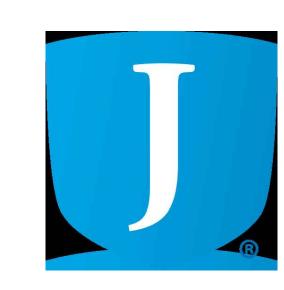

JSD-JS-328409-16

MHTN

ARCHITECTS

280 South 400 West

www.mhtn.com

Salt Lake City, Utah 84101

Telephone (801) 595-6700

Suite 250

MHTN Architects, Inc.


3 ©2023 MHTN ARCHITECTS, INC. Confidentiality Notice: This document is intended for use on the Project identified herein by individuals and companies involved in the design, permitting, bidding and construction of the Project. MHTN Architects, Inc. grants limited rights to distribute and copying this document for purposes other than those indicated is strictly prohibited. If a digital copy of this document is received in error, please delete it.

MHTN PF	ROJECT NO. 20	24528
Original d	rawing is 30 x 42. [Do not scale contents of this drawing.
	CTOR TO VERIF	Y DRAWINGS IN FIELD USE REFLECT
NO. <u></u> △	DATE	DESCRIPTION
X2	13 SEP. 2024	ADDENDUM 2

CONSTRUCTION DOCUMENTS AUGUST 29, 2024


^E IRRIGATION **DETAILS AND** NOTES

LI501

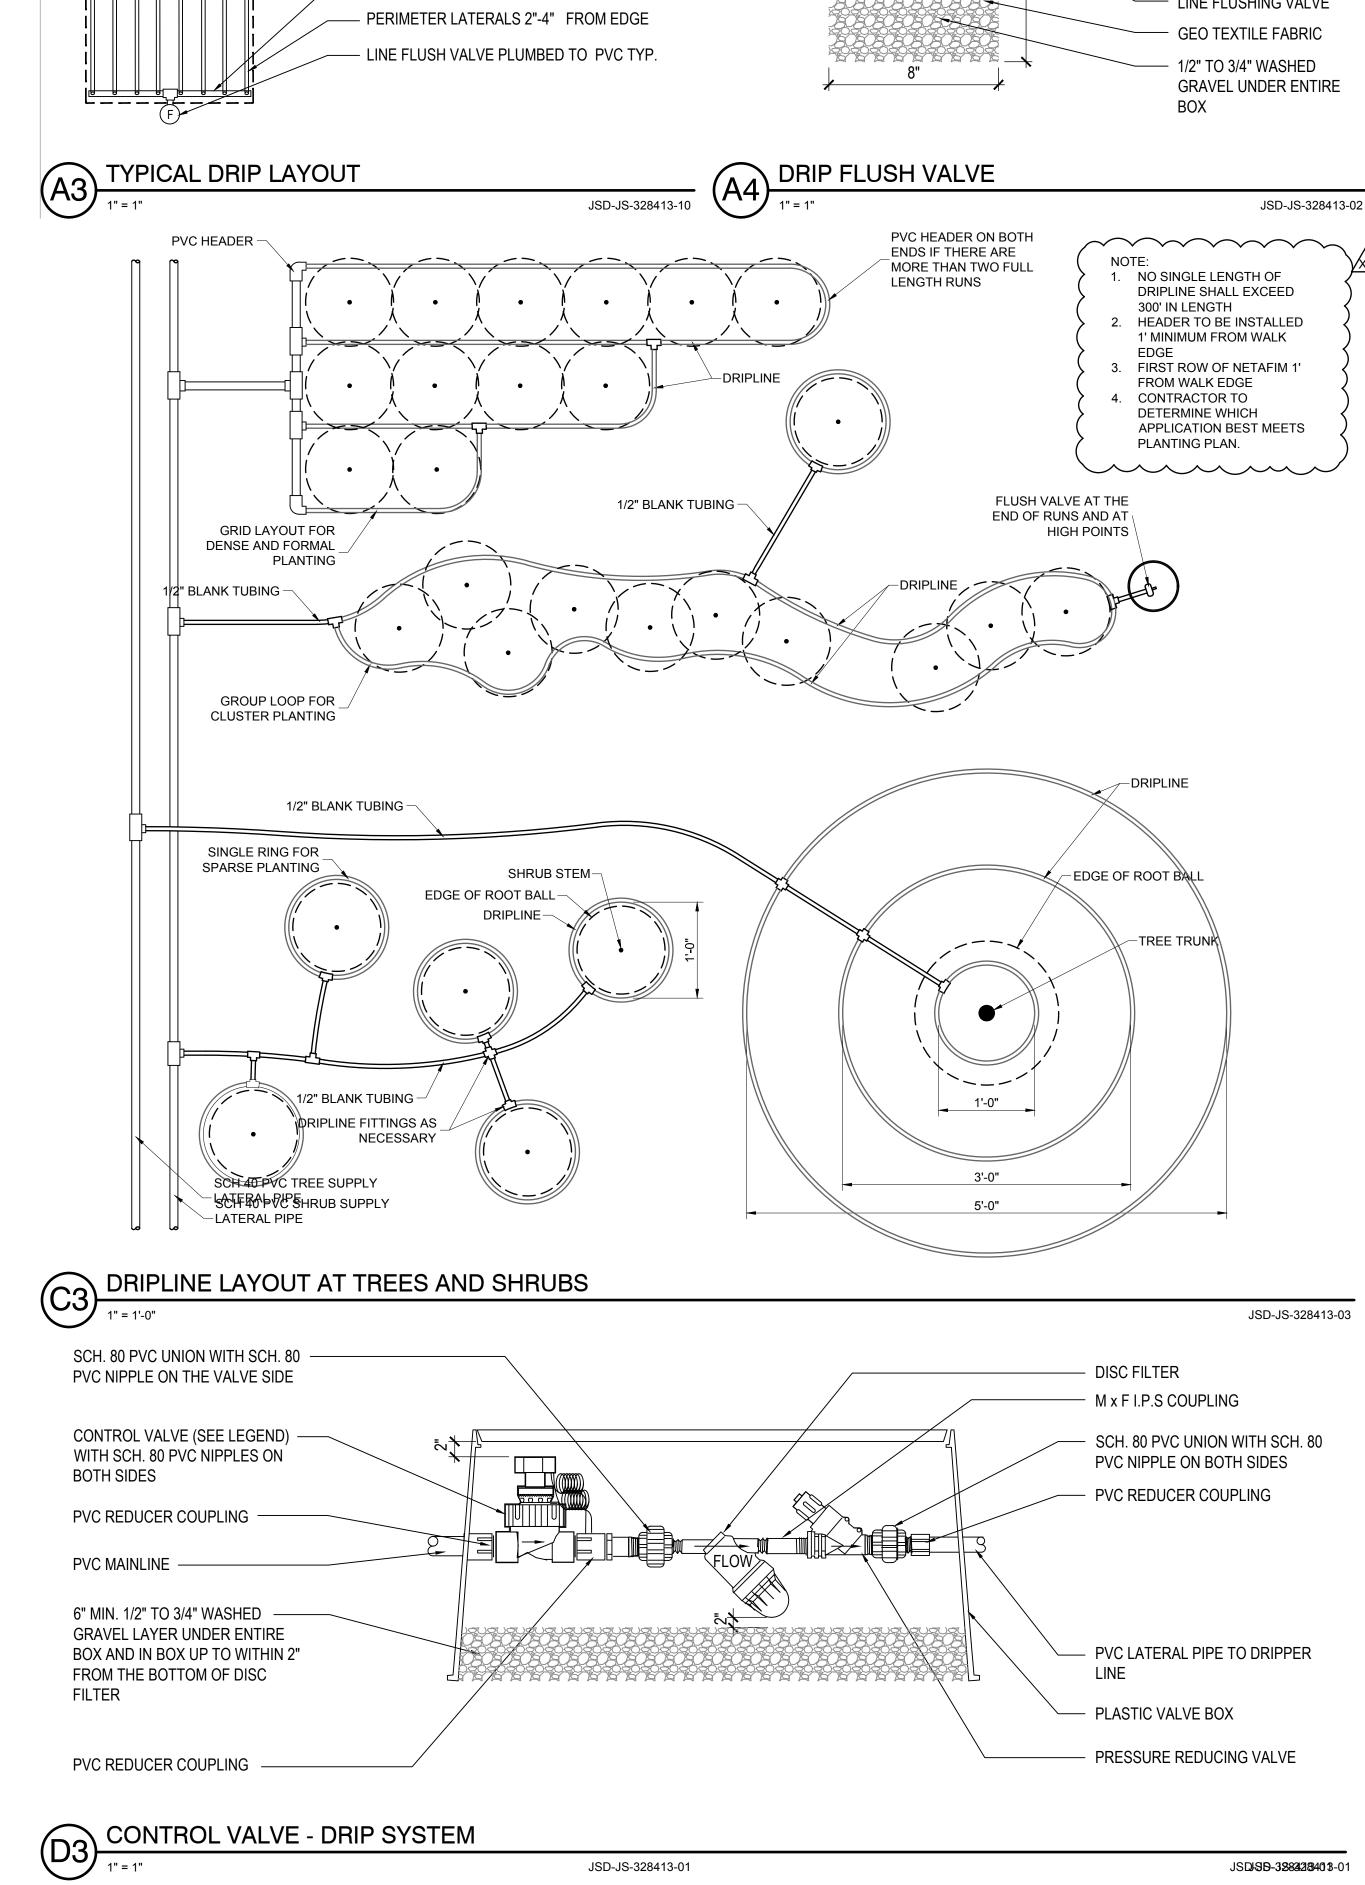


JSD-JS-328413-01

JSDJSD-328328403-01

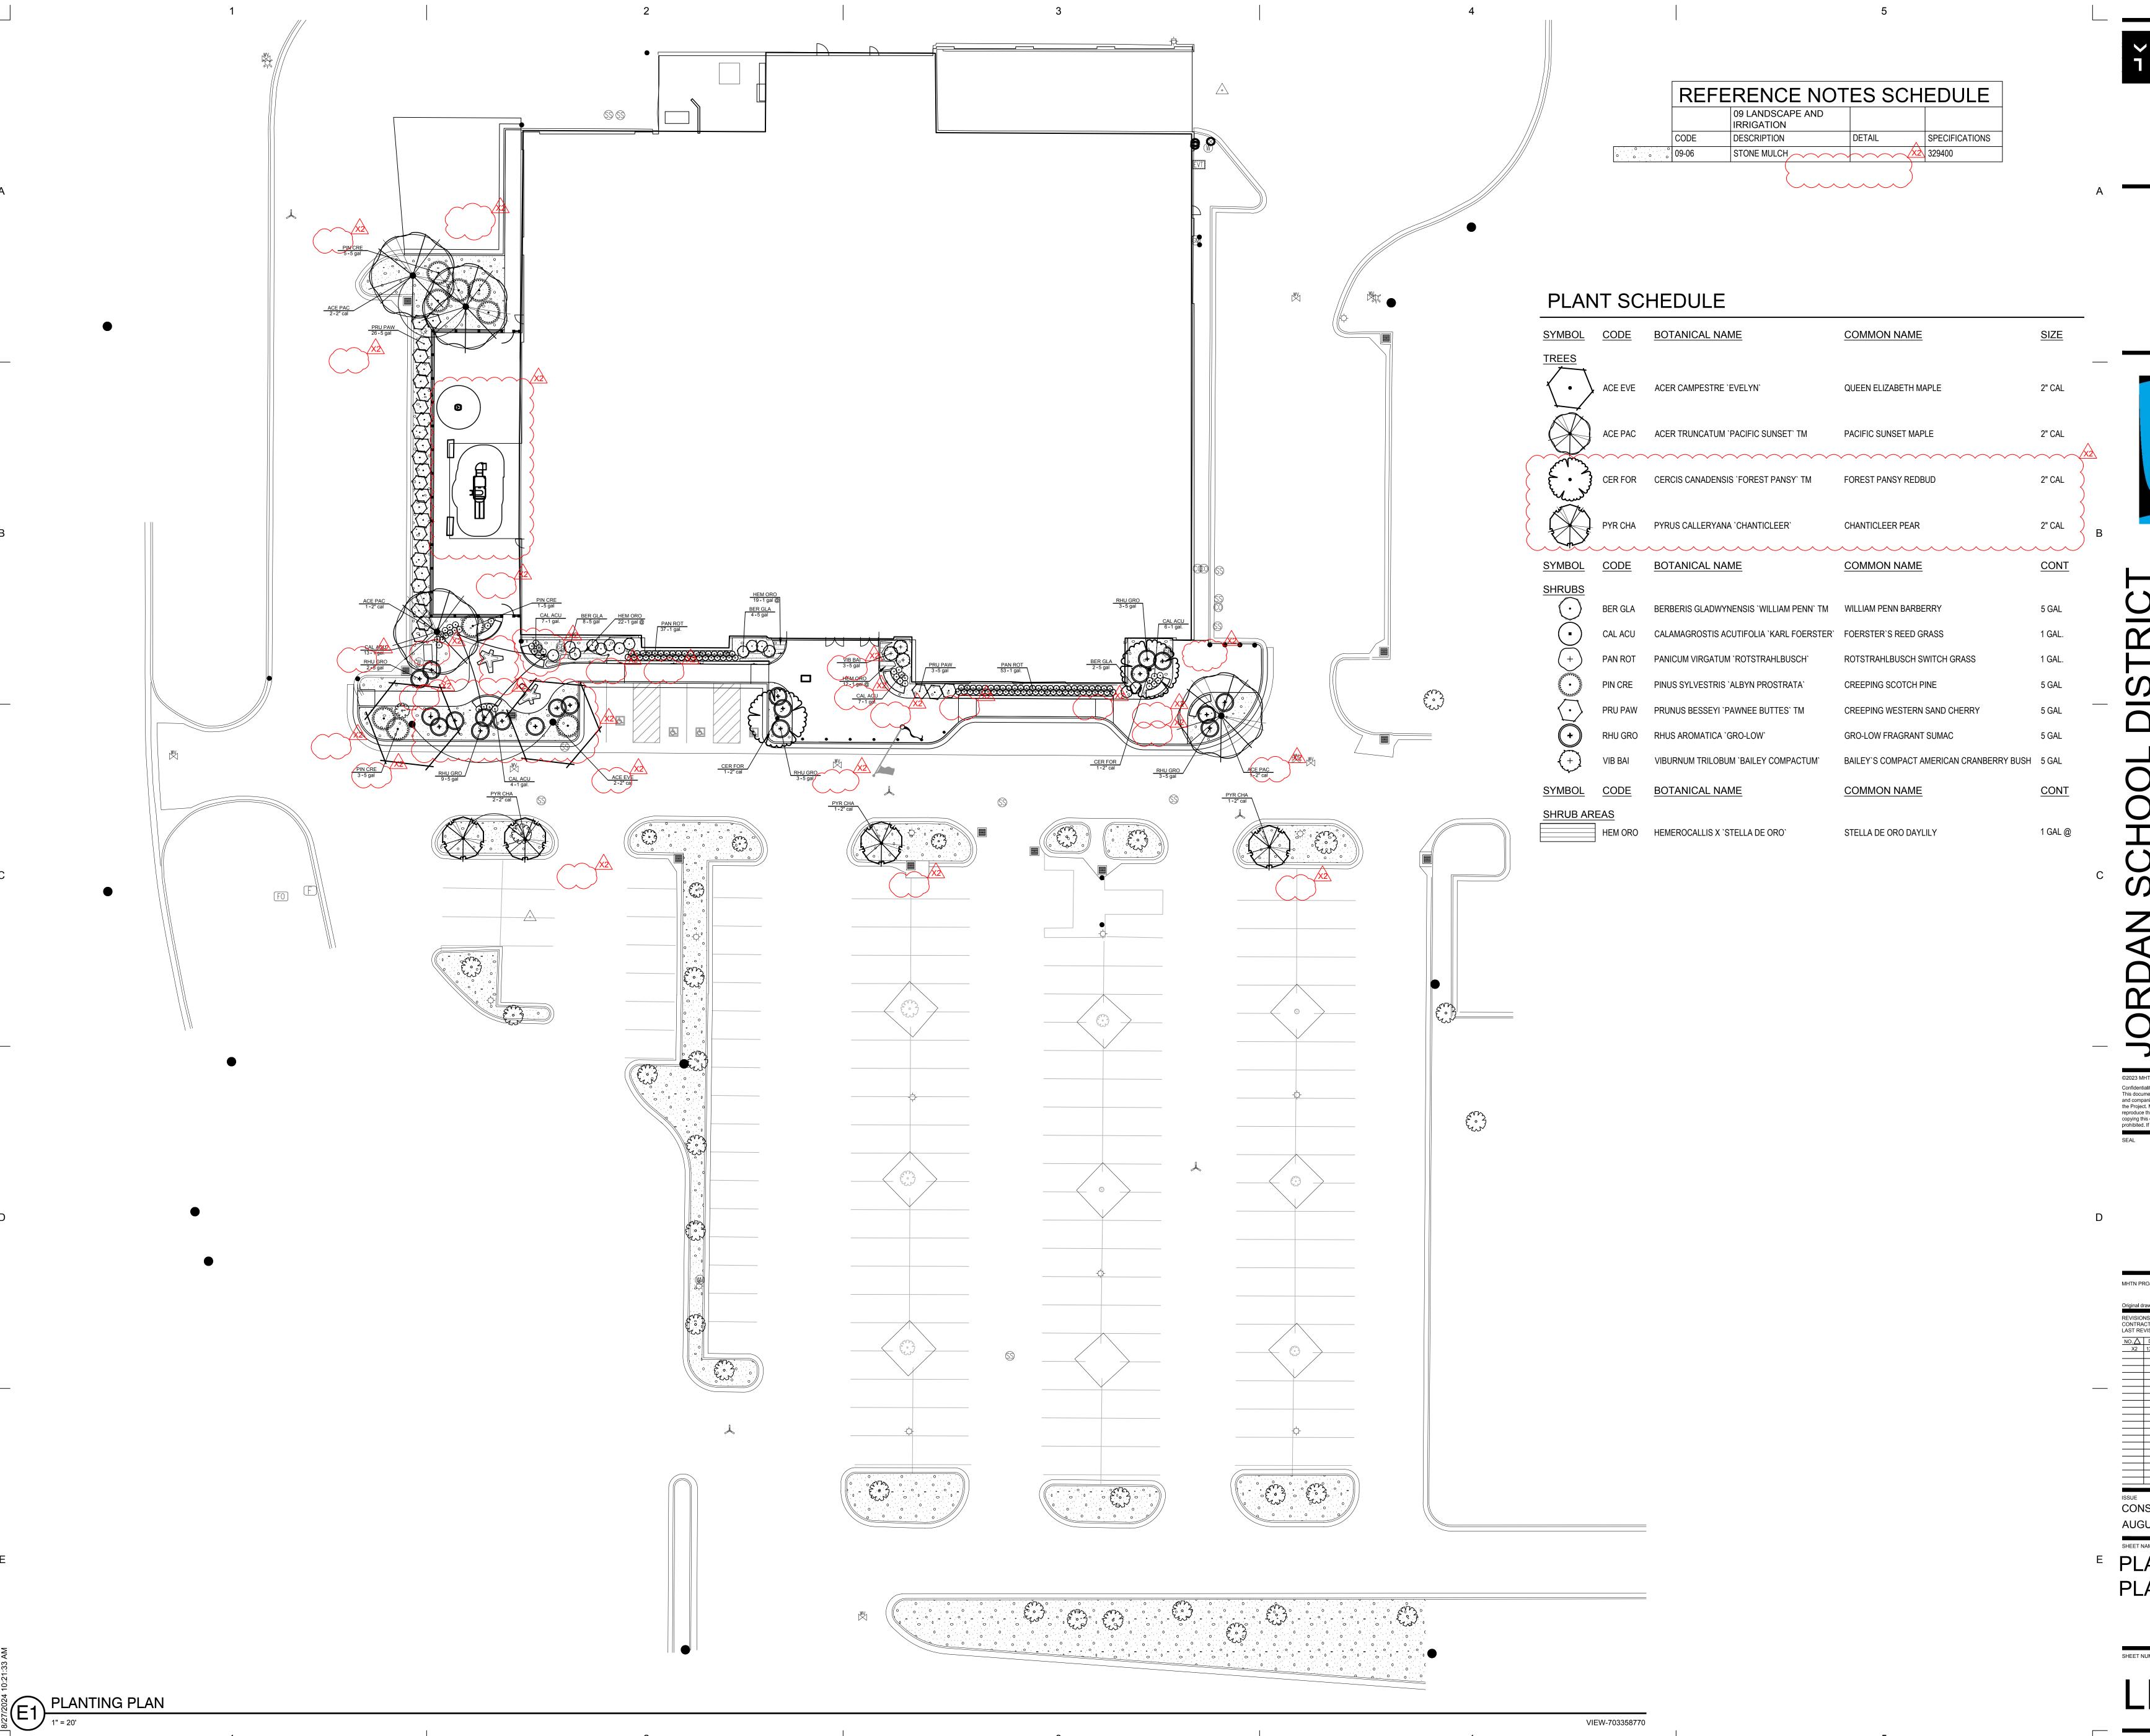



www.mhtn.com

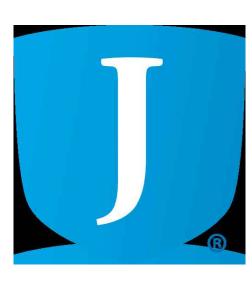

REARNING CENTER

©2023 MHTN ARCHITECTS, INC.

Confidentiality Notice:
This document is intended for use on the Project identified herein by individuals and companies involved in the design, permitting, bidding and construction of the Project. MHTN Architects, Inc. grants limited rights to distribute and reproduce this document for this express purpose only. Distribution, printing or copying this document for purposes other than those indicated is strictly prohibited. If a digital copy of this document is received in error, please delete it.

VINCENT RULON
OLCOTT
No. 4812865

OS-29-2024

MHTN PROJECT NO. **2024528**

Original drawing is 30 x 42. Do not scale contents of this drawing.


REVISIONS
CONTRACTOR TO VERIFY DRAWINGS IN FIELD USE REFLECT
LAST REVISION DATE.

NO. DATE DESCRIPTION
X2 13 SEP. 2024 ADDENDUM 2

CONSTRUCTION DOCUMENTS AUGUST 29, 2024

PLANTINGPLAN

LP101

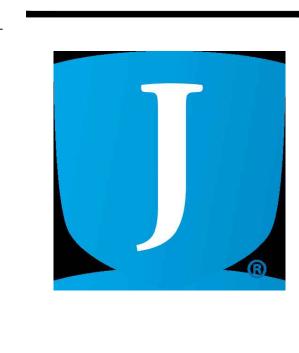

ADAN LEARNING CENTER

©2023 MHTN ARCHITECTS, INC.

Confidentiality Notice:
This document is intended for use on the Project identified herein by individuals and companies involved in the design, permitting, bidding and construction of the Project. MHTN Architects, Inc. grants limited rights to distribute and reproduce this document for this express purpose only. Distribution, printing or copying this document for purposes other than those indicated is strictly prohibited. If a digital copy of this document is received in error, please delete it.

VINCENT RULON
OLCOTT
No. 4812865

MHTN PROJECT NO. **2024528**

PLANTING NOTES

~ROOT BALL

-ROUND-TOPPED SOIL BERM 4"

HIGH x 8" WIDE ABOVE ROOT

CENTERED ON THE DOWNHILL

SIDE OF THE ROOT BALL FOR

240°. BERM SHALL BEGIN AT

- PRIOR TO MULCHING, LIGHTLY

TAMP SOIL AROUND THE ROOT

SHRUB. DO NOT OVER COMPACT.

WHEN THE PLANTING HOLE HAS

BEEN BACKFILLED, POUR WATER

JSD-JS-329333-06

AROUND THE ROOT BALL TO

SETTLE THE SOIL.

EXISTING SOIL

3x's widest dimension of root ball.

SECTION VIEW

1- SHRUBS SHALL BE OF QUALITY PRESCRIBED IN THE ROOT OBSERVATIONS DETAIL AND SPECIFICATIONS.

2- SEE SPECIFICATIONS FOR FURTHER REQUIREMENTS RELATED TO THIS DETAIL.

(E3) SHRUB ON SLOPE 5% (20:1) TO 50% (2:1) - UNMODIFIED SOIL

BALL SURFACE SHALL BE

ROOT BALL PERIPHERY.

BALL IN 6" LIFTS TO BRACE

ALL PLANTS SHALL CONFORM TO THE MINIMUM

STANDARDS OF HEIGHT, SIZE, CALIPER AND ETC. OF

THE AMERICAN ASSOCIATIONS OF NURSERYMEN

THIS CONTRACTOR SHALL SPREAD TOPSOIL TO A

THIS CONTRACTOR SHALL BE RESPONSIBLE FOR

DISPOSING FROM THE SITE ALL SOIL EXCAVATED

ALL MOWSTRIPS ARE TO BE INSTALLED PRIOR TO

THE INSTALLATION OF THE IRRIGATION SYSTEM

INSTALL SHREDDED BARK MULCH IN ALL SHRUB

 $\underbrace{\hspace{1cm}}^{\underline{\hspace{1cm}}\underline{\hspace{1cm}}}$

PROVIDING AND INSTALLING THE REQUIRED AMOUNT OF TOPSOIL TO COMPLETE THE PROJECT. NEW TOPSOIL SHALL MATCH QUALITY AND TEXTURE OF THE EXISTING

THIS CONTRACTOR SHALL BE RESPONSIBLE FOR

SYSTEM AND THE LANDSCAPE PLANTING.

PLANTING BEDS AFTER PLANT MATERIAL

"AMERICAN STANDARDS FOR NURSERY STOCK".

DEPTH OF 6" IN ALL LAWN PLANTING AREAS AND

12" IN ALL SHRUB AND PERENNIAL BEDS.

FROM TREE PITS.

INSTALLATION.

TOPSOIL ON SITE.

Original drawing is 30 x 42. Do not scale contents of this drawing.

REVISIONS
CONTRACTOR TO VERIFY DRAWINGS IN FIELD USE REFLECT
LAST REVISION DATE.

NO. DATE DESCRIPTION

X2 13 SEP. 2024 ADDENDUM 2


ISSUE CONSTRUCTION DOCUMENTS

AUGUST 29, 2024
SHEET NAME

PLANTING DETAILS

SHEET NUMBER

LP501

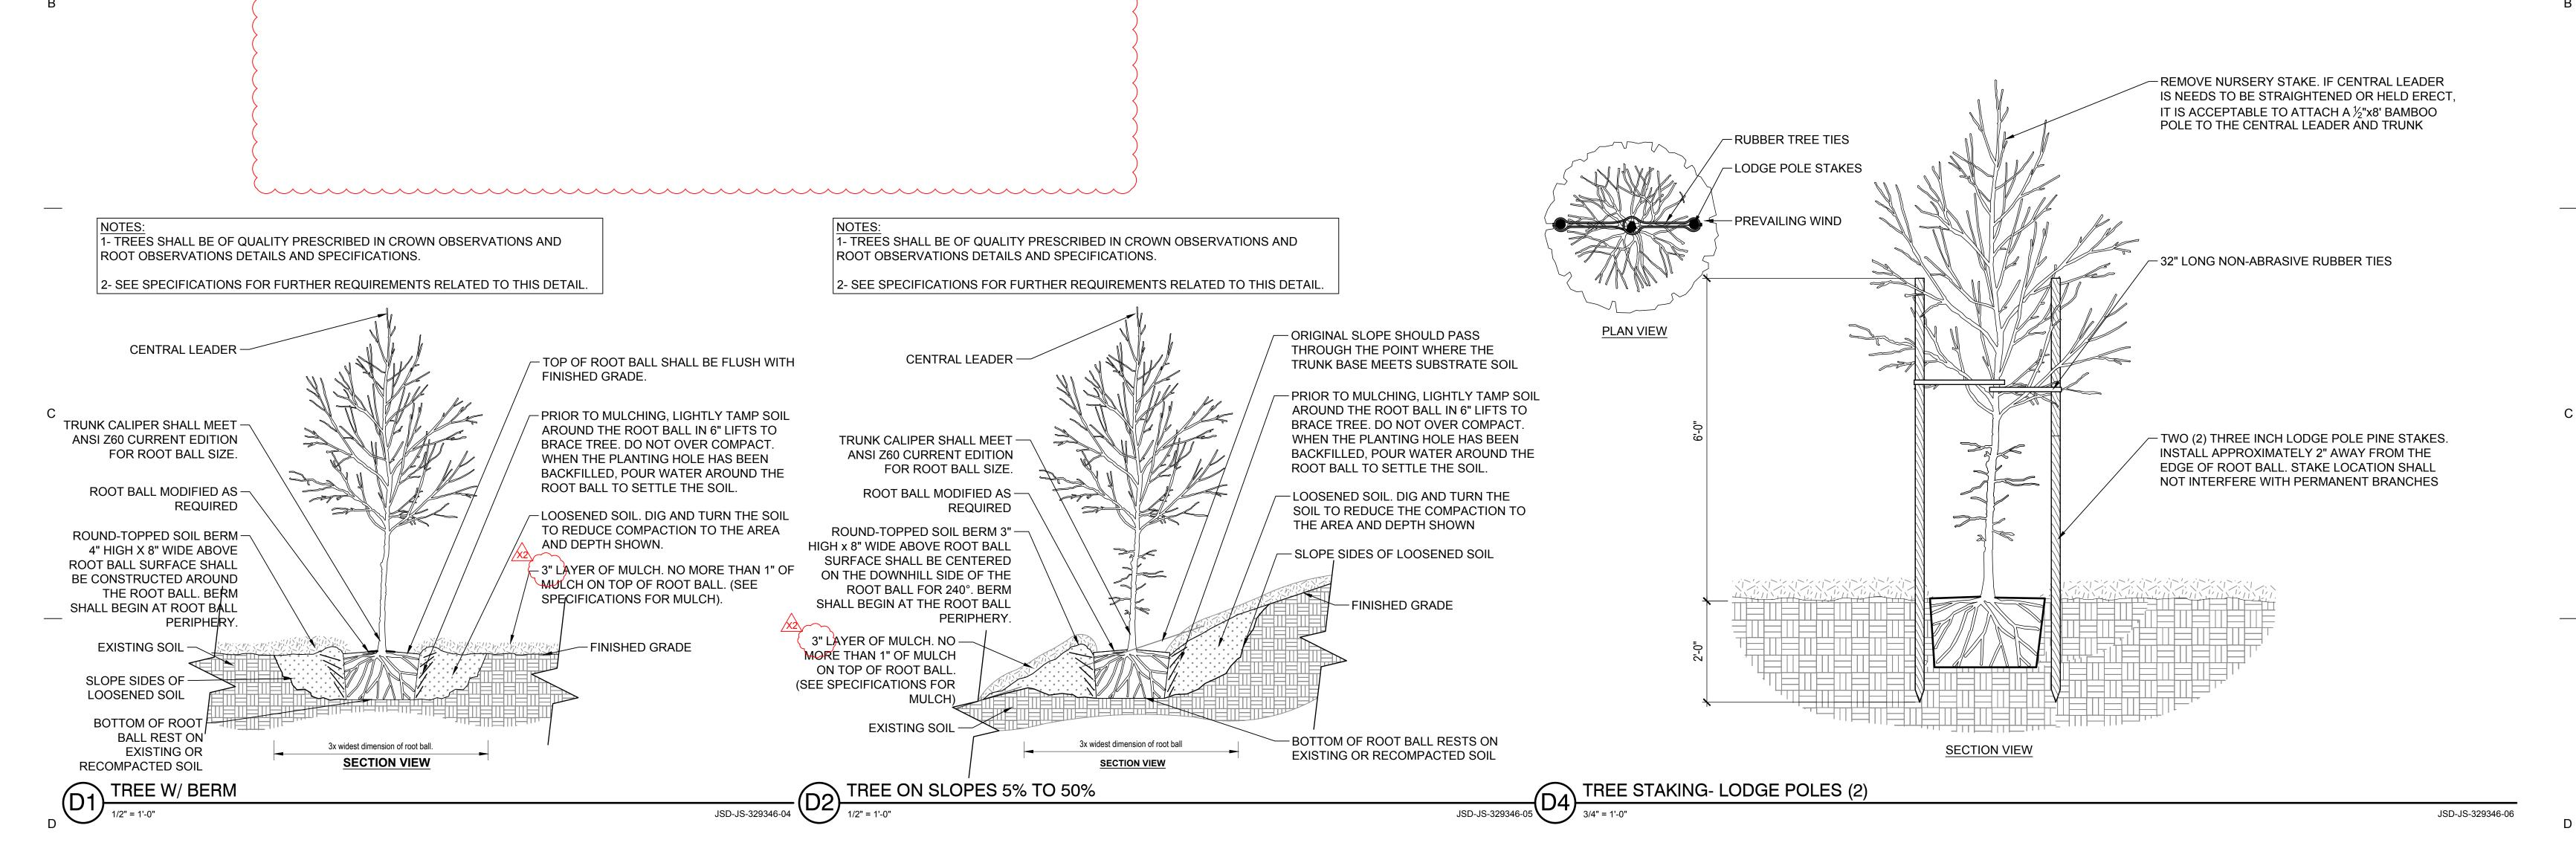

-ROOTBALL

3" LAYER OF MULCH. NO -

MORE THAN 1" OF MULCH

ON TOP OF ROOT BALL.

FINISHED GRADE -

SLOPE SIDES OF

LOOSENED SOIL

REDUCE THE

SHRUB PLANTING

SHOWN.

LOOSENED SOIL. DIG-

AND TURN THE SOIL TO

COMPACTION TO THE

AREA AND DEPTH

(SEE SPECIFICATIONS

FOR MULCH).

SHRUB PLANTING AREA

- STONE, BARK MULCH OR

- GEO-TEXTILE WEED

SUBGRADE - SCARIFY AS REQUIRED.

JSD-JS-329313-08

BARRIER FABRIC

- 12" TOPSOIL

SHRUB TOPSOIL PROFILE

1 1/2" = 1'-0"

- 3" HIGH x 8" WIDE ROUND-

TOPPED SOIL BERM ABOVE

AT ROOT BALL PERIPHERY.

BALL IN 6" LIFTS TO BRACE

PLANTING HOLE HAS BEEN

BACKFILLED, POUR WATER

AROUND THE ROOT BALL TO

- ROOT BALL REST ON EXISTING

JSD-JS-329333-05

OR RECOMPACTED SOIL.

SHRUB. DO NOT OVER

COMPACT. WHEN THE

SETTLE THE SOIL.

-EXISTING SOIL

3x's widest dimension of root ball.

2- SEE SPECIFICATIONS FOR FURTHER REQUIREMENTS RELATED TO THIS DETAIL.

SECTION VIEW

1- SHRUBS SHALL BE OF QUALITY PRESCRIBED IN THE ROOT OBSERVATIONS DETAIL AND SPECIFICATIONS.

CONSTRUCTED AROUND THE

-PRIOR TO MULCHING, LIGHTLY

TAMP SOIL AROUND THE ROOT

ROOT BALL. BERM SHALL BEGIN

ROOT BALL SURFACE SHALL BE MORE THAN 1" OF MULCH ON

ORIGINAL SLOPE SHOULD -

3" LAYER OF MULCH. NO -

TOP OF ROOT BALL. (SEE

SLOPE SIDES OF -

LOOSENED SOIL. DIG AND -

TURN THE SOIL TO REDUCE

THE COMPACTION TO THE

AREA AND DEPTH SHOWN.

LOOSENED SOIL

BOTTOM OF ROOT BALL

RESTS ON EXISTING OR

RECOMPACTED SOIL.


SPECIFICATIONS FOR

MULCH).

SUBSTRATE/SOIL.

PASS THROUGH THE POINT

WHERE THE TRUNK MEETS

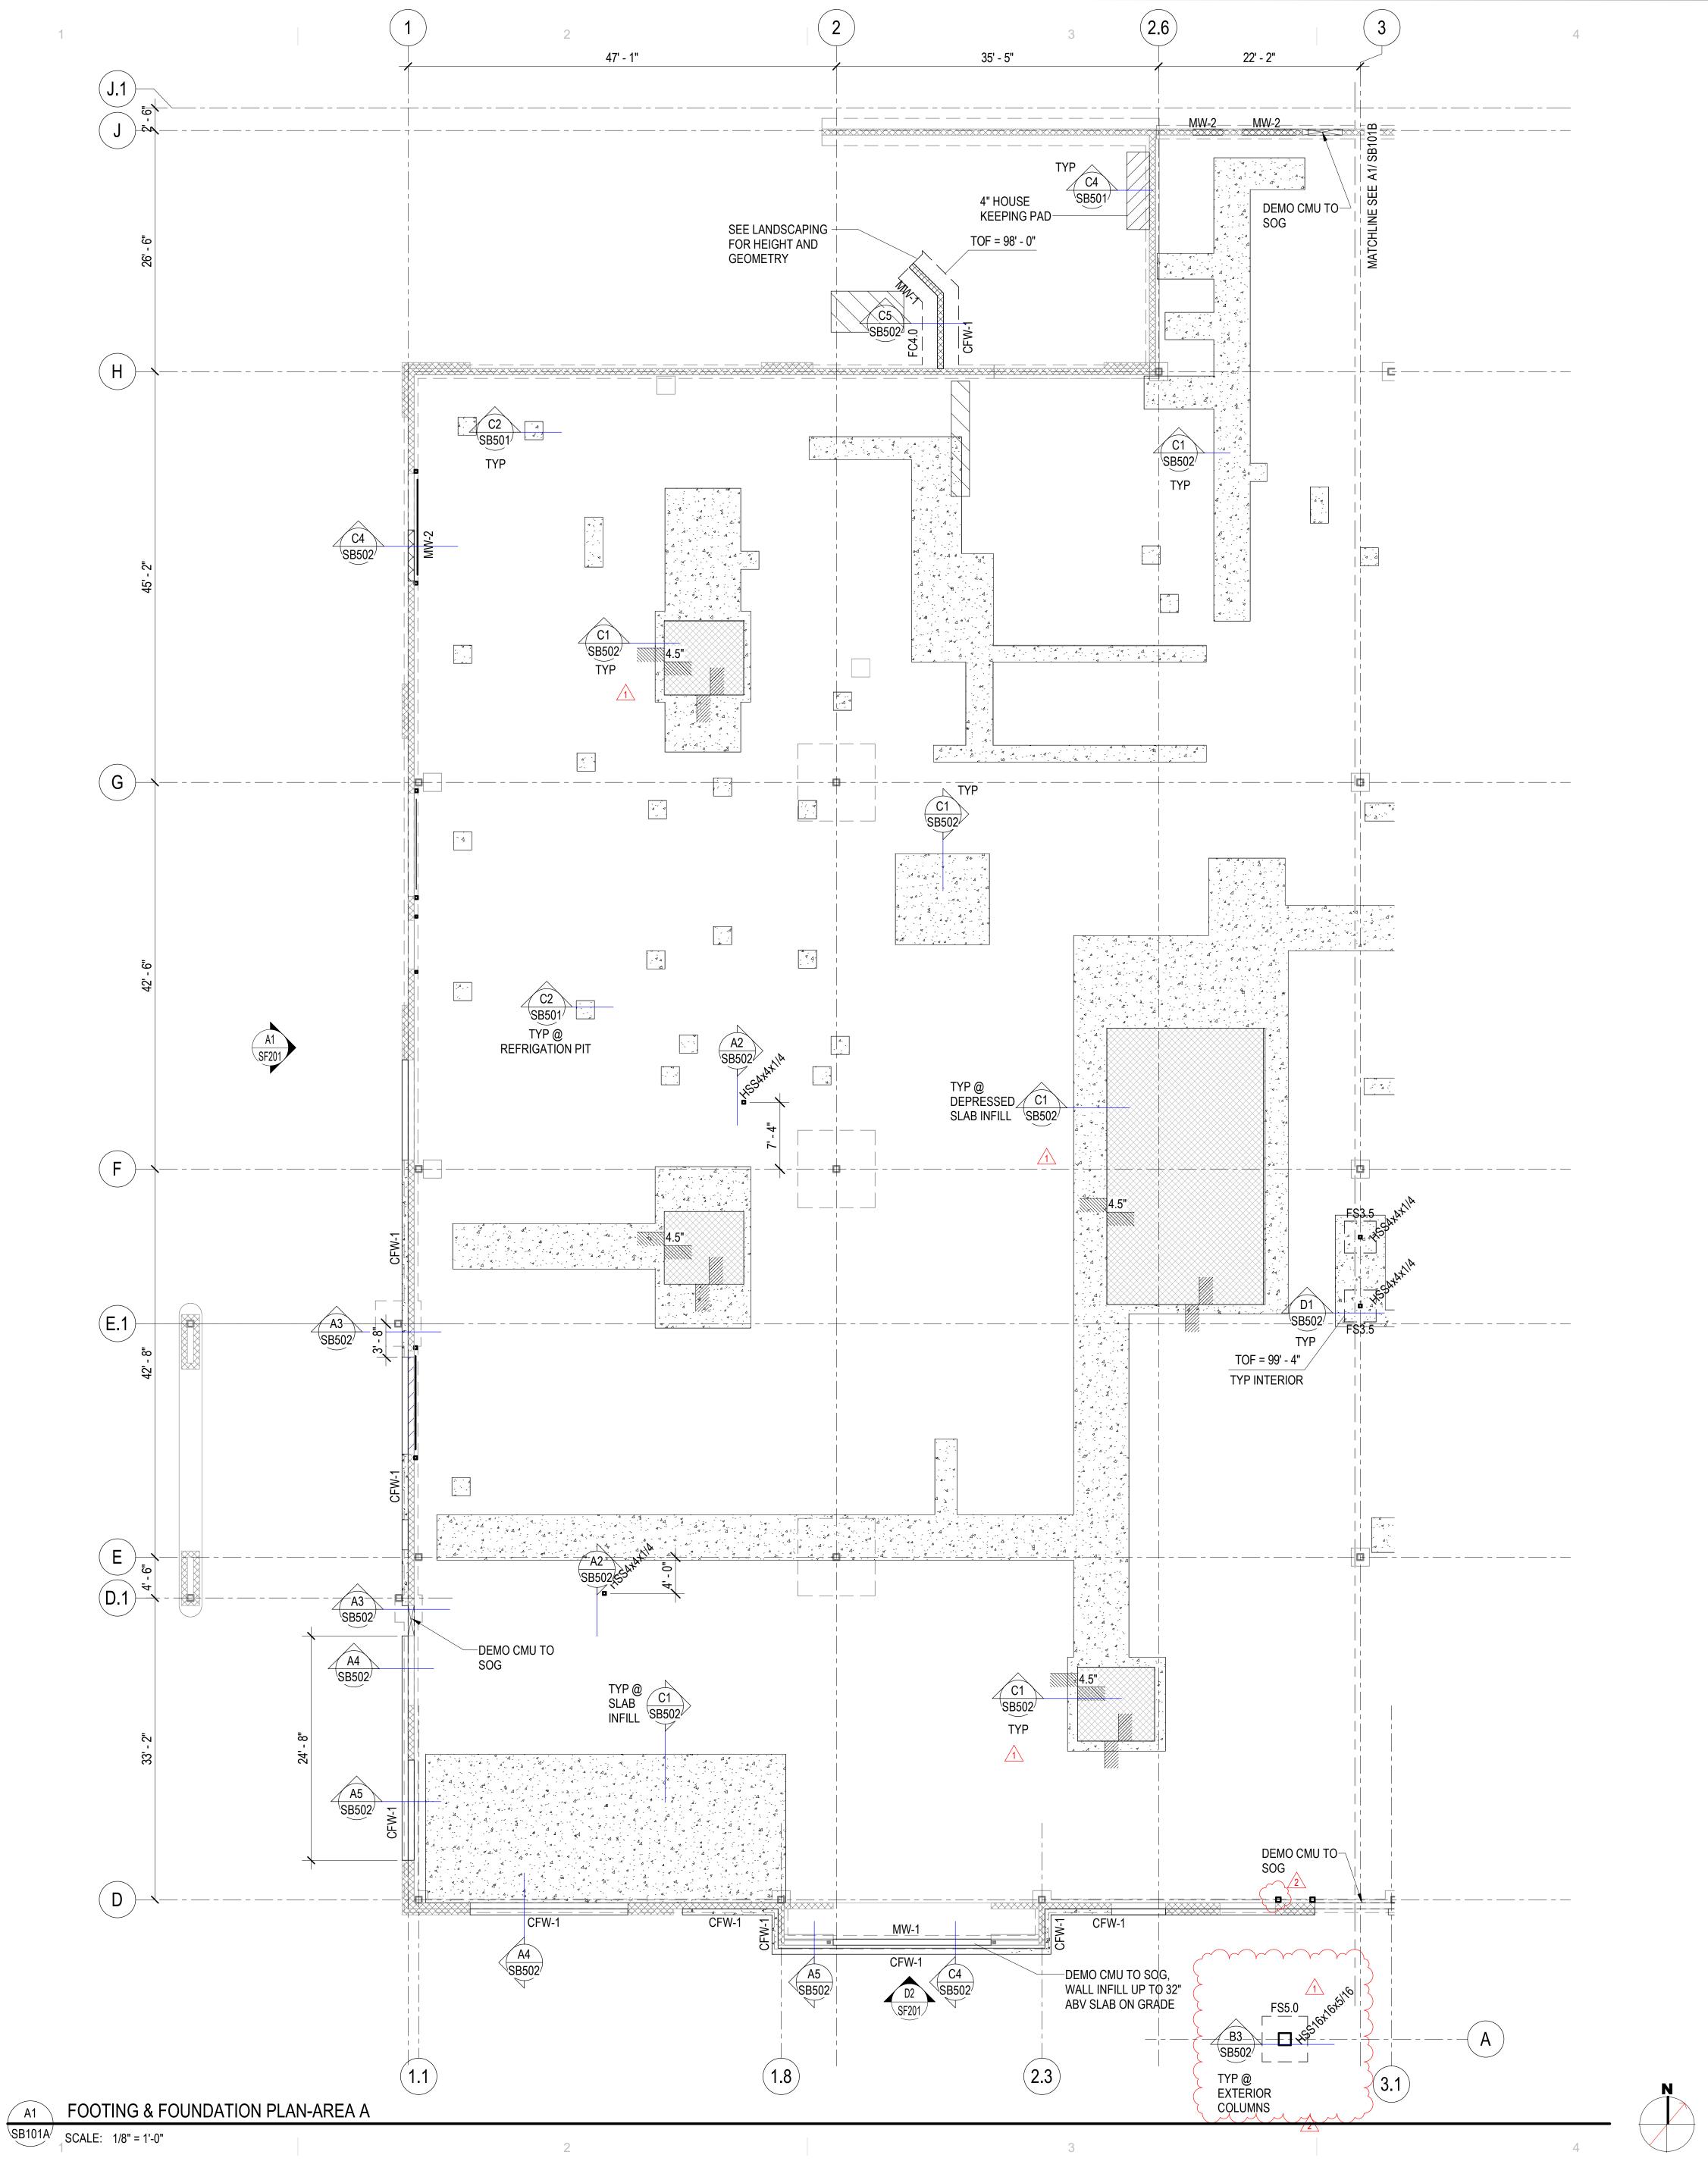



1. SEE ARCHITECTURAL, CIVIL AND LANDSCAPE DRAWINGS FOR EXTERIOR CONCRETE RETAINING AND / OR SITE WALLS NOT SHOWN ON THE STRUCTURAL DRAWINGS.

2. SEE TYPICAL STEP DETAIL AT CONTINUOUS FOOTING AND TYPICAL STEP DETAIL AT MAT FOOTING FOR REINFORCING REQUIREMENTS

3. PROVIDE REINFORCEMENT AT WALL ENDS, INTERSECTIONS AND OPENINGS PER TYPICAL DETAILS D2/SB601 AND C2/SB601.

4. DOWEL ALL CONCRETE WALLS TO FOOTING PER TYPICAL DETAIL C4/SB501.

5. PROVIDE COMPACTED STRUCTURAL FILL UNDER ALL CONCRETE FOOTINGS PER TYPICAL DETAIL A5/SB501.

6. WHERE REQUIRED, DEMO THE EXISTING SLAB ON GRADE AND REPLACE WITH NEW CONCRETE MATCHING THE THICKNESS OF THE EXISTING SLAB PER DETAIL C1/SB502.

7. SBP-# INDICATES THE COLUMN BASEPLATE TYPE. SEE SCHEDULE ON SF602

EXISTING BUILDING NOTES


1. THE CONTRACTOR SHALL FIELD VERIFY ALL EXISTING CONDITIONS PRIOR TO DETAILING, FABRICATING, ERECTING OR INSTALLING ANY STRUCTURAL ELEMENT. ALL DISCREPANCIES SHALL BE BROUGHT TO THE ATTENTION OF THE DESIGN TEAM IN A TIMELY MANNER SUCH THAT WORK WILL NOT BE DELAYED.

2. THE CONTRACTOR SHALL PROVIDE ADEQUATE SHORING OF EXISTING STRUCTURE DURING CONSTRUCTION.

3. INFILL ROOF DECK OPENINGS, SEE TYP DETAIL B3/SF503.



MHTN Architects, Inc. 280 South 400 West Suite 250 Salt Lake City, Utah 84101 Telephone (801) 595-6700 www.mhtn.com

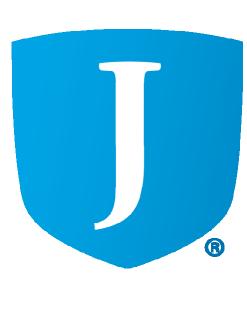

ORDAN LEARNING CENTER

©2023 MHTN ARCHITECTS, INC.

Confidentiality Notice:
This document is intended for use on the Project identified herein by individuals and companies involved in the design, permitting, bidding and construction of the Project. MHTN Architects, Inc. grants limited rights to distribute and reproduce this document for this express purpose only. Distribution, printing or copying this document for purposes other than those indicated is strictly prohibited. If a digital copy of this document is received in error, please delete it.

мнти ркојест no. 2024528

NO.△ DATE 1 09/06/24 2 09/13/24

REVISIONS CONTRACTOR TO VERIFY DRAWINGS IN FIELD USE REFLECT LAST REVISION DATE.


A	В

KEY PLAN

CONSTRUCTION DOCUMENTS 100% 08/29/24

FOOTING AND FOUNDATION PLAN-AREA A

SB101A

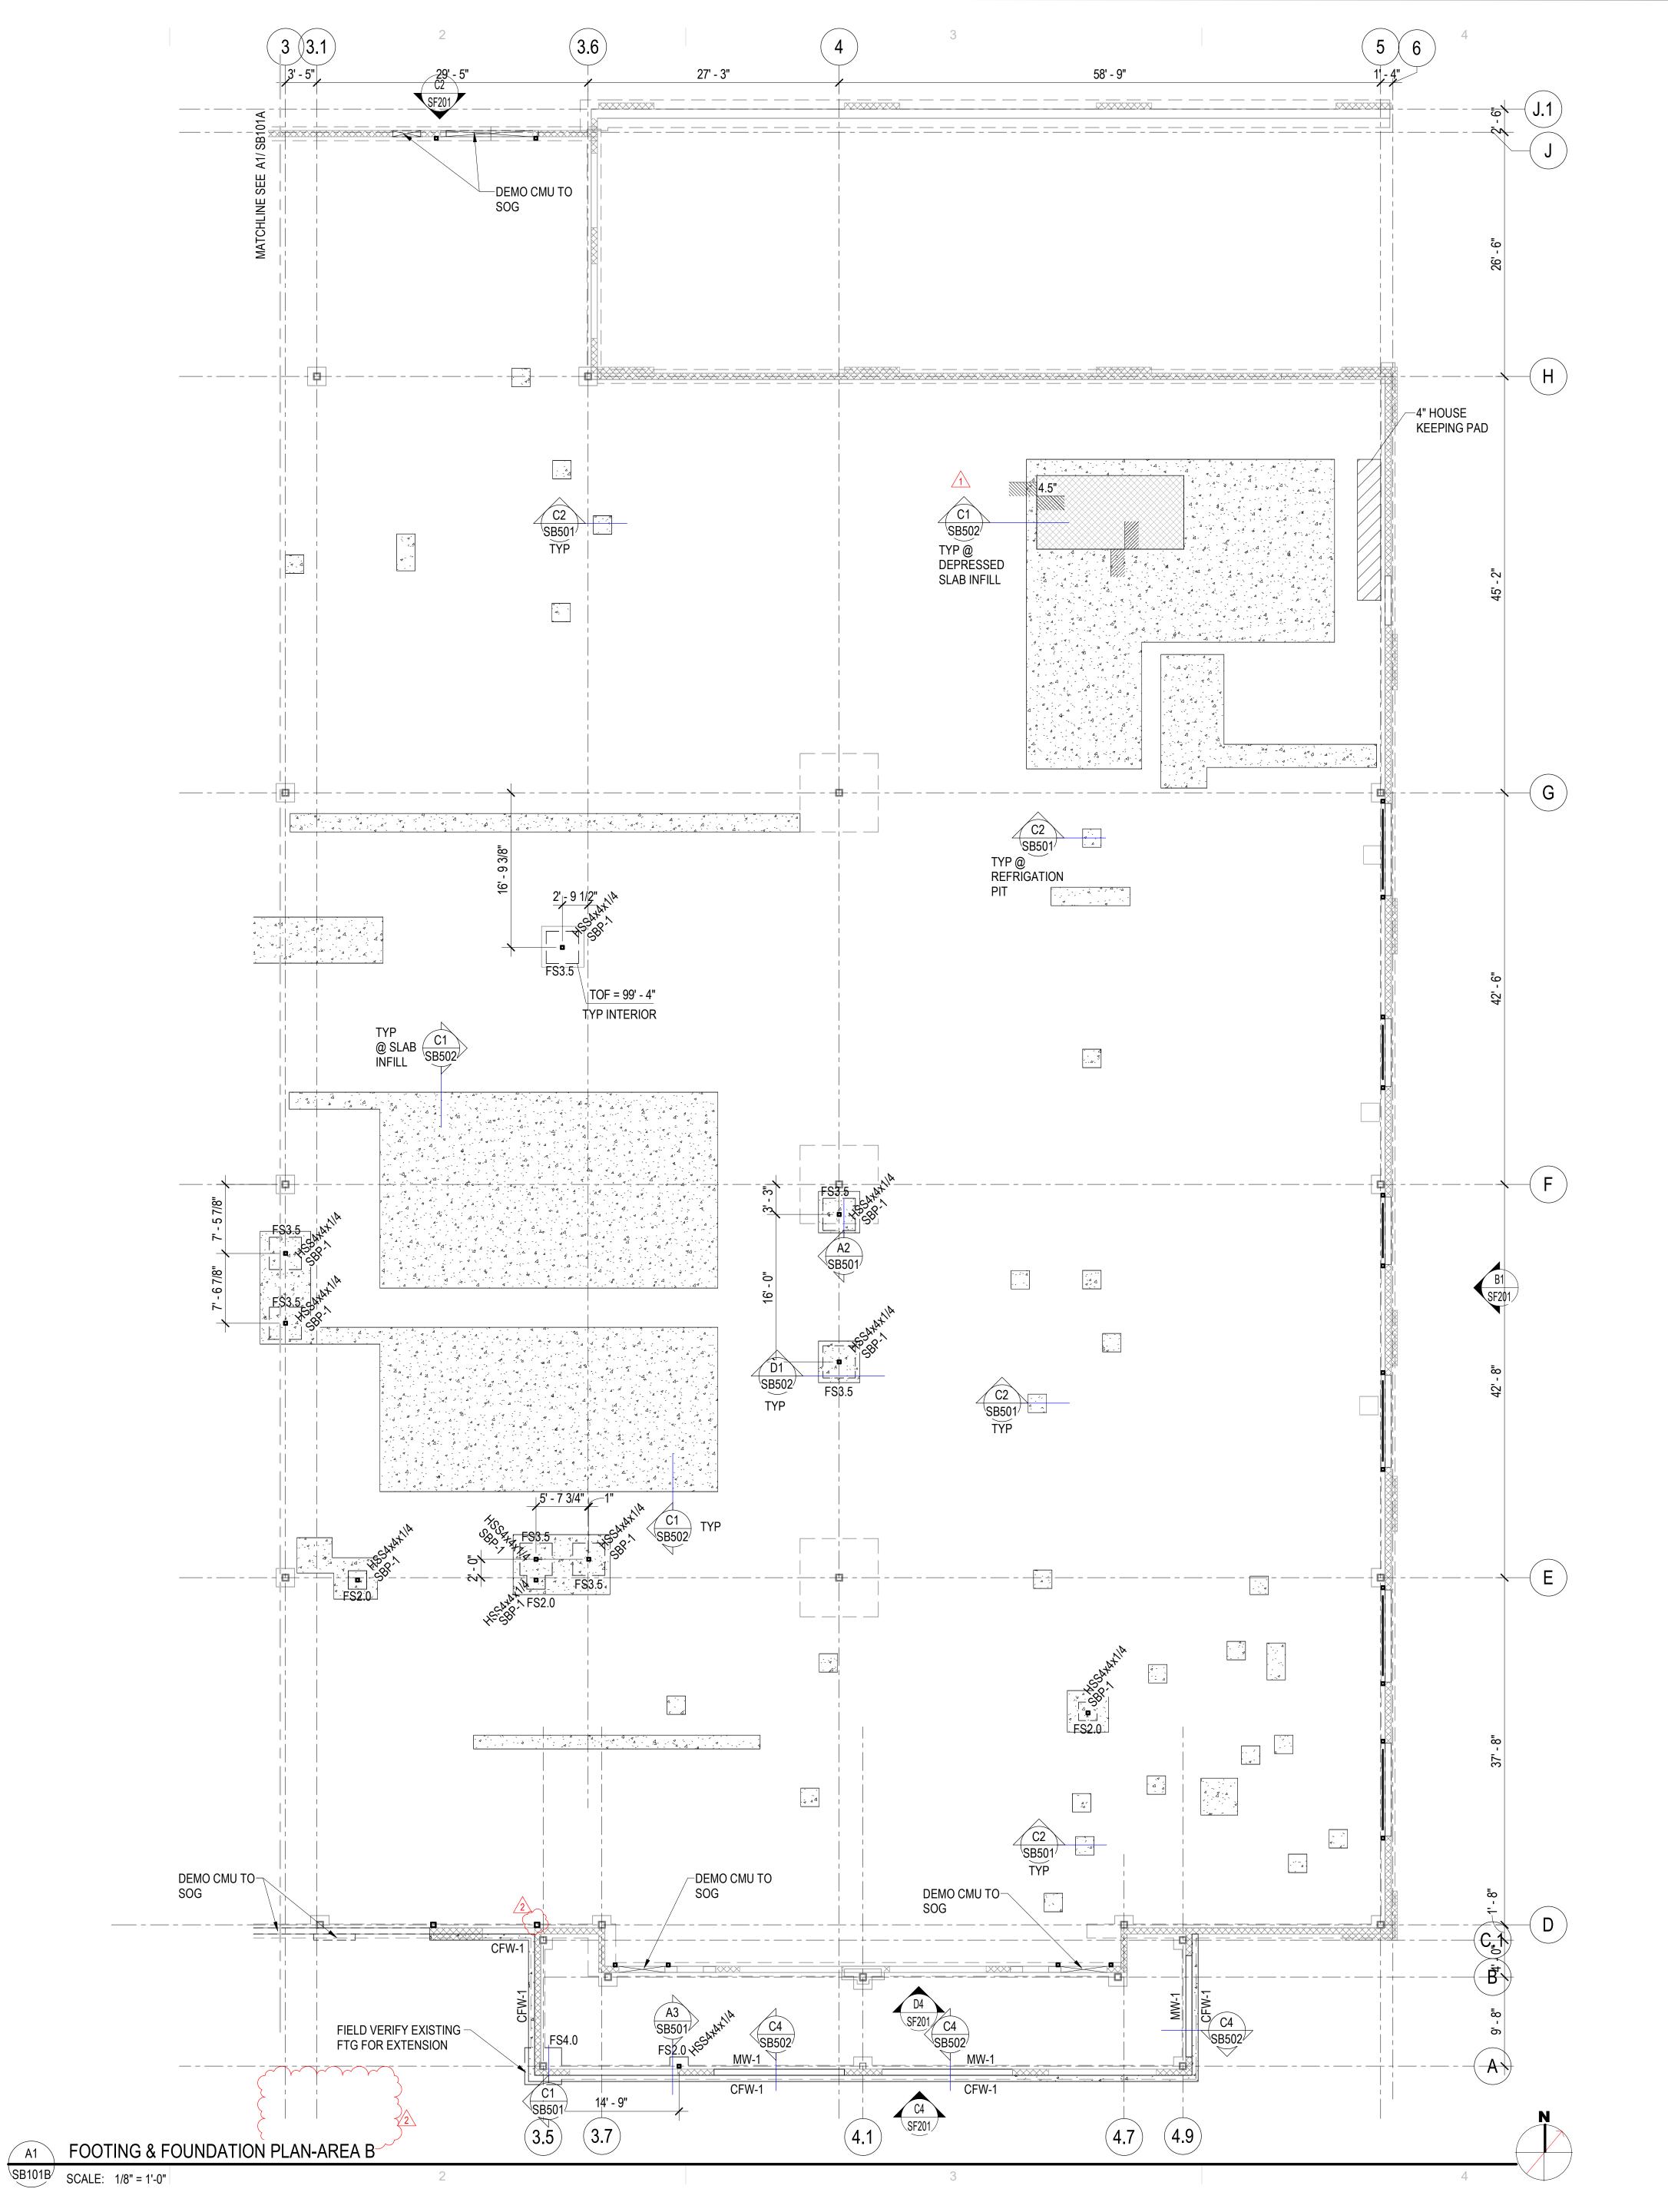

FOOTING & FOUNDATION PLAN NOTES

3. PROVIDE REINFORCEMENT AT WALL ENDS, INTERSECTIONS AND OPENINGS PER TYPICAL

4. DOWEL ALL CONCRETE WALLS TO FOOTING PER

5. PROVIDE COMPACTED STRUCTURAL FILL UNDER

6. WHERE REQUIRED, DEMO THE EXISTING SLAB ON

MATCHING THE THICKNESS OF THE EXISTING SLAB

7. SBP-# INDICATES THE COLUMN BASEPLATE TYPE.

ALL CONCRETE FOOTINGS PER TYPICAL DETAIL

GRADE AND REPLACE WITH NEW CONCRETE

DETAILS D2/SB601 AND C2/SB601.

TYPICAL DETAIL C4/SB501.

PER DETAIL C1/SB502.

SEE SCHEDULE ON SF602

A5/SB501.

STRUCTURAL DRAWINGS.


1. SEE ARCHITECTURAL, CIVIL AND LANDSCAPE

DRAWINGS FOR EXTERIOR CONCRETE RETAINING

ARCHITECTS

MHTN Architects, Inc. 280 South 400 West Suite 250 Salt Lake City, Utah 84101 Telephone (801) 595-6700 www.mhtn.com

AND / OR SITE WALLS NOT SHOWN ON THE 2. SEE TYPICAL STEP DETAIL AT CONTINUOUS FOOTING AND TYPICAL STEP DETAIL AT MAT FOOTING FOR REINFORCING REQUIREMENTS

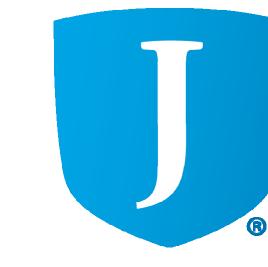

EXISTING BUILDING NOTES

1. THE CONTRACTOR SHALL FIELD VERIFY ALL EXISTING CONDITIONS PRIOR TO DETAILING, FABRICATING, ERECTING OR INSTALLING ANY STRUCTURAL ELEMENT. ALL DISCREPANCIES SHALL BE BROUGHT TO THE ATTENTION OF THE DESIGN TEAM IN A TIMELY MANNER SUCH THAT WORK WILL NOT BE DELAYED.

2. THE CONTRACTOR SHALL PROVIDE ADEQUATE SHORING OF EXISTING STRUCTURE DURING CONSTRUCTION.

3. INFILL ROOF DECK OPENINGS, SEE TYP DETAIL B3/SF503.

©2023 MHTN ARCHITECTS, INC. Confidentiality Notice:
This document is intended for use on the Project identified herein by individuals and companies involved in the design, permitting, bidding and construction of the Project. MHTN Architects, Inc. grants limited rights to distribute and reproduce this document for this express purpose only. Distribution, printing or copying this document for purposes other than those indicated is strictly prohibited. If a digital copy of this document is received in error, please delete it.


МН	TN PROJE	CT NO.	202452

REVISIONS CONTRACTOR TO VERIFY DRAWINGS IN FIELD USE REFLECT LAST REVISION DATE.

CONSTRUCTION DOCUMENTS 100%

FOOTING & FOUNDATION PLAN-AREA B

SB101B

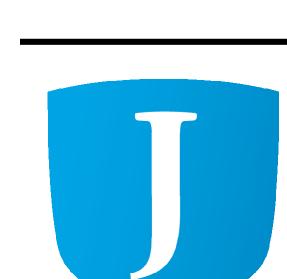

ARCHITECTS

280 South 400 West

Salt Lake City, Utah 84101 Telephone (801) 595-6700

Suite 250

www.mhtn.com

MHTN Architects, Inc.



RNIN

-DOWELS TO MATCH

-CONC FDTN WALL

WALL REINF

-HORIZ CONC FDTN

-ROUGHEN JOINT TO

1/4" AMPLITUDE

-CONC FOOTING

REINF

44

VERT MASONRY WALL

က တ ©2023 MHTN ARCHITECTS, INC. Confidentiality Notice: This document is intended for use on the Project identified herein by individuals and companies involved in the design, permitting, bidding and construction of the Project. MHTN Architects, Inc. grants limited rights to distribute and reproduce this document for this express purpose only. Distribution, printing or copying this document for purposes other than those indicated is strictly prohibited. If a digital copy of this document is received in error, please delete it.

MHTN PROJECT NO. 2024528 Original drawing is 30 x 42. Do not scale contents of this drawing. CONTRACTOR TO VERIFY DRAWINGS IN FIELD USE REFLECT LAST REVISION DATE. NO.△ DATE 1 09/06/24 2 09/13/24


CONSTRUCTION DOCUMENTS 100% 08/29/24

TYPICAL FOOTING & FOUNDATION DETAILS

SB502


TYPICAL STEEL COLUMN CONNECTION TO CONCRETE FOOTING/CONCRETE PIER

SB502 NO SCALE

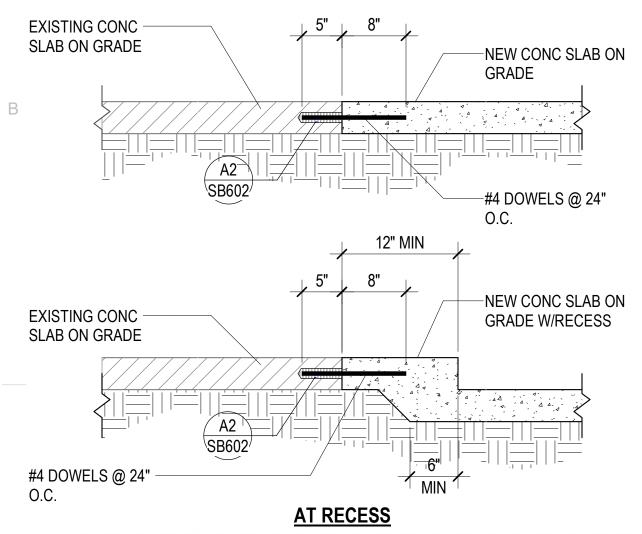


TYPICAL NEW SLAB ON GRADE CONNECTION TO (c1) EXISTING CONCRETE SLAB ON GRADE

SB502/ NO SCALE

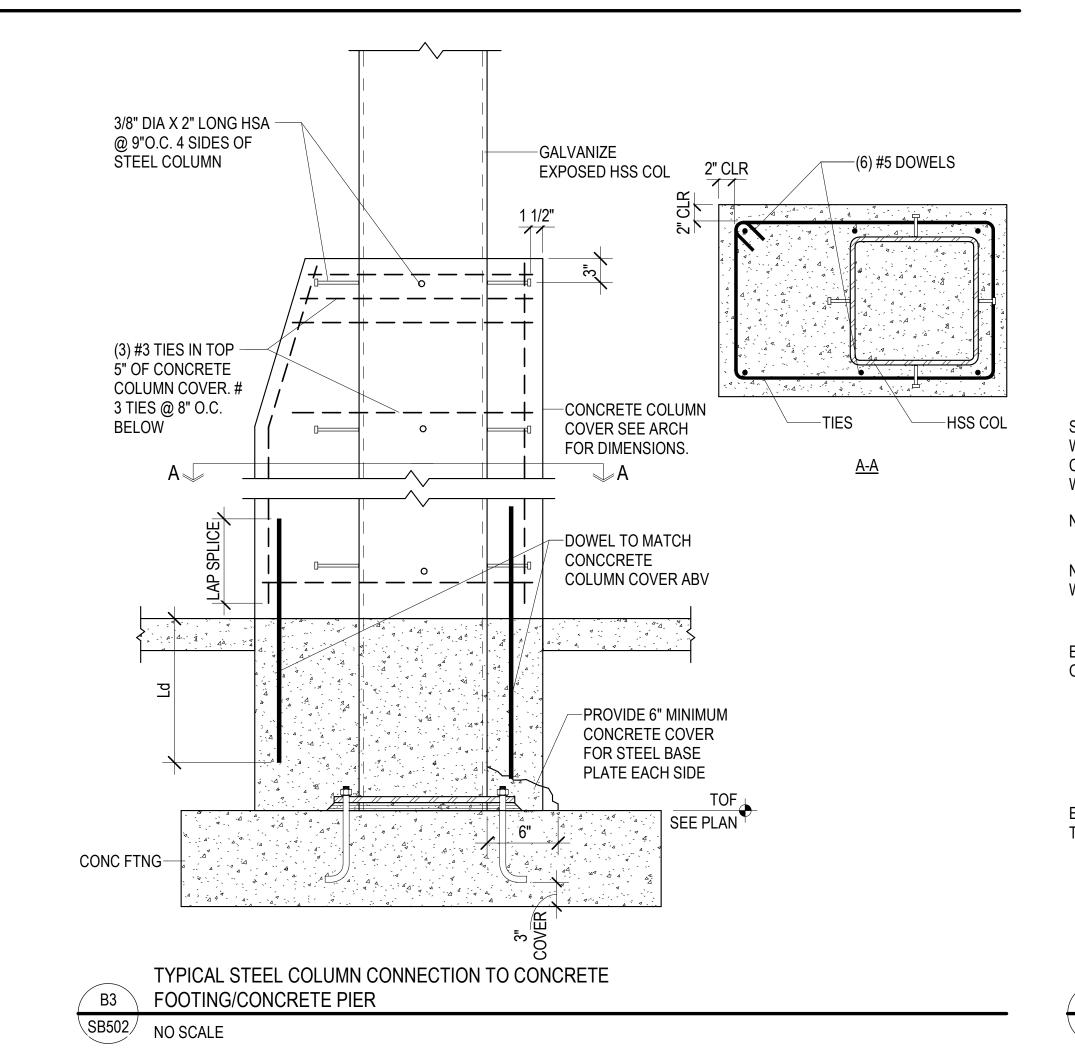

1. REMOVE SIDEWALK CONCRETE -

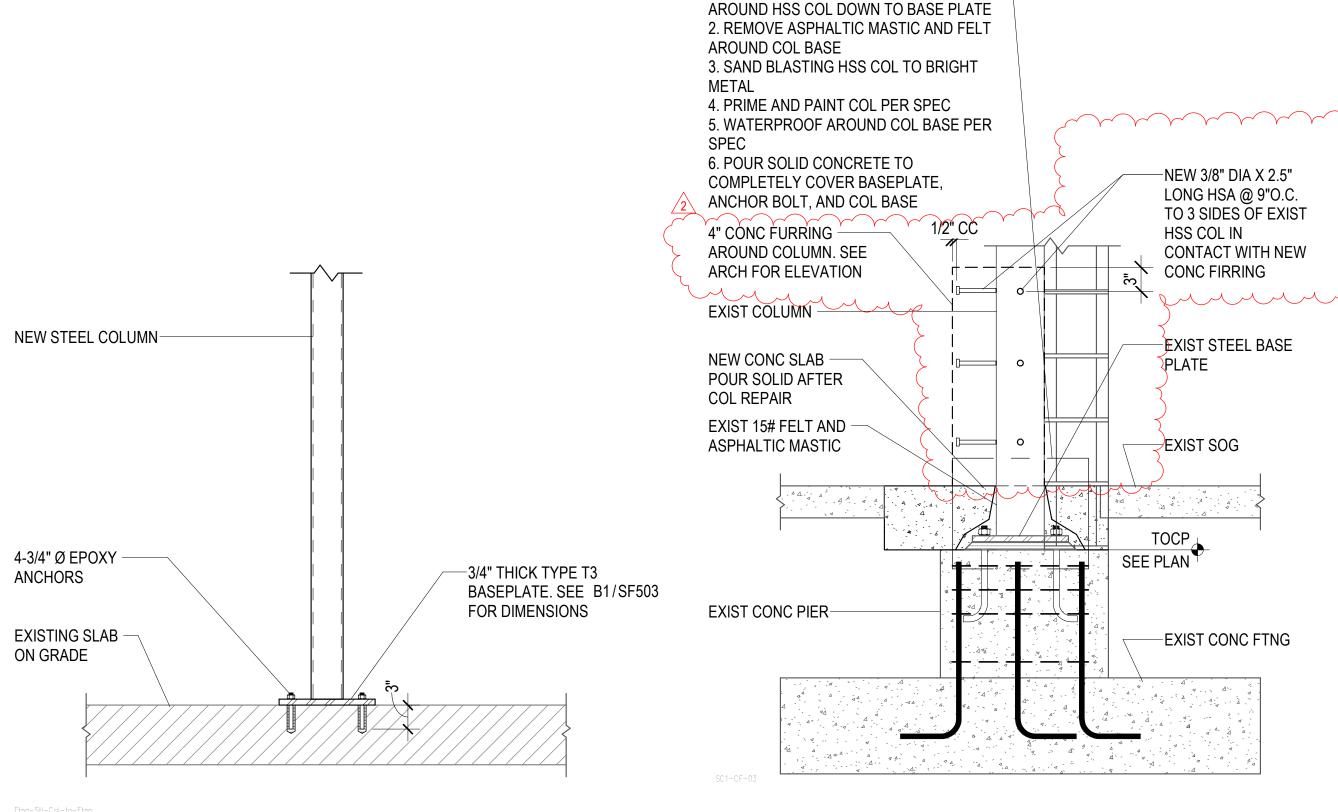


SB502 NO SCALE

NEW TUBE COLUMN CONNECTION TO EXISTING SLAB ON


A2 GRADE

SB502 NO SCALE

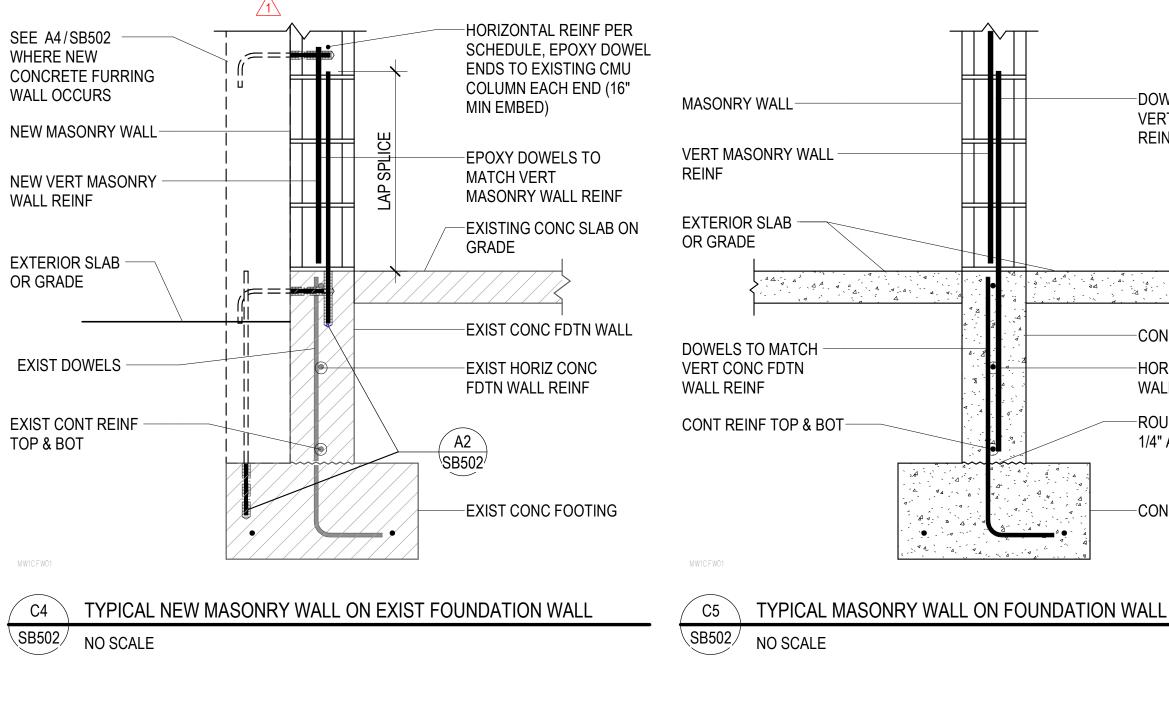

MASONRY WALL CUT DOWN ON EXIST FOUNDATION WALL


SB502 NO SCALE

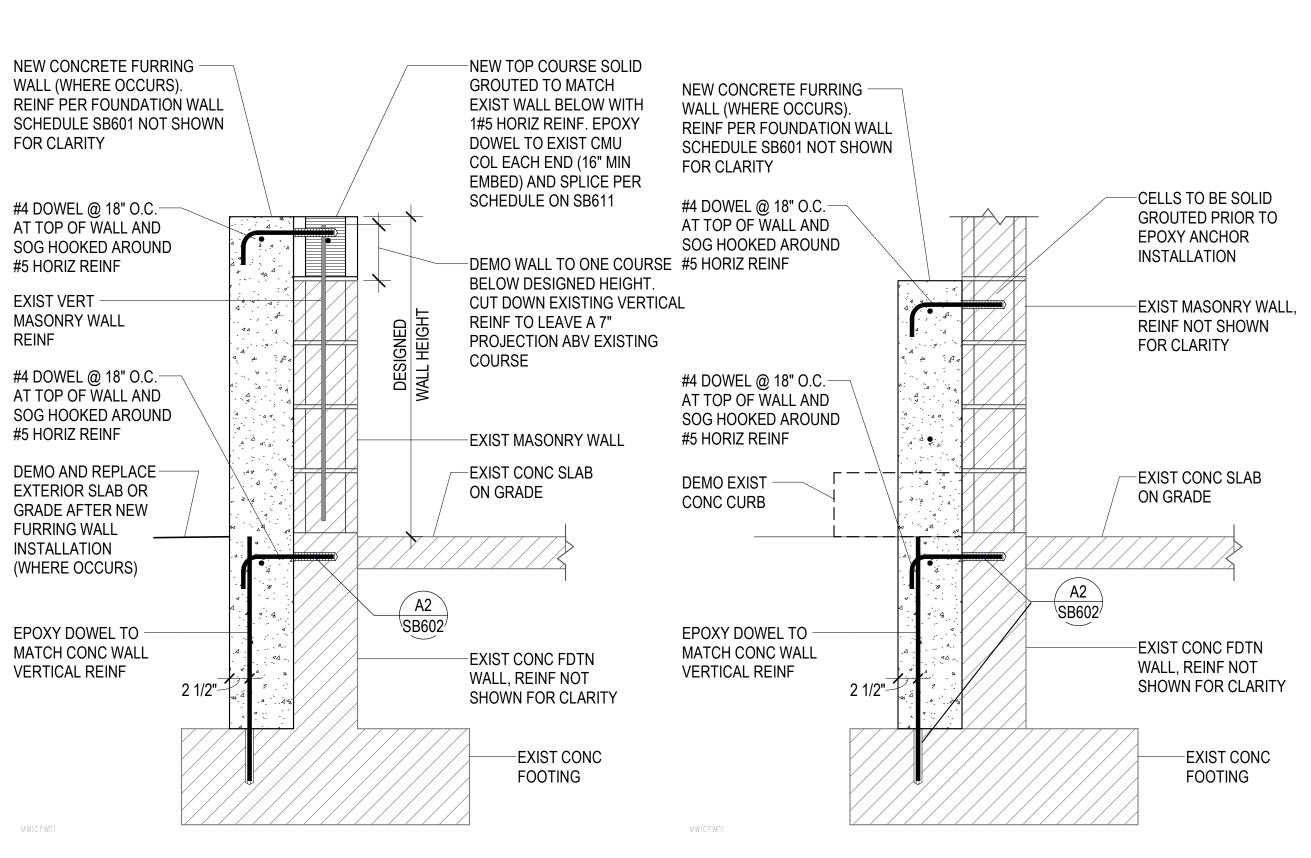

SB502 NO SCALE

A5 NEW FURRING CONC WALL TO EXISTING CMU WALL

A3 RUST REPAIR ON EXIST EXTERIOR HSS COLUMN

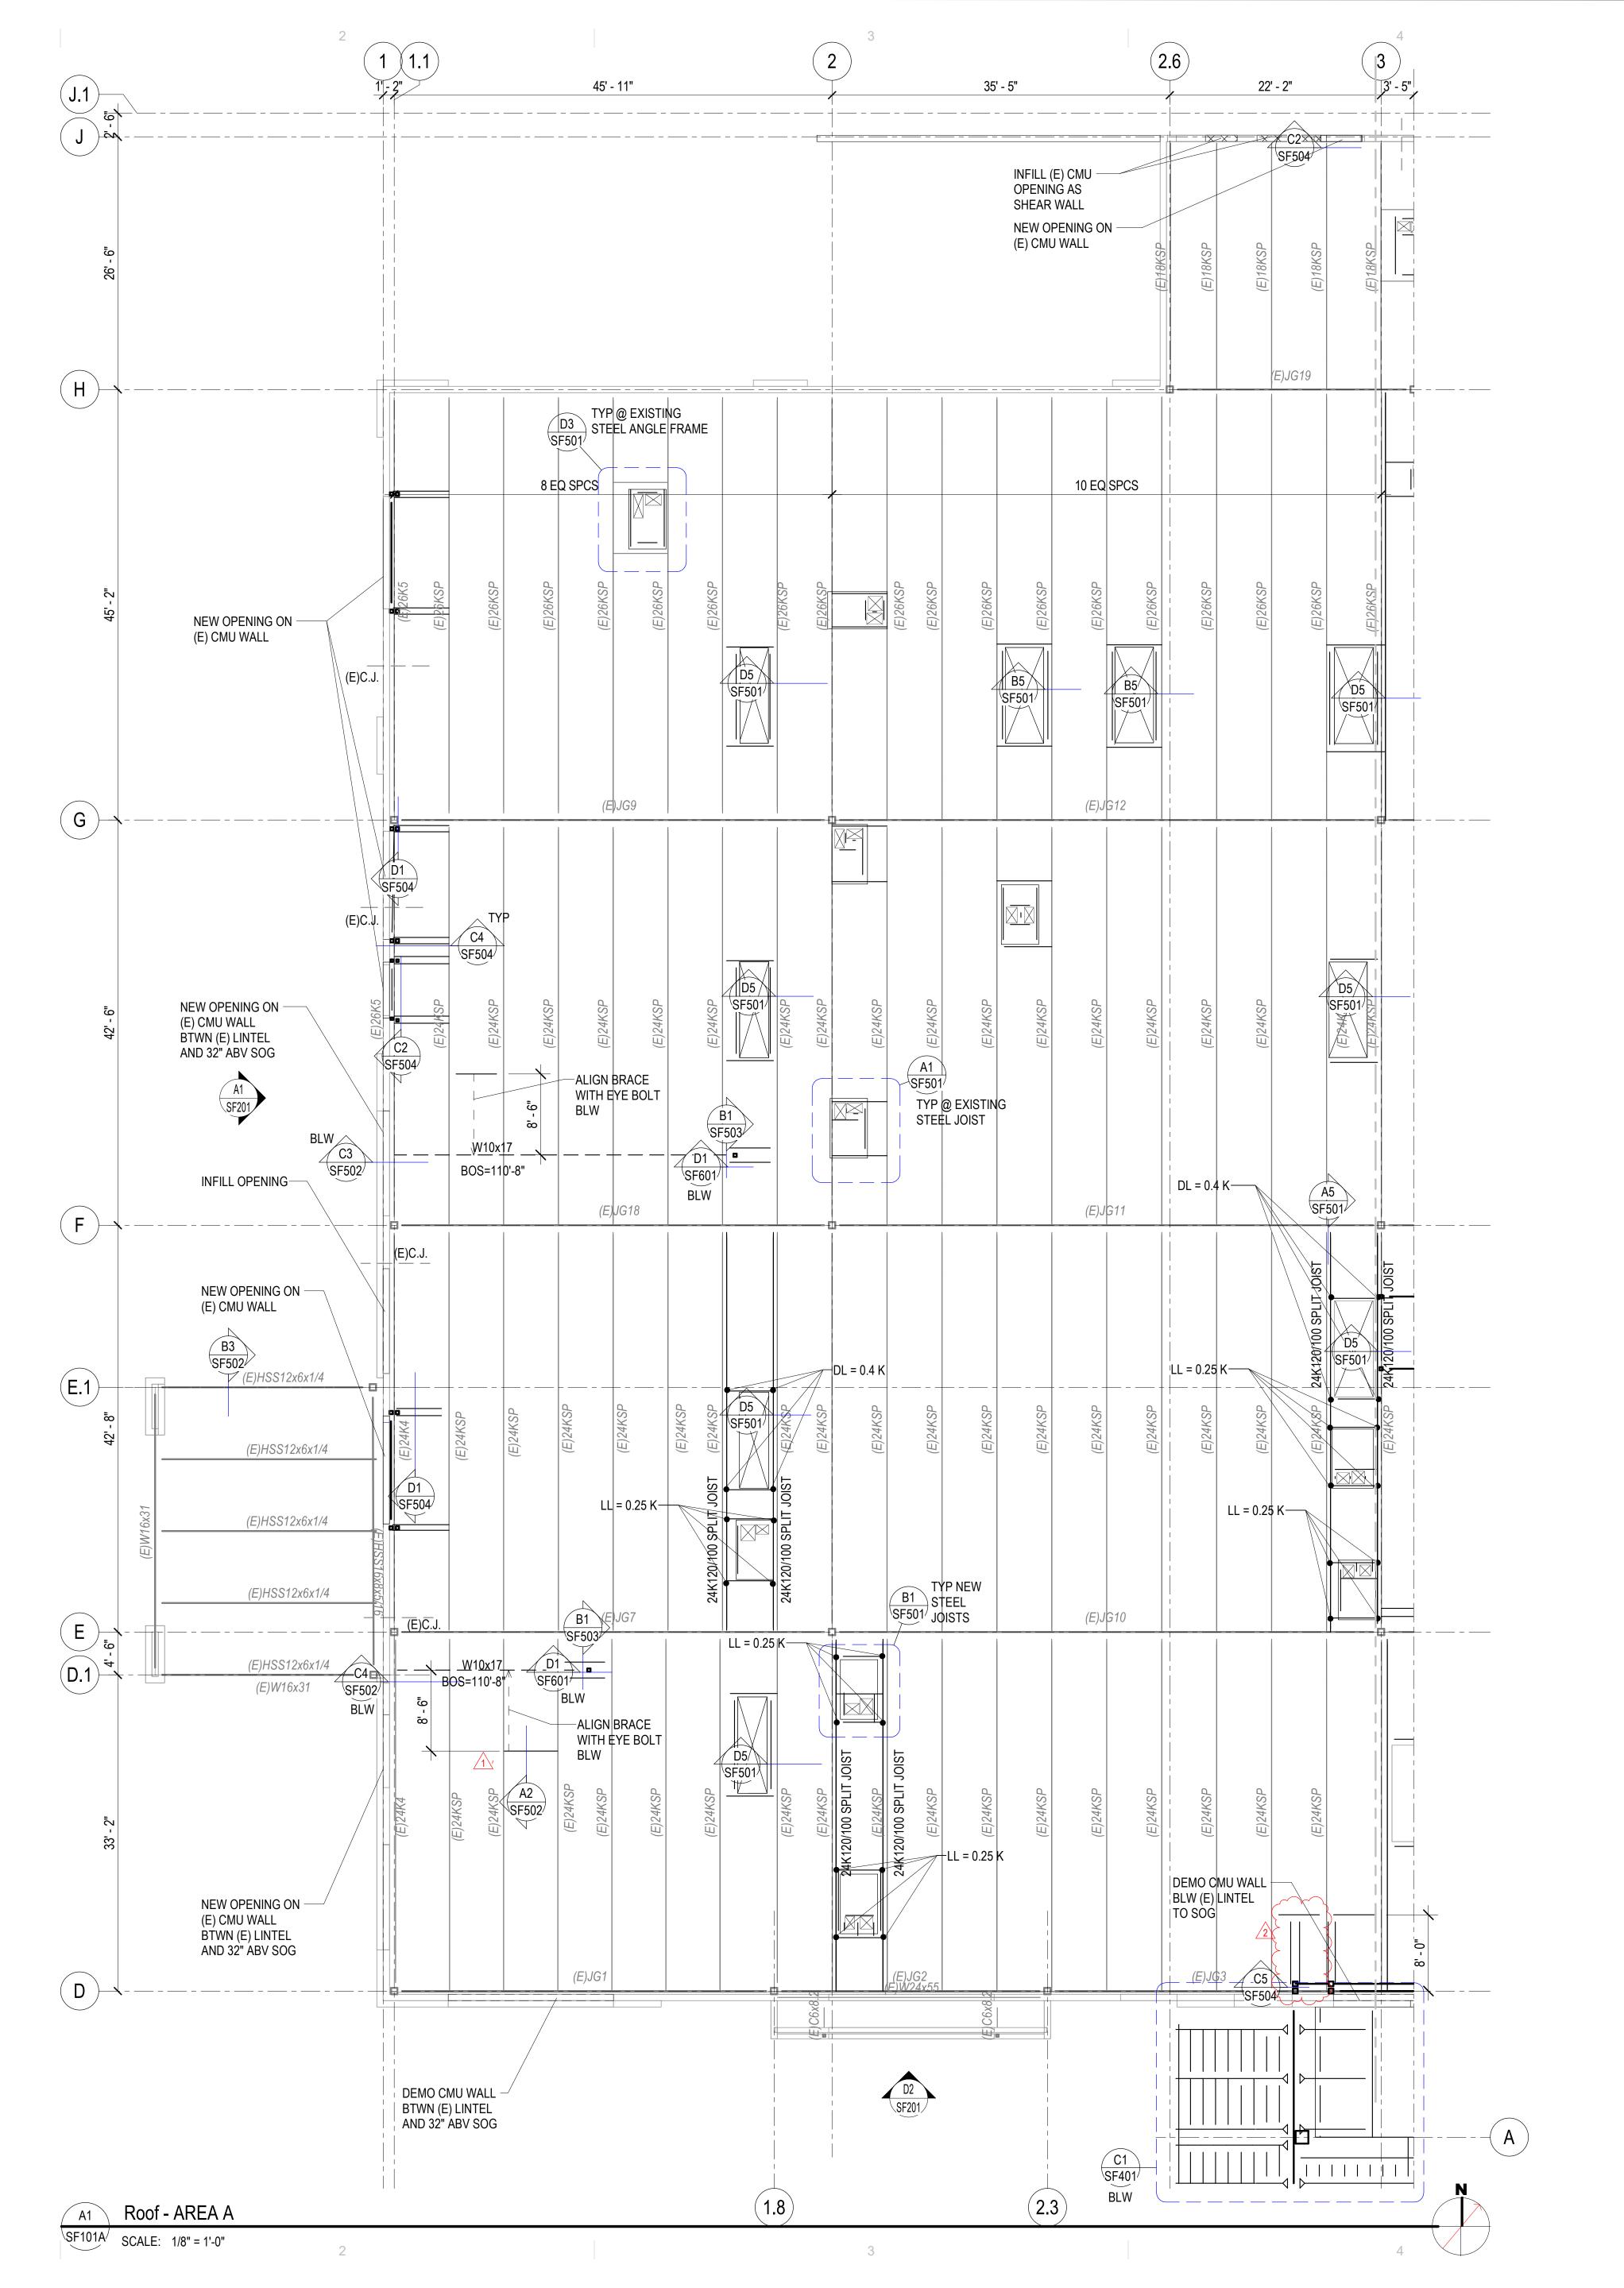

ROOF FRAMING PLAN NOTES

1. SEE ARCHITECTURAL FOR ROOF SLOPES AND



MHTN Architects, Inc. 280 South 400 West Suite 250 Salt Lake City, Utah 84101 Telephone (801) 595-6700 www.mhtn.com

EXISTING BUILDING NOTES

1. THE CONTRACTOR SHALL FIELD VERIFY ALL EXISTING CONDITIONS PRIOR TO DETAILING, FABRICATING, ERECTING OR INSTALLING ANY STRUCTURAL ELEMENT. ALL DISCREPANCIES SHALL BE BROUGHT TO THE ATTENTION OF THE DESIGN TEAM IN A TIMELY MANNER SUCH THAT WORK WILL NOT BE DELAYED.

2. THE CONTRACTOR SHALL PROVIDE ADEQUATE SHORING OF EXISTING STRUCTURE DURING CONSTRUCTION.

3. INFILL ROOF DECK OPENINGS, SEE TYP DETAIL B3/SF503.

NON-COMPOSITE FRAMING PLAN NOTES

1. SEE STEEL DECK SCHEDULE ON SHEET SF602 FOR DECK PROFILE AND DECK ATTACHMENT REQUIREMENTS.

2. FOR ROUND OPENINGS LESS THAN 12 INCHES IN DIAMETER SEE DETAILD2/SF501

3. VERIFY SIZE WEIGHT, LOCATION AND CONFIGURATION OF ALL ROOF TOP EQUIPMENT WITH ARCHITECT AND MECHANICAL ENGINEER. PROVIDE STEEL FRAMES FOR SUPPORT OF ROOF TOP EQUIPMENT PER DETAIL D3/SF501 AT EXISTING STEEL ANGLE FRAMES, B1/SF501 AT NEW JOISTS, AND A1/SF501 AT EXISTING JOISTS. COORDINATE OPENINGS WITH MECHANICAL & ELECTRICAL.

OPEN WEB JOIST FRAMING PLAN NOTES

1. OPEN WEB STEEL JOISTS AND JOIST GIRDERS SHALL BE DESIGNED BY THE MANUFACTURER TO SUPPORT THE MECHANICAL AND LATERAL LOADS SHOWN ON THE ROOF FRAMING PLANS IN ADDITION TO THE UNIFORM AND POINT LOADS SHOWN. LOADS SHOWN ARE ASD UNO

2. ±#.##k – INDICATES POINT LOAD ON STEEL JOIST IN ADDITION TO UNIFORM LOADING SHOWN. + INDICATES DOWNWARD AND - INDICATES UPWARD LOADS. LOADS SHOWN ARE UNFACTORED, UNO.

3. T/C X.XXK INDICATES ADDITIONAL TOP CHORD AXIAL FORCE ON STEEL JOIST OR GIRDER. THIS FORCE IS A FACTORED SEISMIC LOAD THAT SHALL BE CONSIDERED IN BOTH TENSION AND COMPRESSION AND INCLUDES APPLICABLE OVERSTRENGTH FACTORS PER THE GOVERNING BUILDING CODE. STEEL JOISTS AND GIRDERS WITH T/C FORCE SHALL BE DESIGNED AS COLLECTOR ELEMENTS.

4. ALL LOADS SUPPORTED BY OPEN WEB STEEL JOISTS AND GIRDERS SHALL BE LOCATED WITHIN 6" OF JOIST OR GIRDER PANEL POINT OR THE JOIST OR GIRDER SHALL BE REINFORCED PER DETAIL B4/SF501.

5. HORIZONTAL CROSS BRIDGING SHALL BE SIZED AND SUPPLIED BY THE JOIST MANUFACTURER. CONNECT TO WALLS AS INDICATED ON DETAILS


6. WHERE SKYLIGHTS OR MECHANICAL UNITS INTERRUPT HORIZONTAL BRIDGING, PROVIDE CROSS BRIDGING AT JOIST SPACES ON EACH SIDE, TYP.

7. ALL OPEN WEB STEEL JOISTS WITH A SLOPE OF 3/8" PER FOOT OR LARGER SHALL HAVE SLOPED BEARING SEATS.

8 OPEN WEB STEEL JOISTS AT ROOF AREAS SHALL BE DESIGNED FOR THE FOLLOWING WIND ASD NET UPLIFT LOADS: 19 PSF WITHIN 11.4 FT OF ROOF

9. PROVIDE SPLICE CONNECTION NEAR MIDSPAN OF NEW JOISTS FOR INSTALLATION.

EDGES, 11 PSF AT ALL OTHER AREAS.

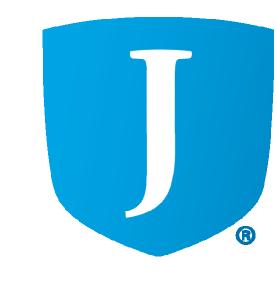

RC

ORDAN LEARNING CENTER

©2023 MHTN ARCHITECTS, INC.

Confidentiality Notice:
This document is intended for use on the Project identified herein by individuals and companies involved in the design, permitting, bidding and construction of the Project. MHTN Architects, Inc. grants limited rights to distribute and reproduce this document for this express purpose only. Distribution, printing or copying this document for purposes other than those indicated is strictly prohibited. If a digital copy of this document is received in error, please delete it.

က

		 _	 		20	2	4 5	_


Original d	rawing is 30 x 42.	Do not scale contents of this drawing.
		FY DRAWINGS IN FIELD USE REFLE
NO \wedge	DATE	DESCRIPTION

1 09/06/24 X1 2 09/13/24 X2

ISSUE CONSTRUCTION DOCUMENTS 100%

ROOF FRAMING PLAN- AREA A

SF101A

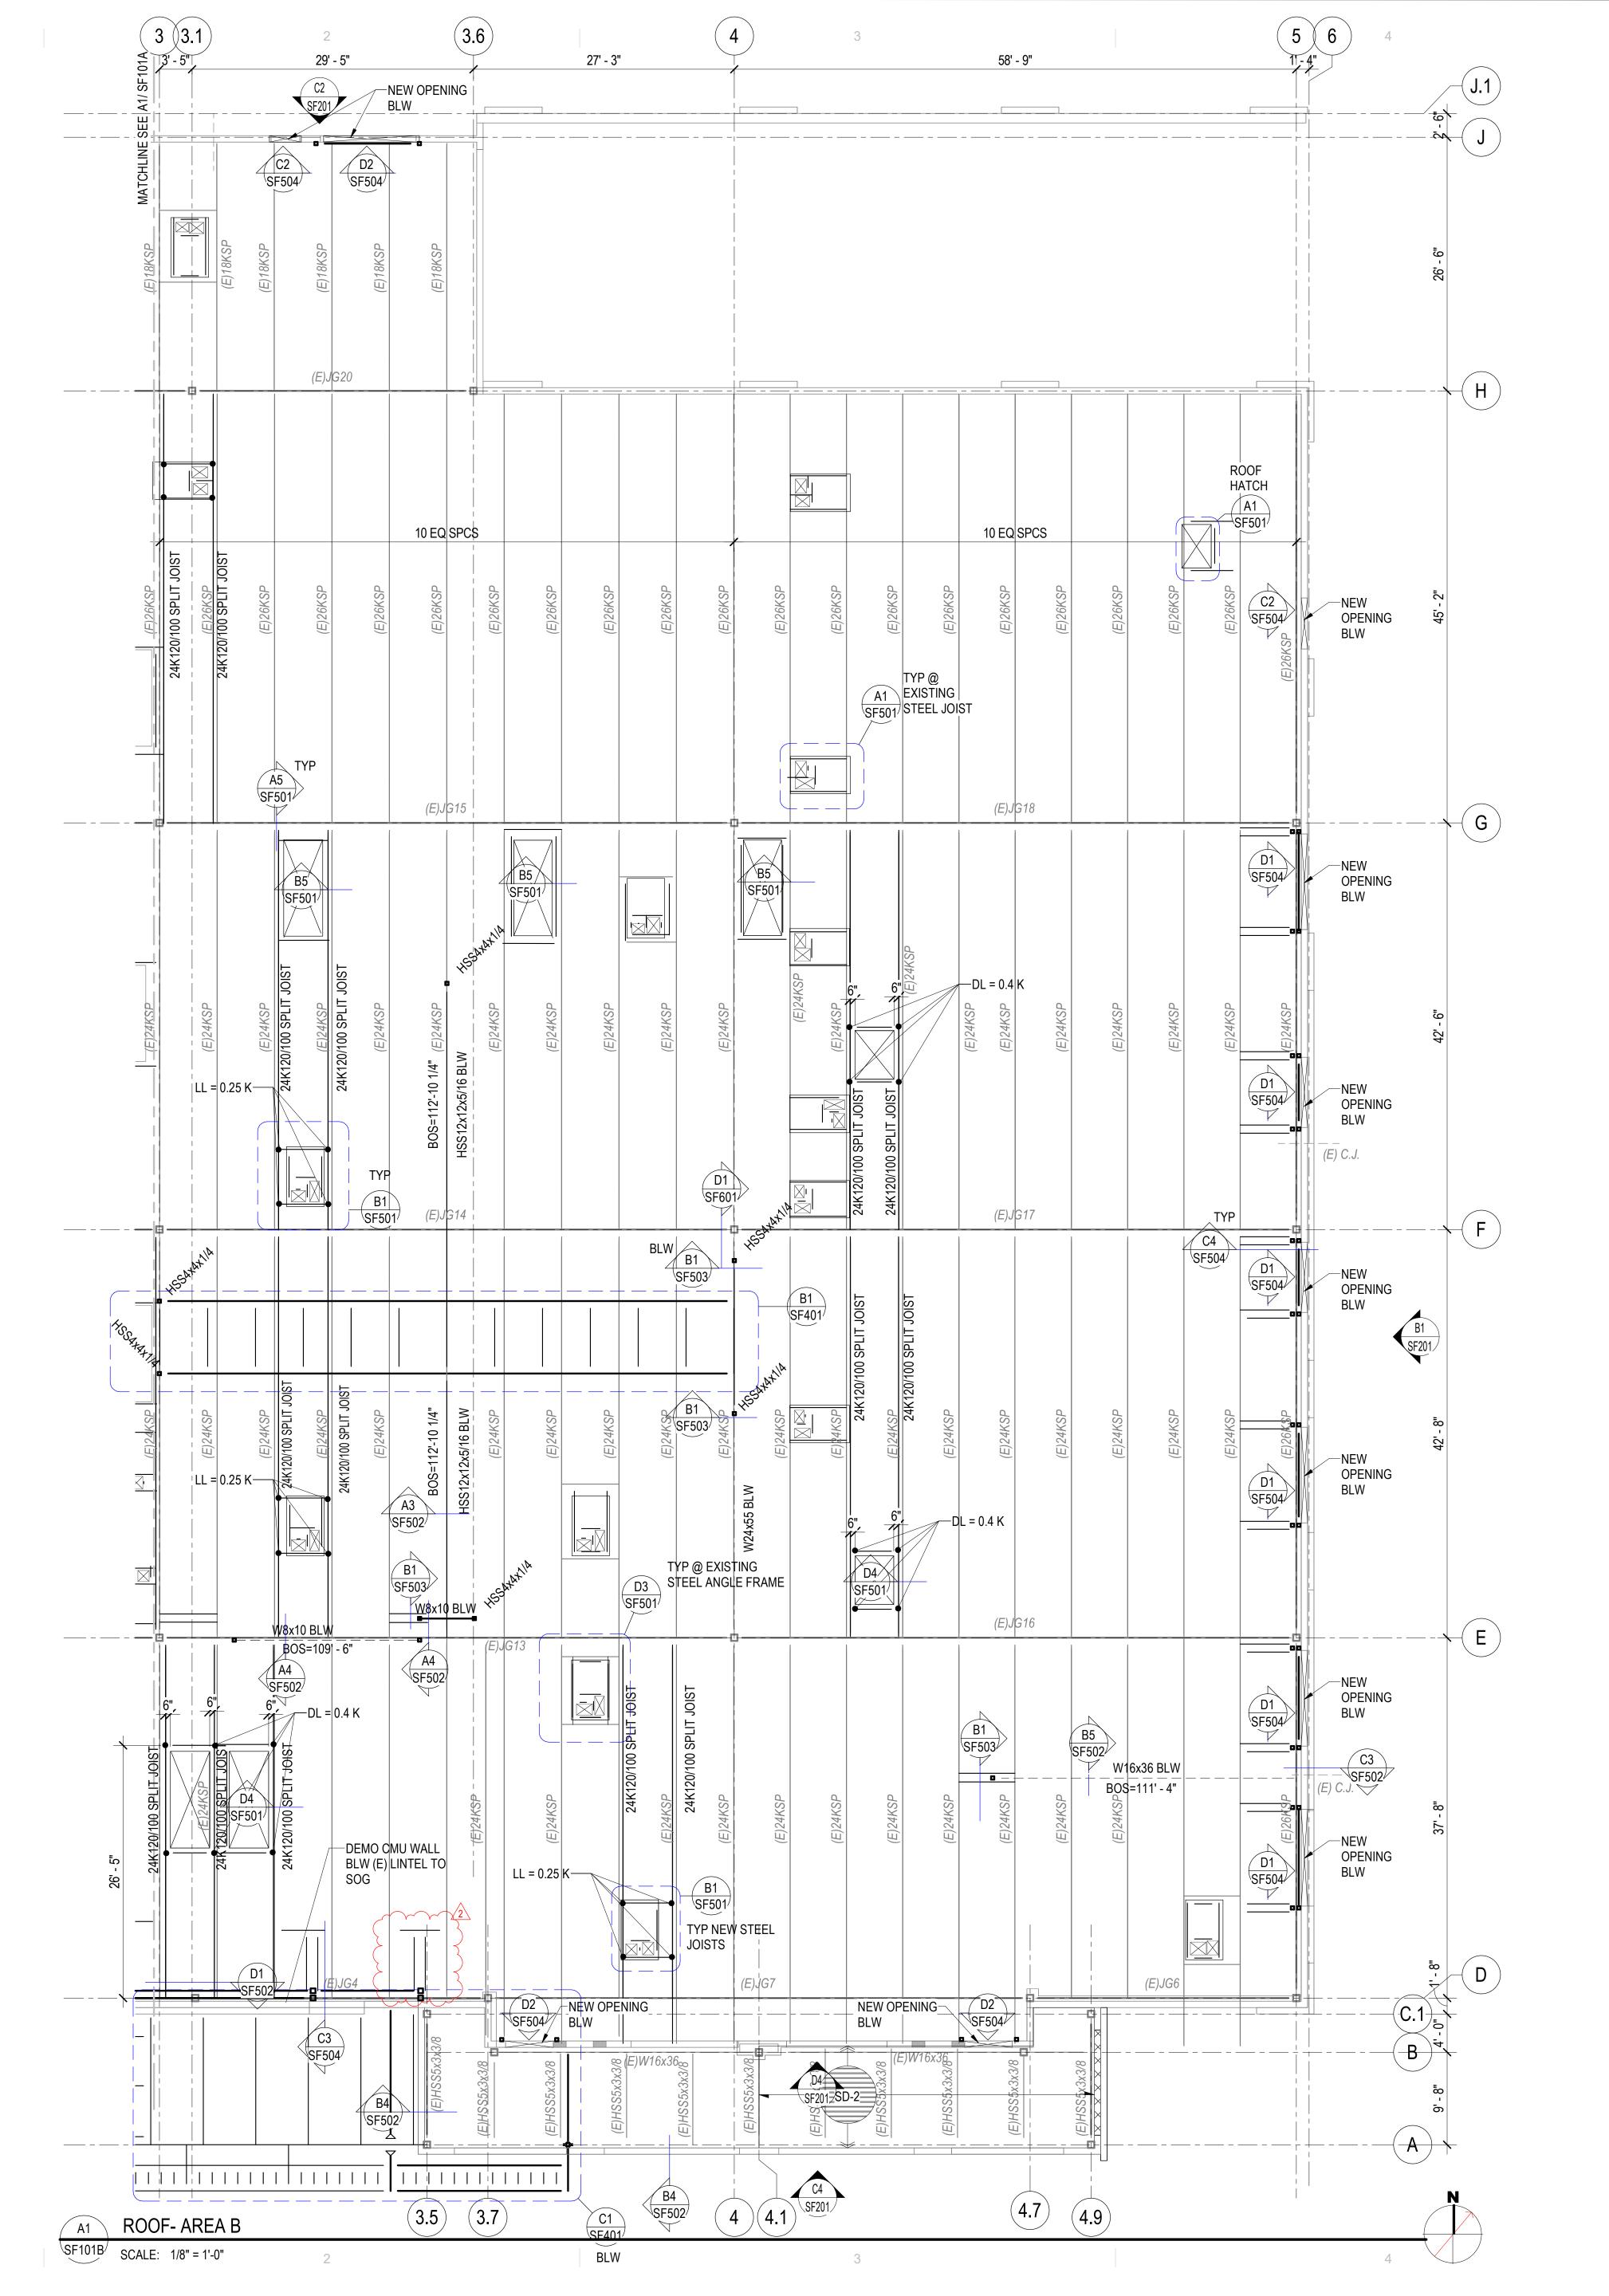

ROOF FRAMING PLAN NOTES

1. SEE ARCHITECTURAL FOR ROOF SLOPES AND



MHTN Architects, Inc. 280 South 400 West Suite 250 Salt Lake City, Utah 84101 Telephone (801) 595-6700 www.mhtn.com

EXISTING BUILDING NOTES

1. THE CONTRACTOR SHALL FIELD VERIFY ALL EXISTING CONDITIONS PRIOR TO DETAILING, FABRICATING, ERECTING OR INSTALLING ANY STRUCTURAL ELEMENT. ALL DISCREPANCIES SHALL BE BROUGHT TO THE ATTENTION OF THE DESIGN TEAM IN A TIMELY MANNER SUCH THAT WORK WILL NOT BE DELAYED.

2. THE CONTRACTOR SHALL PROVIDE ADEQUATE SHORING OF EXISTING STRUCTURE DURING CONSTRUCTION.

3. INFILL ROOF DECK OPENINGS, SEE TYP DETAIL B3/SF503.

NON-COMPOSITE FRAMING PLAN NOTES

1. SEE STEEL DECK SCHEDULE ON SHEET SF602 FOR DECK PROFILE AND DECK ATTACHMENT REQUIREMENTS.

2. FOR ROUND OPENINGS LESS THAN 12 INCHES IN DIAMETER SEE DETAILD2/SF501

3. VERIFY SIZE WEIGHT, LOCATION AND CONFIGURATION OF ALL ROOF TOP EQUIPMENT WITH ARCHITECT AND MECHANICAL ENGINEER. PROVIDE STEEL FRAMES FOR SUPPORT OF ROOF TOP EQUIPMENT PER DETAIL D3/SF501 AT EXISTING STEEL ANGLE FRAMES, B1/SF501 AT NEW JOISTS, AND A1/SF501 AT EXISTING JOISTS. COORDINATE OPENINGS WITH MECHANICAL & ELECTRICAL.

OPEN WEB JOIST FRAMING PLAN NOTES

1. OPEN WEB STEEL JOISTS AND JOIST GIRDERS SHALL BE DESIGNED BY THE MANUFACTURER TO SUPPORT THE MECHANICAL AND LATERAL LOADS SHOWN ON THE ROOF FRAMING PLANS IN ADDITION TO THE UNIFORM AND POINT LOADS SHOWN. LOADS SHOWN ARE ASD UNO

2. ±#.##k – INDICATES POINT LOAD ON STEEL JOIST IN ADDITION TO UNIFORM LOADING SHOWN. + INDICATES DOWNWARD AND - INDICATES UPWARD LOADS. LOADS SHOWN ARE UNFACTORED, UNO.

3. T/C X.XXK INDICATES ADDITIONAL TOP CHORD AXIAL FORCE ON STEEL JOIST OR GIRDER. THIS FORCE IS A FACTORED SEISMIC LOAD THAT SHALL BE CONSIDERED IN BOTH TENSION AND COMPRESSION AND INCLUDES APPLICABLE OVERSTRENGTH FACTORS PER THE GOVERNING BUILDING CODE. STEEL JOISTS AND GIRDERS WITH T/C FORCE SHALL BE DESIGNED AS COLLECTOR ELEMENTS.

4. ALL LOADS SUPPORTED BY OPEN WEB STEEL JOISTS AND GIRDERS SHALL BE LOCATED WITHIN 6" OF JOIST OR GIRDER PANEL POINT OR THE JOIST OR GIRDER SHALL BE REINFORCED PER DETAIL B4/SF501.

5. HORIZONTAL CROSS BRIDGING SHALL BE SIZED AND SUPPLIED BY THE JOIST MANUFACTURER. CONNECT TO WALLS AS INDICATED ON DETAILS

6. WHERE SKYLIGHTS OR MECHANICAL UNITS INTERRUPT HORIZONTAL BRIDGING, PROVIDE CROSS BRIDGING AT JOIST SPACES ON EACH SIDE, TYP.

7. ALL OPEN WEB STEEL JOISTS WITH A SLOPE OF 3/8" PER FOOT OR LARGER SHALL HAVE SLOPED BEARING SEATS.

8 OPEN WEB STEEL JOISTS AT ROOF AREAS SHALL BE DESIGNED FOR THE FOLLOWING WIND ASD NET UPLIFT LOADS: 19 PSF WITHIN 11.4 FT OF ROOF EDGES, 11 PSF AT ALL OTHER AREAS.

9. PROVIDE SPLICE CONNECTION NEAR MIDSPAN OF NEW JOISTS FOR INSTALLATION.



ORDAN LEARNING CENTER

©2023 MHTN ARCHITECTS, INC.

Confidentiality Notice:
This document is intended for use on the Project identified herein by individuals and companies involved in the design, permitting, bidding and construction of the Project. MHTN Architects, Inc. grants limited rights to distribute and reproduce this document for this express purpose only. Distribution, printing or copying this document for purposes other than those indicated is strictly prohibited. If a digital copy of this document is received in error, please delete it.

က

мнти ркојест no. 2024528	3


Original drawi	ing is 30 x 42. D	o not scale co	entents of this drawing.
REVISIONS CONTRACTO LAST REVIS	OR TO VERIFY	Y DRAWING	S IN FIELD USE REF
NO A D	ATE	DESCRIPTION	ON

2 09/13/24 X2

CONSTRUCTION DOCUMENTS 100%

ROOF FRAMING PLAN-AREA B

SF101B

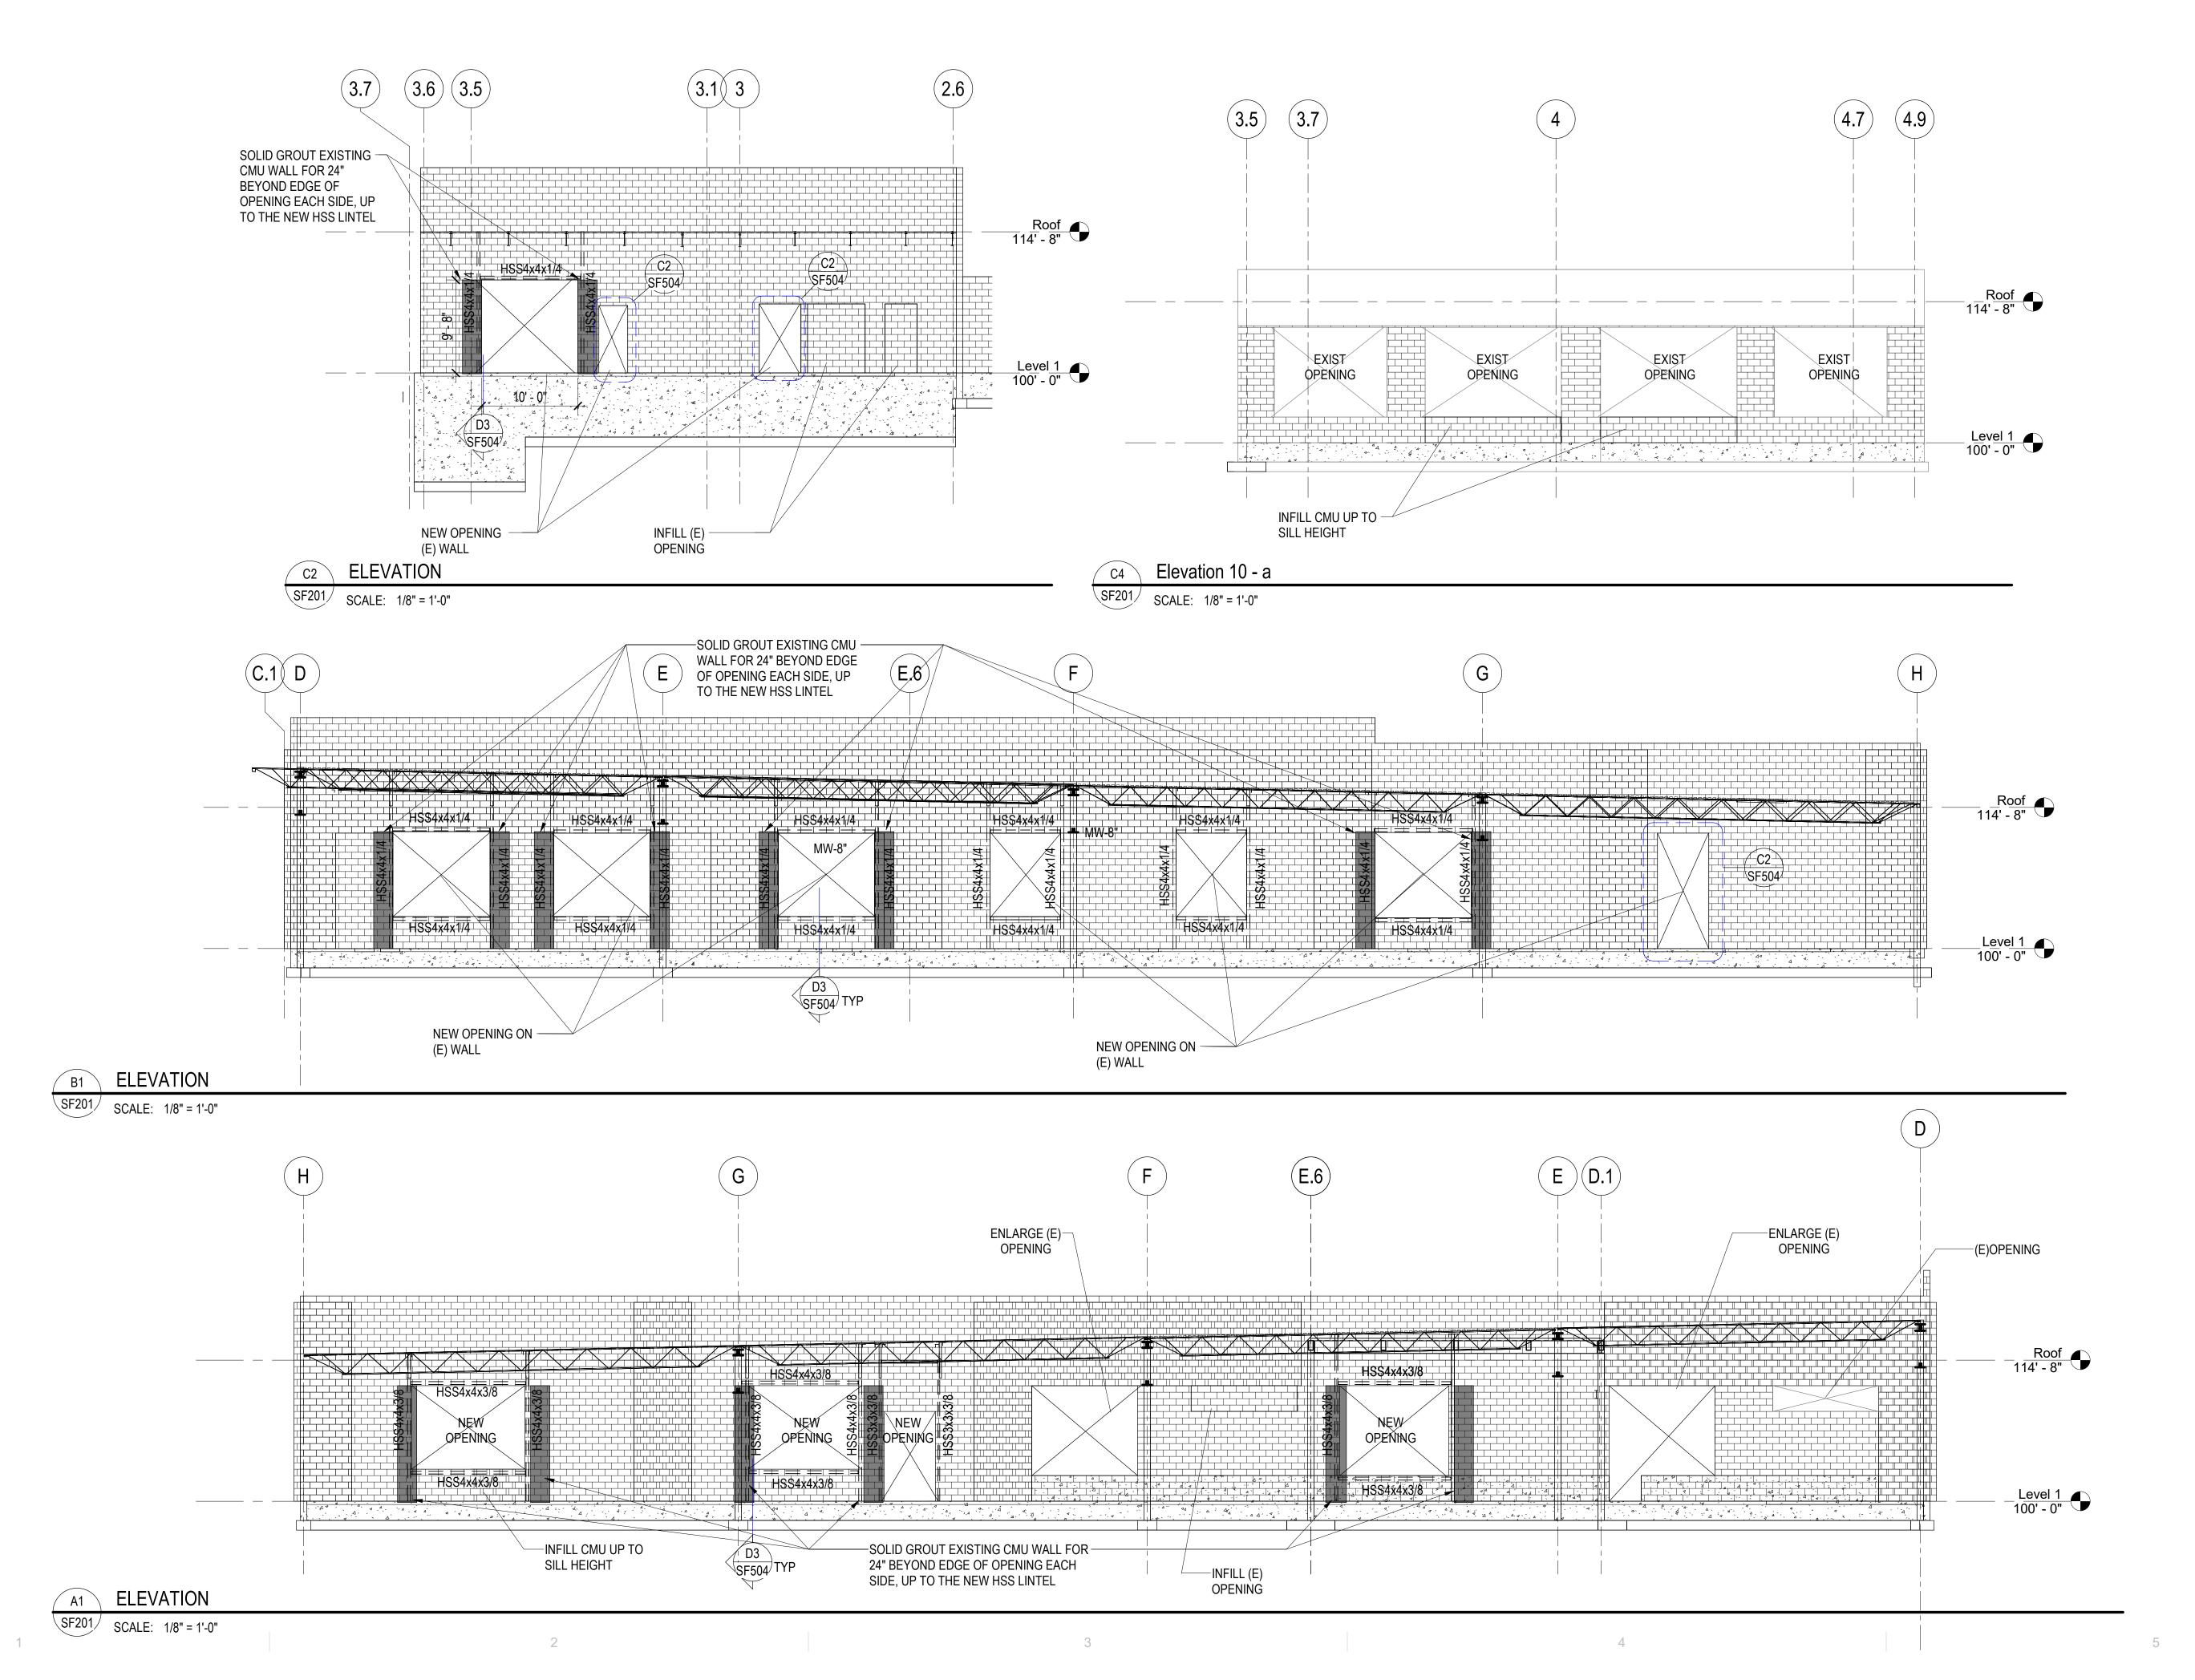





RDAN LEARNING CENTER

©2023 MHTN ARCHITECTS, INC.
Confidentiality Notice: This document is intended for use on the Project identified herein by individual and companies involved in the design, permitting, bidding and construction of he Project. MHTN Architects, Inc. grants limited rights to distribute and eproduce this document for this express purpose only. Distribution, printing copying this document for purposes other than those indicated is strictly prohibited. If a digital copy of this document is received in error, please delete
SEAL


MHTN PI	ROJECT NO. 20 2	24528
Original d	rawing is 30 x 42. [Oo not scale contents of this drawing.
		Y DRAWINGS IN FIELD USE REFLECT
NO. \triangle	DATE	DESCRIPTION
2	09/13/24	X2

	ACTOR TO VER	RIFY DRAWINGS IN FIELD USE REFLEC
NO.	DATE	DESCRIPTION
2	09/13/24	X2

CONSTRUCTION DOCUMENTS 100% 08/29/24

STRUCTURAL ELEVATIONS

SF201

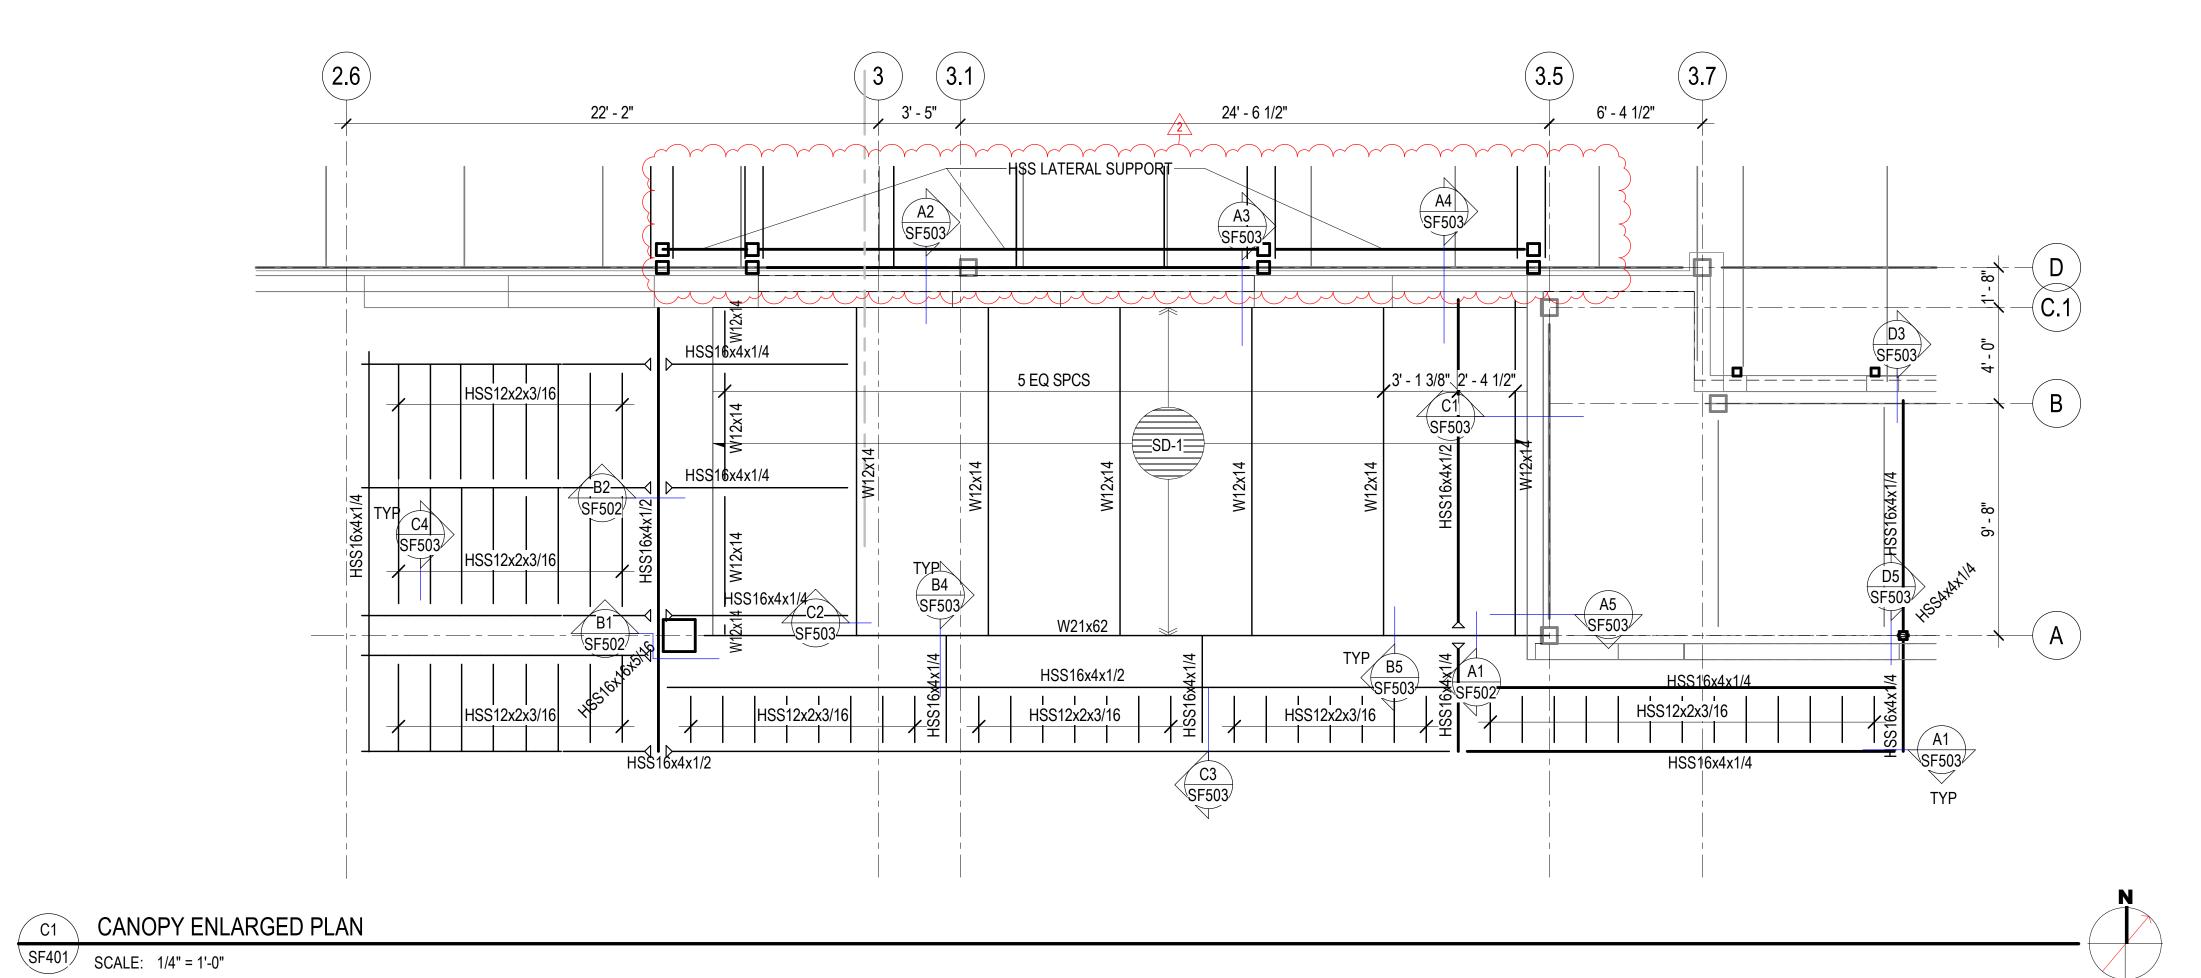

29' - 5" 27' - 3" TOS = 114' - 8" TYP D1 SF601 W21x132 BLW TOST = 114' - 8" TYP W21x132 BLW TOST = 114' - 8"

1 3

ENLARGED VIEW- OPERABLE PARTITION SUPPORT AT INTERSECTION

SF401 SCALE: 1/4" = 1'-0"

CANOPY FRAMING PLAN NOTES

1. SEE ARCHITECTURAL FOR ROOF SLOPES AND


2. EXPOSED STEEL FRAMING, COLUMNS AND ASSOCIATED BASE PLATES AND ANCHOR BOLTS SHALL BE GALVANIZED G60

3. SEE STEEL DECK SCHEDULE ON SHEET SF602 FOR DECK PROFILE AND DECK ATTACHMENT.

4. AT ENDS OF EXPOSED HSS BEAMS, PROVIDE A 1/8" CLOSURE PLATE. MATCH THE PROFILE OF THE HSS.



MHTN Architects, Inc. 280 South 400 West Suite 250 Salt Lake City, Utah 84101 Telephone (801) 595-6700 www.mhtn.com

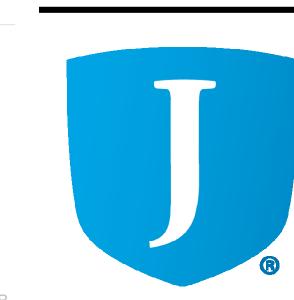

©2023 MHTN ARCHITECTS, INC. Confidentiality Notice:
This document is intended for use on the Project identified herein by individuals and companies involved in the design, permitting, bidding and construction of the Project. MHTN Architects, Inc. grants limited rights to distribute and reproduce this document for this express purpose only. Distribution, printing or copying this document for purposes other than those indicated is strictly prohibited. If a digital copy of this document is received in error, please delete it.

MHTN PROJECT NO. 2024528

Original drawing is 30 x 42. Do not scale contents of this drawing. REVISIONS CONTRACTOR TO VERIFY DRAWINGS IN FIELD USE REFLECT LAST REVISION DATE.

 NO.
 DATE
 DESCRIPTION


 2
 09/13/24
 X2

CONSTRUCTION DOCUMENTS 100%

ENLARGED STRUCTURAL

PLANS

SF401

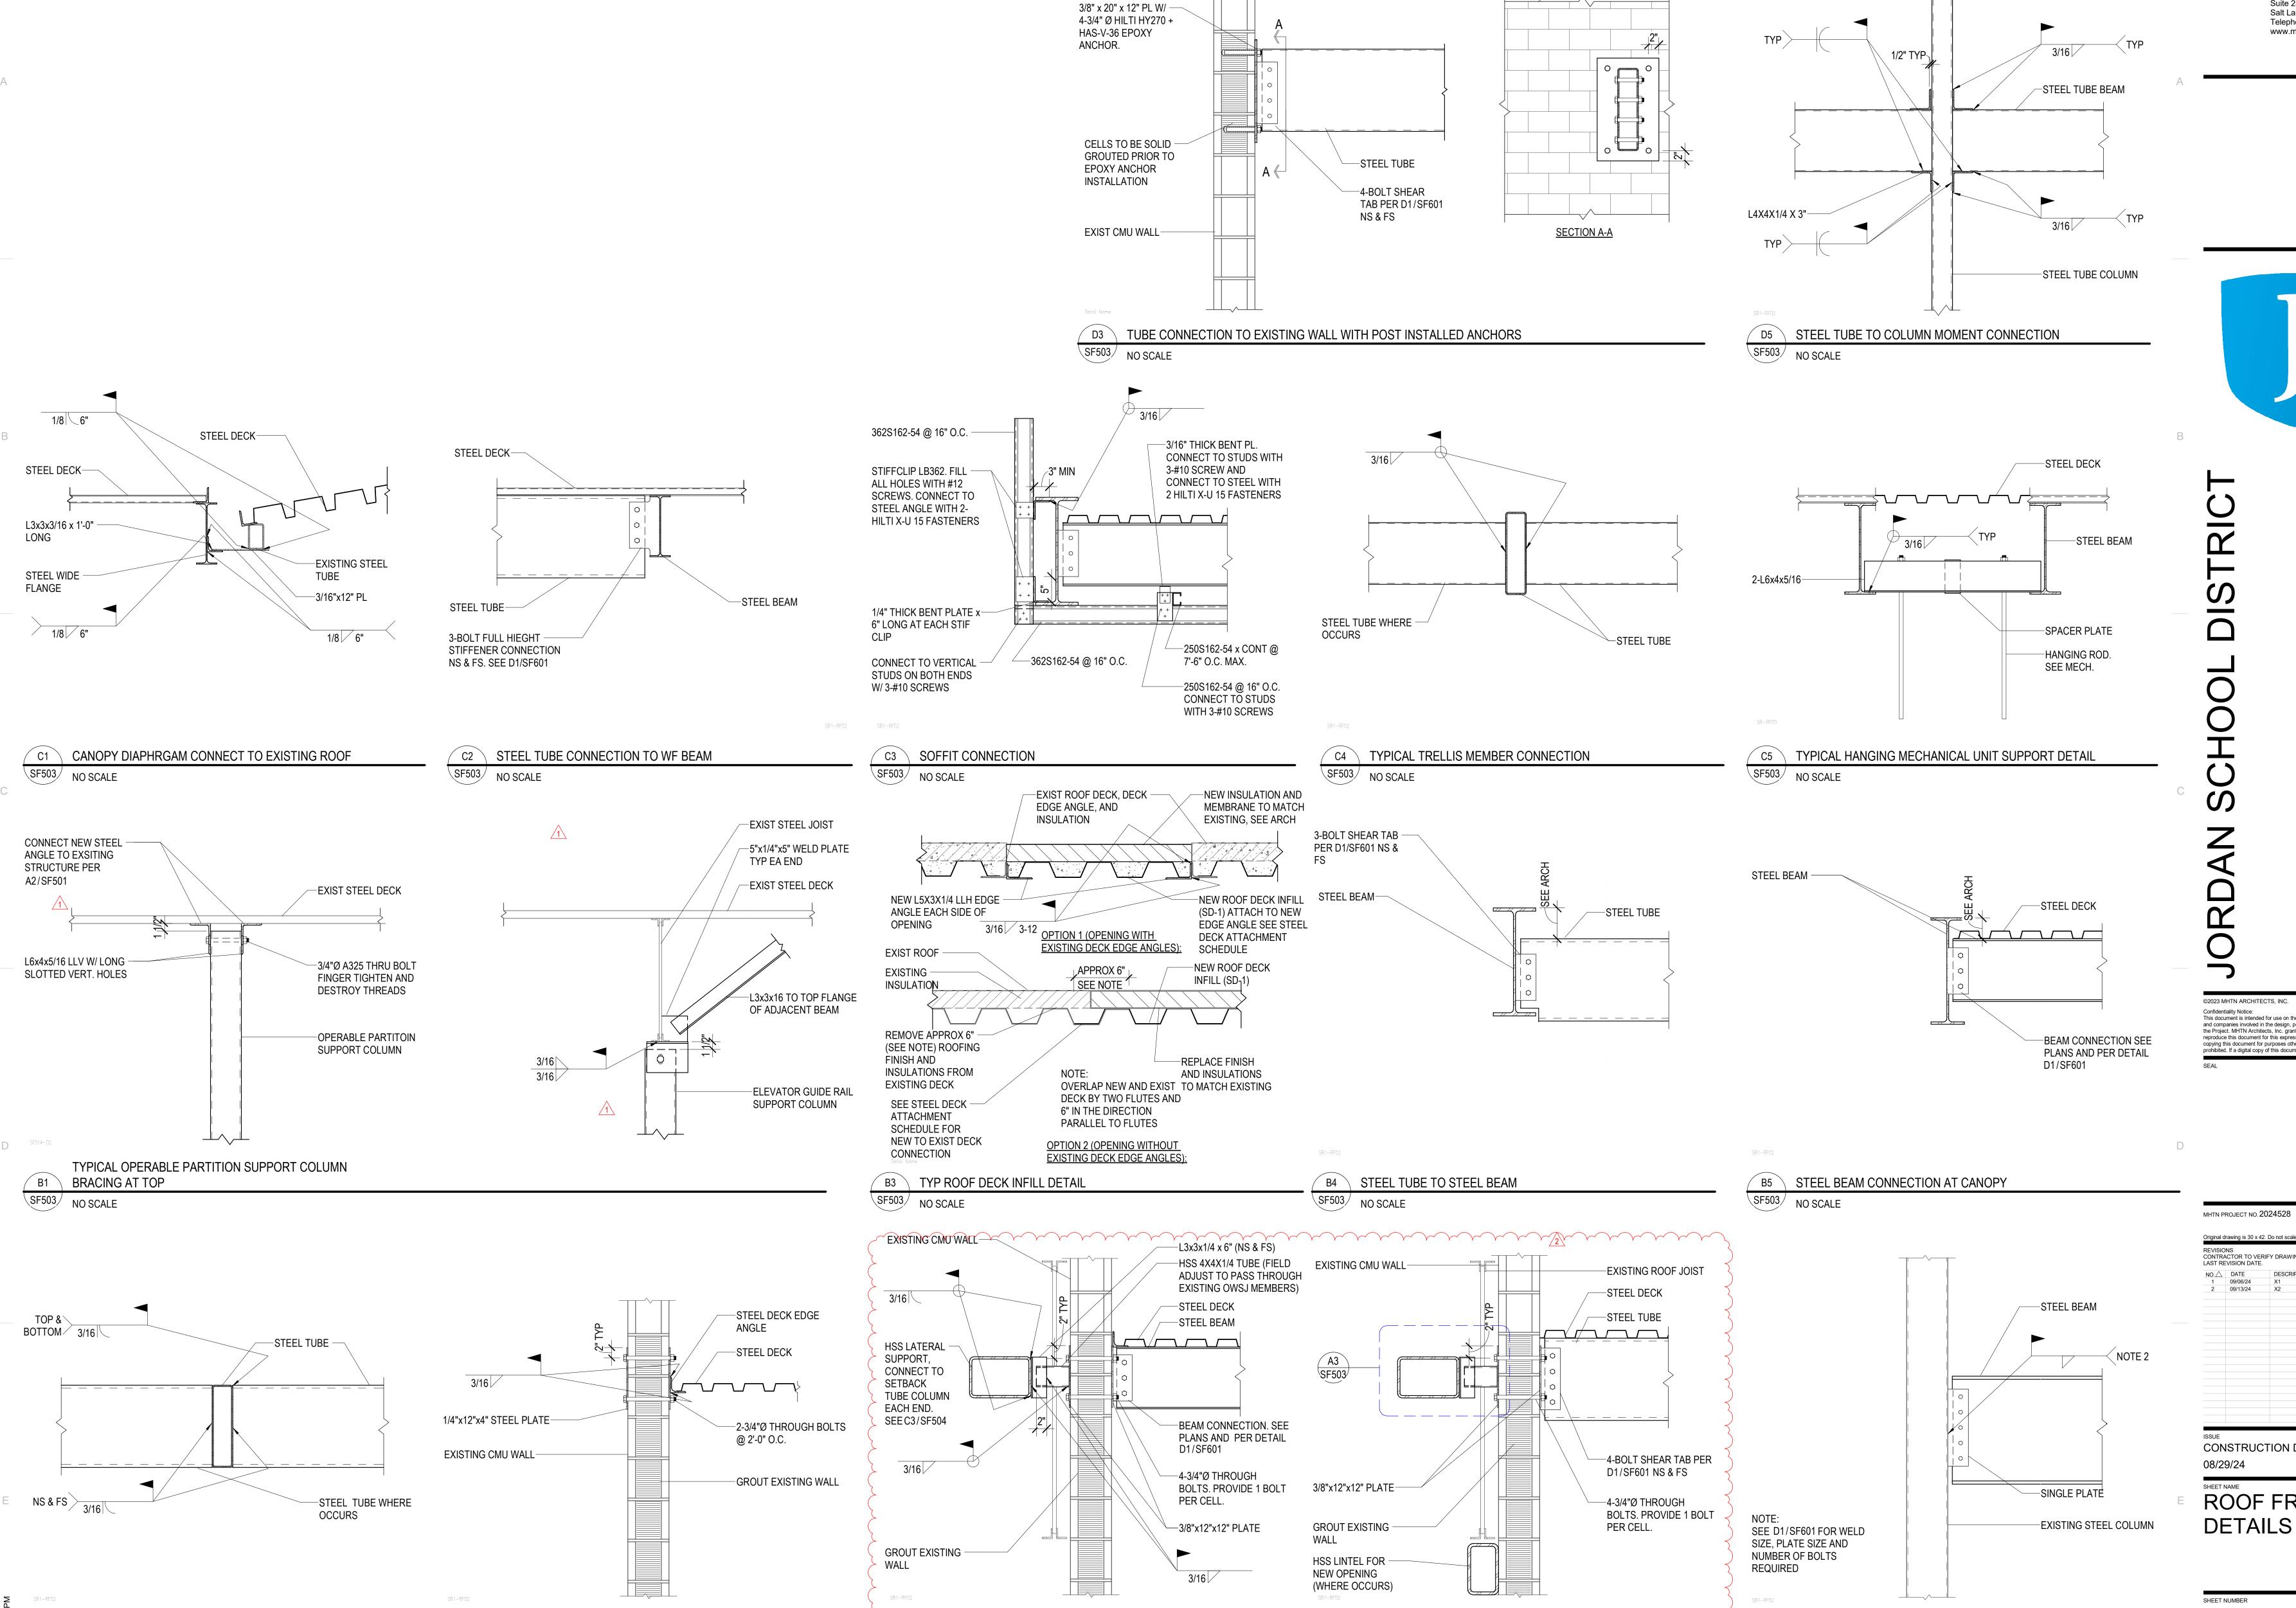

(A3) NEW STEEL BEAM TO EXISTING CMU WALL

SF503 NO SCALE

A4 NEW STEEL TUBE TO EXISTING CMU WALL

SF503 NO SCALE

MINIME MANAGERA MANAG

A1 STEEL TUBE TO STEEL BEAM

SF503 NO SCALE


A2 DECK EDGE TO EXISTING CMU WALL

SF503 NO SCALE



EXIST CMU WALL

MHTN Architects, Inc. 280 South 400 West Suite 250 Salt Lake City, Utah 84101 Telephone (801) 595-6700 www.mhtn.com

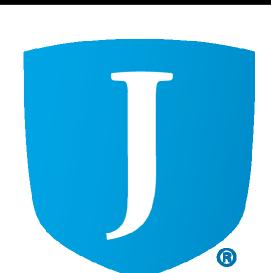

3706 WE SOUTH ©2023 MHTN ARCHITECTS, INC. Confidentiality Notice: This document is intended for use on the Project identified herein by individuals and companies involved in the design, permitting, bidding and construction of the Project. MHTN Architects, Inc. grants limited rights to distribute and reproduce this document for this express purpose only. Distribution, printing or copying this document for purposes other than those indicated is strictly prohibited. If a digital copy of this document is received in error, please delete it.


Original drawing is 30 x 42. Do not scale contents of this drawing. REVISIONS CONTRACTOR TO VERIFY DRAWINGS IN FIELD USE REFLECT NO.△ DATE DES0 1 09/06/24 X1 2 09/13/24 X2

CONSTRUCTION DOCUMENTS 100%

ROOF FRAMING **DETAILS**

A5 NEW STEEL BEAM TO EXISTING COLUMN

SF503 NO SCALE

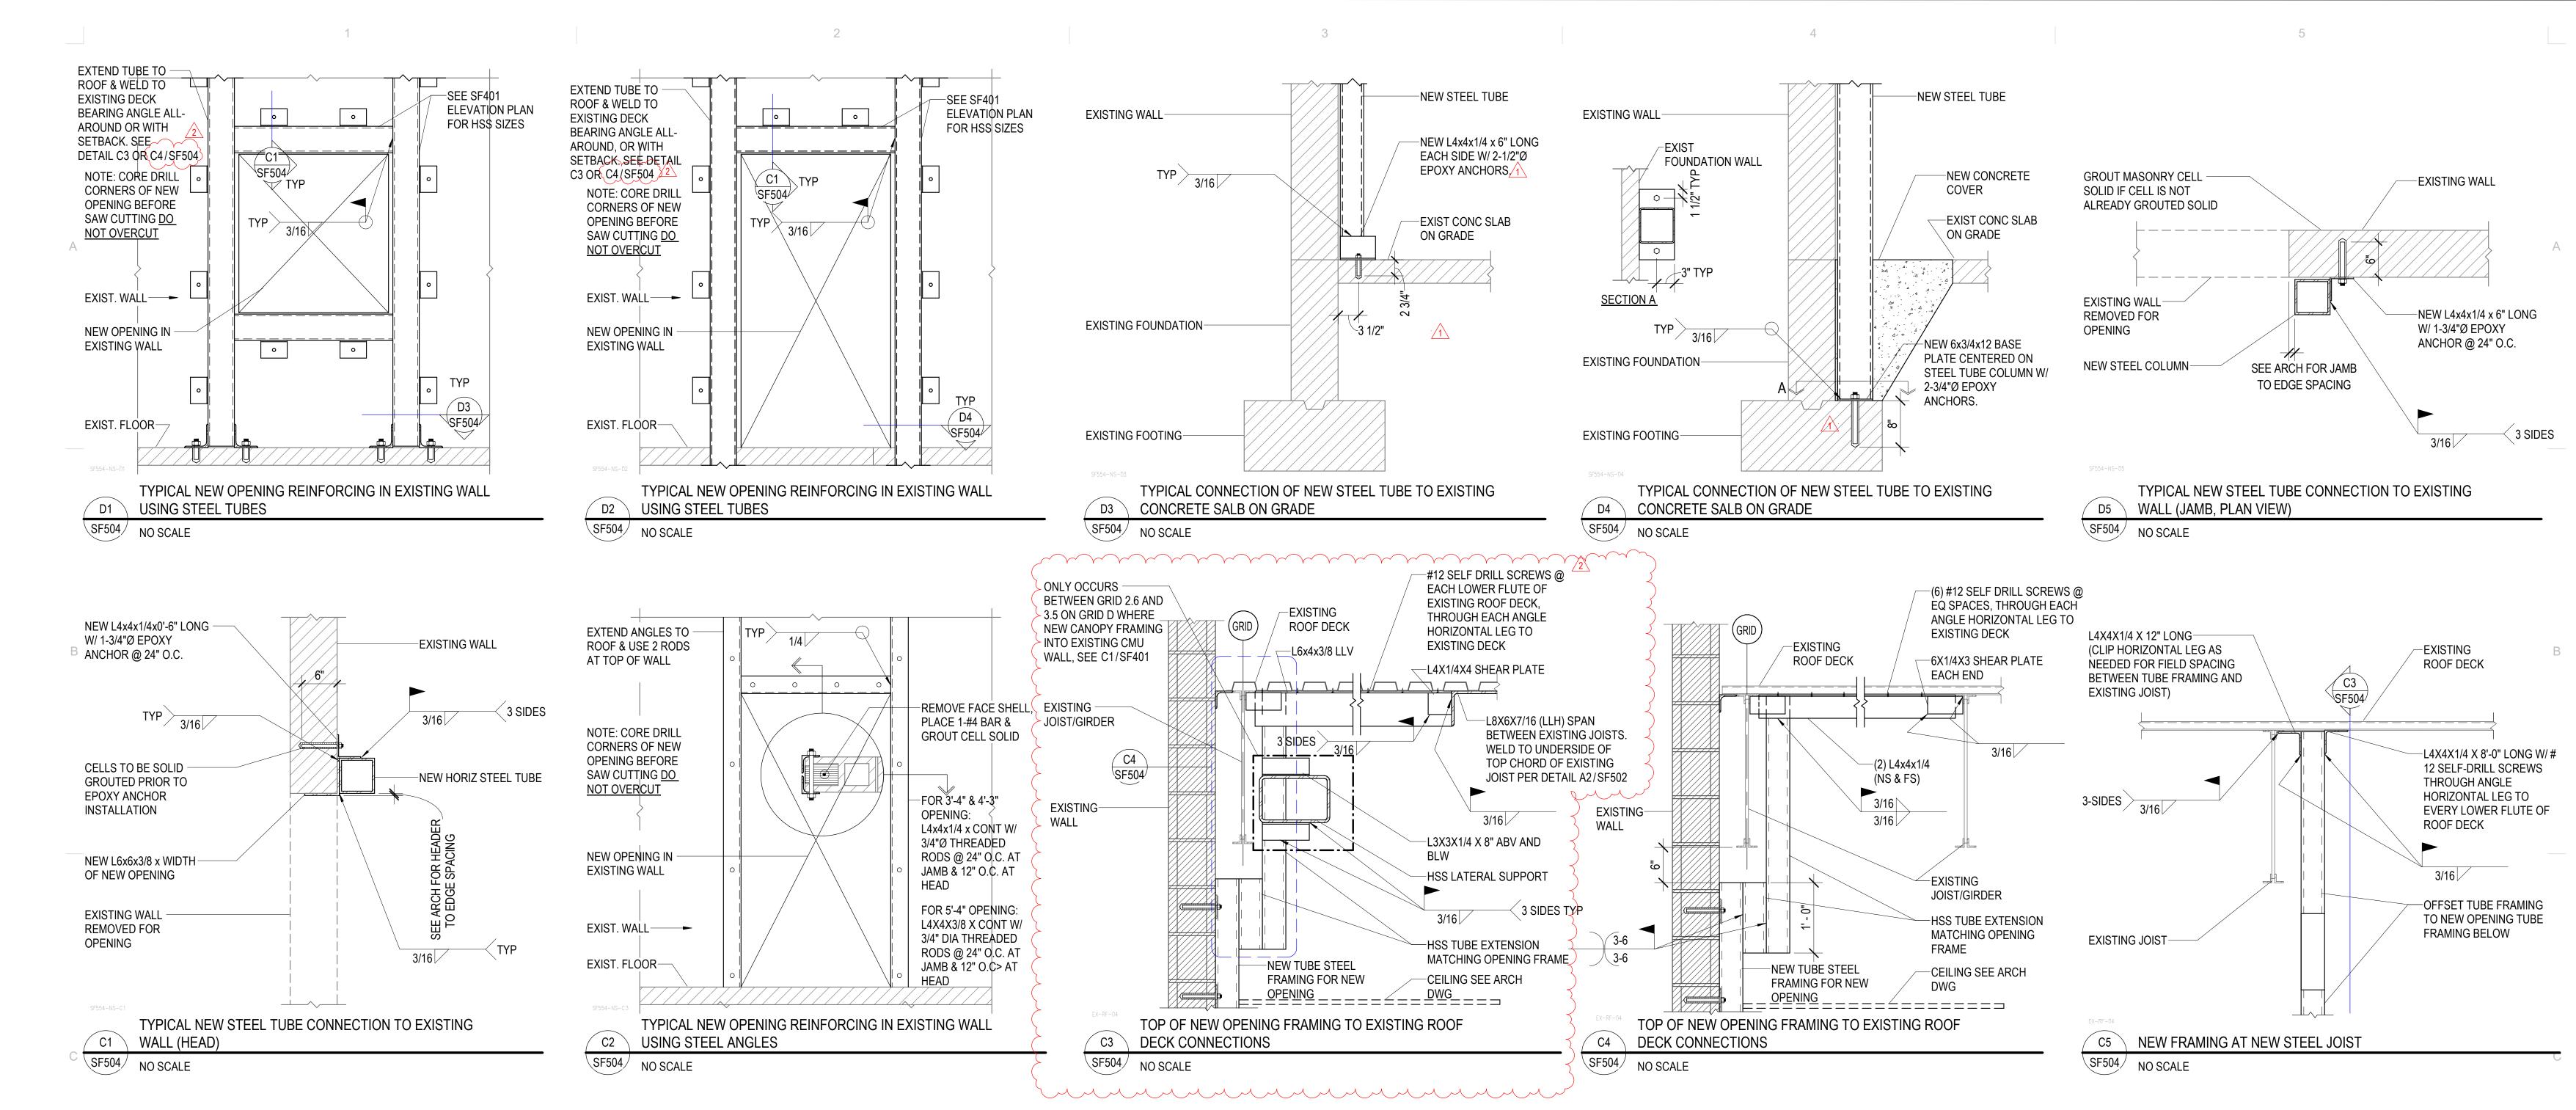

MHTN Architects, Inc.
280 South 400 West
Suite 250

www.mhtn.com

Salt Lake City, Utah 84101 Telephone (801) 595-6700

NING CENTER

JORDAN LEARNING CEN

©2023 MHTN ARCHITECTS, INC.

Confidentiality Notice:
This document is intended for use on the Project identified herein by individuals and companies involved in the design, permitting, bidding and construction of the Project. MHTN Architects, Inc. grants limited rights to distribute and reproduce this document for this express purpose only. Distribution, printing or copying this document for purposes other than those indicated is strictly prohibited. If a digital copy of this document is received in error, please delete it.

мнти ргојест по 2024528

Original drawing is 30 x 42. Do not scale contents of this drawing.

REVISIONS
CONTRACTOR TO VERIFY DRAWINGS IN FIELD USE REFLECT LAST REVISION DATE.


NO A DATE DESCRIPTION

NO.△ DATE DESCRIPTION
1 09/06/24 X1
2 09/13/24 X2

CONSTRUCTION DOCUMENTS 100% 08/29/24

NEW WALL OPENINGS

SF504

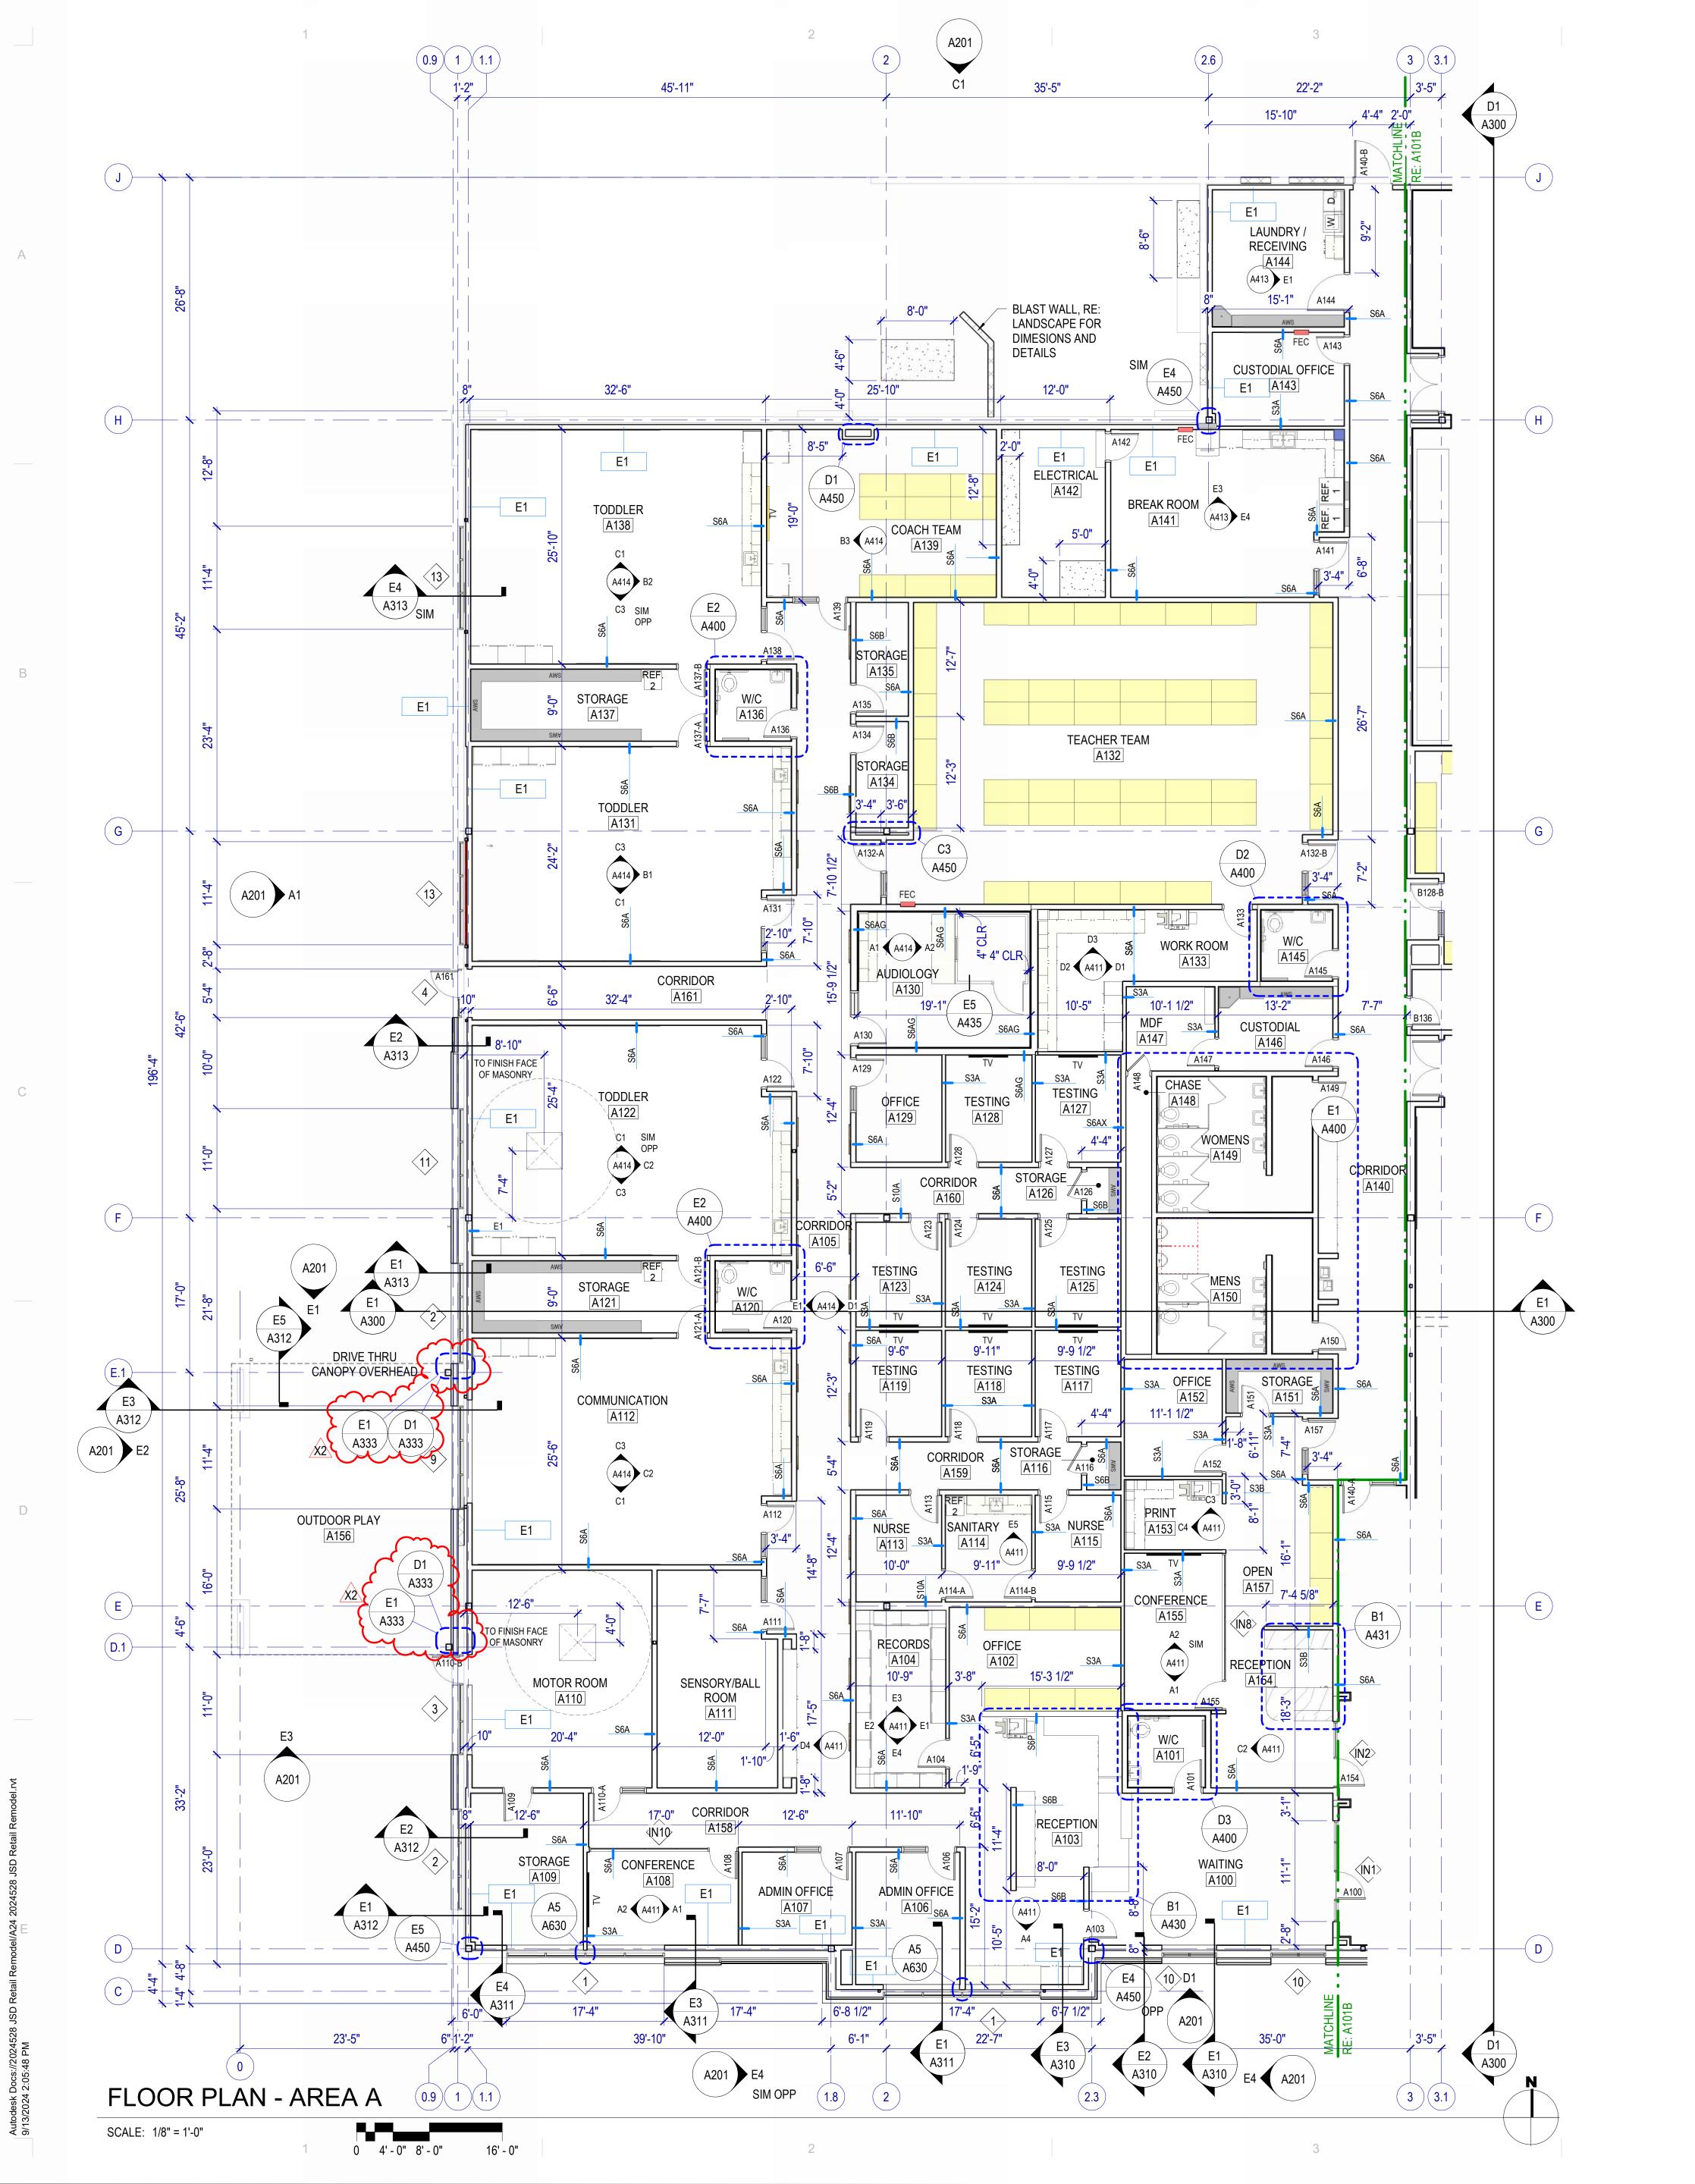

FLOOR PLAN GENERAL NOTES

References to sheets below are provided to aid in navigating the drawings.

RE: G001 for General Project notes.

RE: G200 for Fixture Mounting Heights.

RE: G400 for Floor, Roof and Exterior Wall Types.

RE: G500 for Interior Wall Types.

RE: A111 for slab edges, recesses and other transitions.

RE: A600 for the Door Schedule.

RE: A620 drawings for Window Types.

RE: A640A & A640B for wall finishes.

RE: Structural for slab recesses.

RE: Structural for concrete scoring, except where decorative scoring is shown.

Unless noted otherwise all dimensions are to face of metal stud.

When floor height varies in a room, the ceiling height shown is the height above the floor at the entry.

All outside gypsum board corners to be finished with corner guards. Refer to A641 Finish Legend for

Rated Construction: Provide as shown on the plans, the Life Safety Plans and elsewhere in the documents. Seal penetrations with systems applicable to the application and that have UL or other testing agency certifications.

Keynotes: Not all keynotes apply to this sheet.

LEGEND - FLOOR PLAN



FIRE EXTINGUISHER + CABINET SEMI-RECESSED

AUTOMATED EXTERNAL DEFIBRILLATOR

WALL MOUNTED TOILET **RE: PLUMBING**

FLOOR MOUNTED TOILET RE: PLUMBING

RE: PLUMBING

WALL HUNG LAVATORY RE: PLUMBING

COUNTER MOUNTED SINK

ELECTRICAL WATER COOLER

RE: PLUMBING

RE: C4/G201 & PLUMBING

ADJUSTABLE WALL SHELVING -16" DEEP SHELVES, RE: D5/A435

WASHING MACHINE RE: PLUMBING

PLUMBING

REFRIDGERATOR,CFCI


REFRIDGERATOR,OFOI

ICE MACHINE RE:

PLUMBING

RECORDING SOUND BOOTH, OFOI

RECORDING SOUND BOOTH, OFOI

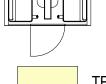

TEACHER WORK DESKS, OFOI



SHIPS LADDER, RE: E1/A340



THERAPY SWING LOCATION, OFOI,

SEE RCP FOR MOUNTING DETAIL



COUNTERTOP LASER CUTTER,



CONCRETE - COORDINATE WITH EQUIPMENT DIMENSIONS


NOTE: PROVIDE ITEMS INDICATED IN THE LEGEND IN THE QUANTITIES SHOWN ON THE PLAN.

KEYNOTES



Salt Lake City, Utah 84101 Telephone (801) 595-6700

www.mhtn.com

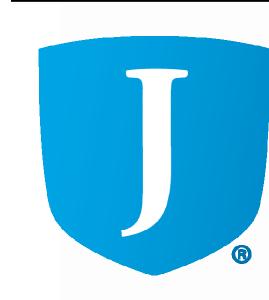

C	Original drawi	ng is 30 x	(42. Do r	not s

мнти ркојест no.2024528

©2023 MHTN ARCHITECTS, INC.

Confidentiality Notice: This document is intended for use on the Project identified herein by individuals and companies involved in the design, permitting, bidding and construction of the Project. MHTN Architects, Inc. grants limited rights to distribute and

reproduce this document for this express purpose only. Distribution, printing or copying this document for purposes other than those indicated is strictly prohibited. If a digital copy of this document is received in error, please delete it.

CONTRACTOR TO VERIFY DRAWINGS IN FIELD USE REFLECT LAST REVISION DATE.
 NO. △
 DATE
 DESCRIPTION

 X2
 9/13/2024
 ADDENDUM #2


CONSTRUCTION DOCUMENTS

AUGUST 29, 2024 FIRST FLOOR

PLAN - AREA A


A101A

www.mhtn.com

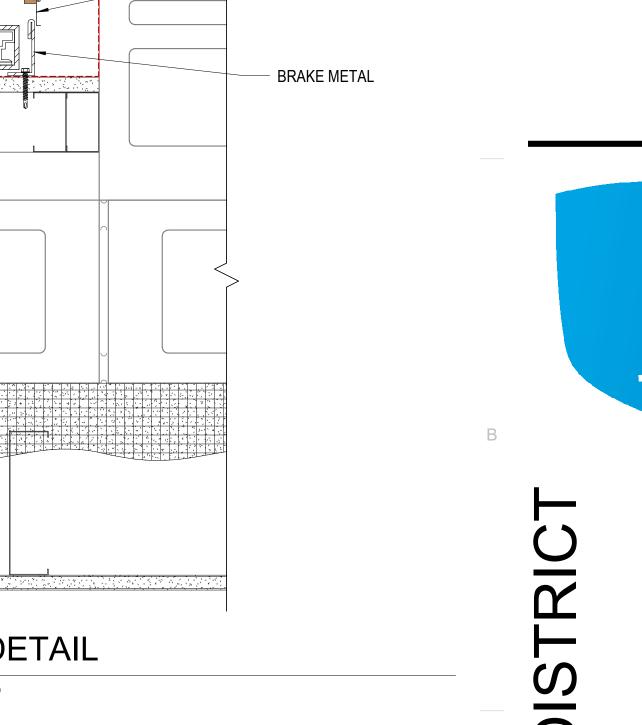




©2023 MHTN ARCHITECTS, INC. Confidentiality Notice:
This document is intended for use on the Project identified herein by individuals and companies involved in the design, permitting, bidding and construction of the Project. MHTN Architects, Inc. grants limited rights to distribute and reproduce this document for this express purpose only. Distribution, printing or copying this document for purposes other than those indicated is strictly prohibited. If a digital copy of this document is received in error, please delete it.

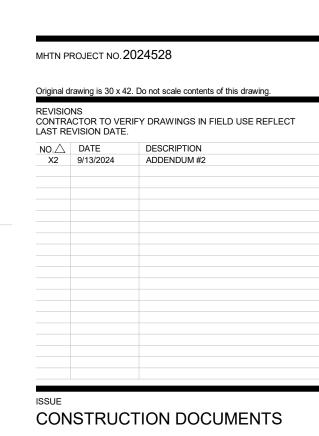

AUGUST 29, 2024

SHEET NAME ENVELOPE DETAILS

A333

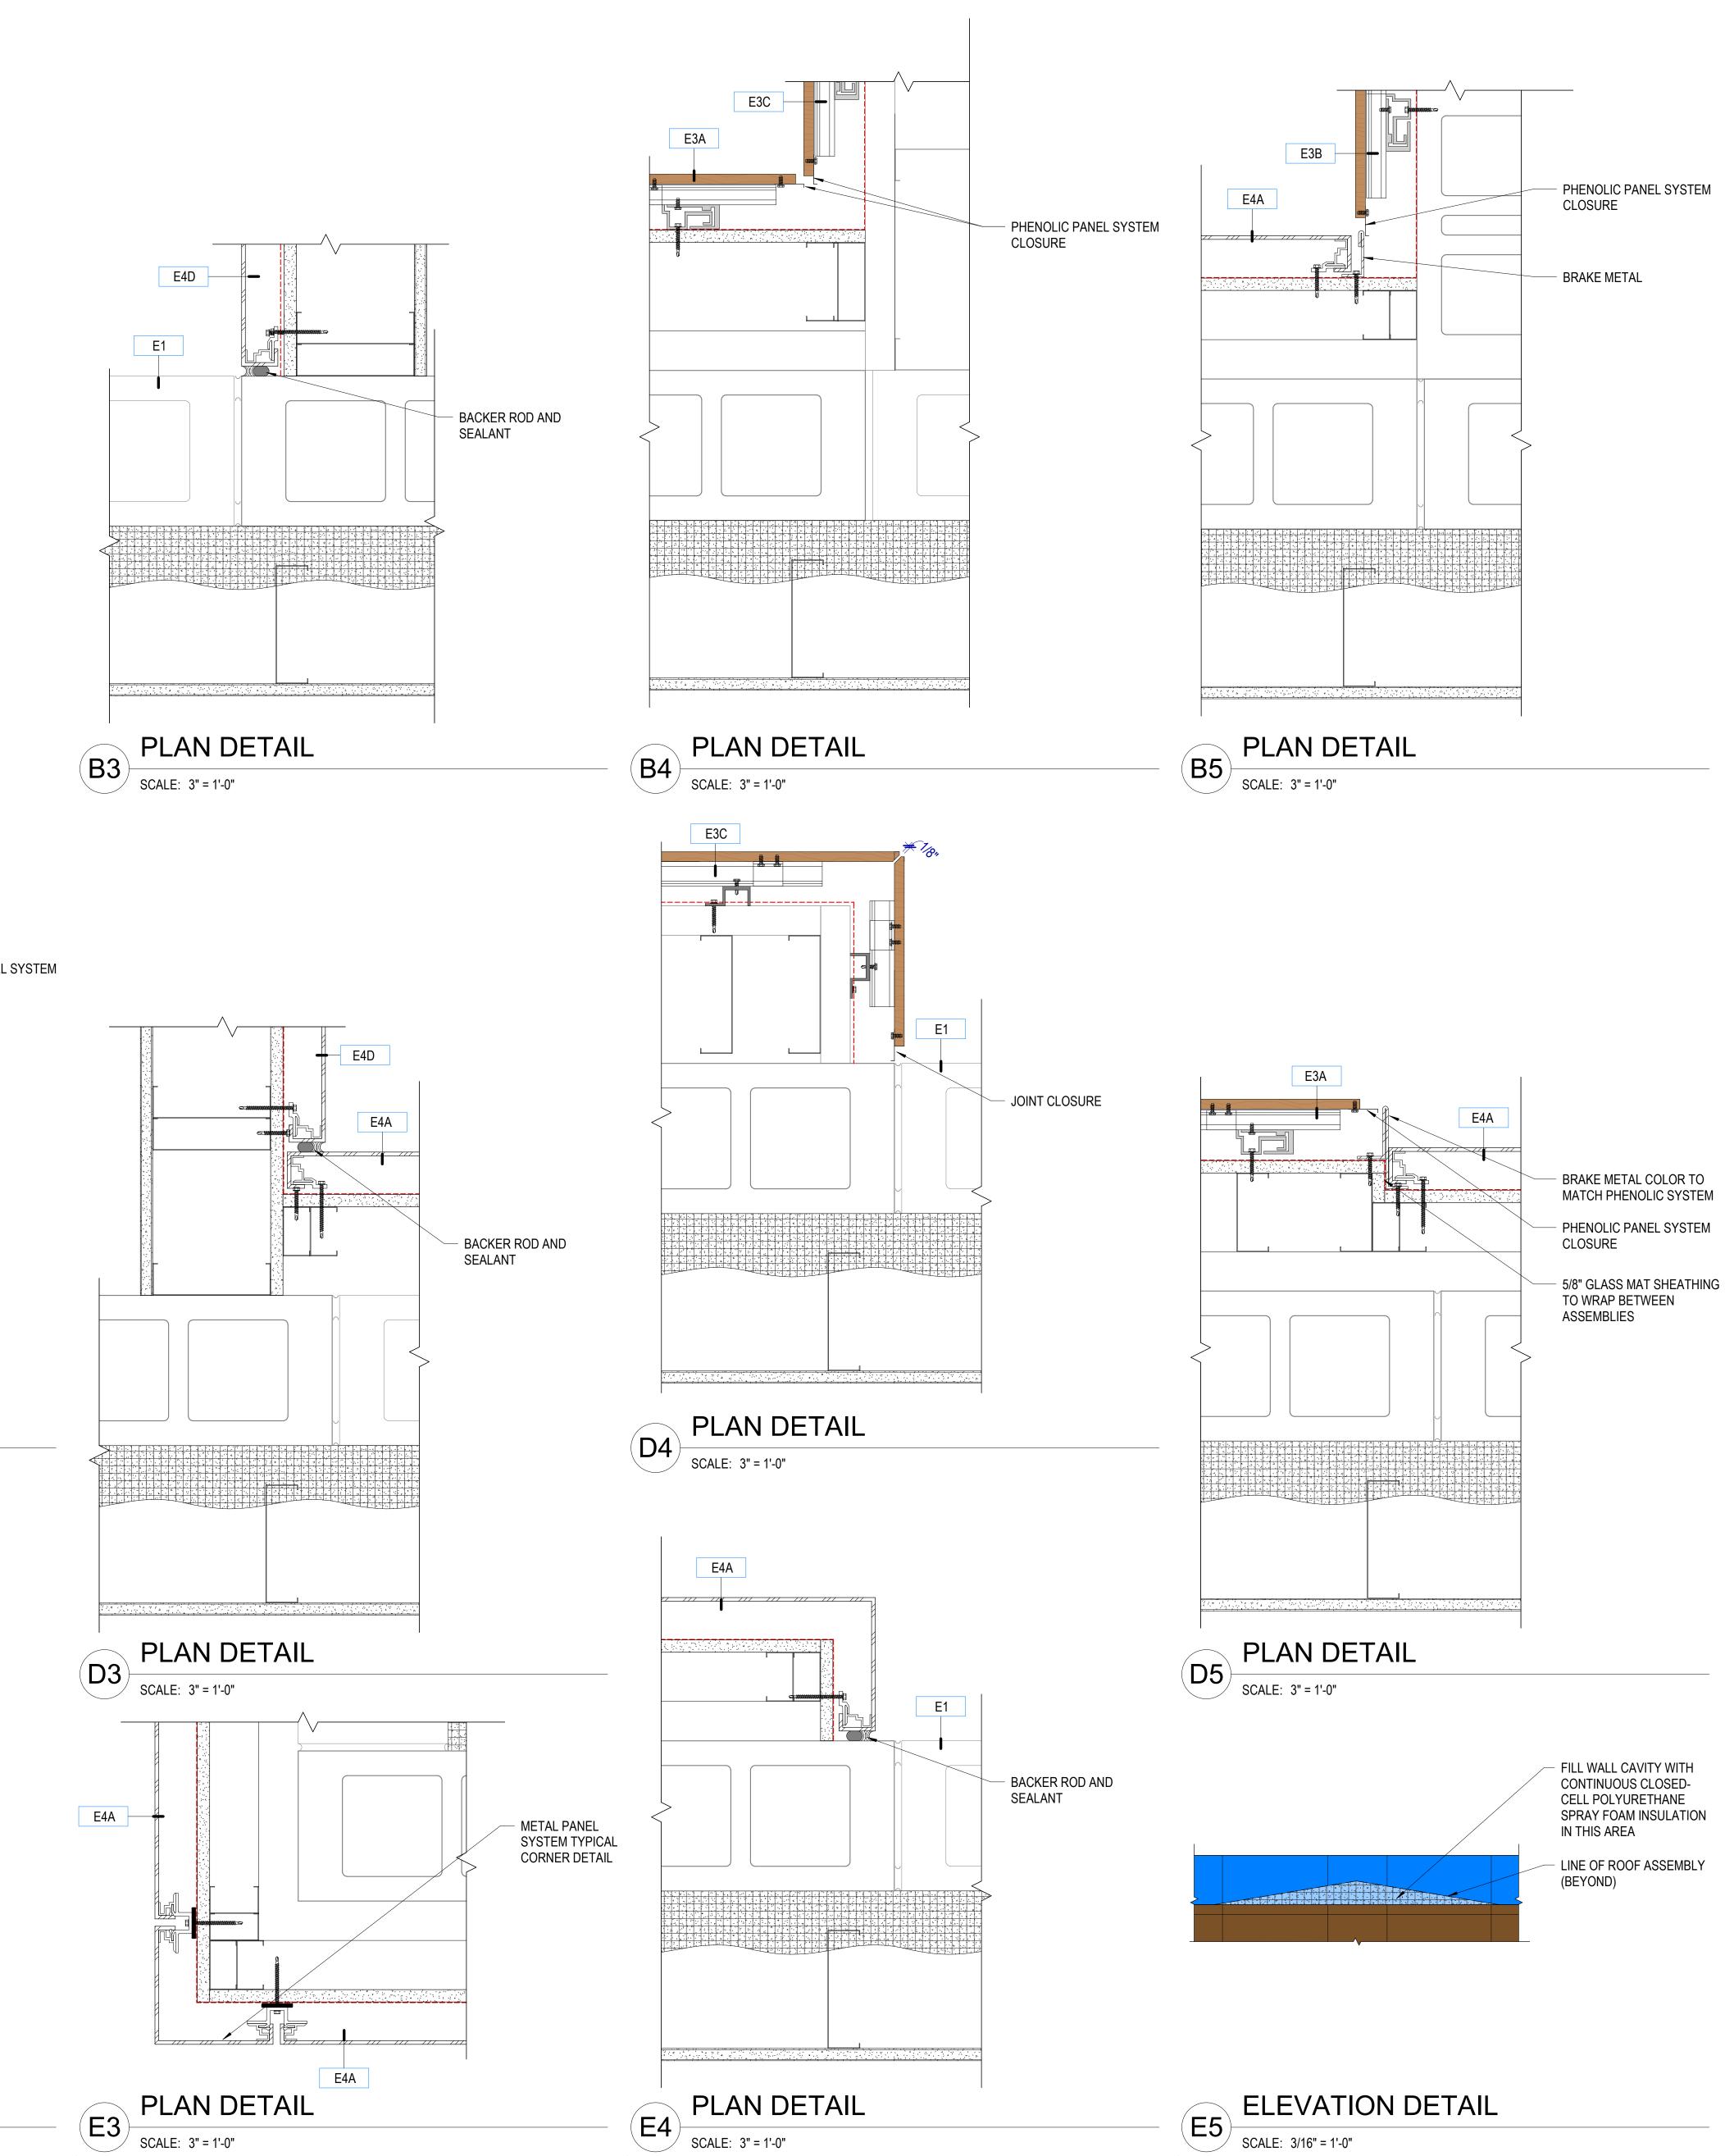

PRIME AND PAINT EXISTING

COLUMN PER SPEC

- CONTINUOUS SEALANT

- 3/8" DIA X 2" LONG HSA @ 9" O.C. RE: STRUCTURAL

CONCRETE STEM WALL RE: STRUCTURAL

mmmy

PLAN DETAIL

PLAN DETAIL

SCALE: 3" = 1'-0"

E3A

SCALE: 3" = 1'-0"

PHENOLIC PANEL SYSTEM

JOINT CLOSURE

- PHENOLIC PANEL SYSTEM

BRAKE METAL COLOR TO MATCH PHENOLIC SYSTEM

EXISTING EXTERIOR STEEL COLUMN - PRIME AND PAINT

CONCRETE STEM

RE: STRUCTURAL

HSA @ 9" O.C.

RE: STRUCTURAL

1 3/8" DIA X 2" LONG 2 E3A

E3D

CLOSURE

PER SPEC

1/4" PER 12"

4MIN.

SCALE: 3" = 1'-0"


SECTION DETAIL

PLAN DETAIL

PLAN DETAIL

SCALE: 3" = 1'-0"

SLOPE

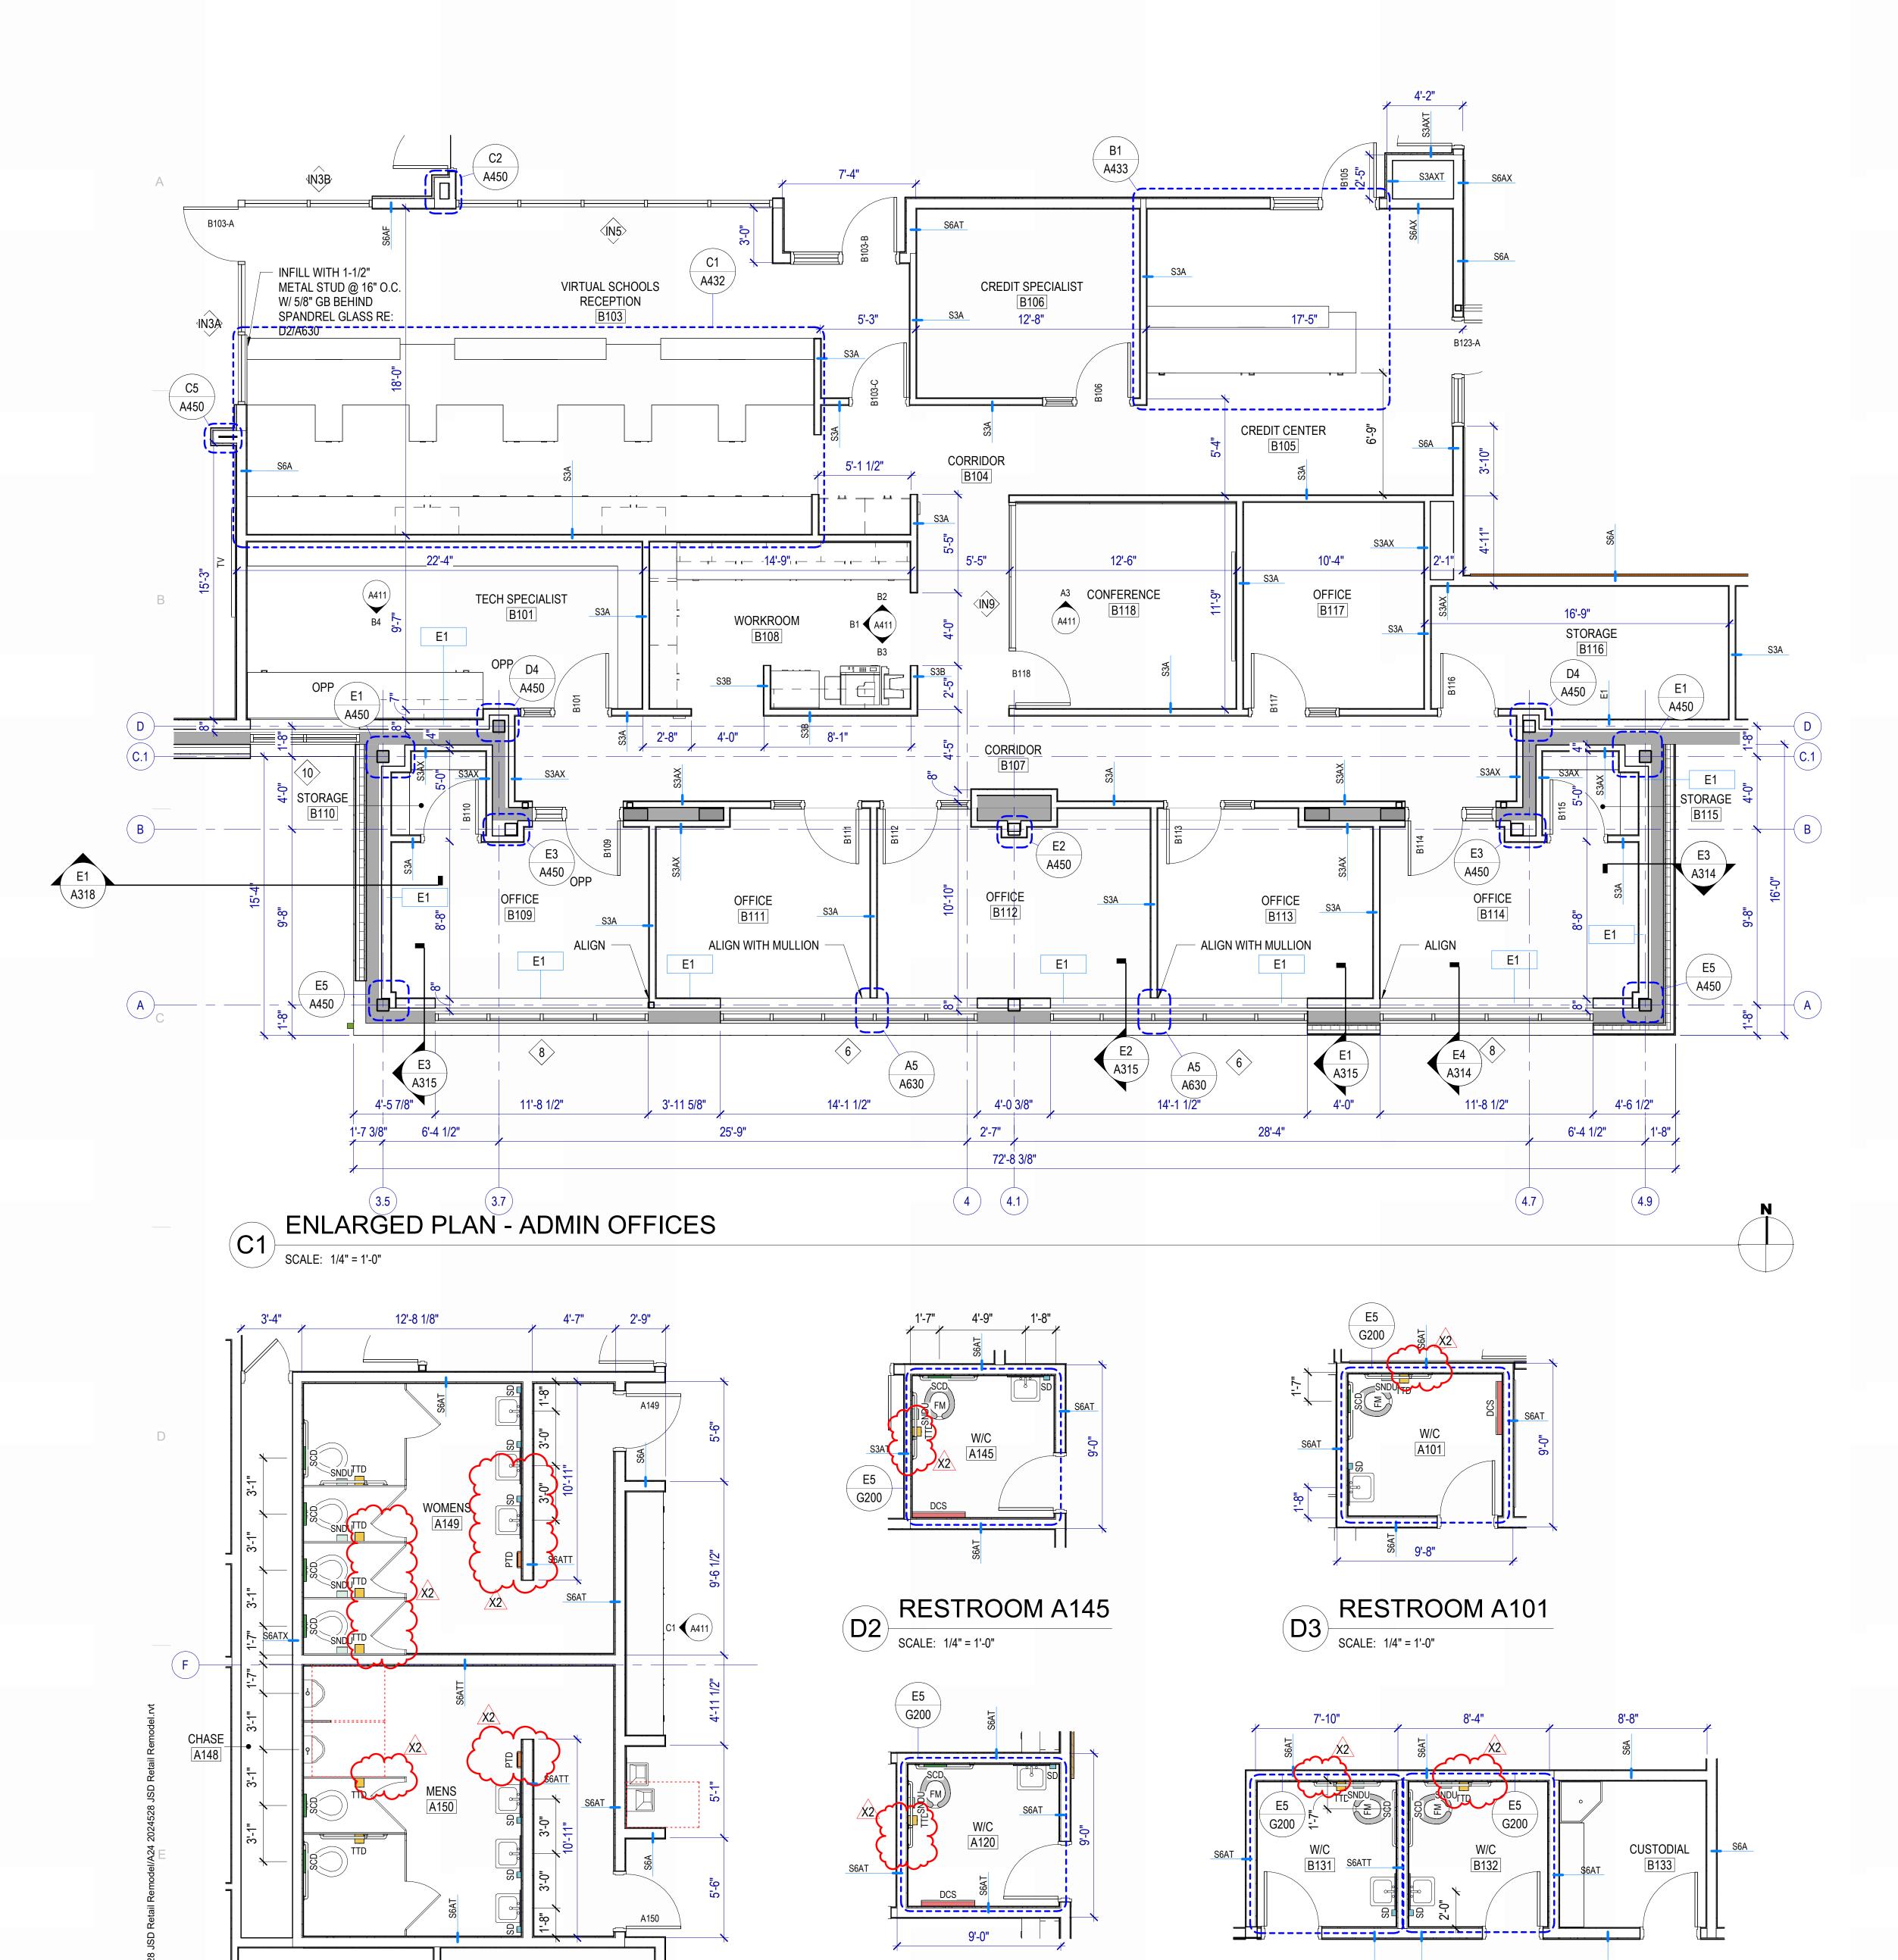

RESTROOM A120

RESTROOMS A149 & A150

SCALE: 1/4" = 1'-0"

PARTIAL PLAN GENERAL NOTES

References to sheets below are provided to aid in navigating the drawings.

RE: G200 for Fixture Mounting Heights.

RE: G400 for Floor, Roof and Exterior Wall Types.

RE: G500 for Interior Wall Types.

RE: A450 for Locker Types.

RE: A640-A642 for finish schedule.

Interior Wall Height: All walls are continuous from floor to roof or floor deck above, UNO.

Keynotes: Not all keynotes apply to this sheet.

LEGEND - TOILET ROOMS

DISPENSER, OFCI

FRAMED MIRROR

DISPENSER, OFCI

SANITARY NAPKIN DISPOSAL UNIT, OFCI

DISPENSER, OFCI

DIAPER CHANGING

WATER CLOSET

WALL HUNG URINAL

WALL HUNG LAVATORY

COUNTER MOUNTED SINK


MOP & BROOM HOLDER

WALL MOUNTED WATER

SOAP DISPENSER, OFCI

<u>PLAN</u> <u>ELEVATION</u>



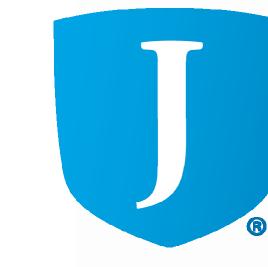


NTER

JORDAN LEARNING CENTER

©2023 MHTN ARCHITECTS, INC.

Confidentiality Notice:
This document is intended for use on the Project identified herein by individuals and companies involved in the design, permitting, bidding and construction of the Project. MHTN Architects, Inc. grants limited rights to distribute and reproduce this document for this express purpose only. Distribution, printing or copying this document for purposes other than those indicated is strictly prohibited. If a digital copy of this document is received in error, please delete it.

MHTN PROJECT NO. 2024528

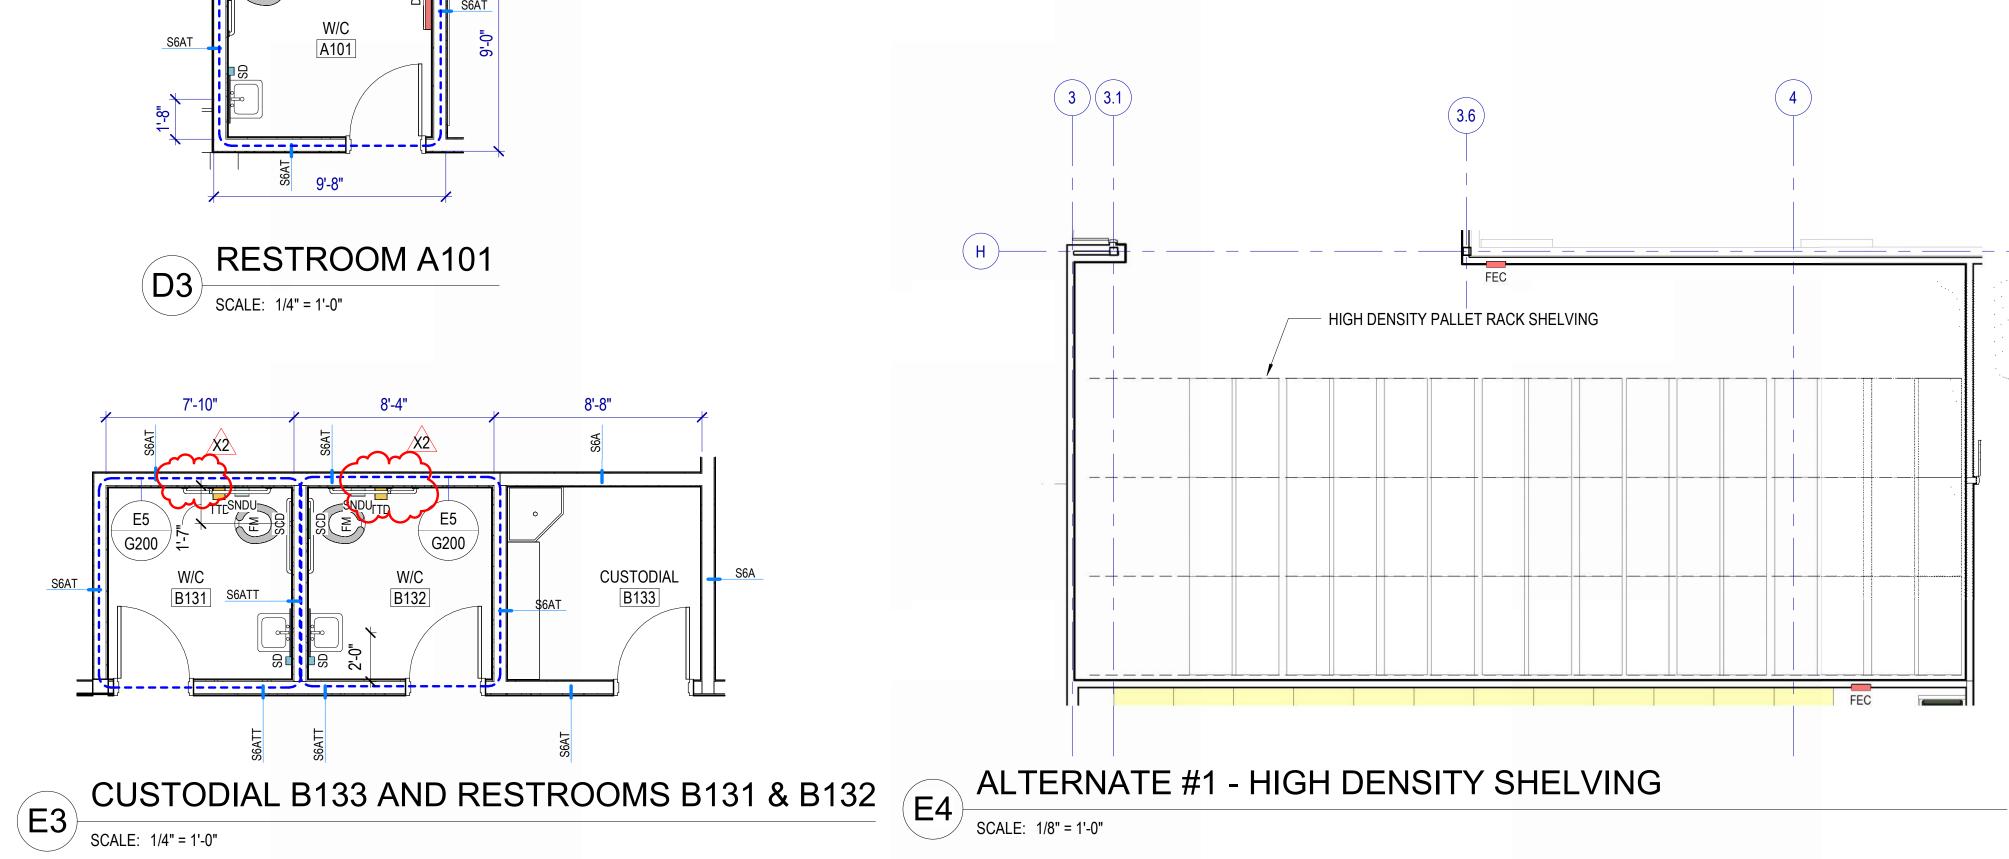


ISSUE
CONSTRUCTION DOCUMENTS
AUGUST 29, 2024

SHEET NAME


PARTIAL PLANS

REVISIONS CONTRACTOR TO VERIFY DRAWINGS IN FIELD USE REFLECT LAST REVISION DATE.

A400

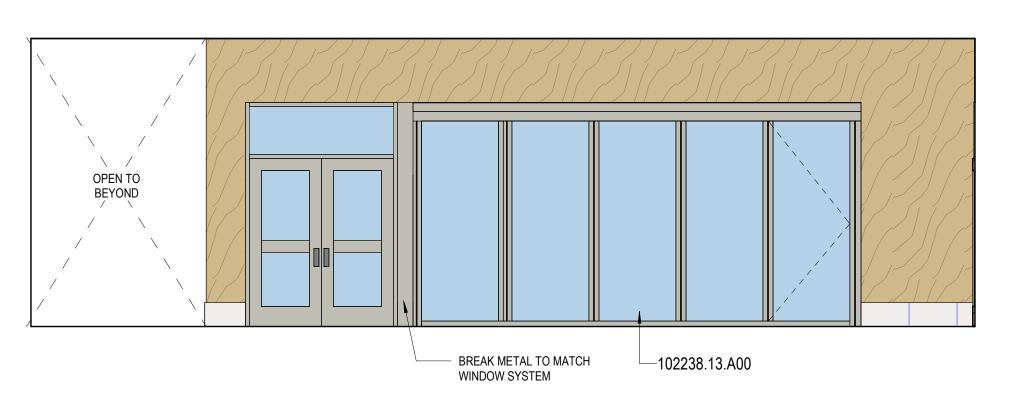

LOBBY B100 - NORTH LOBBY B SCALE: 1/4" = 1'-0"

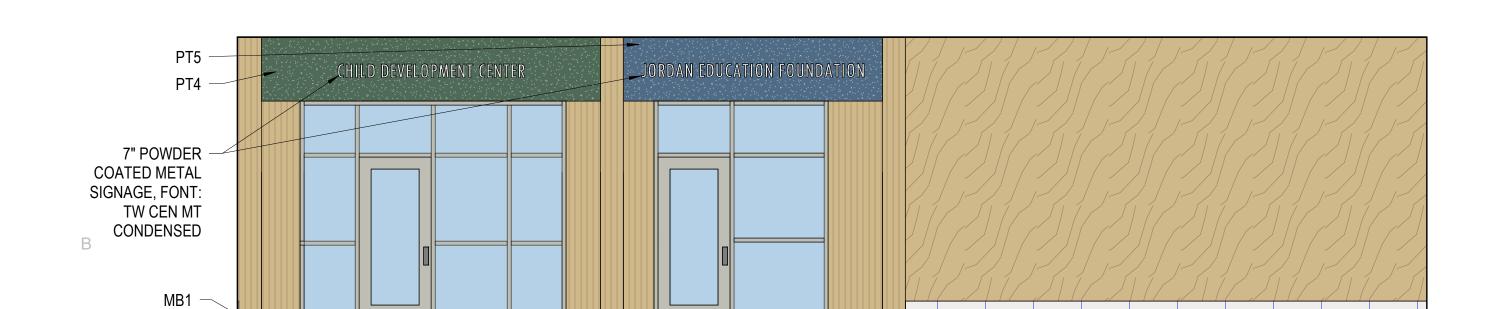

LOBBY B100 - SOUTH

LOBBY B100 - EAST

SCALE: 1/4" = 1'-0"


MB1 -




EXISTING COLUMN,

TO BE PAINTED

LOBBY B100 - WEST

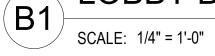


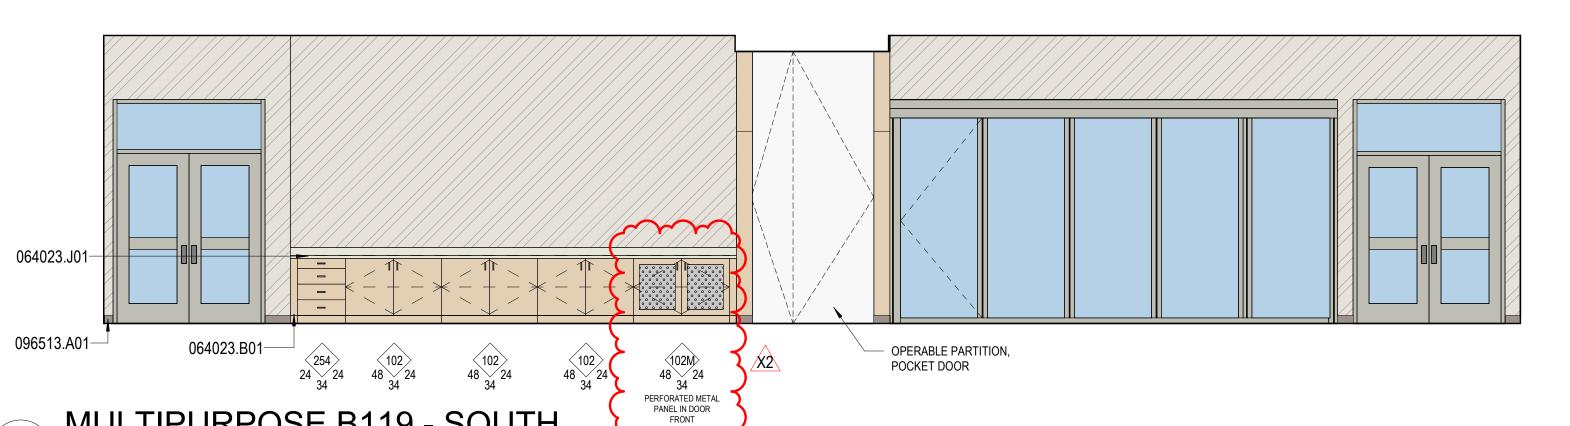

MULTIPURPOSE B119 - SOUTH C1 MULTIPU SCALE: 1/4" = 1'-0"


MB1

LOBBY B100 -SCALE: 1/4" = 1'-0"

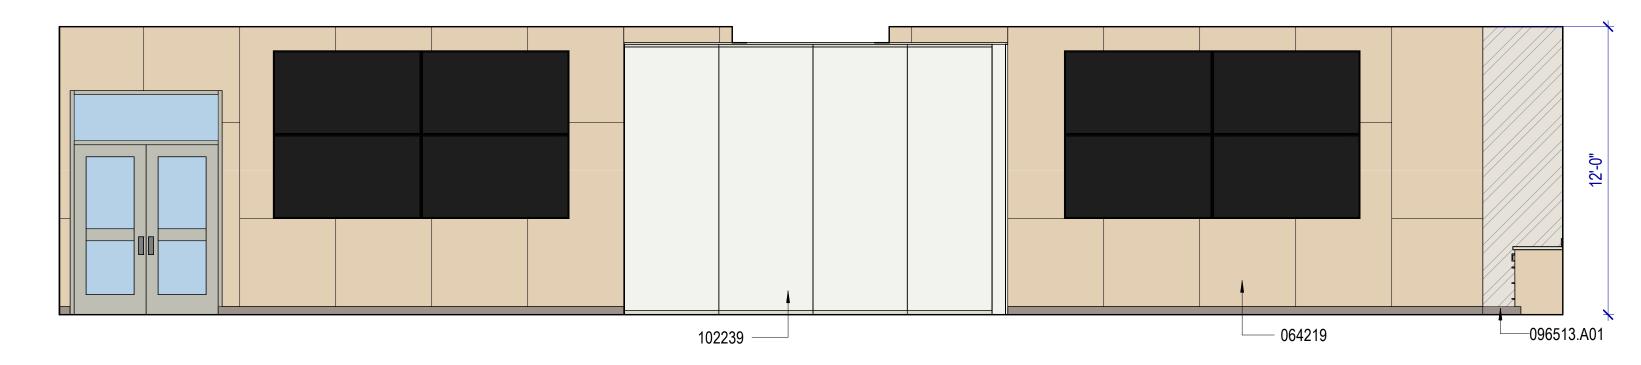


MULTIPURPOSE B119 - EAST

SCALE: 1/4" = 1'-0"

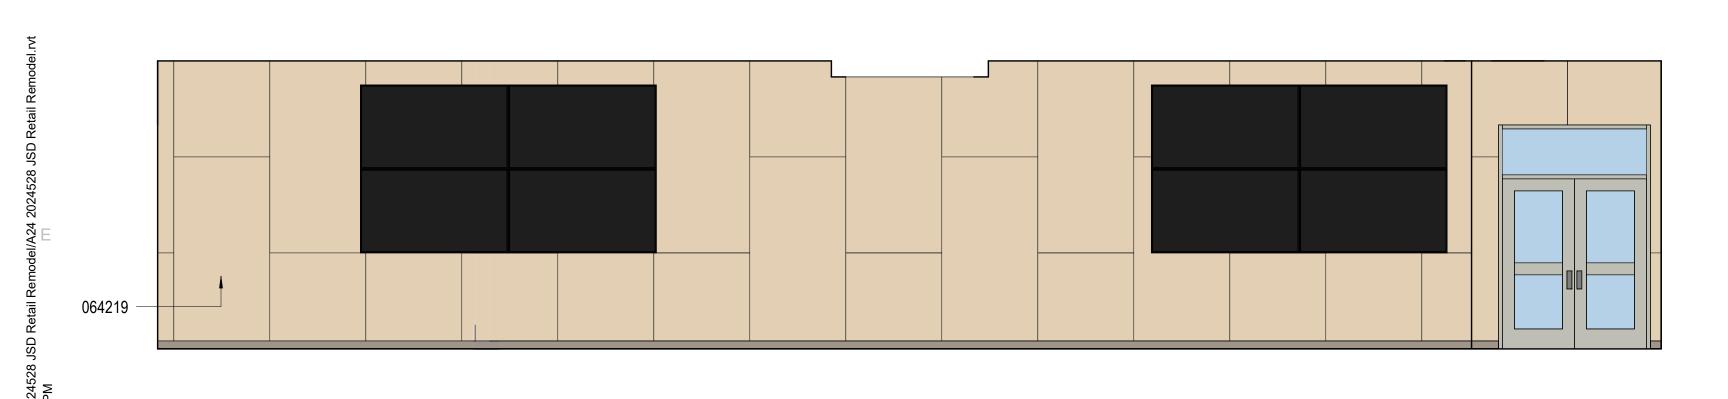

MULTIPURPOSE B119 - WEST SCALE: 1/4" = 1'-0"

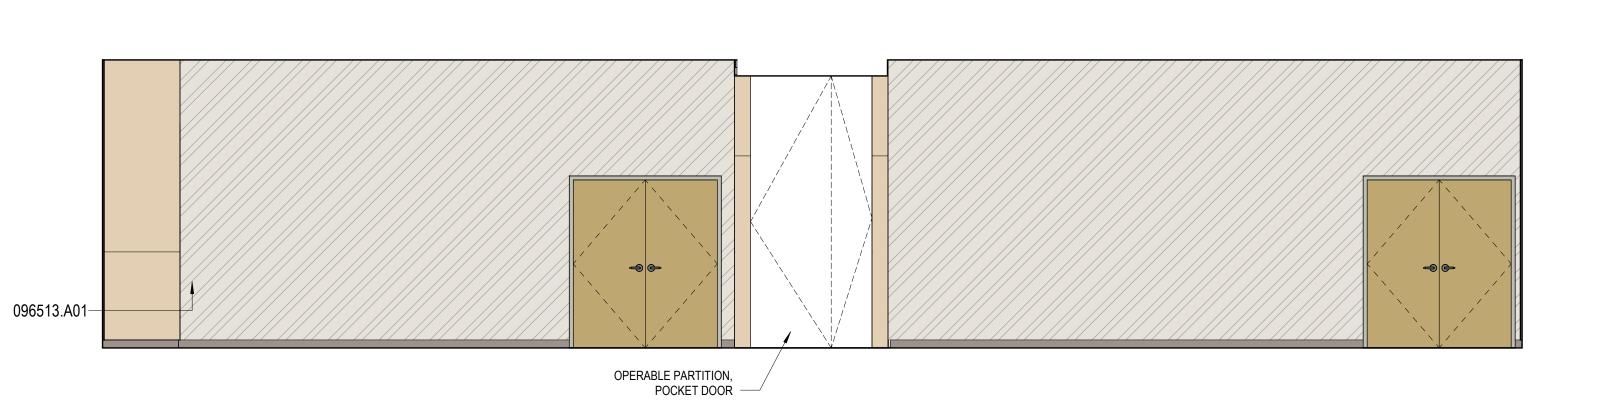

MULTIPURPOSE B119 - NORTH

SCALE: 1/4" = 1'-0"

INTERIOR ELEVATIONS GENERAL NOTES

RE: North American Architectural Woodwork Standards v3.0 (NAAWS), Cabinet Design Series for cabinet

RE: G500 for Interior Wall Types.

RE: A640A & A640B for the Finish Schedule.

Dimensions shown to walls or casework are to finished face of wall or cabinet, UNO.

Equipment indicated by dashed lines is a general representation and shown for coordination purposes only. Mechanical, electrical, plumbing and telecom rough-in locations are shown for general coordination purposes only. Refer to mechanical, electrical, plumbing and telecom drawings.

Countertops: 25" deep with 4" high backsplash, UNO. Provide sidesplashes at walls, tall cabinets or similar


Blocking: Provide blocking in walls at cabinets, wall-mounted accessories, equipment, display boards and similar items.

Finishes: Finishes are required on all exposed and semi-exposed surfaces, UNO. Wall elevations are not shown for walls where the Finish Schedule is deemed adequate to convey the intent.

Cabinet Locks: Provide locks on cabinet drawers and doors, keyed alike by room, UNO.

Casework Finishes: Provide laminate finishes on all exposed and semi-exposed surfaces as required by the specifications. Provide laminate finishes on concealed surfaces if required by the specifications. Refer to NAAWS Section 10.4.4 for definitions of exposed, semi-exposed and concealed surfaces.

LEGEND - INTERIOR ELEVATION

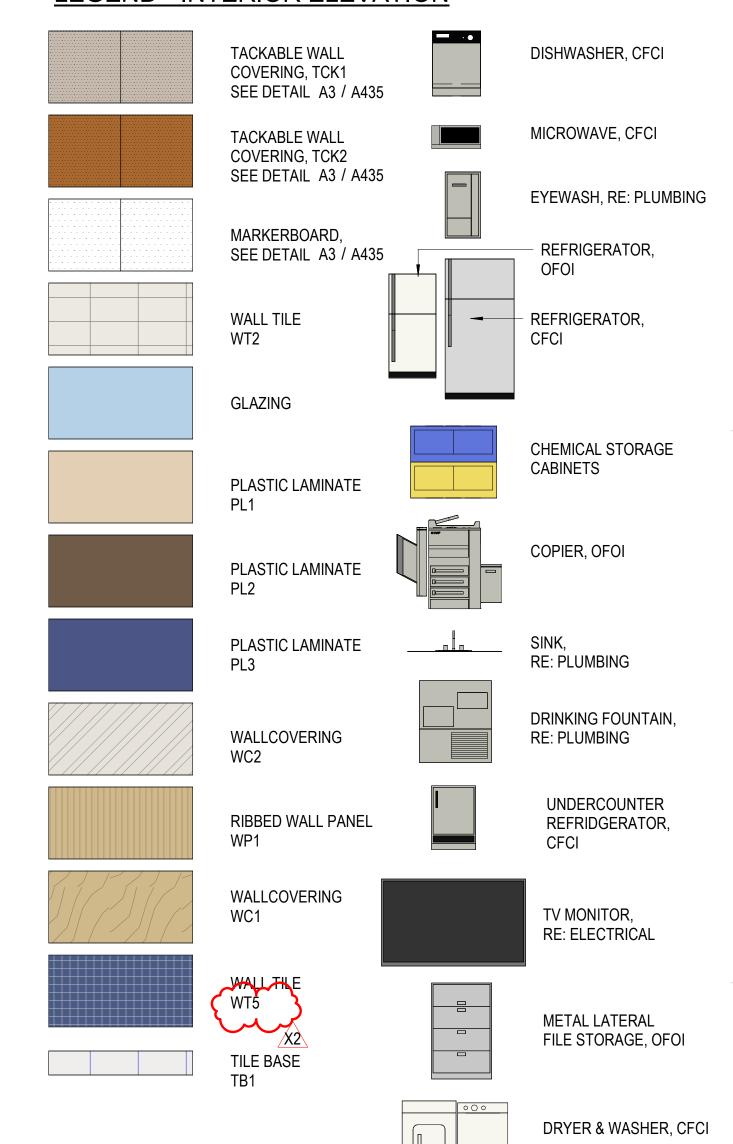

KEYNOTES

1-1/2" scheduled solid surface countertop w/ 4" backsplash SECTION 064219 - PLASTIC-LAMINATE-FACED WOOD PANELING

RESILIENT BASE

OPERABLE GLASS-PANEL PARTITIONS SECTION 102239 - FOLDING PANEL PARTITIONS мнти ркојест no.2024528

©2023 MHTN ARCHITECTS, INC.

Confidentiality Notice:
This document is intended for use on the Project identified herein by individuals and companies involved in the design, permitting, bidding and construction of the Project. MHTN Architects, Inc. grants limited rights to distribute and reproduce this document for this express purpose only. Distribution, printing or copying this document for purposes other than those indicated is strictly prohibited. If a digital copy of this document is received in error, please delete it.

REVISIONS CONTRACTOR TO VERIFY DRAWINGS IN FIELD USE REFLECT LAST REVISION DATE.

ARCHITECTS

280 South 400 West

www.mhtn.com

Z W

ARNING

SCF

Suite 250 Salt Lake City, Utah 84101 Telephone (801) 595-6700

MHTN Architects, Inc.

CONSTRUCTION DOCUMENTS AUGUST 29, 2024

INTERIOR **ELEVATIONS**

A412

								DOOF	R AND FRAM	IE SCHE	DULE										DOOR	AND FRAM	IE SCHE	DULE		
			DOOR			FRAM	E				(MIN)	h.					DOOR		FRAM	E				MIN)		
DOOR#	TYPE	WIDTH	HEIGHT	THICKNESS	MATERIAL	TYPE	MATERIAL	HEAD DETAIL	JAMB DETAIL	SILL DETAIL	FIRE RATING (I	HARDWARE SEMARKS	DOOR#	DOOR#	TYPE	WIDTH	HEIGHT THICKNESS	MATERIAL	ТҮРЕ	MATERIAL	HEAD DETAIL	JAMB DETAIL	SILL DETAIL	FIRE RATING (I	REMARKS	DOOR#
A100	FG	3'-0"	7'-0"	2"	AL	SEE PLAN	AL	C4/A610	D4/A610	_	<u> </u>	L01 CR, DR, 8 MIL SECURITY FILM ON GLAZING	A100	B103-A	FG (3'-0"	7'-0" 2 1/4"	AL	SEE PLAN	AL	C4/A610	D4/A610	-	AL03	CR, DR, 21 MIL MIN SECURITY FILM ON GLAZING	B103-A
A101		3'-0"		1 3/4"		1	НМ	C5/A610	D5/A610	E2/A610	-	08	A101	B103-B			7'-0" 1 3/4"		8	НМ	C5/A610	D5/A610	-	04		B103-B
A103		3'-0"		1 3/4"		1	HM	C5/A610	D5/A610	-	-	14	A103	B103-C			7'-0" 1 3/4"		1	HM	C5/A610	D5/A610	-	04		B103-C
A104 A106		3'-0" 3'-0"		1 3/4"	WD	8	HM HM	C5/A610 C5/A610	D5/A610 D5/A610	-	-	15 05	A104 A106	B105 B106			7'-0" 1 3/4" 7'-0" 1 3/4"		6	HM HM	C5/A610 C5/A610	D5/A610 D5/A610	-	04		B105 B106
A107		3'-0"		1 3/4"		8	НМ	C5/A610	D5/A610	-	-	05	A107	B109			7'-0" 1 3/4"		6	НМ	C5/A610	D5/A610	-	05		B109
A108		3'-0"	7'-0"	2"	AL	SEE PLAN	AL	C4/A610	D4/A610	-	- /	L04	A108	B110			7'-0" 1 3/4"		1	HM	C5/A610	D5/A610	-	22		B110
A109 A110-A		3'-0" 3'-0"	7'-0" 7'-0"	1 3/4"	WD WD	1 8	HM HM	C5/A610 C5/A610	D5/A610 D5/A610	-	-	06 8 MIL SECURITY FILM ON GLAZING	A109 A110-A	B111 B112			7'-0" 1 3/4" 7'-0" 1 3/4"		6	HM	C5/A610 C5/A610	D5/A610 D5/A610	-	05 05		B111 B112
A110-A		3'-0"		1 3/4"	AL	SEE PLAN	AL	C1/A330	D1/A330 & E1/A332	C2/A610	- ,	LO2 CR, DC, 8 MIL SECURITY FILM ON GLAZING	A110-A	B112			7'-0" 1 3/4"		6	HM	C5/A610	D5/A610	-	05		B112
A111	G	3'-0"		1 3/4"	WD	8	НМ	C5/A610	D5/A610	-	-	20 8 MIL SECURITY FILM ON GLAZING	A111	B114	G (3'-0"	7'-0" 1 3/4"	WD	6	НМ	C5/A610	D5/A610	-	05		B114
A112		3'-0"				8	HM	C5/A610	D5/A610	-	-	03 8 MIL SECURITY FILM ON GLAZING	A112	B115			7'-0" 1 3/4"	+	1	HM	C5/A610	D5/A610	-	22		B115
A113 A114-A		3'-0" 3'-0"		1 3/4"		1	HM HM	C5/A610 C5/A610	D5/A610 D5/A610	-	-	05 05	A113 A114-A	B116			7'-0" 1 3/4" 7'-0" 1 3/4"		6	HM	C5/A610 C5/A610	D5/A610 D5/A610	-	06		B116 B117
A114-B		3'-0"		1 3/4"		1	HM	C5/A610	D5/A610	-	-	05	A114-B	B118			7'-0" 2"	AL	SEE PLAN	AL	C4/A610	D4/A610	-	AL04		B117
A115		3'-0"		1 3/4"		1	НМ	C5/A610	D5/A610	-	-	05	A115	B119-A			7'-0" 1 3/4"		SEE PLAN	AL	C4/A610	D4/A610	-	AL06	CR, DR, 21 MIL SECURITY FILM ON GLAZING	B119-A
A116		3'-0" 3'-0"		1 3/4"		1	HM HM	C5/A610 C5/A610	D5/A610 D5/A610	-	-	20 02	A116 A117	B119-B B119-C			7'-1" 1 3/4" 7'-1" 1 3/4"		SEE PLAN	AL AL	C4/A610 C4/A610	D4/A610 D4/A610	-		CR CR	B119-B B119-C
A117		3'-0"		1 3/4"		<u> </u>	HM	C5/A610	D5/A610	-	-	02	A117 A118	B119-C		5-0	7-1 13/4	AL	SEE PLAN	AL	B5/A611 SIM	D4/A010	B4/A611 SIM		OPERABLE GLASS-PANEL PARTITION, CYLINDER	
A119		3'-0"	7'-0"		WD	1	НМ	C5/A610	D5/A610	-	-	02	A119												BY HARDWARE SUPPLIER, 21 MIL SECURITY FILM	
A120		3'-0"			WD	1	HM	C5/A610	D5/A610	E2/A610	-	08	A120	R110_F	FG (3'-0"	7'-1" 1 3/4"	ΔΙ	SEE PLAN	ΔΙ	C4/A610	D4/A610	_		ON GLAZING CR	B119-E
A121-A A121-B		3'-0" 3'-0"			WD WD	1	HM HM	C5/A610 C5/A610	D5/A610 D5/A610	-	-	06 06	A121-A A121-B				9'-4" 2 3/8"		SEE PLAN	/\L	E3/A630	E4/A630 & D2/A610	E2/A630	OH01	OPERABLE FOLDING PARTITION, 21 MIL SECURITY	
A121-B		3'-0"	7'-0"		WD	8	HM	C5/A610	D5/A610	-	-	03 8 MIL SECURITY FILM ON GLAZING	A121-B												FILM ON GLAZING	
A123		3'-0"		1 3/4"	WD	1	НМ	C5/A610	D5/A610	-	-	02	A123	B119-G B119-H							A4/A611 A4/A611	SEE PLAN SEE PLAN	B4/A611 B4/A611		OPERRABLE FOLDING PARTITION, MO OPERABLE FOLDING PARTITION, MO	B119-G B119-H
A124		3'-0"		1 3/4"		1	HM	C5/A610	D5/A610	-	-	02	A124		RAC				_		A4/A011	SLL FLAN	B4/A611 SIM		VERTICAL FOLDING RETRACTABLE WALL, MO	B119-11
A125 A126		3'-0" 3'-0"		1 3/4"		<u> </u>	HM HM	C5/A610 C5/A610	D5/A610 D5/A610	-	-	02 20	A125 A126	B119-K	RAC				-				B4/A611 SIM		VERTICAL FOLDING RETRACTABLE WALL, MO	B119-K
A127		3'-0"		1 3/4"		1	HM	C5/A610	D5/A610	-	-	02	A127	B120			7'-0" 1 3/4"		3	HM	C5/A610	D5/A610	-	23		B120
A128		3'-0"		1 3/4"		1	НМ	C5/A610	D5/A610	-	-	02	A128	B121 B122			7'-0" 1 3/4" 7'-0" 2" (WD	3 7 (AL	C5/A610 C5/A610	D5/A610 D5/A610	-	23 AL08	PROVIDE ELECTIFIED HARDWARE, 21 MIL	B121 B122
A129	_	3'-0"		1 3/4"		8	HM	C5/A610	D5/A610	-	-	05 8 MIL SECURITY FILM ON GLAZING	A129	DIZZ	10 ,	3-0	7-0 2	كئر	X2 ' \		X2	DSIACTO			SECURITY FILM ON GLAZING	DIZZ
A130 A131		3'-0" 3'-0"			WD WD	<u> </u>	HM HM	C5/A610 C5/A610	D5/A610 D5/A610	-	-	01 8 MIL SECURITY FILM ON GLAZING 03 8 MIL SECURITY FILM ON GLAZING	A130 A131	B123-A		3'-0"			8	HM	C5/A610	D5/A610	-	07	8 MIL SECURITY FILM ON GLAZING	B123-A
A132-A		3'-0"			WD	8	НМ	C5/A610	D5/A610	-	-	10 CR, 8 MIL SECURITY FILM ON GLAZING	A132-A	B123-B B123-C		3'-0"	7'-0" 1 3/4"	WD	8	HM	C5/A610 B5/A611 SIM	D5/A610 SEE PLAN	- B4/A611	03	8 MIL SECURITY FILM ON GLAZING OPERABLE FOLDING PARTITION	B123-B B123-C
A132-B	G					8	НМ	C5/A610	D5/A610	-	-	10 CR, 8 MIL SECURITY FILM ON GLAZING	A132-B	B123-C		3'-0"	7'-0" 1 3/4"	WD	1	НМ	C5/A610	D5/A610	-	06	OF LIVABLE FOLDING FAITHTON	B123-C
A133		3'-0" 3'-0"		1 3/4"		1	HM	C5/A610 C5/A610	D5/A610 D5/A610	-	-	01	A133	B125-A	FG 3	3'-0"	7'-0" 1 3/4"	WD	8	НМ	C5/A610	D5/A610	-	03	8 MIL SECURITY FILM ON GLAZING	B125-A
A134 A135		3'-0"		1 3/4"		1	HM HM	C5/A610	D5/A610	-	-	06 06	A134 A135	B125-B	SL 7	"-10"	9'-2" 1 3/4"					D4/A610		27	STOREFRONT SLIDING MALL FRONT SYSTEM, 8 MIL SECURITY FILM ON GLAZING	B125-B
A136		3'-0"		1 3/4"		1	НМ	C5/A610	D5/A610	E2/A610	-	08	A136	B126-A	FG 3	3'-0"	7'-0" 1 3/4"	WD	8	HM	C5/A610	D5/A610	-	03	8 MIL SECURITY FILM ON GLAZING	B126-A
A137-A		3'-0"		1 3/4"		1	НМ	C5/A610	D5/A610	-	-	06	A137-A				9'-2" 1 3/4"					D4/A610		27	STOREFRONT SLIDING MALL FRONT SYSTEM, 8	B126-B
A137-B A138	N G	3'-0"		1 3/4"		1 8	HM HM	C5/A610 C5/A610	D5/A610 D5/A610	-	-	06 8 MIL SECURITY FILM ON GLAZING	A137-B A138	B127	EC '	ייט יכ	7'-0" 1 3/4"	WD	0	HM	C5/A610	D5/A610		03	MIL SECURITY FILM ON GLAZING 8 MIL SECURITY FILM ON GLAZING	B127
A139		3'-0"		1 3/4"		8	HM	C5/A610	D5/A610	-	-	11 CR, 8 MIL SECURITY FILM ON GLAZING	A130	B128-A			7'-0" 1 3/4" 7'-0" 1 3/4"		8	НМ	C5/A610	D5/A610	-	10	CR, 8 MIL SECURITY FILM ON GLAZING	B128-A
A140-A	FG		7'-0"	1 3/4"	WD	8	НМ	C5/A610	D5/A610		-	10 CR, DR, 21 MIL SECURITY FILM ON GLAZING	A140-A	B128-B			7'-0" 1 3/4"		8	НМ	C5/A610	D5/A610	-	10	CR	B128-B
A140-B				1 3/4"		2	HM	C3/A610	D3/A610	C2/A610	-	13 INSULATED, PROVIDE CR, DC	A140-B	B129-A			7'-0" 1 3/4"		5	HM	C5/A610	D5/A610	-	21		B129-A
A141 A142				1 3/4"		<u>გ</u>	HM HM	C5/A610 C5/A610	D5/A610 D5/A610	-	-	16 18 ED	A141 A142	B129-B B130			7'-0" 1 3/4" 7'-0" 1 3/4"		1 1	HM HM	C5/A610 C5/A610	D5/A610 D5/A610	-	06		B129-B B130
A143				1 3/4"		1	HM	C5/A610	D5/A610	-	-	05	A143	B131			7'-0" 1 3/4"		1	HM	C5/A610	D5/A610	E2/A610	08		B131
A144				1 3/4"		1	НМ	C5/A610	D5/A610	-	-	17	A144	B132			7'-0" 1 3/4"		1	НМ	C5/A610	D5/A610	E2/A610	08		B132
A145 A146				1 3/4"		1	HM HM	C5/A610 C5/A610	D5/A610 D5/A610	E2/A610	-	08 12 CR	A145 A146	B133			7'-0" 1 3/4"		1	HM	C5/A610	D5/A610	-	06	CD	B133
A146				1 3/4"		1	HM	C5/A610	D5/A610	-	-	12 CR	A140	B134 B135-A			7'-0" 1 3/4" 7'-0" 1 3/4"		1	HM HM	C5/A610 C3/A610	D5/A610 D3/A610	- C2/A610	12 13	CR INSULATED, PROVIDE CR, DC	B134 B135-A
A148	F	2'-6"	7'-0"	1 3/4"	WD	1	НМ	C5/A610	D5/A610	-	-	20	A148	B135-B	OH 8	8'-0"	8'-0" 3"		_						EXISTING OH DOOR - PROVIDE DC	B135-B
A149		3'-0"		1 3/4"		1	HM	C5/A610	D5/A610	E2/A610	-	09	A149	B135-C			8'-0" 3"	0===		0===	B.11.55				EXISTING OH DOOR - PROVIDE DC	B135-C
A150 A151		3'-0" 3'-0"		1 3/4"		1	HM HM	C5/A610 C5/A610	D5/A610 D5/A610	E2/A610	-	09 06	A150 A151	B135-D B135-E		0'-0"	10'-0" 3" 7'-0" 1 3/4"	STEEL	2	STEEL	D1/A331 C5/A610	E1/A331 D5/A610		OH01 26	INSULATED OH DOOR - PROVIDE MO, DC	B135-D B135-E
A152				1 3/4"		1	HM	C5/A610	D5/A610	-	-	05	A151	B136			7'-0" 1 3/4" 7'-0" 1 3/4"	_	1	НМ	C5/A610	D5/A610	-	01	UI X	B136
-	FG	3'-0"	7'-0"	2 1/4"	AL	SEE PLAN	AL	C4/A610	D4/A610	-		L02 CR, DR, 8 MIL SECURITY FILM ON GLAZING	A154					_	SEE PLAN		C1/A330	D1/A330 & E2/A331	C2/A610	13	INSULATED, PROVIDE CR, D, 21 MIL SECURITY	B137
			7'-0"			SEE PLAN	AL	C4/A610	D4/A610	-	- /	NL04	A155	Grand total	al· 117										FILM ON GLAZING	
A157 A161				1 3/4"		SEE PLAN	HM AL	C5/A610 C1/A330	D5/A610 D1/A330 & E2/A331	- C2/A610	- -X1	04 CR, DC, 8 MIL SECURITY FILM ON GLAZING	A157 A161	Gianu loli	aı. 11 <i>1</i>											
B100-A			. •						D1/A330 & D1/A332		/ / / / / /	NOT CR DC ADA	R100-A													

B100-A

B100-B

B101

DOOR SCHEDULE GENERAL NOTES

RE: A620 for the Glazing Schedule.

RE: Division 8 Section "Door Hardware" for hardware sets.

Door Leaves: At each door, provide the number of leaves shown on the plans. Where two leaves are shown, provide equal leaves, UNO.

Frame Depth: Coordinate hollow metal frame depth with wall thickness, wrapping stud framed walls. Provide depths as scheduled for masonry walls, UNO.

Abbreviations: Door and Frame Schedule Remarks abbreviations:

ADA ADA Actuator
DC Door Contact

CR Card Reader DR Door Release

EL Electric Latch

ES Electric Strike MO Motor Operation ED Exit Device

OP Operable Partition OGP Operable Glass Partition

OH Overhead RAC Retractable Acoustical Wall



www.mhtn.com



ENTER

ARNING

S

HOLLOW METAL FRAME DEPTH SCHEDULE MASONRY/CONCRETE DEPTH FRAME DEPTH 5 3/4" 6 3/4" 8 3/4" 10"

12"

GLAZING SCHEDULE

10 3/4"

1 CLEAR SILICONE SEALANT, CONTINUOUS


A01 6mm (1/4") CLEAR ANNEALED FLOAT GLASS

1" LOW-E COATED, CLEAR HEAT-STRENGTHENED INSULATING GLASS T01 6mm (1/4") CLEAR TEMPERED FLOAT GLASS

T02 12mm (1/2") CLEAR TEMPERED FLOAT GLASS

T22 1" LOW-E COATED, CLEAR TEMPERED INSULATING GLASS T24 1" LOW-E COATED, INSULATING SPANDREL GLASS

> ©2023 MHTN ARCHITECTS, INC. Confidentiality Notice:
> This document is intended for use on the Project identified herein by individuals and companies involved in the design, permitting, bidding and construction of the Project. MHTN Architects, Inc. grants limited rights to distribute and reproduce this document for this express purpose only. Distribution, printing or copying this document for purposes other than those indicated is strictly prohibited. If a digital copy of this document is received in error, please delete it.

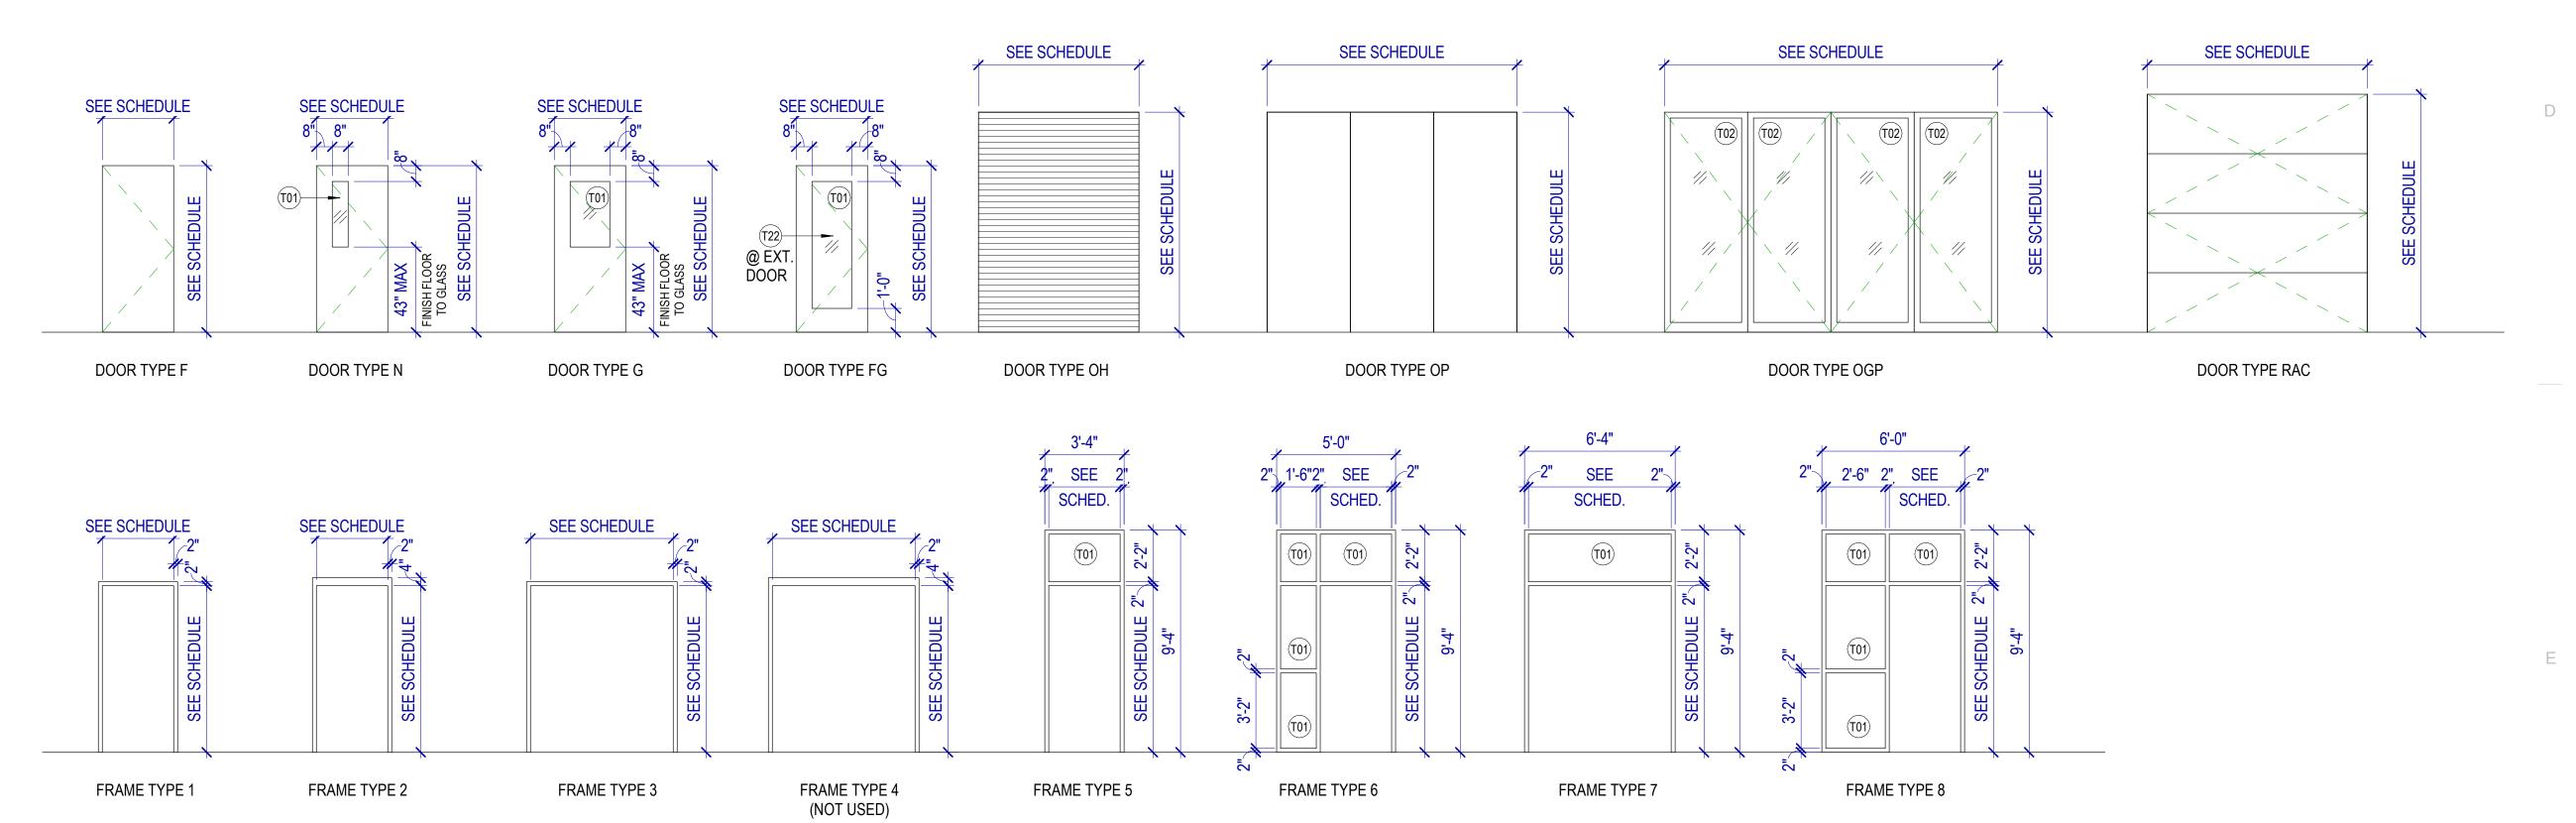

DOOR & FRAME TYPES

AL07 CR, DC, ADA

AL05 EL, DC

05

6'-0" 7'-0" 2" AL SEE PLAN AL C1/A330 D1/A330 & D1/A332 E1/A330

6 HM C5/A610

D1/A330 & D1/A332 | E1/A330

B100-B FG 6'-0" 7'-0" 2" AL SEE PLAN AL C1/A330

B101 G 3'-0" 7'-0" 1 3/4" WD

Original drawing is 30 x 42. Do not scale contents of this drawing.

MHTN PROJECT NO. 2024528


REVISIONS CONTRACTOR TO VERIFY DRAWINGS IN FIELD USE REFLECT LAST REVISION DATE. NO.△ DATE DESCRIPTION
X1 9/06/2024 ADDENDUM#1 X2 9/13/2024 ADDENDUM #2

CONSTRUCTION DOCUMENTS

AUGUST 29, 2024

DOOR SCHEDULE

A600

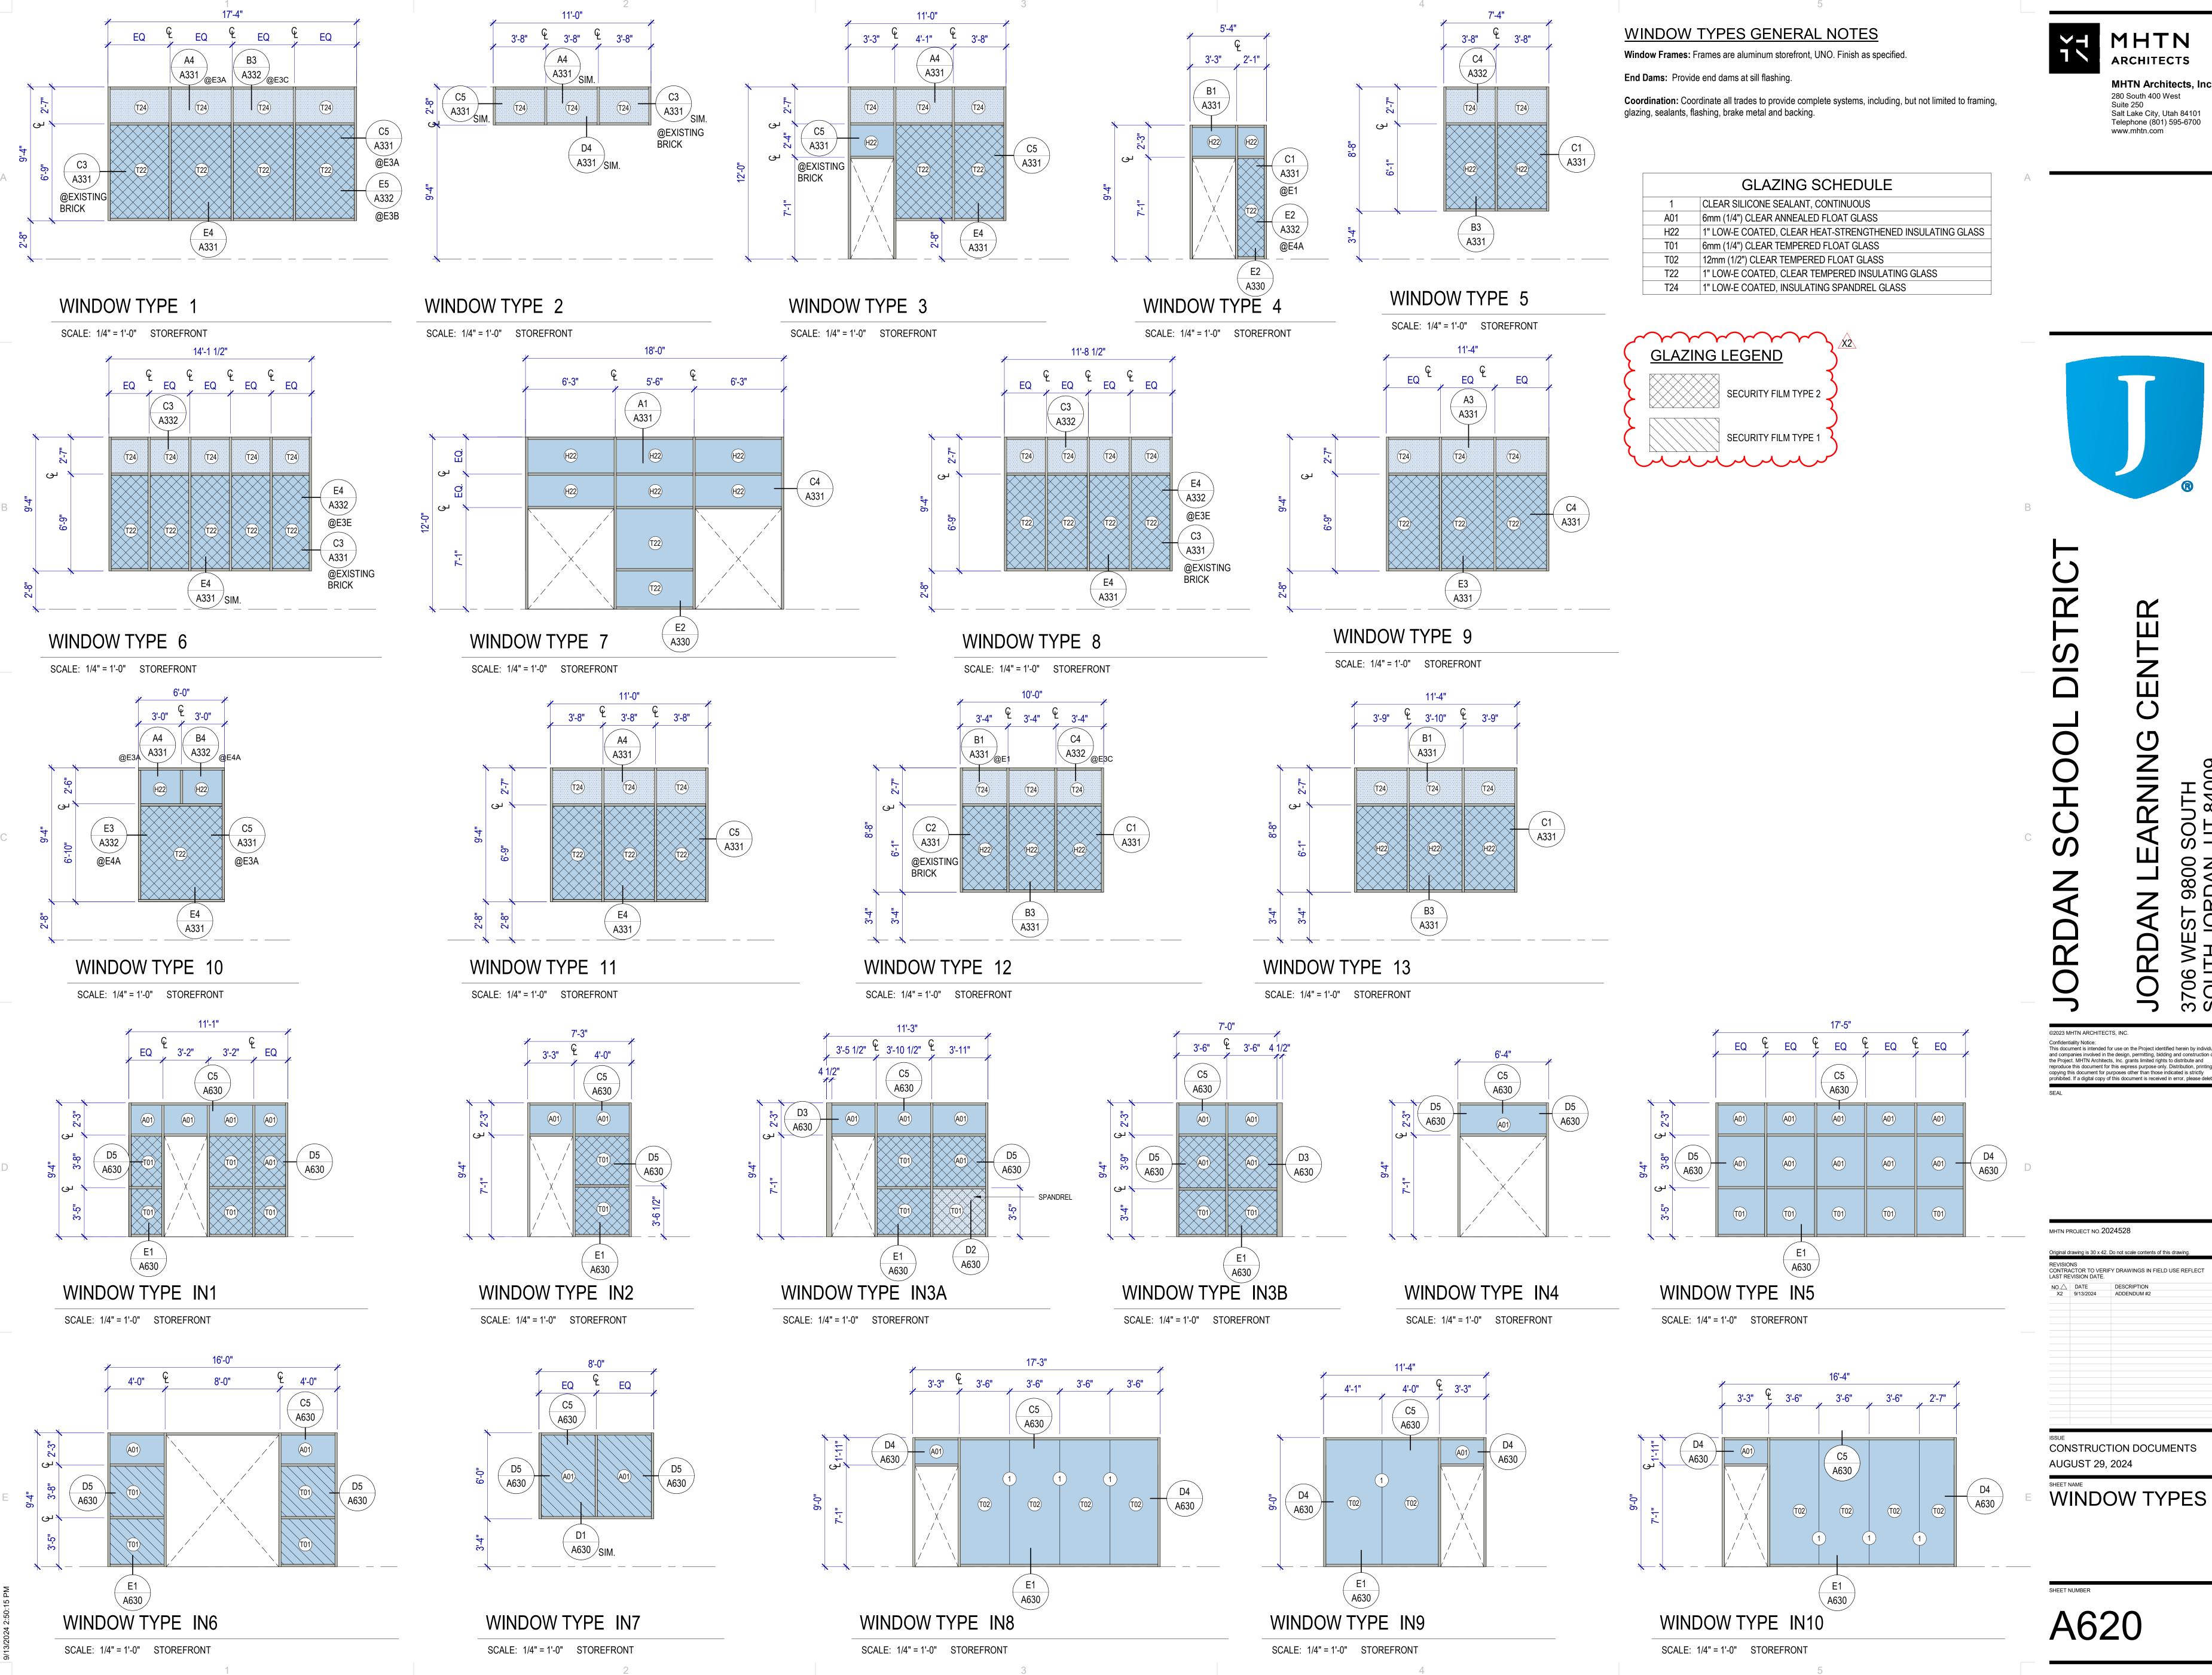

MHTN ARCHITECTS MHTN Architects, Inc.



Confidentiality Notice:
This document is intended for use on the Project identified herein by individuals and companies involved in the design, permitting, bidding and construction of the Project. MHTN Architects, Inc. grants limited rights to distribute and reproduce this document for this express purpose only. Distribution, printing or copying this document for purposes other than those indicated is strictly prohibited. If a digital copy of this document is received in error, please delete it.

REVISIONS CONTRACTOR TO VERIFY DRAWINGS IN FIELD USE REFLECT LAST REVISION DATE.

CONSTRUCTION DOCUMENTS

				FII	VISH	H SC	HED	DULE	E AR	EA A	4	
				HS.		ALL - 동	_			NISH		
		FLOOR FINISH	BASE FINISH	NORTH WALL FINISH	EAST WALL FINISH	SOUTH WALL FINISH	WEST WALL FINISH	CEILING FINISH	CABINET FINISH	COUNTER TOP FINISH		
RM#	ROOM NAME	FLC	BAS	Š	EAS	SOI	WE	CEI	CAE	100	REMARKS	RM#
A100	WAITING	SEE PLAN	RB1	WC4	PT1	PT1	PT4, PL1	SEE RCP				A100
A101	W/C	SEE PLAN	TB2	WT2	WT2	WT2	WT4	SEE RCP		~~	<u> </u>	A101
A102	OFFICE	SEE PLAN	RB1	PT1	PT1, PT4	PT1	PT1	SEE RCP	PL	•	}	A102
A103	RECEPTION	SEE PLAN	RB1		PT4		PT4	SEE RCP	PL1	SSC		A103
A104	RECORDS	SEE PLAN	RB1	PT1	PT1	PT1	PT1	SEE RCP	PL1			A104
A105	CORRIDOR	SEE PLAN	RB1	PT1, PT6	PT1, PT6, WD, WC4	PT1, PT6	PT1, PT6, WD, WC4	SEE RCP				A105
A106	ADMIN OFFICE	SEE PLAN	RB1	PT1	PT1	PT1	PT1	SEE RCP				A106
A107	ADMIN OFFICE		RB1	PT1	PT1	PT1	PT1	SEE RCP				A107
A108	CONFERENCE	SEE PLAN	RB1	PT1	PT1	PT1	PT1	SEE RCP				A108
A109	STORAGE	SEE PLAN	RB1	PT1	PT1	PT1	PT1	SEE RCP				A109
A110	MOTOR ROOM	SEE PLAN	RB1	PT1	PT1	PT1	PT1	SEE RCP				A110
A111	SENSORY/BALL ROOM	SEE PLAN	RB1	PT1	PT1	PT1	PT1	SEE RCP				A111
A112	COMMUNICATION	SEE PLAN	RB1	PT1, TCK1	PT1	PT1	PT1	SEE RCP	PL1	PL4		A112
A113	NURSE	SEE PLAN	RB1	PT1	PT1	PT1	PT1	SEE RCP				A113
A114	SANITARY	SEE PLAN	RB1	PT1	PT1	PT1	PT1	SEE RCP	PL1	PL4		A114
A115	NURSE	SEE PLAN	RB1	PT1	PT1	PT1	PT1	SEE RCP				A115
A116	STORAGE	SEE PLAN	RB1	PT1	PT1	PT1	PT1	SEE RCP				A116
A117	TESTING	SEE PLAN	RB1	PT1	WC4	PT1	PT1	SEE RCP				A117
A118	TESTING	SEE PLAN	RB1	PT1	WC4	PT1	PT1	SEE RCP				A118
A119	TESTING	SEE PLAN	RB1	PT1	WC4	PT1	PT1	SEE RCP				A119
A120	W/C	SEE PLAN	TB2	WT4	WT2	WT2	WT2	SEE RCP				A120
A121	STORAGE	SEE PLAN	RB1	PT1	PT1	PT1	PT1	SEE RCP				A121
A122	TODDLER	SEE PLAN	RB1	PT1	PT1	PT1, TCK1	PT1	SEE RCP	PL1	PL4		A122
A123	TESTING	SEE PLAN	RB1	PT1	WC4	PT1	PT1	SEE RCP				A123
A124	TESTING	SEE PLAN	RB1	PT1	WC4	PT1	PT1	SEE RCP				A124
A125	TESTING	SEE	RB1	PT1	WC4	PT1	PT1	SEE				A125
A126	STORAGE	PLAN SEE	RB1	PT1	PT1	PT1	PT1	RCP SEE RCP				A126
A127	TESTING	PLAN SEE	RB1	PT1	WC4	PT1	PT1	RCP SEE RCP				A127
A128	TESTING	PLAN SEE	RB1	PT1	WC4	PT1	PT1	RCP SEE				A128
A129	OFFICE	PLAN SEE	RB1	PT1	PT1	PT1	PT1	RCP SEE				A129
A130	AUDIOLOGY	PLAN SEE DLAN	RB1	PT1	PT1	PT1	PT1	RCP SEE RCP	PL1	PL4		A130
		PLAN						RCP				

					W	ALL				_		
RM#	ROOM NAME	FLOOR FINISH	BASE FINISH	NORTH WALL FINISH	EAST WALL FINISH	SOUTH WALL FINISH	WEST WALL FINISH	CEILING FINISH	CABINET FINISH	COUNTER TOP FINISH	REMARKS	RM#
A131	TODDLER	SEE	RB1	PT1,	PT1	PT1	PT1	SEE	PL1	PL4	TALIVII II III	A131
A132	TEACHER TEAM	PLAN SEE PLAN	RB1	TCK1 PT1	PT1	PT1	PT1	RCP SEE RCP				A132
A133	WORK ROOM	SEE PLAN	RB1	PT1	PT1	PT1	PT1	SEE RCP	PL1	PL4		A133
A134	STORAGE	SEE PLAN	RB1	PT1	PT1	PT1	PT1	SEE RCP				A134
A135	STORAGE	SEE	RB1	PT1	PT1	PT1	PT1	SEE				A135
A136	W/C	PLAN SEE PLAN	TB2	WT4	WT2	WT2	WT2	RCP SEE RCP				A136
A137	STORAGE	SEE PLAN	RB1	PT1	PT1	PT1	PT1	SEE RCP				A137
A138	TODDLER	SEE PLAN	RB1	PT1	PT1	PT1, TCK1	PT1	SEE	PL1	PL4	X2	A138
A139	COACH TEAM	SEE	RB1	PT1	PT1	PT1	PT1	SEE	PL	•	}	A139
A140	CORRIDOR	PLAN SEE PLAN	RB1	PT1	PT1	PT1	PT1, WT2	RCP SEE RCP	PL1	SS1	<u>ک</u> ر	A140
A141	BREAK ROOM	SEE PLAN	RB1	PT1, WT5	PT1, WT5	PT1	PT1	SEE RCP	PL1, PL3	SS1		A141
A142	ELECTRICAL	SEE PLAN	RB1	PT1	PT1	PT1	PT1	SEE RCP				A142
A143	CUSTODIAL OFFICE	SEE PLAN	RB1	PT1	PT1	PT1	PT1	SEE RCP				A143
A144	LAUNDRY / RECEIVING	SEE PLAN	RB1	PT1	PT1	PT1	PT1	SEE RCP	PL1	PL4		A144
A145	W/C	SEE PLAN	TB2	WT4	WT2	WT2	WT2	SEE RCP				A145
A146	CUSTODIAL	SEE PLAN	RB1	PT1	PT1	PT1	PT1	SEE RCP				A146
A147	MDF	SEE PLAN	RB1	PT1	PT1	PT1	PT1	SEE RCP				A147
A148	CHASE	SEE PLAN	RB1	PT1	PT1	PT1	PT1	SEE RCP				A148
A149	WOMENS	SEE PLAN	TB2	WT2	WT2, WT3	WT2	WT2, WT3	SEE RCP				A149
A150	MENS	SEE PLAN	TB2	WT2	WT2, WT3	WT2	WT2, WT3	SEE RCP				A150
A151	STORAGE	SEE PLAN	RB1	PT1	PT1	PT1	PT1	SEE RCP				A151
A152	OFFICE	SEE PLAN	RB1	PT1	PT1	PT1	PT1	SEE RCP				A152
A153	PRINT	SEE PLAN	RB1	PT1	PT1	PT1	PT1	SEE RCP	PL2	SS1		A153
A154	RECEPTION	SEE PLAN	RB1	WP2	PT1	WC5	PT1, PT5	SEE RCP	PL2	QTZ1		A154
A155	CONFERENCE	SEE PLAN	RB1	PT1		PT1	WC5	SEE RCP				A155
A156	OUTDOOR PLAY		DD4	DT4	DT4	DT4	DTC					A156
A157	OPEN	SEE PLAN	RB1	PT1	PT1	PT1	PT5	SEE RCP				A157
A158	CORRIDOR	SEE PLAN	RB1	PT1	PT1	PT1	PT1	SEE RCP				A158
A159	CORRIDOR	SEE PLAN	RB1	PT1	PT1	PT6		SEE RCP				A159
A160	CORRIDOR	SEE PLAN	RB1	PT6	PT1	PT1		SEE RCP				A160
A161	CORRIDOR	SEE PLAN	RB1	PT1	PT1	PT1	PT1	SEE				A161

FINISH SCHEDULE GENERAL NOTES

RE: A653 for typical floor finish transition details

RE: A651 for Floor Pattern Plans

elevations, provide 4" rubber base.

Provide finishes as indicated in the finish schedule. Refer to interior elevations, where drawn, for clarification, dimensions and additional information. The absence of an interior elevation does not override the requirement to provide the finish indicated in the schedule.

Where a finish is partly hidden by an object, extend that finish behind the object.

Where multiple finishes are scheduled, refer to interior elevations and floor pattern plans for transition

which in a floor plan view may obscure the extent of the floor finish. Base: Where base is scheduled for a room, provide base at all walls whether shown in elevation,

Floor: Extend floor finishes into knee spaces at cabinets, under counters and under all other objects,

Walls: Extend wall finishes behind cabinets, behind mirrors, and into other areas that may be hidden in

including alcoves and offsets. At gypsum board walls, if no base is scheduled or shown in interior

Ceilings: Paint areas above suspended ceilings that are visible from below. Color: black.

Doors, Windows and Frames: Unless specified to be pre-finished at the factory, provide paint finish on hollow metal doors and hollow metal door and window frames. Color as indicated, or if not indicated, then as selected by the Architect. Provide specified stain finish at wood doors.

Unfinished and Primed Metal Surfaces: Paint all unfinished and primed metal surfaces that are visible with the specified system(s). Color by Architect.

Standing and Running Trim: Provide specified stain finish at wood trim.

Floor Finish Transitions at Doors: Locate floor finish material transitions that occur at doors under the center of the door, UNO.

Floor Drains: Coordinate location of floor drains with Plumbing drawings.

Seaming Diagrams: Provide diagrams for broadloom carpet and sheet flooring.

Wall Covering Seams: Apply wall covering to minimize seams, to provide equal panels and locate seams no closer than 1'-0" from corners.

FINISH SCHEDULE LEGEND

RB - RUBBER BASE

TB1 - TILE BASE 1 TB2 - TILE BASE 2

WALL FINISHES

WC - WALL COVERING

P1 - PAINTED GYPSUM BOARD P2 - PAINTED

<u>CABINET</u>

PLAM1 - PLASTIC LAMINATE 1 PLAM2 - PLASTIC LAMINATE 2

COUNTER TOP

PL1 - PLASTIC LAMINATE 1

SS1 - SOLID SURFACE 1 SSTL - STAINLESS STEEL



MHTN Architects, Inc. 280 South 400 West Suite 250 Salt Lake City, Utah 84101 Telephone (801) 595-6700

www.mhtn.com



ARNING

©2023 MHTN ARCHITECTS, INC. Confidentiality Notice: This document is intended for use on the Project identified herein by individuals and companies involved in the design, permitting, bidding and construction of the Project. MHTN Architects, Inc. grants limited rights to distribute and reproduce this document for this express purpose only. Distribution, printing or copying this document for purposes other than those indicated is strictly prohibited. If a digital copy of this document is received in error, please delete it.

MHTN	PROJECT	NO. 20	0245

Original drawing is 30 x 42. Do not scale contents of this drawing.


REVISIONS CONTRACTOR TO VERIFY DRAWINGS IN FIELD USE REFLECT LAST REVISION DATE.
 NO. △
 DATE
 DESCRIPTION


 X2
 9/13/2024
 ADDENDUM #2

CONSTRUCTION DOCUMENTS

AUGUST 29, 2024


SHEET NAME FINISH SCHEDULE AREA

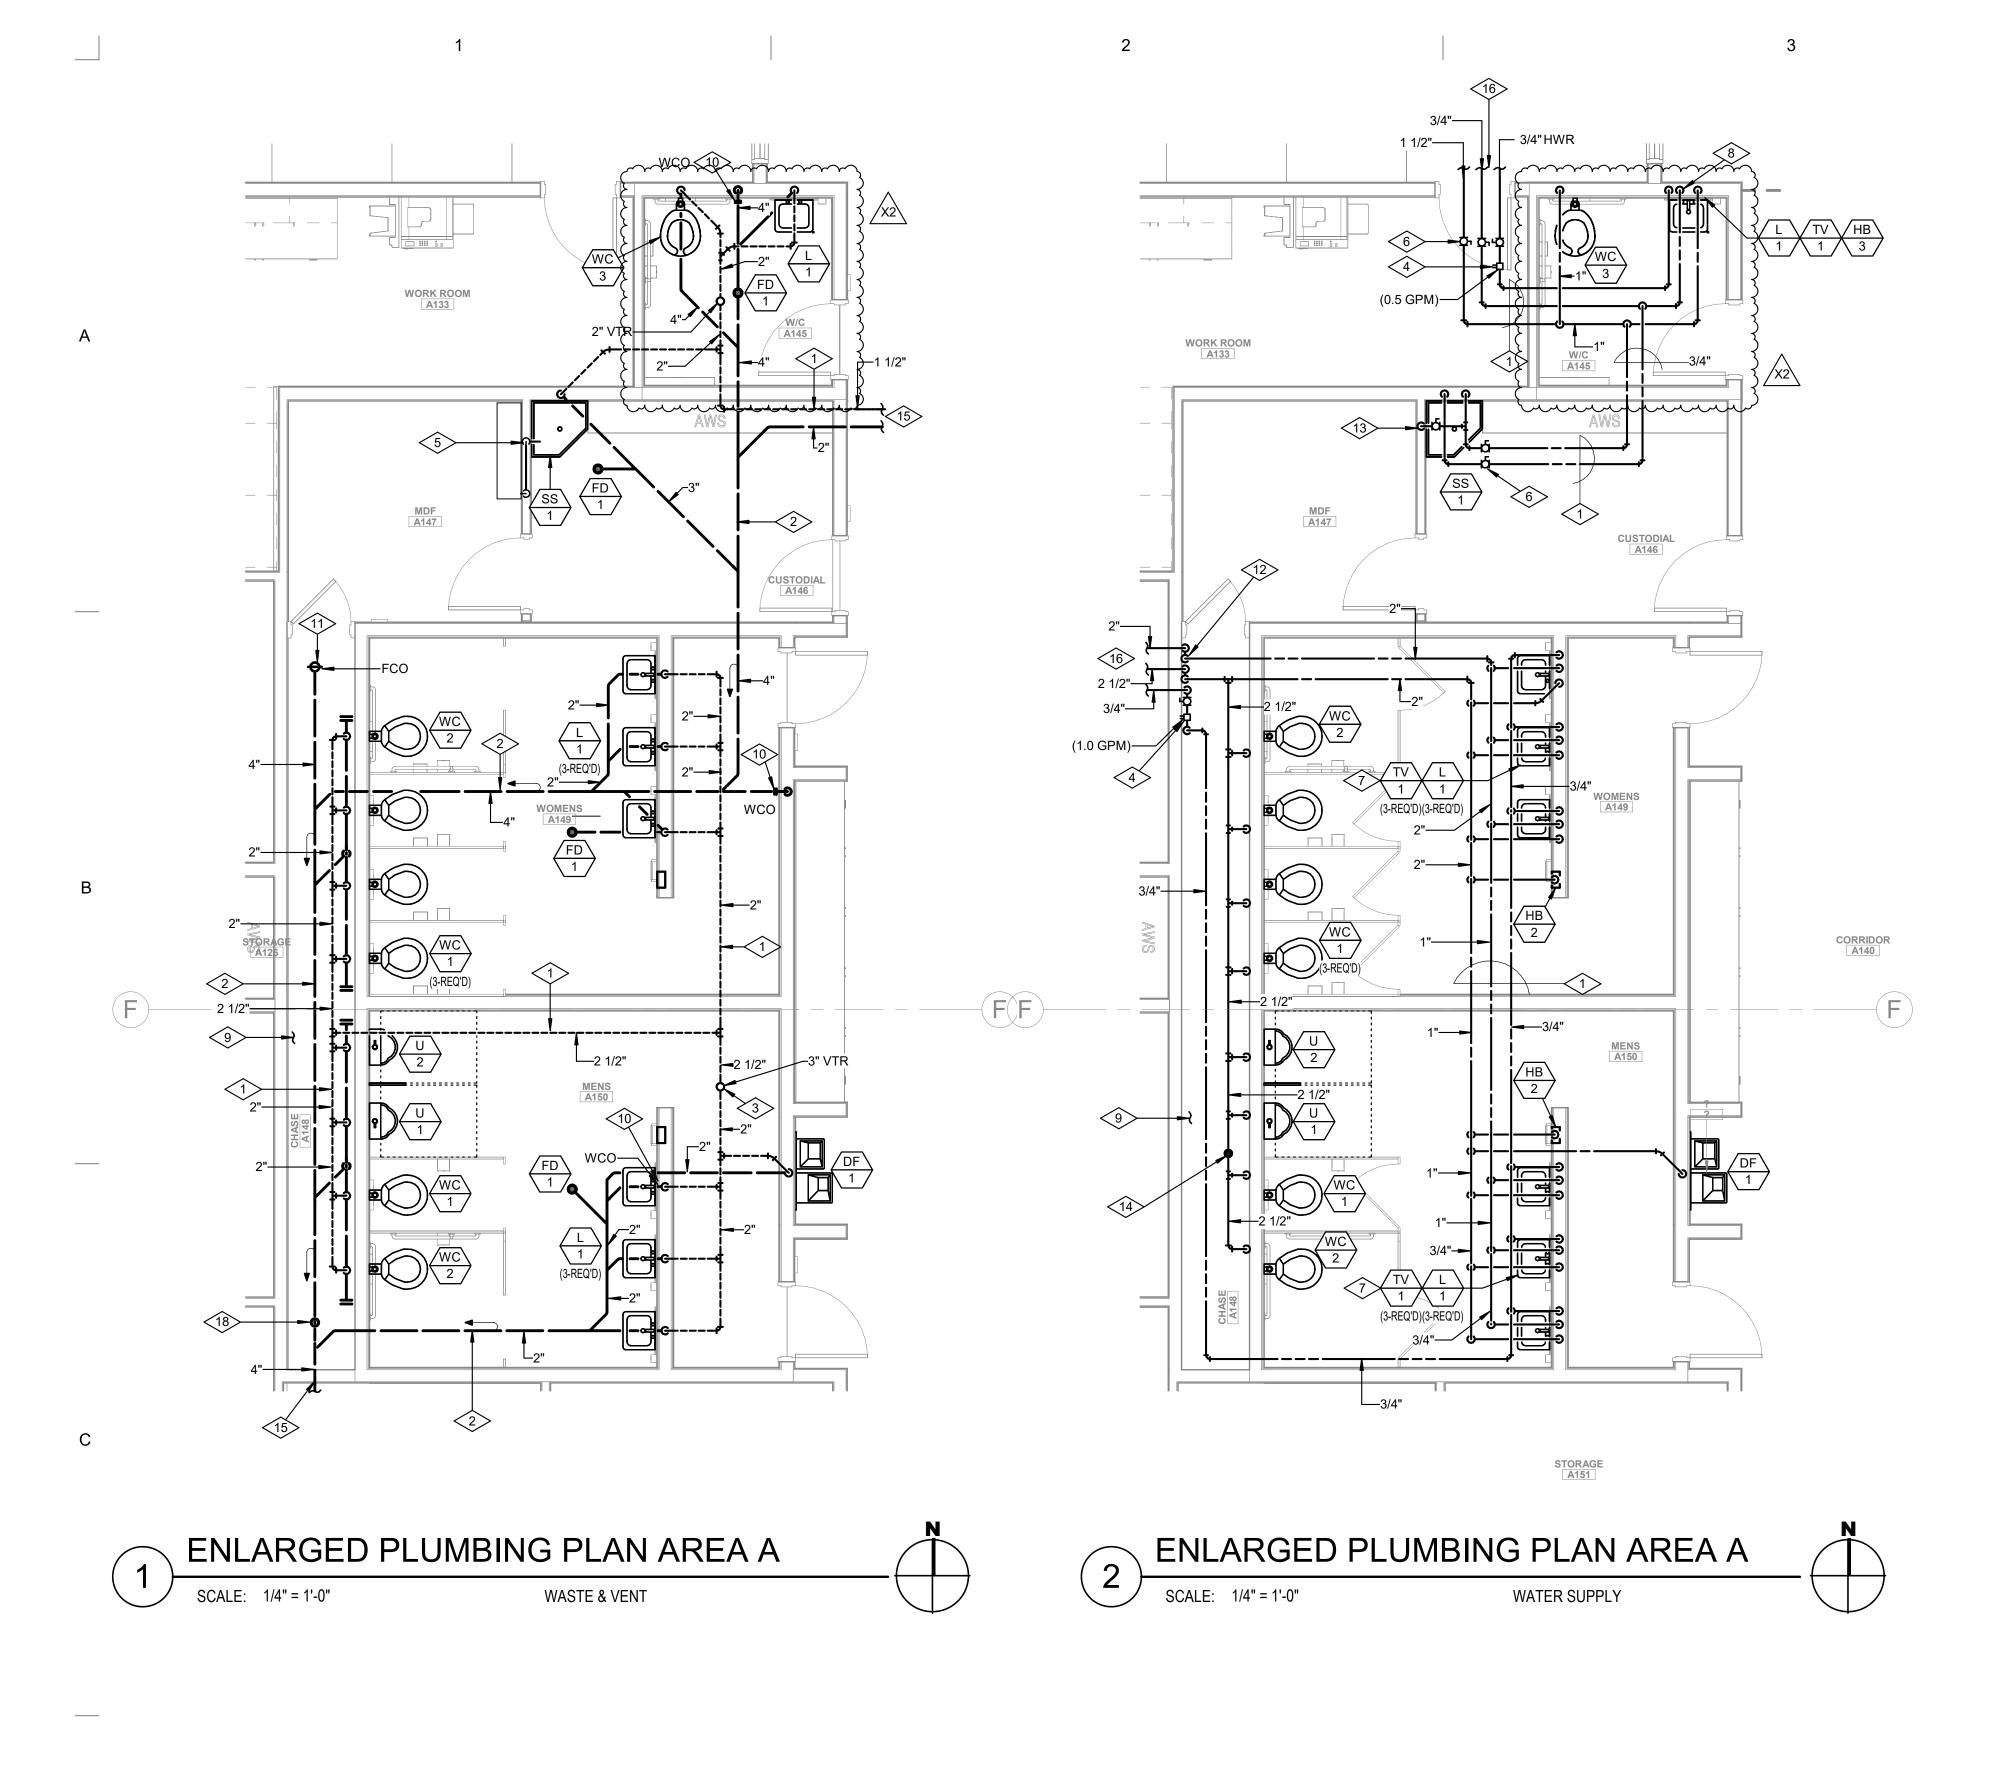


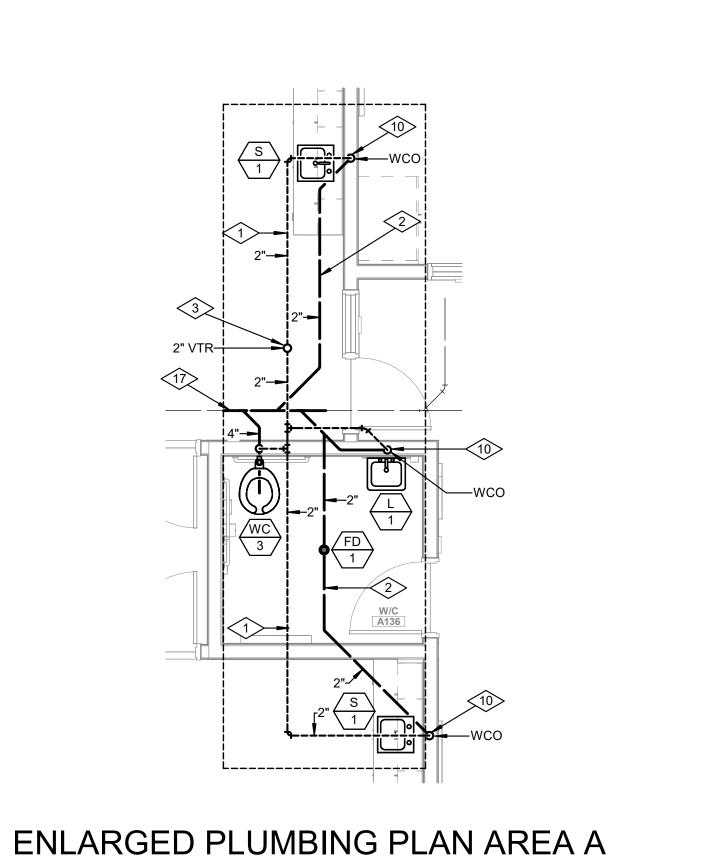

WASTE & VENT


SCALE: 1/4" = 1'-0"

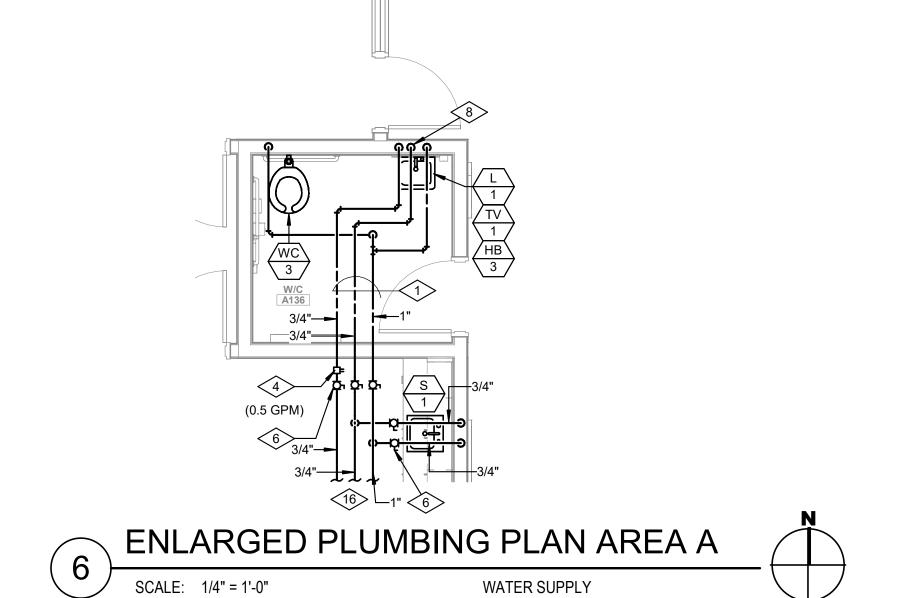

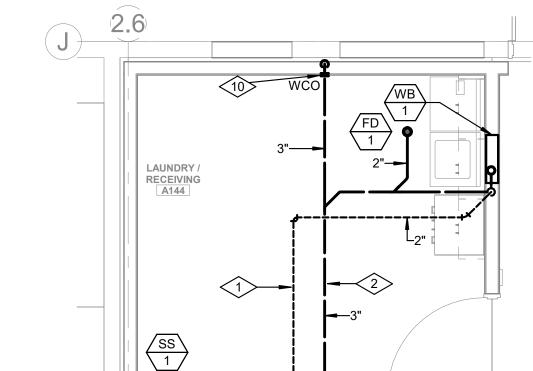


3 ENLARGED PLUMBING PLAN W&V AREA A


SCALE: 1/4" = 1'-0" WASTE & VENT

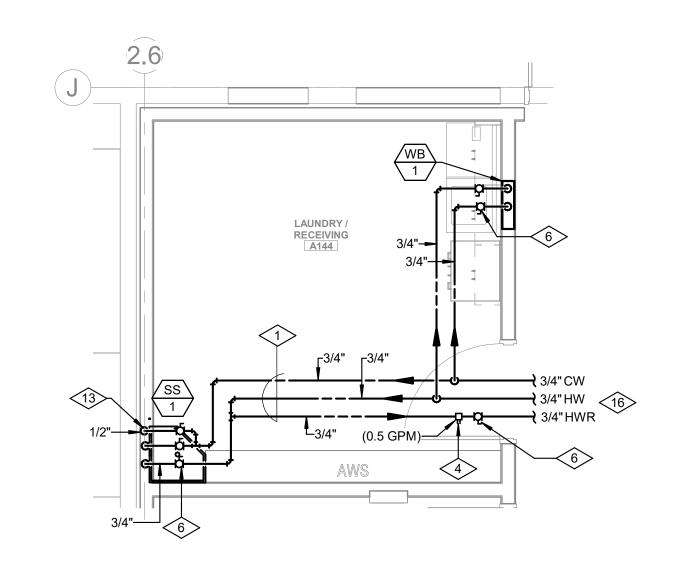



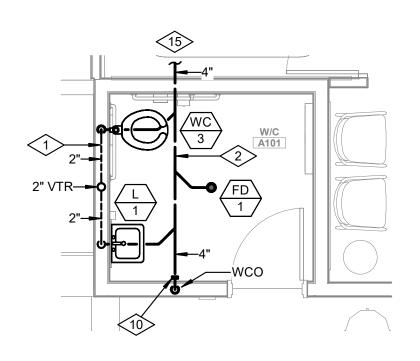

7 ENLARGED PLUMBING PLAN AREA A

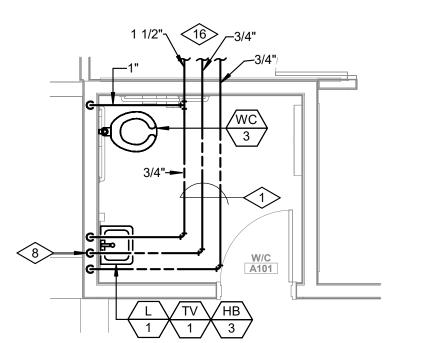

WASTE & VENT

8 ENLARGED PLUMBING PLAN AREA A

SCALE: 1/4" = 1'-0" WATER SUPPLY



- 1 PIPING TO RUN AS HIGH AS POSSIBLE ABOVE CEILING. COORDINATE ROUTING WITH ALL TRADES (TYPICAL).
- PIPING TO RUN BELOW FINISHED FLOOR. COORDINATE ROUTING WITH STRUCTURAL FOOTINGS (TYPICAL).
- ROUTING WITH STRUCTURAL FOOTINGS (TTFICAL).
- VENT THRU ROOF (VTR). MAINTAIN A MINIMUM OF 15'-0" FROM ALL OUTSIDE AIR INTKES. SEE DETAIL 8/P602.
- 4 CALIBRATED BALANCING VALVE ON HOT WATER RECIRCULATING LINE. BALANCE FLOW TO GPM SHOWN.
- 5 3/4" CONDENSATE DRAIN LINE FROM AC-1. TERMINATE DRAIN INDIRECT AT SERVICE SINK.
- 6 BALL VALVE (TYPICAL). VALVE MUST BE ACCESSIBLE.
- 7 1/2" HOT, COLD AND HOT WATER RECIRCULATING PIPING TO DROP IN WALL TO SERVE LAVATORY (TYPICAL).
- 8 3/4" COLD, 1/2" HOT AND HOT WATER RECIRCULATING PIPING TO DROP IN WALL TO SERVE LAVATORY
- 9 ALL HORIZONTAL PIPING RUN IN PLUMBING CHASE SHALL BE INSTALLED 7'-0" MINIMUM ABOVE FINISHED FLOOR.
- 10 WALL CLEANOUT (WC0) (TYPCIAL). SEE DETAIL 4/P602.
- 12 LINE SIZE BALL VALVE IN VERTICAL PIPE DROP. VALVES MUST BE ACCESSIBLE. MOUNT VALVES AT 6'-6" ABOVE

11 FLOOR CLEANOUT (FCO) (TYPICAL). SEE DETAIL 4/P601.

- 13 PROVIDE 1/2" CW LINE TO HOSE BIBB 'HB-4' SEE DETAIL
- 14 WATER HAMMER ARRESTOR (TYPICAL).

FINISHED FLOOR.

- 15 FOR CONTINUATION OF PIPING SEE SHEET P101A.
- 16 FOR CONTINUATION OF PIPING SEE SHEET P102A.
- 17 CONTRACTOR TO TIE INTO EXISTING PIPING IN THIS APPROXIMATE LOCATION. CONTRACTOR TO REMOVE AS NEEDED PIPING TO MAKE ALL NEW CONNECTIONS.
- 18 4" WASTE PIPIE STUB UP WITH JIM CAP.



MHTN Architects, Inc.
280 South 400 West
Suite 250
Salt Lake City, Utah 84101
Telephone (801) 595-6700
www.mhtn.com






ORDAN LEARNING CENTER 06 WEST 9800 SOUTH

©2023 MHTN ARCHITECTS, INC.

Confidentiality Notice:
This document is intended for use on the Project identified herein by individuals and companies involved in the design, permitting, bidding and construction of the Project. MHTN Architects, Inc. grants limited rights to distribute and reproduce this document for this express purpose only. Distribution, printing or copying this document for purposes other than those indicated is strictly prohibited. If a digital copy of this document is received in error, please delete it.

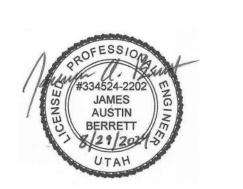


/IHTN P	ROJECT NO. 2	2024528
Original d	rawing is 30 x 4	Do not scale contents of this drawing.
		RIFY DRAWINGS IN FIELD USE REFLECT
NO.	DATE	DESCRIPTION
2	9-13-24	Addendum 02

CONSTRUCTION DOCUMENTS
AUGUST 29, 2024

E ENLARGED PLUMBING PLANS

P401

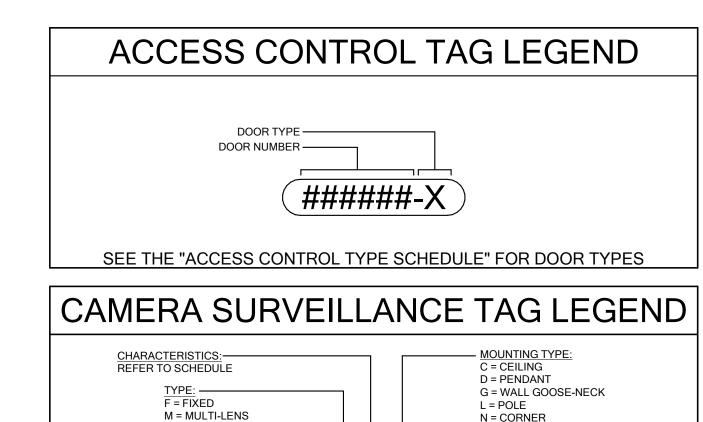

P = PARAPET T = THERMAL R = RECESSED S = INSIDE CORNER MOUNT W = WALLSEE THE "CAMERA SURVEILLANCE SCHEDULE" FOR CAMERA TYPES ACCESS CONTROL TYPE SCHEDULE CR: ACCESS CONTROL CARD KCR: ACCESS CONTROL CREDENTIAL CARD DC: ACCESS CONTROL READER WITH KEYPAD DOOR/WINDOW CONTACT ICR: INTEGRATED LOCKSET WITH CREDENTIAL DP: INTRUSION DETECTION RX: REQUEST TO EXIT BR : ACCESS CONTROL BIOMETRIC READER CARD READER DOOR/WINDOW CONTACT MOTION

(CAMERA SURVEILLANCE TYPE SCHEDULE											
TYPE	DESCRIPTION	MANFR.	CAT NO.	NOTES								
F01C	INDOOR DAY/NIGHT FIXED DOME CAMERA - CEILING MOUNTED	AXIS	P3265-LV	REFER TO THE SECURITY GENERAL NOTES #3								
F01W	INDOOR DAY/NIGHT FIXED DOME CAMERA - WALL MOUNTED	AXIS	P3265-LV	REFER TO THE SECURITY GENERAL NOTES #3								
F02W	INDOOR DAY/NIGHT FIXED DOME CAMERA - WALL MOUNTED	AXIS	P3265-LVE	REFER TO THE SECURITY GENERAL NOTES #3								
F20W	INDOOR DAY/NIGHT FIXED DOME CAMERA - WALL MOUNTED	AXIS	P3265-LVE	REFER TO THE SECURITY GENERAL NOTES #3								

SINGLE DOOR

SINGLE DOOR DOUBLE DOOR

DOUBLE DOOR

	~~~	FLOOR BOX SCHED	ULE	~~~~
(	TYPE	DESCRIPTION	MFR.	CATALOG N
	FB01	MULTI-SERVICE RECESSED FOUR-COMPARTMENT FLOOR BOXES WITH (2) 1-GANG COMPARTMENTS FOR POWER AND (2) 1-GANG COMPARTMENT FOR DATA. PROVIDE ROUND LOW PROFILE AND BEVELED EDGE COVER; INCLUDE MUDCAP, DEVICE PLATES, BLANK PLATES, MOUNTING BRACKETS, SPACERS AND COVER ASSEMBLIES. PROVIDE FLUSH FURNITURE FEED ASSEMBLIES. PROVIDE CIRCUITS AS SHOWN THROUGH THE FLOOR BOX TO THE WIRING ASSEMBLY ON THE TABLES. PROVIDE (2) 2" CONDUITS TO THE FLOOR BOX FOR DATA CABLING WITH CABLING FROM THE MDF AS INDICATED. PROVIDE DUPLEX RECEPTACLES AND DATA OUTLETS AS SHOWN IN THE TABLES. VERIFY ALL REQUIREMENTS WITH THE TABLE INSTALLER.	WIREMOLD	RFBA4
2	FB02	MULTI-SERVICE RECESSED FOUR-COMPARTMENT FLOOR BOXES WITH (1) 2-GANG COMPARTMENTS FOR POWER AND (1) 1-GANG COMPARTMENT FOR DATA. INCLUDE MUDCAP, DEVICE PLATES, BLANK PLATES, MOUNTING BRACKETS, SPACERS AND COVER ASSEMBLIES. PROVIDE FLUSH TILE ASSEMBLIES. SEE SECTION 262726, WIRING DEVICES. PROVIDE (2) DUPLEX RECEPTACLES IN EACH FLOOR BOX. PROVIDE A 2" CONDUIT TO THE DATA COMPARTMENT FROM THE MDF WITH PULL STRING.	WIREMOLD	RFBA4
			$\mathbf{V} = \mathbf{V} \mathbf{V} \mathbf{V}$	TEC

# FLOOR BOX GENERAL NOTES

PROVIDE FLOOR BOX WITHIN CONCRETE FLOOR SLAB AS SHOWN (REVIEW ARCHITECTURAL AND ELECTRICAL DRAWINGS). PRIOR TO PLACING CONCRETE SLAB, HOLD A COORDINATION WITH ELECTRICIAN, CONCRETE

SUBCONTRACTOR, AND A REPRESENTATIVE FROM THE SCHOOL DISTRICT'S FURNITURE VENDOR TO REVIEW ELECTRICAL REQUIREMENTS AND FINAL ELECTRICAL FURNITURE IN-FEED LOCATIONS. PROVIDE ALL NECESSARY FLOOR BOX ACCESSORIES REQUIRED FOR POWER, DATA, AND AV DEVICES.

COORDINATE FINAL FINISHES WITH ARCHITECT.

SECURIT	Y						
_###_ <	IP CAMERA [OFOI] - ROUGH-IN ONLY [PATHWAY AND CABLING]	AS NOTED	9. 10. 12.	DH	MAGNETIC DOOR HOLD OPENER	AS NOTED	8. 12.
NVR	NETWORK VIDEO RECORDER / SERVER		12.	ES	ELECTRIC DOOR STRIKE	DOOR JAMB	8. 12.
DC 1	ACCESS CONTROL DOOR/WINDOW SWITCH/CONTACT	DOOR JAMB	12.	DP	INTRUSION DETECTION DOOR / WINDOW CONTACT	DOOR JAMB	12.
DC 2	SPECIALIZED SWITCH/CONTACT (GARAGE DOOR, ROOF ACCESS DOOR/HATCH)		12.	EL	ELECTRIC DOOR LOCK	DOOR JAMB	8. 12.
XX	DR=DOOR RELEASE, LD=LOCKDOWN, PE=PUSH TO EXIT, DB=DURESS/PANIC:		10	RX	ACCESS CONTROL REQUEST TO EXIT MOTION		8. 12.
$\langle xx \rangle_X$	T = TRANSMITTER, R = RECEIVER, H = HARDWIRED		12.	EC	ELECTRIFIED EXIT RIM DEVICE (CRASH BAR)		8. 12.
$\langle MD \rangle \langle MD \rangle$	INTRUSION MOTION DETECTOR SOLID - WALL MOUNTED, DASHED = CEILING		12.	CR	ACCESS CONTROL CARD READER	+46"	1. 12.
GB (GB)	GLASS BREAK DETECTOR: SOLID = WALL MOUNTED, DASHED = CEILING		12.	BR	ACCESS CONTROL BIOMETRIC READER	+46"	1. 12.
AS (AS)	INTRUSION DETECTION ALARM SIREN AND/OR STROBE		12.	KS	KEY OVERRIDE SWITCH	+46"	1. 12.
PI	INTRUSION DETECTION POP-IT MODULE		12.	ICR	INTEGRATED LOCKSET WITH CREDENTIAL CARD READER		8. 12.
KP	INTRUSION SYSTEM KEYPAD (ARM/DISARM)		12.	KCR	ACCESS CONTROL CREDENTIAL CARD READER WITH KEYPAD	+46"	1. 12.
INT	IP TWO-WAY AUDIO & VIDEO INTERCOM (ANSWERING BASE STATION & DOOR STATION)		12.	WS	SECURITY WORKSTATION		12.
ML	ELECTROMAGNETIC LOCK (MAG LOCK)		8. 12.	'ACS'	ACCESS CONTROL PANEL		12.
$\langle sc \rangle \langle sc \rangle$	SMOKE & C/O DETECTOR COMBO: SOLID = WALL MOUNTED, DASHED = CEILING		12.	'IDS'	INTRUSION DETECTION PANEL		12.
SH> (SH)	SMOKE & C/O DETECTOR COMBO: SOLID = WALL MOUNTED, DASHED = CEILING		12.	'PSP'	POWER SUPPLY PANEL FOR ELECTRIFIED DOOR HARDWARE EQUIPMENT		12.

THE "CAMERA SURVEILLANCE SCHEDULE" FOR CAMERA TYPES		ABBREVIA	rion:	SINDEX
	ABBREV.	DESCRIPTION	ABBREV.	DESCRIPTION
S CONTROL TYPE SCHEDULE	#	NUMBER	МН	MANHOLE
S CONTROL THE SCHEDULE	AC	ALTERNATING CURRENT	MIC	MICROPHONE
	A.F.F.	ABOVE FINISH FLOOR	MIN	MINIMUM
A A COECC CONTROL OPENIAL CARD DO LACOFCO CONTROL DE L'RICHTO EVIT	AIC	AMPS INTERRUPTING CAPACITY	MTG	MOUNTING
: ACCESS CONTROL CREDENTIAL CARD DC : ACCESS CONTROL PE : PUSH TO EXIT DOOR/WINDOW CONTACT BUTTON	AM	AMPS METER	MTR	MOTOR
INTECDATED LOCKSET WITH OPENENTIAL DRIVING INTRUSION DETECTION DV DEGLEST TO EVIT	AMP	AMPERE	N/A	NOT APPLICABLE
INTEGRATED LOCKSET WITH CREDENTIAL DP: INTRUSION DETECTION RX: REQUEST TO EXIT DOOR/WINDOW CONTACT MOTION	ANN	ANNUNCIATOR	NC	NORMALLY CLOSED
DOOR	ATS	AUTOMATIC TRANSFER SWITCH	NEC	NATIONAL ELECTRICAL CODE
CREDENTIAL DOOR CONTACT EXIT DEVICES NOTES	AUX	AUXILIARY	NEMA	NATIONAL ELECT. MANUFAC. ASSOC.
CR BR KCR ICR DC DP PTE REX	AWG	AMERICAN WIRE GAUGE	NFPA	NATIONAL FIRE PROTECTION ASSOC.
1         0         0         1         0         0         0         REFER TO THE SECURITY GENERAL NOTE #1           1         0         0         0         0         0         REFER TO THE SECURITY GENERAL NOTE #1	ВС	BARE COPPER	N.I.C.	NOT IN CONTRACT
1 0 0 0 0 0 0 0 0 REFER TO THE SECURITY GENERAL NOTE #1	BFG	BELOW FINISH GRADE	NO	NORMALLY OPENED
1 0 0 0 0 0 0 REFER TO THE SECURITY GENERAL NOTE #1	С	CONDUIT	NTS	NOT TO SCALE
R 0 0 0 0 1 0 0 0 REFER TO THE SECURITY GENERAL NOTE #1	CAB	CABINET	OS & Y	OUTSIDE SCREW & YOKE
	CATB	COMMUNITY ANTENNA TELEVISION	PB	PUSHBUTTON
	CATV	CABLE TELEVISION	PF	POWER FACTOR
JRVEILLANCE TYPE SCHEDULE	СКТ	CIRCUIT	PFR	PHASE FAILURE RELAY
MANFR. CAT NO. NOTES	CLG	CEILING	PNL	PANEL
CAMERA - AXIS P3265-LV REFER TO THE SECURITY GENERAL NOTES	CNTR	CONTRACTOR	PT	POTENTIAL TRANSFORMER
CAMERA - AXIS P3265-LV REFER TO THE SECURITY GENERAL NOTES	C.O.	CONDUIT ONLY	PVC	POLYVINYL CHLORIDE CONDUIT
CAMIERA - AXIS P3203-LV REFER TO THE SECURITY GENERAL NOTES #3	CRT	COMPUTER TERMINAL	(R)	RELOCATE
CAMERA - AXIS P3265-LVE REFER TO THE SECURITY GENERAL NOTES	СТ	CURRENT TRANSFORMER	RECEP	RECEPTACLE
#3  CAMERA - AXIS P3265-LVE REFER TO THE SECURITY GENERAL NOTES	CU	COPPER	REQ	REQUIREMENT
#3	C/W	COMPLETE WITH	RLA	RATED LOAD AMPS
	DB	DECIBEL	RMP	ROCKY MOUNTAIN POWER
FLOOR BOX SCHEDULE	DC	DIRECT CURRENT	RMS	ROOT MEAN SQUARE
<u>, , , , , , , , , , , , , , , , , , , </u>	DWG	DRAWING	SE	SERVICE ENTRANCE
DESCRIPTION MFR. CATALOG NO.	(E)	TO REMAIN, UNLESS OTHERWISE NOTES	SPEC	SPECIFICATIONS
VICE RECESSED FOUR-COMPARTMENT FLOOR BOXES WITH (2) WIREMOLD RFBA4  MPARTMENTS FOR POWER AND (2) 1-GANG COMPARTMENT FOR	EC	EMPTY CONDUIT	SPKR	SPEAKER
IDE ROUND LOW PROFILE AND BEVELED EDGE COVER; INCLUDE	EG	EMERGENCY GENERATOR	SS	SELECTOR SWITCH
VICE PLATES, BLANK PLATES, MOUNTING BRACKETS, SPACERS ASSEMBLIES. PROVIDE FLUSH FURNITURE FEED ASSEMBLIES.	EMT	ELECTRICAL METALLIC TUBING	SW	SWITCH
RCUITS AS SHOWN THROUGH THE FLOOR BOX TO THE WIRING	EX	EXPLOSION PROOF	SWBD	SWITCHBOARD
ON THE TABLES. PROVIDE (2) 2" CONDUITS TO THE FLOOR BOX ABLING WITH CABLING FROM THE MDF AS INDICATED. PROVIDE	FACP	FIRE ALARM CONTROL PANEL	SWGR	SWITCHGEAR
ECEPTACLES AND DATA OUTLETS AS SHOWN IN THE TABLES.	FC	FOOT CANDLE	TTB	TELEPHONE TERMINAL BOARD
RIFY ALL REQUIREMENTS WITH THE TABLE INSTALLER.	FT	FOOT	TTC	TELEPHONE TERMINAL CABINET
/ICE RECESSED FOUR-COMPARTMENT FLOOR BOXES WITH (1) WIREMOLD RFBA4  IPARTMENTS FOR POWER AND (1) 1-GANG COMPARTMENT FOR	GFI	GROUND FAULT INTERRUPTER	TV	TELEVISION
CLUDE MUDCAP, DEVICE PLATES, BLANK PLATES, MOUNTING S. SPACERS AND COVER ASSEMBLIES. PROVIDE FLUSH TILE	GND	GROUND	TYP	TYPICAL
S. SEE SECTION 262726, WIRING DEVICES. PROVIDE (2) DUPLEX	GRC	GALVANIZED RIGID CONDUIT	UG	UNDERGROUND
LES IN EACH FLOOR BOX. PROVIDE A 2" CONDUIT TO THE DATA COMPARTMENT FROM THE MDF WITH PULL STRING.	HP	HORSE POWER	UPS	UNINTERRUPTED POWER SUPPLY
COMPARTMENT FROM THE MIDE WITH POLL STRING.	HZ	HERTZ	V	VOLT (KV-KILOVOLT)
FLOOR BOX GENERAL NOTES	IFC	INTERNATIONAL FIRE CODE	VA/R	VOLT-AMPS/REACTIVE
I LOUIT DON GLITCHAL NOTES	IG	ISOLATED GROUND	VM	VOLT METER
OR BOX WITHIN CONCRETE FLOOR SLAB AS SHOWN (REVIEW ARCHITECTURAL AND ELECTRICAL	IMC	INTERMEDIATE METALLIC CONDUIT	W	WATTS
	IN	INCH	W/	WITH
RIOR TO PLACING CONCRETE SLAB, HOLD A COORDINATION WITH ELECTRICIAN, CONCRETE		JUNCTION BOX	WH	WATTHOUR METER
RIOR TO PLACING CONCRETE SLAB, HOLD A COORDINATION WITH ELECTRICIAN, CONCRETE OR, AND A REPRESENTATIVE FROM THE SCHOOL DISTRICT'S FURNITURE VENDOR TO REVIEW	J-BOX		****	
RIOR TO PLACING CONCRETE SLAB, HOLD A COORDINATION WITH ELECTRICIAN, CONCRETE OR, AND A REPRESENTATIVE FROM THE SCHOOL DISTRICT'S FURNITURE VENDOR TO REVIEW	J-BOX KV	KILOVOLT	W/O	WITHOUT
RIOR TO PLACING CONCRETE SLAB, HOLD A COORDINATION WITH ELECTRICIAN, CONCRETE OR, AND A REPRESENTATIVE FROM THE SCHOOL DISTRICT'S FURNITURE VENDOR TO REVIEW EQUIREMENTS AND FINAL ELECTRICAL FURNITURE IN-FEED LOCATIONS.		KILOVOLT KILOVOLT AMPERES		WITHOUT WEATHERPROOF
RIOR TO PLACING CONCRETE SLAB, HOLD A COORDINATION WITH ELECTRICIAN, CONCRETE OR, AND A REPRESENTATIVE FROM THE SCHOOL DISTRICT'S FURNITURE VENDOR TO REVIEW EQUIREMENTS AND FINAL ELECTRICAL FURNITURE IN-FEED LOCATIONS.  ECESSARY FLOOR BOX ACCESSORIES REQUIRED FOR POWER, DATA, AND AV DEVICES.	KV		W/O	
RIOR TO PLACING CONCRETE SLAB, HOLD A COORDINATION WITH ELECTRICIAN, CONCRETE TOR, AND A REPRESENTATIVE FROM THE SCHOOL DISTRICT'S FURNITURE VENDOR TO REVIEW EQUIREMENTS AND FINAL ELECTRICAL FURNITURE IN-FEED LOCATIONS.  ECESSARY FLOOR BOX ACCESSORIES REQUIRED FOR POWER, DATA, AND AV DEVICES.	KV KVA	KILOVOLT AMPERES	W/O WP	WEATHERPROOF
RIOR TO PLACING CONCRETE SLAB, HOLD A COORDINATION WITH ELECTRICIAN, CONCRETE TOR, AND A REPRESENTATIVE FROM THE SCHOOL DISTRICT'S FURNITURE VENDOR TO REVIEW EQUIREMENTS AND FINAL ELECTRICAL FURNITURE IN-FEED LOCATIONS.  IECESSARY FLOOR BOX ACCESSORIES REQUIRED FOR POWER, DATA, AND AV DEVICES.	KV KVA KVAR	KILOVOLT AMPERES KILOVARS	W/O WP XFMR	WEATHERPROOF TRANSFORMER
RIOR TO PLACING CONCRETE SLAB, HOLD A COORDINATION WITH ELECTRICIAN, CONCRETE FOR, AND A REPRESENTATIVE FROM THE SCHOOL DISTRICT'S FURNITURE VENDOR TO REVIEW EQUIREMENTS AND FINAL ELECTRICAL FURNITURE IN-FEED LOCATIONS.  IECESSARY FLOOR BOX ACCESSORIES REQUIRED FOR POWER, DATA, AND AV DEVICES.	KV KVA KVAR KW	KILOVOLT AMPERES KILOVARS KILOWATT	W/O WP XFMR XFMR SW	WEATHERPROOF TRANSFORMER TRANSFER SWITCH
RIOR TO PLACING CONCRETE SLAB, HOLD A COORDINATION WITH ELECTRICIAN, CONCRETE FOR, AND A REPRESENTATIVE FROM THE SCHOOL DISTRICT'S FURNITURE VENDOR TO REVIEW EQUIREMENTS AND FINAL ELECTRICAL FURNITURE IN-FEED LOCATIONS.  RECESSARY FLOOR BOX ACCESSORIES REQUIRED FOR POWER, DATA, AND AV DEVICES.  FINAL FINISHES WITH ARCHITECT.	KV KVA KVAR KW LRA	KILOVOLT AMPERES KILOVARS KILOWATT LOCKED ROTOR AMPS	W/O WP XFMR XFMR SW XP	WEATHERPROOF TRANSFORMER TRANSFER SWITCH EXPLOSION PROOF
RIOR TO PLACING CONCRETE SLAB, HOLD A COORDINATION WITH ELECTRICIAN, CONCRETE FOR, AND A REPRESENTATIVE FROM THE SCHOOL DISTRICT'S FURNITURE VENDOR TO REVIEW EQUIREMENTS AND FINAL ELECTRICAL FURNITURE IN-FEED LOCATIONS.  IECESSARY FLOOR BOX ACCESSORIES REQUIRED FOR POWER, DATA, AND AV DEVICES.	KV KVA KVAR KW LRA LTG	KILOVOLT AMPERES KILOVARS KILOWATT LOCKED ROTOR AMPS LIGHTING	W/O WP XFMR XFMR SW XP 1P	WEATHERPROOF TRANSFORMER TRANSFER SWITCH EXPLOSION PROOF SINGLE-PHASE
RIOR TO PLACING CONCRETE SLAB, HOLD A COORDINATION WITH ELECTRICIAN, CONCRETE FOR, AND A REPRESENTATIVE FROM THE SCHOOL DISTRICT'S FURNITURE VENDOR TO REVIEW EQUIREMENTS AND FINAL ELECTRICAL FURNITURE IN-FEED LOCATIONS.  IECESSARY FLOOR BOX ACCESSORIES REQUIRED FOR POWER, DATA, AND AV DEVICES.	KV KVA KVAR KW LRA LTG MNF MAX	KILOVOLT AMPERES KILOVARS KILOWATT LOCKED ROTOR AMPS LIGHTING MANUFACTURER MAXIMUM	W/O WP XFMR XFMR SW XP 1P 2P 3P	WEATHERPROOF TRANSFORMER TRANSFER SWITCH EXPLOSION PROOF SINGLE-PHASE TWO-POLE THREE-POLE
RIOR TO PLACING CONCRETE SLAB, HOLD A COORDINATION WITH ELECTRICIAN, CONCRETE FOR, AND A REPRESENTATIVE FROM THE SCHOOL DISTRICT'S FURNITURE VENDOR TO REVIEW EQUIREMENTS AND FINAL ELECTRICAL FURNITURE IN-FEED LOCATIONS.  IECESSARY FLOOR BOX ACCESSORIES REQUIRED FOR POWER, DATA, AND AV DEVICES.	KV KVA KVAR KW LRA LTG MNF	KILOVOLT AMPERES KILOVARS KILOWATT LOCKED ROTOR AMPS LIGHTING MANUFACTURER	W/O WP XFMR XFMR SW XP 1P 2P	WEATHERPROOF TRANSFORMER TRANSFER SWITCH EXPLOSION PROOF SINGLE-PHASE TWO-POLE

# SECURITY GENERAL NOTES

1. PRIOR TO STARTING ANY WORK THE DIV.28 ACCESS CONTROL CONTRACTOR SHALL COORDINATE A MEETING WITH THE OWNER, THE DIV.8 DOOR HARDWARE CONTRACTOR, AND THE DIV.26 ELECTRICAL CONTRACTOR TO REVIEW AND DISCUSS: A. DOOR HARDWARE SPECIFICATIONS AND DOOR ROUGH-IN REQUIREMENTS. B. WHAT ELECTRIFIED DOOR HARDWARE IS GETTING INSTALLED ON EACH DOOR. C. THE FAIL-SAFE OR FAIL-SECURE OPERATION FOR THE ELECTRIFIED DOOR HARDWARE. D. THE OPERATION HOW THE ADA EQUIPMENT WILL NEED TO FUNCTION WITH THE ACCESS CONTROL SYSTEM. E. THE POWER REQUIREMENTS FOR ALL OF THE ELECTRIFIED HARDWARE. F. HOW EACH DOOR WILL NEED TO BE PROGRAMMED TO OPERATE DURING BUSINESS HOURS, AFTER HOURS, SCHEDULED TIMES, LOCKDOWNS, EMERGENCY SITUATIONS, FIRE ALARMS, ETC. G. THE FIRE ALARM INTERFACE AND THE OPERATION WITH THE ACCESS CONTROL SYSTEM AND THE EQUIPMENT H. WHICH AREAS IN THE EF/ER/TR ROOM IS TO BE UTILIZED TO INSTALL THE ACCESS CONTROL HEAD-END PANEL(S) AND THE ELECTRIFIED DOOR HARDWARE POWER SUPPLIES. I. WHICH ELECTRICAL CURCUIT THE ACCESS CONTROL HEAD-END PANELS AND ELECTRIFIED DOOR HARDWARE POWER SUPPLIES SHOULD BE CURCUITED TO (EMERGENCY POWER OR A STANDARD CURCUIT). J. CONFIRM WITH THE OWNER AND THE DIV.8 CONTRACTOR THAT THE DIV.28 CONTRACTOR WILL BE PROVIDING AND INSTALLING THE DOOR POSITION CONATCTS FOR THE ACCESS CONTROL SYSTEM. 2. THE ACCESS CONTROL SYSTEM SHALL INCLUDE ANY RELAYS, EXTERNAL POWER SUPPLIES, AUXILIARY DEVICES

OR INPUT/OUTPUT MODULES REQUIRED TO SUPPORT DOOR TYPE INDICATED FOR COMPLETE AND FUNCTIONING CARD READER AND DOOR CONTROL. 3. THE VIDEO SURVEILLANCE CONTRACTOR SHALL PROVIDE ALL FOR THE CORRECT AND NECESSARY HARDWARE AND MOUNTING EQUIPMENT FOR THE VIDEO SURVEILLANCE CAMERAS AND EQUIPMENT. PRIOR TO STARTING ANY

WORK THE DIV.28 SECURITY CONTRACTOR WILL COORDINATE A MEETING THE OWNER AND THE DIV.26 ELECTRICAL CONTRACTOR AND REVIEW & DISCUSS: A. THE ROUGH-IN REQUIREMENTS FOR EACH CAMERA LOCATION AND THE SPECIFIED RACEWAY. B. EACH SURVEILLANCE CAMERA LOCATION, HEIGHT, ORIENTATION AND VIEW. C. THE SPECIFIED CATEGORY CABLE AND THE OUTER CABLING JACKET COLOR. D. WHICH EF/ER/TR ROOM(S) AND EQUIPMENT RACK(S) THE SPECIFIED CATEGORY CABLING AND THE VIDEO SURVEILLANCE EQUIPMENT WILL NEED TO BE INSTALLED INTO. 4. PROVIDE ALL SPECIFIED AND NON-SPECIFIED COMPONENTS IN ORDER TO PROVIDE A COMPLETE AND A FULLY FUNCTIONAL ACCESS CONTROL, VIDEO SURVEILLANCE, AND INTRUSION DETECTION SYSTEMS.

5. THE DIV.28 CONTRACTOR(S) SHALL CAREFULLY REVIEW THE REFLECTED CEILING PLANS AND ARCHITECTURAL ELEVATIONS FOR COMPONENT INSTALLATION. 6. THE DIV.28 ACCESS CONTROL CONTRACTOR SHALL CAREFULLY REVIEW DOOR HARDWARE SUBMITTAL AND SUMMARIZE DISCREPANCIES TO TEAM.

STILL REMAINS THE CONTRACTOR'S RESPONSIBILITY TO VERIFY DRAWING QUANTITIES. IF A DISCREPANCY ARISES BETWEEN THE SCHEDULE COUNTS AND THE DRAWING COUNTS, THE HIGHEST QUANTITY SHALL BE 8. PROVIDE FIRE ALARM INTERFACE TO UNLOCK ALL INDICATED LOCKS UPON ANY FIRE ALARM INITIATION.

7. EQUIPMENT COUNTS ARE PROVIDED FOR INFORMATION ONLY AT A CONVENIENCE TO THE CONTRACTOR. IT

9. COORDINATE WITH THE ELECTRICAL CONTRACTOR PRIOR TO ROUGH-IN TO ENSURE A COMPLETE INSTALLATION IS PROVIDED AND CORRECTLY INSTALLED. 10. ALL CABLING TO DEVICES THAT ARE INSTALLED WITHIN DOOR OR ON MULLIONS SHALL BE ROUTED THROUGH

THE MULLIONS. COORDINATE INSTALLATION WITH THE DOOR/WINDOW SYSTEM INSTALLER PRIOR TO ANY ROUGH-IN. MULLION MOUNT CARD READERS DO NOT REQUIRE BACK BOX. 11. ALL FINAL CAMERA VIEWS SHALL BE APPROVED BY THE OWNER PRIOR TO PROJECT COMPLETION.

12. ALL PENETRATIONS OF FIRE RATED FLOORS, WALLS, AND CEILINGS SHALL BE SEALED WITH APPROVED MATERIAL TO MAINTAIN FIRE RATING OF SURFACE PENETRATED. 13. COORDINATE WITH THE OWNER AND REFERENCE EACH MANUFACTURER'S SPECIFICATIONS AND

INSTRUCTIONS AND THE CODE REQUIREMENTS FOR THE SETUP, PROGRAMMING, AND THE INTEGRATION BETWEEN THE VIDEO SURVEILLANCE SYSTEM, ACCESS CONTROL SYSTEM, FIRE ALARM SYSTEM, ADA EQUIPMENT,

14. THE DIV.28 VIDEO SURVEILLANCE CONTRACTOR SHALL PROVIDE AN INTERACTIVE MAP IN THE SURVEILLANCE VIDEO MANAGEMENT SOFTWARE WITH CAMERAS AND ACCESS CONTROL DEVICES. 15. CONTRACTORS SHALL PROMPTLY NOTIFY ENGINEER PRIOR TO INSTALLATION OF WORK IF ANY OF THE SECURITY DEVICE LOCATIONS THAT ARE SHOWN IN THE SECURITY DRAWINGS ARE OBSTRUCTED.

16. EQUIPMENT LISTS ARE PROVIDED TO SET EQUIPMENT EXPECTATIONS AND MAY NOT BE COMPLETE. COORDINATE WITH DEVICES SHOWN ON DRAWINGS, SYSTEM RISERS, SPECIFICATIONS, AND EQUIPMENT LIST FOR SYSTEM INTENT. PROVIDE COMPLETE AND FUNCTIONAL SYSTEMS AS DESCRIBED WITHIN THE CONSTRUCTION

17. INSTALL AND PROGRAM THE ACCESS CONTROL AND THE IP VIDEO SURVEILLANCE SYSTEMS TO THE MANUFACTURER'S INSTRUCTIONS AND SPECIFICATIONS, INDUSTRIES STANDARDS, AND TO THE OWNER'S

# GENERAL NOTES

- CONSULT ARCHITECTURAL REFLECTED CEILING PLANS FOR EXACT LOCATION OF ALL LIGHTING FIXTURES. VERIFY ALL EQUIPMENT DIMENSIONS AND LOCATIONS BEFORE BEGINNING ROUGH IN. CONSULT ALL APPLICABLE CONTRACT DRAWINGS AND SHOP DRAWINGS TO INSURE NEC CODE CLEARANCES REQUIRED AROUND ALL ELECTRICAL EQUIPMENT.
- CONTRACTOR SHALL VERIFY ALL ELECTRICAL LOADS (VOLTAGE, PHASE, CONNECTION REQUIREMENTS, ETC) OF ALL EQUIPMENT FURNISHED UNDER ALL DIVISIONS, INCLUDING ALL EXISTING EQUIPMENT TO BE RE-USED. REVIEW ALL SHOP DRAWINGS AND EXISTING EQUIPMENT BEFORE BEGINNING ROUGH-IN.
- SEE SECTION 265100 (16510) OF THE SPECIFICATION FOR REQUIRED COORDINATION MEETINGS WITH MECHANICAL AND CEILING CONTRACTORS.
- SEE APPLICABLE SHOP DRAWINGS FOR ROUGH IN LOCATION OF ALL EQUIPMENT, WIRING DEVICES, ETC. WHERE APPLICABLE MOUNT ALL WIRING DEVICES ABOVE BACK SPLASH EXCEPT THOSE SERVING UNDER COUNTER EQUIPMENT.
- . SEE SPECIFICATION FOR ENERGY SAVING LAMP AND BALLAST REQUIREMENTS.
- FINISHES OF ALL LIGHT FIXTURES SHALL BE AS SELECTED BY ARCHITECT.
- THE ELECTRICAL CONTRACTOR SHALL NOTIFY AND COOPERATE WITH THE MECHANICAL CONTRACTOR SUCH THAT NO PIPING, DUCTS, OR EQUIPMENT FOREIGN TO THE OPERATION OF THE ELECTRICAL EQUIPMENT SHALL BE PERMITTED TO BE INSTALLED IN, ENTER OR PASS THRU ELECTRICAL ROOMS OR SPACES, OR ABOVE OR BELOW ELECTRICAL EQUIPMENT IN OTHER AREAS.
- ELECTRICAL BOXES SHALL NOT BE LOCATED IN MASONRY COLUMNS IN BRICK WALLS OR IN GROUTED CELLS ADJACENT TO OPENINGS. COORDINATE LOCATION OF BOXES WITH MASONRY CONTRACTOR.
- 0. ALL PENETRATIONS OF FIRE RATED FLOORS, WALLS, AND CEILINGS SHALL BE SEALED WITH APPROVED MATERIAL TO MAINTAIN FIRE RATING OF SURFACE PENETRATED.
- . CONTRACTOR SHALL VERIFY FURNITURE LAYOUT PRIOR TO ANY FLOORBOX OR POKE-THRU INSTALLATION. COORDINATE EXACT LOCATION OF FLOOR BOX OR POKE-THRU WITH OWNER AND FURNITURE PROVIDER PRIOR
- 2. CIRCUITS EXTENDING OVER 70' FOR 120 VOLT AND 115' FOR 277 VOLT 20 AMP CIRCUITS SHALL BE RUN WITH CONDUCTORS PER TABLE BELOW.

20 AMP MINIMUM B	RANCH CIRCUIT CONDUC	TOR SIZING
MAXIMUM LENGTH	BRANCH CIF	RCUIT VOLTAGE
CONDUCTOR LENGTH (FT)	120 VOLT	277 VOLT
<70	MIN. #12 AWG	MIN. #12 AWG
70 - 115	MIN. #10 AWG	MIN. #12 AWG
115 - 170	MIN. #8 AWG	MIN. #10 AWG
170 - 270	MIN. #6 AWG	MIN. #8 AWG
271 - 380	NOTE B	MIN. #8 AWG
>380	NOTE B	NOTE B

- A. THESE ARE BASED ON MAXIMUM LENGTH OF CIRCUIT.
- B. PERFORM VOLTAGE DROP CALCULATIONS AND PROVIDE CONDUCTOR SIZE TO KEEP BRANCH CIRCUIT VOLTAGE DROP LESS THAN 3% WITH A 15 AMP LOAD.
- C. CONTRACTOR SHALL ENSURE THAT THE INSTALLATION OF EACH BRANCH CIRCUIT STAYS WITHIN 3% VOLTAGE DROP FOR A 15 AMP LOAD. IF NECESSARY, CONTRACTOR SHALL INCREASE WIRE AND CONDUIT SIZE TO MEET THE STANDARD AT NO ADDITIONAL COST TO

# SHEET INDEX

ELECTRICAL SYMBOLS, SCHEDULES, AND NOTES ELECTRICAL SCHEDULES AND NOTES

ELECTRICAL SITE PLAN

FIRST FLOOR LIGHTING PLAN AREA A FIRST FLOOR LIGHTING PLAN AREA B

FIRST FLOOR POWER PLAN - AREA A FIRST FLOOR POWER PLAN - AREA B

ROOF POWER PLAN ONE-LINE DIAGRAM PANELBOARD SCHEDULES

PANELBOARD SCHEDULES PANEL BOARD SCHEDULES ELECTRICAL DIAGRAMS

ELECTRICAL DIAGRAMS ELECTRICAL DIAGRAMS ELECTRICAL DIAGRAMS ELECTRICAL DIAGRAMS

FIRST FLOOR SYSTEM PLAN - AREA A FIRST FLOOR SYSTEM PLAN -AREA B

AUDIOVISUAL SYMBOLS AND NOTES AUDIOVISUAL SCHEDULES AND NOTES

FIRST FLOOR AUDIOVISUAL PLAN AREA - A FIRST FLOOR AUDIOVISUAL PLAN AREA - B FIRST FLOOR AUDIOVISUAL RCP AREA - A FIRST FLOOR AUDIOVISUAL RCP AREA - B AUDIOVISUAL ELEVATIONS

AUDIOVISUAL DIAGRAMS AUDIOVISUAL DIAGRAMS AUDIOVISUAL DIAGRAMS

LEVEL 1 INTERCOM OVERALI

# SYMBOL LEGEND

- 1. SEE FIXTURE SCHEDULE FOR TYPE, MOUNTING AND WATTAGE. 2. HEIGHT MEASURED TO CENTER LINE OF THE BOX FROM THE FINISHED FLOOR.
- 7. PROVIDE H.O.A. AND S.S. PUSHBUTTONS AS REQUIRED.
- 10. SUBSCRIPT INDICATES NEMA CONFIGURATION.
- 6. HEIGHT MEASURED TO TOP OF THE BOX FROM FINISHED FLOOR.
- DRAWINGS AND ELEVATIONS FOR HEIGHT.
- 3. REFER TO DRAWINGS FOR DIRECTIONAL ARROWS. 4. SUBSCRIPT INDICATES FIXTURES TO BE CONTROLLED. 5. NEMA TYPE 'ND' NON-FUSED UNLESS NOTED 'F' (FUSED). USE 'HD' 480 V.
- 8. DOUBLE ARROWS INDICATES A DOUBLE FACE UNIT. 9. DEVICES NOTED WITH AN 'A' INDICATE TO COORDINATE WITH MILLWORK SHOP
- 11. SOLID BOX AROUND DEVICE INDICATES INSTALLED IN FLOOR. DASHED BOX AROUND DEVICE INDICATES INSTALLED IN CEILING.
- 12. COORDINATE WITH DOOR HARDWARE SUPPLIER. 13. FOR WATER COOLER LOCATION, SEE DIAGRAM R002. FOR ALL OTHER LOCATIONS.
- MOUNT AT +16" TO BOTTOM OF BOX FROM FINISHED FLOOR, OR AS NOTED. 14. ARROWS SHOWN ON DEVICE INDICATE AIMING DIRECTION.
- 15. CAMERA NUMBERS ARE SHOWN INSIDE THE CAMERA SYMBOL. CAMERA TYPES ARE INDICATED IN TAG. 16. MOUNT ON TRACK OF OVERHEAD DOOR, 6" FROM TOP OF DOOR, UNLESS OVERHEAD DOOR
- IS A ROLL UP DOOR, THEN MOUNT PER MANUFACTURER'S INSTRUCTIONS. 17. INSTALL DEVICES PER MANUFACTURER'S INSTALLATION INSTRUCTIONS. 18. DASHED LINE INDICATES EQUIPMENT CLEARANCES. ARROW INDICATES FRONT OF RACK. 19. SPEAKER TO BE MOUNTED IN HORIZONTAL POSITION.
- 20. MOUNTING HEIGHT IS TO BOTTOM OF DISPLAY.
- *TYPICAL SYMBOL SCHEDULE. SOME SYMBOLS MAY NOT BE USED ON THIS SET OF DRAWINGS.

STANDARD MC	STANDARD MOUNTING HEIGHT UNLESS OTHERWISE NOTED ON PLANS										
GENERAL	GENERAL CONTRACTOR OF THE PROPERTY OF THE PROP										
SYMBOL	DESCRIPTION	MOUNTING HEIGHT	NOTES		SYMBOL	DESCRIPTION	MOUNTING HEIGHT	NOTES			
	ONE CIRCUIT, HOME RUN TO PANEL					EQUIPMENT PANEL, SEE DRAWINGS	+72"	6.			
	2 CIRCUIT, HOME RUN TO PANEL				<u> </u>	CABLE TRAY	AS NOTED				
	3 CIRCUIT, HOME RUN TO PANEL				J	GROUND BUS BAR	+18"	6.			
	CONDUIT RUN CONCEALED IN WALL OR CEILING				X	LIGHT FIXTURE (LETTER DESIGNATES TYPE)					
	CONDUIT RUN CONCEALED IN FLOOR OR GROUND				$\langle X \rangle$	EQUIPMENT NUMBER					
	CONDUIT UP				X	ARCHITECTURAL ROOM NUMBER					
•	CONDUIT DOWN				X	DEVICE / EQUIPMENT (TEXT DESIGNATES TYPE) SEE SCHEDULE					
	CONDUIT STUB LOCATION	CAP CONDUIT			X	DEVICE / EQUIPMENT (TEXT DESIGNATES TYPE) SEE SCHEDULE / LEGEND					
	CONDUIT / CIRCUIT CONTINUATION										

$\langle R \rangle$	RECEPTACLE SWITCH PACK	ABOVE CEILING		JF	JUNCTION BOX ('F' IN FLOOR)	AS NOTED	
	DUPLEX RECEPTACLE  UPPER OUTLET SWITCH CONTROLLED	+18" OR AS NOTED	2. 9.		MOTOR OUTLET	TO SUIT EQUIP.	2.
$\overline{}$	SIMPLEX RECEPTACLE	+18" OR AS NOTED	2. 9.	•	PUSHBUTTON	+46"	2.
$\Rightarrow$	DUPLEX RECEPTACLE	+18" OR AS NOTED	2. 9. 11.		NON-FUSED DISCONNECT SWITCH	+60"	5. 6.
$\Rightarrow$ A	DUPLEX RECEPTACLE		9.	F	FUSED DISCONNECT SWITCH	+60"	5. 6.
$\bigoplus_{G}$	5mA GFCI CIRCUIT BREAKER PROTECTED RECEPTACLE		13.	В	BREAKER DISCONNECT SWITCH	+60"	5. 6.
→ WP	WEATHERPROOF RECEPTACLE	+24" OR AS NOTED	2. 9.	\$	SINGLE POLE SWITCH	+46"	2. 4.
<b>1</b>	GROUND FAULT INTERRUPTER DUPLEX RECEPTACLE	+18" OR AS NOTED	2. 9.	<b>\$</b> ^T	MANUAL STARTER THERMAL OVERLOAD SWITCH WITH PILOT LIGHT	+46"	2.
-	DUPLEX RECEPTACLE EMERGENCY POWER (RED)	+18" OR AS NOTED	2. 9. 11.		MAGNETIC STARTER	+60"	6. 7.
#	FOURPLEX RECEPTACLE	+18" OR AS NOTED	2. 9. 11.		MAGNETIC STARTER / DISCONNECT COMBINATION	+60"	6. 7.
<b></b>	GROUND FAULT INTERRUPTER FOURPLEX RECEPT	+18" OR AS NOTED	2. 9.	VFD	VARIABLE FREQUENCY DRIVE	+66"	6.

	CEILING LIGHT FIXTURE	CEILING	1.	PP	POWER PACK	ABOVE CEILING	SEE DIAGRAM, SPEC.
Ю	WALL LIGHT FIXTURE	AS NOTED	1.	(RC) _X	DIGITAL ROOM CONTROLLER (SUBSCRIPT INDICATES NUMBER OF RELAYS)	ABOVE CEILING	SEE DIAGRAM, SPEC.
	RECESSED DOWNLIGHT FIXTURE	CEILING	1.	EP	EMERGENCY LIGHTING CONTROL UNIT	ABOVE CEILING	SEE DIAGRAM, SPEC.
$\bigcirc\rangle$	RECESSED WALL-WASH DOWNLIGHT FIXTURE	CEILING	1.	<b>\$</b> ³	THREE-WAY SWITCH	+46"	2. 4.
0	LIGHT FIXTURE	AS NOTED	1.	<b>\$</b> ⁴	FOUR-WAY SWITCH	+46"	2. 4.
0	EGRESS LIGHT FIXTURE	AS NOTED	1.	<b>\$</b> ^K	KEY OPERATED SWITCH	+46"	2. 4.
<b>— (</b> )	AREA LIGHT POLE AND FIXTURE POST TOP LIGHT POLE AND FIXTURE	CONCRETE BASE	1. 14. SEE DIAGRAM	\$°	SWITCH WITH PILOT LIGHT	+46"	2. 4.
	BOLLARD	CONCRETE BASE	1. 14. SEE DIAGRAM	<b>\$</b> ^D	VARIABLE INTENSITY SWITCH	+46"	2. 4.
	STEP LIGHT FIXTURE	AS NOTED	1.	<b>\$</b> TM	TIMER SWITCH	+46"	2. 4.
0	IN-GRADE LIGHT FIXTURE	CONCRETE BASE	1.	\$	MOMENTARY CONTACT SWITCH	+46"	2. 4.
$\Diamond$	FLOOD OR TRACK FIXTURE	AS NOTED	1.	X	LOW VOLTAGE WALLSTATION (SUBSCRIPT INDICATES CONFIGURATION & CONTROL SEQUENCE)	+46"	2. SEE DIAGRAM, SPEC
$\otimes$ $\otimes$	CEILING / WALL MOUNTED EXIT LIGHT	CEILING/ AS NOTED	1. 3. 8.		DUAL TECH. CEILING MOUNTED OCCUPANCY SENSOR (PROVIDE WITH ALL PP AND ROOM CONTROLLERS)	CEILING	SEE DIAGRAM, SPEC.
	EMERGENCY LIGHT FIXTURE	AS NOTED	1.	Н	DUAL TECH. WALL MOUNTED OCCUPANCY SENSOR (SUBSCIPT D = DIMMING AND DAYLIGHT CONTROL)	+46"	2. 4. SEE DIAGRAM, SPEC
	COMBO EXIT / EMERGENCY LIGHT FIXTURE	AS NOTED	1.	P	PHOTO-ELECTRIC CONTROL (LOCATE ON ROOF, FACE NORTH)	AS NOTED	MOUNT AS PER MFR.
TC	TIME CLOCK	+60"	2.		DIGITAL DAYLIGHT SENSOR	CEILING	SEE DIAGRAM, SPEC.

$\Longrightarrow$ IG	ISOLATED GROUND RECEPTACLE	+18" OR AS NOTED	2. 9.	<u> </u>	PLUGMOLD	+46" OR AS NOTED	2. SEE SPEC.
₩U	DUPLEX RECEPTACLE WITH USB OUTLET	+18" OR AS NOTED	2. 9.	DP	FLAT PANEL DISPLAY WALL BOX TVSS RECEPT., DATA AND OTHER DEVICES, REFER TO DIAGRAMS	AS NOTED	SEE DIAGRAM SPEC. 26 2726
=©	CONTROLLED DUPLEX RECEPTACLE	+18" OR AS NOTED	2. 9.	CP	CEILING PROJECTION SYSTEM CEILING BOX	ABOVE CEILING	SEE DIAGRAM SPEC.
#	FOURPLEX RECEPTACLE EMERGENCY POWER (RED)	+18" OR AS NOTED	2. 9. 11.		DOORBELL CHIME	+90"	2.
<b>=</b>	CONTROLLED FOURPLEX RECEPTACLE	+18" OR AS NOTED	2. 9.	FB	FLOOR BOX - SEE SCHEDULE	FLOOR	SEE DIAGRAM SPEC.
=(	TVSS PROTECTED RECEPTACLE	+18" OR AS NOTED	2. 9.	PT	POKE THRU - SEE SCHEDULE	FLOOR	SEE DIAGRAM SPEC.
	SPECIAL PURPOSE OUTLET	+18" OR AS NOTED	2. 10. W/ CAP.		PANELBOARD	+72"	6.
•	CORD DROP		SEE DIAGRAM		MAIN DISTRIBUTION PANEL		
	CORD REEL		SEE DIAGRAM		TELEPHONE DEMARCATION BOARD		
=====	TOMBSTONE RECEPTACLE			clg	EQUIPMENT CEILING RACK	CEILING	
	POWER POLE			>	EQUIPMENT 4-POST RACK / CABINET	AS NOTED	18. SEE SPEC.
EV EV	SINGLE / DUAL PORT ELECTRICAL VEHICLE CHARGER				EQUIPMENT 2-POST RACK	AS NOTED	18. SEE SPEC.
M	UTILITY METER / CT CABINET	+72"	6.				

TELECOMMUNICATIONS										
⊳w	WALL PHONE	+60" OR AS NOTED	2.	WAP WAP	WIRELESS ACCESS POINT, TWO CABLES SOLID = WALL, DASHED = CEILING	WALL / CEILING	11.			
$\triangleright$	DATA OUTLET, ONE CABLE	+18" OR AS NOTED	2. 9. 11.	SPL	SPLITTER	ABOVE CEILING				
	DATA OUTLET, TWO CABLES	+18" OR AS NOTED	2. 9. 11.	VIA	VIA	ABOVE CEILING				
	DATA OUTLET, THREE CABLES	+18" OR AS NOTED	2. 9. 11.	BDA	FIBER BDA	ABOVE CEILING				
х	DATA OUTLET, "X" INDICATES QUANTITY	+18" OR AS NOTED	2. 9. 11.	ANT	ANTENNA PS = PUBLIC SAFETY, COM = CELLULAR/COMMERCIAL	CEILING				
	TELEVISION OUTLET	+18" OR AS NOTED	9. 11.							

	BELL	+94"	2.	$\odot_{s}$	SMOKE DETECTOR	CEILING	
С	CHIME / STROBE	+94" / CEILING	2.	Sc	SMOKE/CARBON MONOXIDE DETECTOR	CEILING	
F	FIRE ALARM MANUAL STATION	+46"	2.	⊚ _c	CARBON MONOXIDE DETECTOR	CEILING	
Н	FIRE ALARM SIGNAL HORN / STROBE	+94" / CEILING	2.	⊚ _H	HEAT DETECTOR	CEILING	
[H] CLG	CONCEALED FIRE ALARM HORN / STROBE	CEILING		⊙ _D	DUCT SMOKE DETECTOR		MTD. IN DUCT
Пн	CONCEALED FIRE ALARM HORN / STROBE WALL	+94"	2.	D	FIRE/SMOKE DAMPER		
Е	FIRE ALARM SPEAKER / STROBE	+94" / CEILING	2.		DOOR HOLDER	AS NOTED	
[E] CLG	CONCEALED FIRE ALARM SPEAKER / STROBE	CEILING		FS	FLOW SWITCH		
Е	CONCEALED FIRE ALARM SPEAKER / STROBE WALL	+94"	2.	TS	TAMPER SWITCH		
S	FIRE ALARM STROBE	+94" / CEILING	2.	WF	WATER FLOOD INDICATOR		
[S] CLG	CONCEALED FIRE ALARM STROBE	CEILING			O.S. & Y. VALVE		SEE DIAGRA
S	CONCEALED FIRE ALARM STROBE WALL	+94"	2.	R	FIRE ALARM RELAY OR SECURITY RELAY		
K	FIRE ALARM SPEAKER ONLY	+94" / CEILING	2.	СМ	FIRE ALARM CONTROL MODULE		
В	FIRE ALARM STROBE WITH BLUE COLORED LENS (CO VISUAL ALARM)	+94" / CEILING	2.	MM	FIRE ALARM MONITOR MODULE		
ANN	FIRE ALARM ANNUNCIATOR PANEL	+58"	2. SEE DIAGRAM	TWZ	TWO-WAY COMMUNICATION SYSTEM CONTROL PANEL	+46"	2.
⊙ _V	ASPIRATING SMOKE DETECTION SYSTEM	CEILING	MOUNT AS PER MFR.	TW	TWO-WAY COMMUNICATION SYSTEM CALL STATION	+46"	2.
⊙ _B	BEAM DETECTOR		MOUNT AS PER MFR.	R	FIRE ALARM RELAY		



**MHTN Architects, Inc** 280 South 400 West Suite 250 Salt Lake City, Utah 84101 Telephone (801) 595-6700 www.mhtn.com



www.bnaconsulting.com

©2023 MHTN ARCHITECTS, INC. Confidentiality Notice: This document is intended for use on the Project identified herein by individuals and companies involved in the design, permitting, bidding and construction of the Project. MHTN Architects, Inc. grants limited rights to distribute and reproduce this document for this express purpose only. Distribution, printing or copying this document for purposes other than those indicated is strictly prohibited. If a digital copy of this document is received in error, please delete it.



Original d	Original drawing is 30 x 42. Do not scale contents of this drawing.										
REVISIONS CONTRACTOR TO VERIFY DRAWINGS IN FIELD USE REFLECT LAST REVISION DATE.											
NO.	DATE	DESCRIPTION									
2	09/13/2024	Addendum #2									

MHTN PROJECT NO. 2024528

CONSTRUCTION DOCUMENTS AUGUST 29, 2024

ELECTRICAL SYMBOLS, SCHEDULES, AND NOTES

# **EQUIPMENT SCHEDULE**

RESPONSIBILITY LEGEND:

CONNECTION TYPE NOTES:

3. BREAKER IN ENCLOSURE

5. MAGNETIC STARTER

1. NON-FUSED DISCONNECT SWITCH

4. MANUAL STARTER WITH THERMAL OVERLOAD

8. MAGNETIC STARTER/BREAKER COMBINATION

2. RECEPTACLE/SPECIAL PURPOSE OUTLET/ETC.

6. MAGNETIC STARTER/NON-FUSED DISCONNECT COMBINATION

7. MAGNETIC STARTER/FUSED DISCONNECT COMBINATION

3. TWO-SPEED STARTER. COORDINATE WITH MOTOR TYPE

2 FUSED DISCONNECT SWITCH

9. VARIABLE FREQUENCY DRIVE

10. REDUCED VOLTAGE STARTER

14. SOLID STATE SOFT-STARTER

A. FURNISHED, INSTALLED AND CONNECTED UNDER DIVISION 26(16) B. FURNISHED AND INSTALLED UNDER ANOTHER DIVISION, REQUIRED CONNECTION UNDER DIVISION 26(16) C. FURNISHED UNDER ANOTHER DIVISION BUT INSTALLED AND CONNECTED UNDER DIVISION 26(16) D. FURNISHED, INSTALLED AND CONNECTED UNDER ANOTHER DIVISION

CB = CIRCUIT BREAKER

NOTE 1: PER 250.122(A), EQUIPMENT GROUND IS NOT REQUIRED TO BE LARGER THAN THE PHASE CONDUCTOR NOTE 2: OVERCURRENT PROTECTION DEVICE (OCPD) SHOWN IS LOCATED AT POWER PANEL. ALL FUSING TO BE SIZED IN ACCORDANCE WITH FUSE MFR RECOMMENDATION FOR MOTOR NAME PLATE RATING. NOTE 3: ALL EQUIPMENT TO BE RATED FOR THE ENVIRONMENT FOR WHICH IT IS INSTALLED.

			ELEC	TRICA		JIPMEI	NT INF	ORMA	ATION			\	WIRE		OC	PD			G (%	
UNIT	#	DESCRIPTION	Н	FLA	MCA	۷A	VOLTAGE	PHASE	FULL LOAD AMPS	CONDUIT SIZE	SETS	ατγ	SIZE	EQ. GROUND	ТҮРЕ	AMPS	Equip ment 3-pha se	Sub Diversity Class	STARTER/ DISC/ VFD OTHER (SEE NOTES)	REMARKS
ACI	1	INDOOR AC UNIT	0.00	0 A	1 A	0 VA	208 V	1	0.8 A	3/4"	1	2	12	12	СВ	15 A	No	Mech Coordination	2 A	POWERED BY OUTDOOR UNIT
ACI	2	INDOOR AC UNIT	0.00	0 A	1 A	0 VA	208 V	1	0.8 A	3/4"	1	2	12	12	СВ	15 A	No	Mech Coordination	2 A	POWERED BY OUTDOOR UNIT
ACO	1	OUTDOOR AC UNIT	0.00	0 A	14 A	0 VA	208 V	1	11.2 A	3/4"	1	2	12	12	СВ	20 A	No	Mech Coordination	2 A	
ACO CP	2 1	OUTDOOR AC UNIT PUMP	0.00	0 A 0 A	14 A 0 A	0 VA 0 VA	208 V 120 V	1	11.2 A 4.4 A	3/4"	1	2	12 12	12 12	CB CB	20 A 15 A	No No	Mech Coordination  Mech Coordination	2 A 4 A	
EF	1	EXHAUST FAN	0.00	3.8 A	0 A	0 VA	120 V	1	3.8 A	3/4"	1	2	12	12	СВ	15 A	No	Mech Coordination	4 A	
EF	2	EXHAUST FAN	0.00	3.8 A	0 A	0 VA	120 V	1	3.8 A	3/4"	1	2	12	12	СВ	15 A	No	Mech Coordination	4 A	
EF EF	3 4	EXHAUST FAN EXHAUST FAN	0.00	3.8 A 3.8 A	0 A 0 A	0 VA 0 VA	120 V 120 V	1	3.8 A 3.8 A	3/4"	1	2	12 12	12 12	CB CB	15 A 15 A	No No	Mech Coordination  Mech Coordination	4 A 4 A	
EF	5	EXHAUST FAN	0.00	3.8 A	0 A	0 VA	120 V	1	3.8 A	3/4"	1	2	12	12	СВ	15 A	No	Mech Coordination	4 A	
EF	6	EXHAUST FAN	0.00	3.8 A	0 A	0 VA	120 V	1	3.8 A	3/4"	1	2	12	12	СВ	15 A	No	Mech Coordination	4 A	
EF EF		EXHAUST FAN EXHAUST FAN	0.00	3.8 A 3.8 A	0 A 0 A	0 VA 0 VA	120 V 120 V	1	3.8 A 3.8 A	3/4"	1	2	12 12	12 12	CB CB	15 A 15 A	No No	Mech Coordination  Mech Coordination	4 A 4 A	
EF	9	EXHAUST FAN	0.00	3.8 A	0 A	0 VA	120 V	1	3.8 A	3/4"	1	2	12	12	СВ	15 A	No	Mech Coordination	4 A	
EF	10	EXHAUST FAN	0.00	3.8 A	0 A	0 VA	120 V	1	3.8 A	3/4"	1	2	12	12	CB	15 A	No	Mech Coordination	4 A	
EF	11 	EXHAUST FAN	0.00	5.8 A 75.8A	0 A	0 VA	120 V ~120~V	~ <del>\</del>	5.8 A	3/4° ~3/4°~	<u>'</u>		12	12	CB CB	15 A √15⁄A	No No	Mech Coordination  Mech Coordination	4 A	~~~~
EUH	1	ELECTRIC UNIT HEATER	0.00	0 A	0 A	5000 VA	208 V	1	24.0 A	3/4"	1	2	10	10	СВ	25 A	No	Mech Coordination	2 A	
EUH FH	2	ELECTRIC UNIT HEATER FUME HOOD	0.00	0 A 10 A	0 A 0 A	5000 VA 0 VA	208 V 120 V	1	24.0 A 10.0 A	3/4"	1	2	10 12	10 12	CB CB	25 A 15 A	No No	Mech Coordination  Mech Coordination	2 A 11 A	
ART ART	<del>~</del>	ROOFTOP	0.00		TÝ.	THE	480 V	<del></del>	7.2 A	3/4"	~	Ty.		~~ <u>\</u>	TÜ CB	45A~	Ves	Ween Coordination		COMN/FACTORY RECEP.
RT	2	ROOFTOP	0.00	0 A	9 A	0 VA	480 V	3	7.2 A	3/4"	1	3	12	12	СВ	15 A	Yes	Mech Coordination	2 A	CONN. FACTORY RECEP.
RT	3	ROOFTOP	0.00	0 A	12 A	0 VA	480 V	3	9.6 A	3/4"	1	3	12	12	СВ	15 A	Yes	Mech Coordination	2 A	CONN. FACTORY RECEP.
RT	4	ROOFTOP	0.00	0 A	12 A	0 VA	480 V	3	9.6 A	3/4"	1	3	12	12	СВ	15 A	Yes	Mech Coordination	2 A	CONN. FACTORY RECEP.
RT	5	ROOFTOP	0.00	0 A	17 A	0 VA	480 V	3	13.6 A	3/4"	1	3	12	12	СВ	25 A	Yes	Mech Coordination	2 A	CONN. FACTORY RECEP.
RT	6	ROOFTOP	0.00	0 A	17 A	0 VA	480 V	3	13.6 A	3/4"	1	3	12	12	СВ	25 A	Yes	Mech Coordination	2 A	CONN. FACTORY RECEP.
RT	7	ROOFTOP	0.00	0 A	12 A	0 VA	480 V	3	9.6 A	3/4"	1	3	12	12	СВ	15 A 15 A	Yes	Mech Coordination  Mech Coordination	2 A	CONN. FACTORY RECEP. CONN. FACTORY
RT	8	ROOFTOP	0.00	0 A	12 A	0 VA	480 V	3	9.6 A	3/4"	1	3	12	12	СВ	15 A	Yes	Mech Coordination	2 A	RECEP. CONN. FACTORY
RT	9	ROOFTOP	0.00	0 A	12 A	0 VA	480 V	3	9.6 A	3/4"	1	3	12	12	СВ	15 A	Yes	Mech Coordination	2 A	RECEP. CONN. FACTORY
RT	10	ROOFTOP	0.00	0 A	9 A	0 VA	480 V	3	7.2 A	3/4"	1	3	12	12	СВ	15 A	Yes	Mech Coordination	2 A	RECEP. CONN. FACTORY
RT	11	ROOFTOP	0.00	0 A	12 A 9 A	0 VA 0 VA	480 V 480 V	3	9.6 A 7.2 A	3/4"	1	3	12	12	CB CB	15 A	Yes	Mech Coordination	2 A	RECEP. CONN. FACTORY
RT RT	12 13	ROOFTOP	0.00	0 A 0 A	12 A	0 VA	480 V	3	9.6 A	3/4"	1	3	12	12	СВ	15 A	Yes	Mech Coordination	2 A 2 A	RECEP. CONN. FACTORY
RT	14	ROOFTOP	0.00	0 A	12 A	0 VA	480 V	3	9.6 A	3/4"	1	3	12	12	СВ	15 A	Yes	Mech Coordination	2 A	RECEP. CONN. FACTORY RECEP.
RT	15	ROOFTOP	0.00	0 A	12 A	0 VA	480 V	3	9.6 A	3/4"	1	3	12	12	СВ	15 A	Yes	Mech Coordination	2 A	CONN. FACTORY RECEP.
RT	16	ROOFTOP	0.00	0 A	12 A	0 VA	480 V	3	9.6 A	3/4"	1	3	12	12	СВ	15 A	Yes	Mech Coordination	2 A	CONN. FACTORY RECEP.
RT	17	ROOFTOP	0.00	0 A	9 A	0 VA	480 V	3	7.2 A	3/4"	1	3	12	12	СВ	15 A	Yes	Mech Coordination	2 A	CONN. FACTORY RECEP.
RT	18	ROOFTOP	0.00	0 A	12 A	0 VA	480 V	3	9.6 A	3/4"	1	3	12	12	СВ	15 A	Yes	Mech Coordination	2 A	CONN. FACTORY RECEP.
RT	19	ROOFTOP	0.00	0 A	12 A	0 VA	480 V	3	9.6 A	3/4"	1	3	12	12	СВ	15 A	Yes	Mech Coordination	2 A	CONN. FACTORY RECEP.
RT	20	ROOFTOP	0.00	0 A	12 A	0 VA	480 V	3	9.6 A	3/4"	1	3	#12	12	СВ	15 A	Yes	Mech Coordination	2 A	CONN. FACTORY RECEP.
RT	21	ROOFTOP	0.00	0 A	9 A	0 VA	480 V	3	7.2 A	3/4"	1	3	#12	12	СВ	15 A	Yes	Mech Coordination	2 A	CONN. FACTORY RECEP. CONN. FACTORY
RT	22	ROOFTOP	0.00	0 A	12 A	0 VA	480 V	3	9.6 A	3/4"	1	3	#12	12	СВ	15 A 15 A	Yes	Mech Coordination  Mech Coordination	2 A	RECEP. CONN. FACTORY
RT	23	ROOFTOP	0.00	0 A	9 A	0 VA	480 V	3	7.2 A	3/4"	1	3	#12	12	СВ	15 A	Yes	Mech Coordination	2 A	RECEP. CONN. FACTORY
RT	24	ROOFTOP	0.00	0 A	9 A	0 VA	480 V	3	7.2 A	3/4"	1	3	#12	12	CB	15 A	Yes	Mech Coordination	2 A	RECEP. CONN. FACTORY
RT WH	25 1	ROOFTOP WATER HEATER	0.00	0 A 8 A	9 A 0 A	0 VA 0 VA	480 V 120 V	3	7.2 A 8.0 A	3/4"	1	2	#12	12 12	CB CB	15 A	No	Mech Coordination	2 A 12 A	RECEP.
V V I I	- 1	WAILNILATER	0.00	0.7	1 07	UVA	12U V		U.U.A	J/ <del>+</del>	<u>'</u>		#14	12	00	15 A	INO	INCOL COOLUITATION	12 14	1

# SENSOR GENERAL NOTES

THE ELECTRICAL CONTRACTOR SHALL BE RESPONSIBLE FOR CONTACTING THE SENSOR MANUFACTURER FOR PROPER PLACEMENT AND ADJUSTMENT OF OCCUPANCY SENSORS.

- PROVIDE DUAL TECHNOLOGY OCCUPANCY SENSORS AS SHOWN. LOCATE OCCUPANCY SENSORS PER MANUFACTURER FOR PROPER PLACEMENT AND ADJUSTMENT OF OCCUPANCY SENSORS. PROVIDE ADDITIONAL SENSORS IF REQUIRED TO PROPERLY COVER THE RESPECTIVE ROOM.
- EACH ZONE SHALL HAVE COVERAGE BY OCCUPANCY SENSOR SUCH THAT NO BLIND SPOT EXIST. UPON COMPLETION OF THE INSTALLATION, THE SYSTEM SHALL BE COMPLETELY COMMISSIONED BY THE MANUFACTURER'S FACTORY AUTHORIZED TECHNICIAN WHO WILL VERIFY ALL ADJUSTMENTS AND SENSOR PLACEMENT TO ENSURE A TROUBLE FREE INSTALLATION.
- THE LOCATION AND QUANTITIES OF SENSORS SHOWN ON THE DRAWINGS ARE DIAGRAMMATIC AND INDICATE ONLY THE ROOMS WHICH ARE TO BE PROVIDED WITH SENSORS. THE ELECTRICAL CONTRACTOR SHALL PROVIDE ADDITIONAL SENSORS IF REQUIRED TO PROPERLY COVER THE

RESPECTIVE ROOM.

SENSORS PER MANUFACTURER'S RECOMMENDATION AND WHERE REQUIRED WITHIN THE ROOM FOR PROVIDE OCCUPANCY SENSOR WITH AN ADDITIONAL SET OF DRY CONTACTS FOR HVAC CONTROL AT EACH VAV BOX LOCATION. COORDINATE WITH MECHANICAL DRAWINGS AND THE MECHANICAL

PROVIDE DAYLIGHT ZONE CONTROL REQUIREMENTS PER IECC-2018 C405.2.2.3 LOCATE DAYLIGHT

# LIGHTING CONTROL INTENT NARRATIVE (IECC 2021 COMPLIANT)

THE DRAWINGS SHOW GENERAL ZONING INTENT. THE BIDDING CONTRACTOR ALONG WITH THE LIGHTING CONTROLS MANUFACTURER IS RESPONSIBLE FOR PROVIDING A SYSTEM WITH THE FEATURES NECESSARY AND MUST BE CAPABLE OF MEETING THE INTENT. THE MANUFACTURER'S REPRESENTATIVE FOR DIVISION 26 AND BIDDING CONTROLS SHALL BE ACCOUNTABLE FOR THE COMPREHENSIVE LIGHTING CONTROLS PACKAGE'S FINALIZATION IN ALIGNMENT WITH THE DESIGN INTENT DEPICTED IN THE DRAWINGS AND COMPLYING WITH IECC 2021 REQUIREMENTS THE LIGHTING REPRESENTATIVE IS REQUIRED TO FURNISH EXHAUSTIVE SHOP DRAWINGS. ELUCIDATING THE LIGHTING CONTROL SYSTEM'S TOPOLOGY AND THE ESSENTIAL CONNECTIONS NECESSARY FOR ITS PROPER

THIS NARRATIVE OUTLINES THE LIGHTING CONTROL SYSTEM FOR A MULTIPURPOSE SPACE DIVISIBLE INTO FOUR EQUAL ROOMS. EACH DIVISIBLE ROOM FEATURES TWO ZONES OF LED LIGHTING - LINEAR PENDANTS AND PERIMETER CYLINDER LIGHTS. THE CONTROL SYSTEM IS DESIGNED TO PROVIDE INDEPENDENT OPERATION OF EACH ROOM WHEN SEPARATED AND UNIFIED CONTROL WHEN ROOMS ARE COMBINED.

CONTROL SYSTEM: ROOM-LEVEL CONTROL: EACH ROOM IS EQUIPPED WITH EITHER A TOUCHPANEL OR A LUTRON GRAFIK EYE CONTROLLER FOR LOCAL OPERATION OF THE LIGHTING ZONES WITHIN THAT ROOM. CENTRALIZED CONTROL: A CENTRAL LIGHTING CONTROL SYSTEM OVERSEES THE ENTIRE SPACE, CAPABLE OF RECOGNIZING THE OPEN/CLOSED STATUS OF PARTITIONS USING PARTITION SENSORS PROVIDED BY THE FLECTRICAL CONTRACTOR UNIFIED OPERATION: WHEN PARTITIONS ARE OPEN TO COMBINE ROOMS, THE CENTRAL CONTROL SYSTEM UNIFIES THE LIGHTING CONTROL ACROSS THE COMBINED SPACE. THE TOUCHPANELS/GRAFIK EYE CONTROLLERS IN THE COMBINED SPACE WILL SEAMLESSLY OPERATE THE LIGHTING FOR THE ENTIRE AREA. INDEPENDENT OPERATION: WHEN PARTITIONS ARE CLOSED, EACH ROOM OPERATES INDEPENDENTLY. THE TOUCHPANEL/GRAFIK EYE CONTROLLER IN EACH ROOM WILL ONLY CONTROL THE LIGHTING WITHIN THAT

 0-10V DIMMING: ALL LED LIGHTING FIXTURES ARE CONTROLLED VIA 0-10V DIMMING, ALLOWING FOR SMOOTH AND PRECISE ADJUSTMENTS OF LIGHT LEVELS. BASIC CONTROLS: ON/OFF, RAISE/LOWER CONTROLS ARE PROVIDED FOR ADJUSTING LIGHTING LEVELS. SCENE CONTROL: PRE-PROGRAMMED LIGHTING SCENES ARE AVAILABLE TO CATER TO DIFFERENT ACTIVITIES WITHIN THE SPACE, SUCH AS: GENERAL LIGHTING: BALANCED LIGHTING FOR EVERYDAY USE.

PRESENTATION MODE: OPTIMIZED LIGHTING FOR PRESENTATIONS AND AV USE. TASK LIGHTING: INCREASED LIGHTING LEVELS FOR SPECIFIC TASKS. ZONE CONTROL: INDIVIDUAL CONTROL OF LINEAR PENDANTS AND PERIMETER CYLINDER LIGHTS WITHIN EACH ROOM/COMBINED SPACE.

THE ELECTRICAL CONTRACTOR IS RESPONSIBLE FOR PROVIDING AND INSTALLING PARTITION SENSORS THAT INTERFACE WITH THE CENTRAL LIGHTING CONTROL SYSTEM. THESE SENSORS ARE CRUCIAL FOR THE SYSTEM TO ACCURATELY RECOGNIZE THE CONFIGURATION OF THE SPACE AND ENABLE APPROPRIATE LIGHTING CONTROL. INTEGRATION AND FLEXIBILITY:

THE LIGHTING CONTROL SYSTEM IS DESIGNED TO BE FLEXIBLE AND ADAPTABLE TO FUTURE CHANGES IN THE SPACE CONFIGURATION. ADDITIONAL LIGHTING ZONES OR CONTROL POINTS CAN BE EASILY INTEGRATED INTO THE SYSTEM NOTE: SPECIFIC CONTROLLER MODELS, PROGRAMMING DETAILS, AND WIRING REQUIREMENTS WILL BE DETERMINED

THIS COMPREHENSIVE LIGHTING CONTROL SYSTEM WILL PROVIDE INTUITIVE AND FLEXIBLE CONTROL OF THE MULTIPURPOSE SPACE, ENHANCING ITS FUNCTIONALITY AND ADAPTABILITY TO VARIOUS ACTIVITIES AND EVENTS.

BY THE LIGHTING SUPPLIER AND SHALL OPERATE AS NOTED WITH PROVIDE LIGHTING FIXTURES AND THE OVERALL

# **GENERAL NOTES**

- PROGRAM SYSTEM TO MEET THE REQUIREMENTS OF IECC 2021 OR CURRENT ENERGY CODE CONFIRM SWITCHING AND PROGRAMMING SCHEME WITH OWNER PRIOR TO PROGRAMMING.
- PROGRAM SYSTEM TO INCORPORATE AUTO DAYLIGHT SAVINGS ADJUSTMENTS, ASTRONOMICAL CLOCK WITH OFFSETS. HOLIDAY DATES. AND NETWORK OVERRIDE. REFER TO WALLSTATION DIAGRAMS FOR FACTORY ENGRAVED LABELING FOR ALL INDIVIDUAL PUSH-
- SUBMIT ALL WALLSTATION LAYOUTS, ENGRAVING AND CONTROL SEQUENCES DURING THE SHOP DRAWINGS REVIEW PROCESS.
- PROVIDE RELAY BARRIER FOR VOLTAGE AND POWER SOURCE SEPARATION (EMERGENCY AND NORMAL CIRCUITS, VOLTAGE DIFFERENCES).
- PROGRAM NORMAL AND EMERGENCY RELAYS IN RELATED CORRIDORS TO OPERATE TOGETHER.

ALL RELAYS REQUIRING DIMMING AND/OR DAYLIGHT HARVESTING SHALL UTILIZE 0-10V DIMMING. PROVIDE

0-10VDIMMING WIRING AND CONTROLS AS REQUIRED. PROVIDE A MINIMUM OF (5) SPARE RELAYS.

BUTTONS. DEVICE AND COVERPLATE COLORS SELECTED BY ARCHITECT.

0. SYSTEM MUST INTERFACE WITH NEW OR EXISTING ENERGY MANAGEMENT SYSTEM/BMS. PROVIDE SYSTEM CONSISTING OF MONITOR(S), COMMUNICATIONS EQUIPMENT, A CONTROLLER(S), TIMER(S), OR OTHER DEVICE(S) THAT MONITOR AND/OR CONTROL AN ELECTRICAL LOAD OR POWER PRODUCTION OR STORAGE SOURCE. COORDINATE EXACT TIE-IN POINTS AND COMMUNICATION PROTOCOL/MODULES REQUIRED. PROGRAM ACCORDINGLY AND PER OWNERS REQUIREMENTS.

# LIGHTING CONTROL INTENT NARRATIVE (IECC 2021 COMPLIANT)

THE DRAWINGS SHOW GENERAL ZONING INTENT. THE BIDDING CONTRACTOR ALONG WITH THE LIGHTING CONTROLS MANUFACTURER IS RESPONSIBLE FOR PROVIDING A SYSTEM WITH THE FEATURES NECESSARY AND MUST BE CAPABLE OF MEETING THE INTENT. THE MANUFACTURER'S REPRESENTATIVE FOR DIVISION 26 AND BIDDING CONTROLS SHALL BE ACCOUNTABLE FOR THE COMPREHENSIVE LIGHTING CONTROLS PACKAGE'S FINALIZATION IN ALIGNMENT WITH THE DESIGN INTENT DEPICTED IN THE DRAWINGS AND COMPLYING WITH IECC 2021 REQUIREMENTS THE LIGHTING REPRESENTATIVE IS REQUIRED TO FURNISH EXHAUSTIVE SHOP DRAWINGS. ELUCIDATING THE LIGHTING CONTROL SYSTEM'S TOPOLOGY AND THE ESSENTIAL CONNECTIONS NECESSARY FOR ITS PROPER

GENERAL PRINCIPLES: ALL INDOOR AND OUTDOOR LIGHTING WILL BE CONTROLLED BY A SYSTEM THAT PRIORITIZES ENERGY EFFICIENCY AND OCCUPANT COMFORT, MEETING IECC 2021 REQUIREMENTS. LIGHTING WILL PRIMARILY FOLLOW A MASTER CLOCK SCHEDULE PROVIDED BY THE OWNER, WITH MANUAL OVERRIDE THROUGH TOUCH PANELS FOR FINE-TUNING. 0-10V DIMMING WILL BE AVAILABLE ON ALL APPLICABLE LUMINAIRES FOR SMOOTH LIGHT LEVEL

ADJUSTMENTS. OCCUPANCY SENSORS WILL AUTOMATICALLY DIM LIGHTS TO PRESET LEVELS (50% FOR CORRIDORS, STAIRWELLS, VESTIBULES) AFTER PERIODS OF INACTIVITY (15 MINUTES). DAYLIGHT SENSORS WILL FURTHER ADJUST LIGHT LEVELS IN DESIGNATED ZONES BASED ON AVAILABLE

CLASSROOMS, TEAM ROOMS, LEARNING STUDIOS: ROOM CONTROLLER BASED SYSTEM WITH OCCUPANCY AND DAYLIGHT SENSORS THAT MANAGE

NATURAL LIGHT.

SPECIFIC AREAS:

CLASSROOM LIGHTING ENTERING THE SPACE TRIGGERS THE SENSORS, TURNING LIGHTS ON TO 50% BRIGHTNESS. OCCUPANTS CAN SET DESIRED LIGHT LEVELS FROM PRE-PROGRAMMED SCENES THROUGH THE WALL DAYLIGHT SENSORS WILL AUTOMATICALLY ADJUST LIGHT LEVELS IN DESIGNATED ZONES (PRIMARY AND SECONDARY) BASED ON NATURAL LIGHT AVAILABILITY. • LIGHTS TURN OFF AUTOMATICALLY AFTER VACANCY OR A PRESET TIMEOUT PERIOD. EMERGENCY LUMINAIRES OPERATE ON THE SAME CIRCUIT AS NORMAL CLASSROOM LIGHTS. IN CASE OF A POWER FAILURE, DESIGNATED EMERGENCY LUMINAIRE(S)AUTOMATICALLY SWITCH TO 100%

RC1 WALLSTATION: oALL ON: TURNS ALL LIGHTING RELAYS ON, BRINGING ALL DIMMING ZONES TO 100%. oraise & Lower (press and hold): increases or decreases the Brightness of all dimming zones. oALL OFF: TURNS OFF ALL LIGHTING LOADS.

OALL ON: TURNS ALL LIGHTING RELAYS ON, BRINGING ALL DIMMING ZONES TO 100%. oTEACHING WALL/AV SCREEN: TURNS OFF LIGHTING NEAR THE TEACHING WALL/AV SCREEN AND DIMS ALL OTHER oQUIET TIME: SETS ALL DIMMING ZONES TO 40% BRIGHTNESS. oraise & Lower (press and hold): increases or decreases the Brightness of all dimming zones. oall off: Turns off all lighting loads.

oALL ON: TURNS ALL LIGHTING RELAYS ON, BRINGING ALL DIMMING ZONES TO 100%. oPENDANTS: TOGGLES ON/OFF PENDANT LINEAR LIGHTS. o2X4: TOGGLES ON/OFF 2X4 LIGHTS. oQUIET TIME: SETS ALL DIMMING ZONES TO 40% BRIGHTNESS.

# RECEPTION AREAS AND CONFERENCE ROOM: TYPICAL ROOM CONTROLLER BASED SYSTEM:

oall off: Turns off all lighting loads.

RC5 WALLSTATION:

OALL ON: TURNS ALL LIGHTING RELAYS ON, BRINGING ALL DIMMING ZONES TO 100%. oraise & Lower (press and hold): increases or decreases the Brightness of all dimming zones. oALL OFF: TURNS OFF ALL LIGHTING LOADS.

oraise & Lower (press and hold): increases or decreases the Brightness of all dimming zones.

oALL ON: TURNS ALL LIGHTING RELAYS ON, BRINGING ALL DIMMING ZONES TO 100%. oRECEPT: TOGGLES ON/OFF LIGHTS IN RECEPTION AREA/. oWAITING: TOGGLES ON/OFF LIGHTS IN WAITING AREA. oOFFICE: TOGGLES ON/OFF LIGHTS IN OFFICE AREA.

oRAISE & LOWER (PRESS AND HOLD): INCREASES OR DECREASES THE BRIGHTNESS OF ALL DIMMING ZONES. oALL OFF: TURNS OFF ALL LIGHTING LOADS. RC7 WALLSTATION:

oALL ON: TURNS ALL LIGHTING RELAYS ON, BRINGING ALL DIMMING ZONES TO 100%. oOPEN: TOGGLES ON/OFF LIGHTS IN OPEN AREA. orecept: Toggles on/off lights in reception area. oraise & Lower (press and hold): increases or decreases the Brightness of all dimming zones. oALL OFF: TURNS OFF ALL LIGHTING LOADS.

RC8 WALLSTATION: oall on: Turns all lighting relays on, bringing all dimming zones to 100%. oAV MODE: TURNS OFF MAINS LIGHTS AND TURNS ON COVE LIGHTS TO 100%. oMAIN: TOGGLES ON/OFF MAIN LIGHTS (b)

PROVIDE SEPERATE DIMMING CONTROLS FOR THE RECEPTION AREAS.

oCOVE: TOGGLES ON/OFF COVE LIGHTS (a) . oraise & Lower (press and hold): increases or decreases the Brightness of all dimming zones. oall off: Turns off all lighting loads. oALL ON: TURNS ALL LIGHTING RELAYS ON, BRINGING ALL DIMMING ZONES TO 100%.

oRECEPT: TOGGLES ON/OFF LIGHTS IN RECEPTION AREA (a). oCORR: TOGGLES ON/OFF LIGHTS IN CORRIDOR AND PRINTING AREA (c). oWALL: TOGGLES ON/OFF LIGHTS IN RECEPTION AREA. oRAISE & LOWER (PRESS AND HOLD): INCREASES OR DECREASES THE BRIGHTNESS OF ALL DIMMING ZONES (a)

# STUDENT COMMONS AREA: RELAY CONTROLLED LIGHT FIXTURE:

oall off: Turns off all lighting loads.

oall off: Turns off all lighting loads.

oALL ON: TURNS ALL LIGHTING RELAYS ON, BRINGING ALL DIMMING ZONES TO 100%. oSCENE 1: TBD. oSCENE 2: TRD oRAISE & LOWER (PRESS AND HOLD): INCREASES OR DECREASES THE BRIGHTNESS OF ALL DIMMING ZONES.

 OCCUPANCY: LIGHTS AUTOMATICALLY TURN ON TO DAYLIGHT LEVEL WHEN USER ENTERS, AND LIGHTS WILL AUTOMATICALLY TURN OFF 15 MINUTES AFTER VACATED.

oall on: Turns all lighting relays on, Bringing all Dimming Zones to 100%. oALL OFF: TURNS OFF ALL LIGHTING LOADS

OFFICES, TESTING, ETC: WALL MOUNTED OCCUPANCY WALLSTATION WITH DAYLIGHTING AND 0-10V DIMMER; LIGHTS AUTOMATICALLY TURN ON TO DAYLIGHT LEVEL WHEN USER ENTERS, AND LIGHTS WILL AUTOMATICALLY TURN OFF 15 MINUTES AFTER VACATED. TOGGLE CONTROL BETWEEN ON/OFF. 0-10V DIMMING, RAISE AND LOWER.

RELAY CONTROLLED. MASTER CLOCK SCHEDULE BY OWNER. PROGRAM ACCORDINGLY. LIGHTING FOLLOWS THE MASTER CLOCK SCHEDULE AND TOUCH PANEL OVERRIDES AS DEFINED ABOVE. OCCUPANCY SENSORS TRIGGER CORRIDOR RELAY TO DIM ALL LIGHTS TO 50% AFTER 15 MINUTES OF VACANCY. DAYLIGHTING SENSORS IN DESIGNATED ZONES ADJUST LIGHT LEVELS BASED ON AVAILABLE NATURAL LIGHT OCCUPANCY SENSOR PLACEMENT WILL FOLLOW MANUFACTURER RECOMMENDATIONS FOR OPTIMAL

**EGRESS VESTIBULES:** RELAY CONTROLLED. MASTER CLOCK SCHEDULE BY OWNER. PROGRAM ACCORDINGLY. SAME OPERATION AS VESTIBULES, BUT EGRESS LIGHTS REMAIN ON AT 30% AFTER BUILDING CLOSURE. MOTION SENSORS ACTIVATE EGRESS LIGHTS TO 100% FOR 20 MINUTES AFTER DETECTING MOVEMENT, THEN DIM BACK TO 30% ON VACANCY. LIGHTS REMAIN AT 30% UNTIL SCHEDULED BUILDING OPENING.

RELAY CONTROLLED. MASTER CLOCK SCHEDULE BY OWNER. PROGRAM ACCORDINGLY. SAME OPERATION AS VESTIBULES, WITH 50% DIM LEVEL TRIGGERED BY OCCUPANCY SENSORS AFTER 15 MINUTES OF INACTIVITY DAYLIGHTING SENSORS ADJUST LIGHT LEVELS AS DESCRIBED ABOVE.

 SAME OPERATION AS CORRIDORS, BUT EGRESS LIGHTS REMAIN ON AT 30% AFTER BUILDING CLOSURE. MOTION SENSORS ACTIVATE EGRESS LIGHTS TO 100% FOR 20 MINUTES AFTER DETECTING MOVEMENT, THEN DIM BACK TO 30% ON VACANCY. LIGHTS REMAIN AT 30% UNTIL SCHEDULED BUILDING OPENING.

**EXTERIOR PARKING LOT:**  FOLLOWS THE MASTER CLOCK SCHEDULE WITH ASTRONOMICAL OVERRIDE (DUSK ON/11:00 PM OFF, 6 AM ON/DAWN OFF) SITE POLES HAVE STANDALONE DIMMING OCCUPANCY SENSORS THAT DIM TO 20% AFTER 10 MINUTES OF NO

**BUILDING ENTRY SOFFITS AND FLAG POLE:**  FOLLOWS THE MASTER CLOCK SCHEDULE WITH ASTRONOMICAL OVERRIDE (DUSK ON AND DAWN OFF) AND ADDITIONAL OVERRIDE (DUSK ON/11:00 PM OFF, 6 AM ON/DAWN OFF).

 FOLLOWS THE MASTER CLOCK SCHEDULE WITH TOUCH PANEL OVERRIDE AND ASTRONOMICAL OVERRIDE LIGHTS DIM TO 50% AFTER 10 PM AND TURN OFF AT DAWN.

THIS NARRATIVE OUTLINES A LIGHTING CONTROL SYSTEM THAT COMPLIES WITH THE LATEST IECC 2021

BASED ON OCCUPANCY AND AMBIENT LIGHT LEVELS. THIS APPROACH HELPS MINIMIZE ENERGY CONSUMPTION WHILE ENSURING ADEQUATE LIGHTING FOR OCCUPANT SAFETY AND COMFORT. EMERGENCY LIGHTING AND IBC/IECC COMPLIANCE IN ADDITION TO THE STANDARD LIGHTING CONTROL SYSTEM, THE PROJECT WILL INCLUDE AN EMERGENCY LIGHTING SYSTEM DESIGNED TO MEET THE REQUIREMENTS OF THE INTERNATIONAL BUILDING CODE (IBC) AND THE INTERNATIONAL ENERGY CONSERVATION CODE (IECC). THIS SYSTEM PRIORITIZES OCCUPANT SAFETY AND EGRESS DURING POWER OUTAGES.

REQUIREMENTS, EMPHASIZING AUTOMATED CONTROLS, DAYLIGHT HARVESTING, AND ENERGY-EFFICIENT DIMMING

**EMERGENCY LIGHTING FEATURES:** DEDICATED CIRCUITS: EMERGENCY LUMINAIRES WILL BE CONNECTED TO SEPARATE, DEDICATED CIRCUITS THAT ARE NOT AFFECTED BY NORMAL POWER OUTAGES. AUTOMATIC ACTIVATION: UPON DETECTION OF A POWER FAILURE, EMERGENCY LIGHTS WILL AUTOMATICALLY SWITCH ON TO 100% BRIGHTNESS WITHIN THE FACILITY. GENERATOR BACKUP: THE EMERGENCY LIGHTING SYSTEM WILL BE BACKED UP BY A GENERATOR TO ENSURE SUSTAINED OPERATION DURING EXTENDED POWER OUTAGES. EXIT PATH ILLUMINATION: EMERGENCY LIGHTING WILL BE STRATEGICALLY PLACED TO EFFECTIVELY ILLUMINATE ALL DESIGNATED EXIT PATHS AND STAIRWELLS. FACILITATING SAFE EVACUATION.

ENSURE PROPER FUNCTIONALITY.

ADDITIONAL NOTES: THE SPECIFIED TIME DELAYS AND LIGHT LEVELS CAN BE ADJUSTED TO SUIT THE SPECIFIC NEEDS OF THE BUILDING AND OCCUPANTS. AFTER 2 MONTHS OF OCCUPANCY, LIGHTING PROGRAMMER SHALL RETURN TO MAKE ADJUSTMENTS PER THE OWNERS REQUEST.

COMPLIANCE AND INSPECTION: THE EMERGENCY LIGHTING SYSTEM WILL BE DESIGNED AND INSTALLED IN

ACCORDANCE WITH IBC AND IECC REQUIREMENTS, AND WILL BE SUBJECT TO REGULAR INSPECTIONS TO

# LIGHT FIXTURE SCHEDULE

LIGHT FIXTURE ABBREVIATION SCHEDULE ABOVE FINISH FLOOR STANDARD PAINTED COLOR AS SELECTED BY THE ARCHITECT WALL@CLG WALL MOUNT AT CORNER OF WALL AND CEILING CUSTOM FINISH AS SELECTED BY THE ARCHITECT CUSTOM PAINTED COLOR AS SELECTED BY THE ARCHITECT

REFER TO THE SPECIFICATIONS FOR OTHER LIGHT FIXTURE, FUSING, LED DRIVERS, AND LAMP REQUIREMENTS AND ACCEPTABLE MANUFACTURERS.

STANDARD FINISH AS SELECTED BY THE ARCHITECT

LIGHT FIXTURE GENERAL NOTES REFER TO ARCHITECTURAL REFLECTED CEILING PLANS FOR LOCATIONS OF LIGHT FIXTURES AND, CONFIRM CEILING TYPES WITH LIGHT FIXTURE TRIMS. BRING ALL DISCREPANCIES OF LOCATIONS AND QUANTITIES TO THE ATTENTION OF THE ARCHITECT AND

ELECTRICAL ENGINEER PRIOR TO BIDDING REFER TO ARCHITECTURAL ELEVATIONS FOR MOUNTING HEIGHTS AND LOCATIONS OF LIGHT FIXTURES. BRING ALL DISCREPENCIES TO THE ATTENTION OF THE ARCHITECT PRIOR TO BIDDING.

CONFIRM AVAILABLE MOUNTING DEPTHS OF ALL LIGHT FIXTURES AND COMPARE WITH DEPTHS SHOWN ON SHOP DRAWINGS. BRING ALL POTENTIAL CONFLICT AREAS TO THE ATTENTION OF THE ARCHITECT AND ELECTRICAL ENGINEER PRIOR TO RELEASE. REFER TO LIGHTING PLANS FOR ALL LINEAR FIXTURE LENGTHS. THE CATALOG NUMBER IS BASED ON THE FIXTURE SPECIFIED AND MAY NOT REFLECT THE QUANTITY OR OVERALL LENGTH OF LINEAR FIXTURES REQUIRED. CONTRACTOR TO NOTE THAT VARIOUS FIXTURE LENGTHS MAY BE REQUIRED TO ACHIEVE THE OVERALL RUN LENGTH.

REFER TO LIGHTING PLANS FOR ALL UNDERCABINET FIXTURE LENGTHS. THE CATALOG NUMBER IS BASED ON THE FIXTURE SPECIFIED AND MAY NOT REFLECT THE QUANTITY OR OVERALL LENGTH OF THE UNDERCABINET FIXTURES REQUIRED. CONTRACTOR TO NOTE THAT VARIOUS FIXTURE LENGTHS MAY BE REQUIRED TO ACHIEVE THE OVERALL RUN LENGTH OR TO FIT WITHIN THE MILLWORK. COORDINATE FIXTURE LAYOUT WITH MILLWORK SHOP DRAWINGS PRIOR TO LIGHTING SUBMITTALS. WHEN A CONTRADICTION EXISTS BETWEEN A SPECIFIC MODEL NUMBER AND THE DESCRIPTION, NOTIFY THE ELECTRICAL ENGINEER AND/OR LIGHTING DESIGNER.

PRIOR APPROVALS ARE REQUIRED BEFORE BIDDING THE PROJECT AND SHALL BE SUBMITTED TO THE ELECTRICAL ENGINEER'S OFFICE AT LEAST (8) EIGHT WORKING DAYS BEFORE THE BID. PRIOR APPROVALS RECEIVED AFTER THIS TIME PERIOD SHALL BE...

REFER TO SPECIFICATIONS 20 0500, 26 5100 & 26 5600 (16001, 16510 & 16551).

s <b>I</b>	ER TO SPECIFICATIONS 20 0500, 26 5100 & 26 5600 (16001, 16510 & 16551). JE ENGINEERING CONDUCTED WITHOUT THE DESIGN TEAM IE; ARCHITECT, ENG	GINEER & LIGHTING	CONSULTANT/DESIGNER WILL NOT BE ALLOWED, REVIEWED OR APPROVE	ED.					
TYPE 3PC2	DESCRIPTION  3" LED PENDANT DOWNLIGHT CYLINDER; FIXTURES TO BE HUNG BETWEEN CEILING PANELS, COORDINATE FINAL HEIGHT WITH ARCHITECT; 50 DEGREE	MFR.	CATALOG#	VOLTS	TOTAL WATTS	LAMP TYPE	DELIVERED LUMENS	COLOR TEMP	CRI
4PRW	OPTICS+HEX+SOLITE LENS; 0-10V DIMMING; 50,000+ HOUR (L70); 5 YR WARRANTY  4" WIDE LINEAR RECESSED PERIMETER FILL FIXTURE; EXTRUDED ALUMINUM BODY; FLUSH LENS; FIXTURE LENS SHALL BE CONTINUOUS (NO BREAKS);	CSL LIGHTING PRUDENTIAL	LP3-30-40-50-HEX-MP-CCBA-S-NCXX(SCBA)  BPRO4-REG1-LED4-SO-SEE PLANS-SCBA-PFL-WTW-SC-UNV-X3-DM01	277 V 277 V	30 VA	890 LM/FT LED,	2,440	4000 K	80+
5PC4	BUILT TO LENGTH (SEE PLANS); 90 DEGREE PATTERNED CORNER INTERSECTION; CCBA; 60,000+ HOUR (L80); 5 YR. WARRANTY; 0-10V DIMMING; DRYWALL FLANGE KIT  5" LED PENDANT DOWNLIGHT CYLINDER; FIXTURES TO BE HUNG ABOVE	LIGHTING			8 VA	4000K CCT, 80+ CRI			
6LBP	CEILING PANELS, COORDINATE FINAL HEIGHT WITH ARCHITECT; 30 DEGREE OPTICS+SOLITE LENS; 0-10V DIMMING; 50,000+ HOUR (L70); 5 YR WARRANTY  6'L U-SHAPED LINEAR DIRECT/INDIRECT PENDANT LED LUMINAIRE; WIDESPREAD OPTICS (D60% / I40%); VERIFY SUSPENSION HEIGHT WITH	CSL LIGHTING BETA CALCO	LP5-30-40-50-MP-MB-S-NCXX(SCBA)  BRID2P-SL08-DR3-LPF060-CR80-CTA40-V1-DA01-H1-DT01-HLA03-SCBA-SCB	277 V 277 V	50 VA 48 VA	LED LED	4,252	4000 K	80+
22LR	ARCHITECT; 50,000 HOUR (L70); 0-10 DIMMING; 5 YR WARRANTY  2'X2' HIGH PERFORMANCE LED EDGE LIGHT LUMINAIRE; ULTRA-THIN WITH REMOTE DRIVER; NARROW ALUMINUM BEZEL; OPAL PMMA LENS;	LITELINE	A-SCBA-EO  EDGE-22-H-4-2-UNV	277 V	20 VA	LED	2,200	4000 K	80+
22MR	GLARE-GUARD TECHNOLOGY; RECESSED INTO GRID ARCHITECTURAL CEILING; EASY TO CLEAN; 60,000 HOUR (L70); 5 YR. WARRANTY; 0-10 DIMMING 2'X2' HIGH PERFORMANCE LED EDGE LIGHT LUMINAIRE; ULTRA-THIN WITH REMOTE DRIVER; NARROW ALUMINUM BEZEL; OPAL PMMA LENS;	LITELINE	EDGE-22-H-4-2-UNV	277 V	30 VA	LED	3.100	4000 K	80+
A4H	GLARE-GUARD TECHNOLOGY; RECESSED INTO GRID ARCHITECTURAL CEILING; EASY TO CLEAN; 60,000 HOUR (L70); 5 YR. WARRANTY; 0-10 DIMMING 2'X4' RECESSED LED LAY-IN LUMINAIRE; RECESSED INTO ACCESSIBLE ARCHITECTURAL CEILING; EASY TO CLEAN; 60,000 HOUR (L73); 5 YR.	METALUX	24FPSL2SCT3	277 V	56 VA	6300 LUMEN LED, 4000K CCT, 80+	6,300	4000 K	80+
A4M	WARRANTY; 0-10 DIMMING; FIELD-SELECTABLE LUMEN OUTPUT (HIGH, 4000K)  2'X4' RECESSED LED LAY-IN LUMINAIRE; RECESSED INTO ACCESSIBLE  ARCHITECTURAL CEILING; EASY TO CLEAN; 60,000 HOUR (L73); 5 YR.  WARRANTY; 0-10 DIMMING; FIELD-SELECTABLE LUMEN OUTPUT (MEDIUM,	METALUX	24FPSL2SCT3	277 V	50 VA	5564 LUMEN LED, 4000K CCT, 80+	5,700	4000 K	80+
B2H	4000K)  2'X2' RECESSED LED LAY-IN LUMINAIRE; RECESSED INTO ACCESSIBLE ARCHITECTURAL CEILING; EASY TO CLEAN; 60,000 HOUR (L73); 5 YR. WARRANTY; 0-10 DIMMING; FIELD-SELECTABLE LUMEN OUTPUT (HIGH, 4000K)	METALUX	22FPSL2SCT3	277 V	31 VA	3500 LUMEN LED, 4000K CCT, 80+ CRI			80+
B2M	2'X2' RECESSED LED LAY-IN LUMINAIRE; RECESSED INTO ACCESSIBLE ARCHITECTURAL CEILING; EASY TO CLEAN; 60,000 HOUR (L73); 5 YR. WARRANTY; 0-10 DIMMING; FIELD-SELECTABLE LUMEN OUTPUT (HIGH, 4000K)	METALUX	22FPSL2SCT3	277 V	22 VA	2460 LUMEN LED, 4000K CCT, 80+ CRI			
CUR2	2" WIDE LINEAR PATTERNED LED; RECESSED INTO INACCESSIBLE ARCHITECTURAL CEILING; DRYWALL FLANGE KIT; FLUSH, HIGH EFFICIENCY LENS; FIXTURE LENS SHALL BE CONTINUOUS (NO BREAKS); BUILT TO LENGTH/PATTERN (SEE PLANS); 50,000 HOUR (DRIVER), 117,000 HOUR (L70); 0-10 DIMMING; 5 YR WARRANTY; CCBA	LUMENWERX	CURV2RPAT-D-HLO-SW-80CRI-500-40K-#FT(SEE PLANS)-XXX-XXX-UNV-D1-1C-DMF-CF	277 V	5 VA	500 LUMEN/FT LED, 4.5W/FT, 4000K CCT, 80+ CRI	500	4000 K	80+
CVL	LOW PROFILE LINEAR LED WEDGE RAIL/COVE LUMINAIRE; ULTRA-SLIM 0.5" PROFILE, MOUNTED IN SHALLOW COVE IN CONFERENCE ROOM; ASYMMETRIC DIFFUSED LENS (40° AT 15° TILT); REMOTE DRIVER, LOCATE IN ACCESSIBLE CEILING; 50,000 HOUR (L70); 5 YR. WARRANTY; 0-10 DIMMING; FIELD MEASURE CABINET LENGTH BEFORE ORDERING; CONTRACTOR TO PROVIDE ALL POWER SUPPLIES, CONNECTORS, FEEDS, MOUNTING HARDWARE, DIMMING	xico	MWE140-#FT(SEE PLANS)-DY-E1-MWH-OA-HE80-40-A4015-350-SMC-XX-XX-UNV-FD01-NN-RXX D(VERIFY WITH FACTORY)-NN	277 V	3 VA	350 LUMEN/FT LED, 3W/FT, 4000K CCT, 80+ CRI	350	4000 K	80+
D4A	SWITCHES, ETC. REQUIRED FOR A COMPLETE AND WORKING SYSTEM  4" LED RECESSED ROUND DOWNLIGHT IN INACCESSIBLE CEILING; FRAME + TRIM KIT; SELF-FLANGED; 55,000 HOUR (L90); 5 YR WARRANTY; 0-10 DIMMING; SCBA; MEDIUM DISTRIBUTION	PRESCOLITE	LTR-4RD-H-SL10L-DM1-UNV/LTR-4RD-T-SL40K8MD-SCBA-SCBA-SCBA	277 V	12 VA	1000 LUMEN LED, 4000K CCT, 80+ CRI	1,000	4000 K	80+
L2HP	2" WIDE LINEAR DIRECT/INDIRECT PENDANT LED LUMINAIRE; WIDESPREAD OPTICS; FLUSH LENS; FIXTURE LENS SHALL BE CONTINUOUS (NO BREAKS); BUILT TO LENGTH (SEE PLANS); HANG BETWEEN CEILING BAFFLES; 50,000 HOUR (L70); 0-10 DIMMING; 5 YR WARRANTY	LUMENWERX	VIA2P-DI-WDO-FH-WIO2-SW-80CRI-750LMF-200LMF-40K-#FT(SEE PLANS)-UNV-D1-1C-ACS-CCBA-XX-XX	277 V	8 VA	750 LUMEN/FT DIRECT, 200 LUMEN/FT INDIRECT, 8.3W/FT, 4000K CCT, 80+ CRI	950	4000 K	80+
L2HPP	2" WIDE LINEAR DIRECT/INDIRECT PENDANT LED LUMINAIRE; ASYMMETRIC DIRECT REFRACTIVE OPTIC (POINT INTO THE ROOM), WIDESPREAD INDIRECT OPTIC; FLUSH LENS; FIXTURE LENS SHALL BE CONTINUOUS (NO BREAKS); BUILT TO LENGTH (SEE PLANS); HANG BETWEEN CEILING BAFFLES; 50,000 HOUR (L70); 0-10 DIMMING; 5 YR WARRANTY	LUMENWERX	VIA2P-DI-ARO2-FH-WIO2-SW-80CRI-750LMF-200LMF-40K-#FT(SEE PLANS)-UNV-D1-1C-ACS-CCBA-XX-XX	277 V	8 VA	750 LUMEN/FT DIRECT, 200 LUMEN/FT INDIRECT, 8.3W/FT, 4000K CCT, 80+ CRI	950	4000 K	80+
L2MPD	2" WIDE LINEAR DIRECT PENDANT LED LUMINAIRE; LOW-GLARE OPTIC; FLUSH LENS; FIXTURE LENS SHALL BE CONTINUOUS (NO BREAKS); BUILT TO LENGTH (SEE PLANS); HANG BETWEEN CEILING PANELS; 50,000 HOUR (L70); 0-10 DIMMING; 5 YR WARRANTY	LUMENWERX	VIA2P-D-LGO-FH-WIO2-SW-80CRI-400LMF-40K-#FT(SEE PLANS)-UNV-D1-1C-ACS-CCBA-XX-XX	277 V	6 VA	400 LUMEN/FT DIRECT, 5.7W/FT, 4000K CCT, 80+ CRI	400	4000 K	80+
L2PRD	2" DEEP REGRESSED PERIMETER SLOT SYSTEM LED LUMINAIRE; RECESSED INTO INACCESSIBLE ARCHITECTURAL CEILING; STANDARD DRYWALL FLANGE; FIXTURE LENS SHALL BE CONTINUOUS (NO BREAKS); BUILT TO LENGTH, VERIFY FIELD CONDITIONS; 60,000 HOUR (L80); 5 YR. WARRANTY; 0-10 DIMMING	LUMENWERX	V2PERD-HLO-SW-LED-80CRI-750-40-#FT(SEE PLANS)-XX-XX-UNV-D1-1-DMF-SCBA	277 V	7 VA	750 LUMEN/FT, 6 W/FT, 4000K CCT, 80+ CRI	750	4000 K	80+
L2VPD	2" WIDE LINEAR DIRECT PENDANT LED LUMINAIRE; WIDESPREAD OPTIC; FLUSH LENS; FIXTURE LENS SHALL BE CONTINUOUS (NO BREAKS); BUILT TO LENGTH (SEE PLANS); HANG BETWEEN CEILING PANELS; 50,000 HOUR (L70); 0-10 DIMMING; 5 YR WARRANTY	LUMENWERX	VIA2P-D-WDO-FH-WIO2-SW-80CRI-1000LMF-40K-#FT(SEE PLANS)-UNV-D1-1C-ACS-CCBA-XX-XX	277 V	11 VA	1000 LUMEN/FT DIRECT, 11W/FT, 4000K CCT, 80+ CRI	1,000	4000 K	80+
L4HD	6"X4" HIGH PERFORMANCE LED FLAT PANEL LUMINAIRE; ULTRA-THIN <2-3/8"; GLARE-FREE; NARROW ALUMINUM BEZEL; ACRYLIC LIGHT GUIDE, WHITE FROST LENS WITH SMOOTH PATTERN; SCRATCH AND IMPACT RESISTANT; RECESSED INTO INACCESSIBLE ARCHITECTURAL CEILING; DRYWALL FLANGE KIT; EASY TO CLEAN; 60,000 HOUR (L73); 5 YR. WARRANTY; 0-10 DIMMING; FIELD SELECTABLE LUMEN OUTPUT (HIGH, 4000K)	METALUX	4RBG6-SL1-UNV-L840+DF-64W-U	277 V	36 VA	4195 LUMEN LED, 4000K CCT, 80+ CRI			80+
L4MD	6"X4" HIGH PERFORMANCE LED FLAT PANEL LUMINAIRE; ULTRA-THIN <2-3/8"; GLARE-FREE; NARROW ALUMINUM BEZEL; ACRYLIC LIGHT GUIDE, WHITE FROST LENS WITH SMOOTH PATTERN; SCRATCH AND IMPACT RESISTANT; RECESSED INTO INACCESSIBLE ARCHITECTURAL CEILING; DRYWALL FLANGE KIT; EASY TO CLEAN; 60,000 HOUR (L73); 5 YR. WARRANTY; 0-10 DIMMING; FIELD SELECTABLE LUMEN OUTPUT (MID, 4000K)	METALUX	4RBG6-SL1-UNV-L840+DF-64W-U	277 V	28 VA	3339 LUMEN LED, 4000K CCT, 80+ CRI			80+
L8MD	6"X8' HIGH PERFORMANCE LED FLAT PANEL LUMINAIRE; ULTRA-THIN <2-3/8"; GLARE-FREE; NARROW ALUMINUM BEZEL; ACRYLIC LIGHT GUIDE, WHITE FROST LENS WITH SMOOTH PATTERN; SCRATCH AND IMPACT RESISTANT; RECESSED INTO INACCESSIBLE ARCHITECTURAL CEILING; DRYWALL FLANGE KIT; EASY TO CLEAN; 60,000 HOUR (L73); 5 YR. WARRANTY; 0-10 DIMMING; FIELD SELECTABLE LUMEN OUTPUT (MID, 4000K)	METALUX	8RBG6-SL1-UNV-L840+DF-68W-U	277 V	63 VA	7160 LUMEN LED, 4000K CCT, 80+ CRI			80+
OC13	ARCHITECTURAL 13" LED ROUND CEILING MOUNTED LUMINARIE; REPLACES EXISTING RECESSED LIGHTING FIXTURE IN DRIVE THROUGH CANOPY, COVER EXISTING HOLE COMPLETELY; HIGH IMPACT RESISTANT LENS; MARINE GRADE, CORROSION RESISTANT, DIE-CAST ALUMINUM HOUSING; IP66 RATED; 70,000 HOUR (L70); 5 YR WARRANTY; 0-10 DIMMING	FC LIGHTING	FCW3800-UNV-4K-CRI85-26L-SCBA	277 V	32 VA	LED	2,619	4000 K	85+
OFW	EXTERIOR LED FLOODLIGHT; IP66 WET LISTED; IK07 IMPACT AND VANDAL RESISTANT; ANTI-GLARE VISOR; WIDE OPTICAL DISTRIBUTION; 50,000 HOUR (L70)5 YR WARRANTY; MOUNT TO EXISTING BUILDING AND LOCATE AS HIGH AS POSSIBLE. PROVIDE REQUIRED MOUNTING HARDWARE; AIM TOWARDS FLAGPOLE ACCORDINGLY	LIGMAN	UZA-50011-40W COB-N-W40-SCBA-120/277	277 V	40 VA	LED	3,681	4000 K	80+
S OLDH	PREMIUM EXTERIOR LED LINEAR LUMINAIRE (TAPE AND EXTRUSION); .88" W X .64" H; DIFFUSED LENS; WIDE OPTIC; DAMP RATED; COORDINATE OPENING, LOCATION, AND MECHANICALLY FASTEN TO BETWEEN ARCHITECTURAL CEILING AND FRAMING; FIELD MEASURE TO GET ACCURATE SIZES PRIOR TO ORDERING; PROVIDE FACTORY SHOP DRAWINGS SHOWING CONTINUOUS FIXTURE LENGTHS AND ANGLE SUGGESTIONS; REMOTE DRIVERS; VERIFY FIELD CONDITIONS; 60,000 HOUR (L80); 5 YR. WARRANTY; 0-10 DIMMING; SCBA	Q-TRAN	VERS-01-SW-6.0HE-40-DMP-DF-XX-XX-XX-XX-#FT(SEE PLANS)-SCBA+QTM-0-10V DRIVERS/PS	277 V	6 VA	616 LUMEN/FT, 6 W/FT, 4000K CCT, 80+ CRI	616	4000 K	80+
OP2	MEDIUM ARCHITECTURAL AREA LED SITE LUMINAIRE; DIE-CAST & EXTRUDED ALUMINUM HOUSING; TYPE II DISTRIBUTION, FULL CUTOFF; IP66 RATED; HOUSE SIDE SHIELD MUST BE CUPPED OPTIC STYLE; INSTALL HOUSE SIDE	LITHONIA/GENER AL STRUCTURES INC	DSX1-P4-40K-70-T2M-MVOLT-RPA-PIRH-HS(SEE PLANS)-SCBA/CPA-2-8025-25-D1-VD-SCBA	277 V	124 VA	21,490 LUMEN LED, 4000K CCT, 70+ CRI			70+
	ALUMINUM HOUSING; TYPE IVFT DISTRIBUTION, FULL CUTOFF; IP66 RATED; HOUSE SIDE SHIELD MUST BE CUPPED OPTIC STYLE; INSTALL HOUSE SIDE	LITHONIA/GENER AL STRUCTURES INC	DSX1-P4-40K-70-TFTM-MVOLT-RPA-PIRH-HS(SEE PLANS)-SCBA/CPA-2-8025-25-D1-VD-SCBA	277 V	124 VA	16,000 LUMEN LED, 4000K CCT, 70+ CRI			70+
OP24	MEDIUM ARCHITECTURAL AREA LED SITE LUMINAIRE; DIE-CAST & EXTRUDED ALUMINUM HOUSING; TYPE IV FORWARD THROW AND TYPE II DISTRIBUTION, FULL CUTOFF; IP66 RATED; DIMMING/DAWN/DUSK MOTION SENSOR, FIELD PROGRAMMABLE OUTPUT BASED ON MOTION, PROGRAMMED PER OWNERS REQUIREMENTS; 100,000 HOUR (L70); 5 YR. WARRANTY; MOUNTED ON A 25' ROUND TAPERED ALUMINUM POLE w/VIBRATION DAMPENING; MAX EPA 5.4 @ 120; LIFETIME WARRANTY ON POLE; DUAL HEAD LUMINAIRE MOUNTING; SCBA; DLC PREMIUM LISTED	LITHONIA/GENER AL STRUCTURES INC	DSX1-P4-40K-70-TFTM+T2M-MVOLT-RPA-PIR-SCBA/CPA-2-8025-25-D1-VD-S CBA	277 V	148 VA	19,049+14,458 LUMEN LED, 4000K CCT, 70+ CRI			70+
\ \ \ \	ALUMINUM HOUSING; TYPE IV FORWARD THROW AND TYPE IV FORWARD THROW DISTRIBUTION, FULL CUTOFF; IP66 RATED; DIMMING/DAWN/DUSK	LITHONIA/GENER AL STRUCTURES INC	DSX1-P4-40K-70-TFTM+TFTM-MVOLT-RPA-PIR-SCBA/CPA-2-8025-25-D1-VD-SCBA	277 V	148 VA	17,800 + 17,800 LUMEN LED, 4000K CCT, 70+ CRI			70+
OW340	ARCHITECTURAL WALL MOUNTED LED SITE LUMINARIE; DIFFUSED DROP LENS; DIE-CAST & EXTRUDED ALUMINUM HOUSING; TYPE 3 DISTRIBUTION, FULL CUTOFF; IP66 RATED; 50,000 HOUR (L70); 5 YR WARRANTY; 0-10 DIMMING	LITHONIA	DSXW1-LED-20C-530-40K-T3M-MVOLT-DDL-SCBA	277 V	35 VA	4,315 LUMEN LED, 4000K CCT, 70+ CRI			80+
P2T	BASED ON MOTION, PROGRAMMED PER OWNERS REQUIREMENTS; 100,000 HOUR (L70); 5 YR. WARRANTY; MOUNTED ON A 30' ROUND TAPERED ALUMINUM POLE w/VIBRATION DAMPENING; MAX EPA 5.4 @ 120; LIFETIME	LITHONIA/GENER AL STRUCTURES INC		277 V	102 VA	13600 LUMEN LED, 4000K CCT, 70+ CRI			
PBS	WARRANTY ON POLE; QUADRUPLE HEAD LUMINAIRE MOUNTING; CCBA DECORATIVE BALLON DISCS PENDANT MOUNTED LED LUMINAIRE; ABSTRACT SHAPE; 50,000 HOUR (L70); 5 YR WARRANTY; 0-10V DIMMING; COORDINATE EXACT SUSPENSION HEIGHT AND ROTATION WITH ARCHITECT, RODS LENGTHS TO BE CUSTOMIZABLE AND REVIEWED DURING SHOP DRAWINGS;	ZANEEN	D71034-SCBA-SCBA	277 V	38 VA	1500 LUMEN LED, 4000K CCT, 85+ CRI			85+
\$ \$ \$	COLORS CHOSEN BY ARCHITECT  8" ROUND (6" LENS) SURFACE MOUNTED LED LUMINAIRE W/ PIR SENSOR; LOW PROFILE; MOUNTS IN STANDARD 4" DEEP OCTAGONAL JUNCTION BOX; PROVIDE JUNCTION BOX/HOUSING AS REQUIRED; 50,000 HOUR (L70); 5 YR	VERSALED	SD5-6-15L-277V-MCT-OCS	120 V	15 VA	LED	1,000	4000 K	80+
SL4C	WARRANTY; 0-10 DIMMING; FIELD SELECTABLE CCT (4000K)  4' LED CHAIN MOUNTED LINEAR STRIPLIGHT; RUGGED ENCLOSED FULLY FROSTED ACRYLIC LENS; 303,000 HOUR (L70); 5 YR. WARRANTY; 0-10 DIMMING	METALUX	4SNLED-LD5-54SL-LW-UNV-L840-CD1-U-AYC-CHAIN/SET	277 V	62 VA	6500 LUMEN LED, 4000K CCT, 80+ CRI			80
SLF	SKYLIGHT MOUNTED LOW-PROFILE LED TAPE+CHANNEL+TILTABLE STANDS LUMINAIRE; FROSTED LENS; BEAM ANGLE 118° REMOTE DRIVER; 50,000 HOUR (L70); 5 YR. WARRANTY; 0-10 DIMMING; MOUNT IN SKYLIGHT CHANNEL INTENDED FOR LIGHT FIXTURE, ANGLE LIGHT FIXTURE OUT AND TOWARDS SKYLIGHT, COORDINATE ROUGH-IN AND REFER TO ARCHITECTURAL DETAILS ON SHEET A335; FIELD MEASURE SKYLIGHT LENGTH BEFORE ORDERING; CONTRACTOR TO PROVIDE ALL POWER SUPPLIES, CONNECTORS, FEEDS, MOUNTING HARDWARE, ETC. REQUIRED FOR A COMPLETE AND WORKING	ACOLYTE	TAPE CHANNEL - CHAS1-C-SV-RB-90-SWS220-6.0-40K-1-FI-TILTSTANDST+DRIVER - DRVW2428810P	277 V	6 VA	500 LUMEN/FT LED, 4.5W/FT, 4000K CCT, 80+ CRI	500	4000 K	80+
X1	SYSTEM  UNIVERSAL EDGE-LIT EXIT SIGN; BRUSHED ALUMINUM HOUSING AND BLACK PLASTIC END-CAPS, WITH HIGH GRADE ACRYLIC PANEL; GREEN LETTERING; UNIVERSAL FACE, SINGLE, DOUBLE; UNIVERSAL MOUNTING, SURFACE, RECESSED, OR END-MOUNT; FIELD VERIFY FACE COUNTS AND MOUNTING METHODS; AC ONLY	EMERGI-LITE	PAG6	277 V	2 VA	LED			



PROJECT MANAGER: DRAYTON BAILEY


280 South 400 West Suite 250 Salt Lake City, Utah 84101 Telephone (801) 595-6700

www.mhtn.com



West Valley City, UT 84120 P: 801.532.2196 F: 801.532.2305 www.bnaconsulting.com

<u> </u>	7	(m)
2023 MHTN ARCHITECTS, IN	C.	
confidentiality Notice: his document is intended for use nd companies involved in the desi ne Project. MHTN Architects, Inc. eproduce this document for purpose opying this document for purpose rohibited. If a digital copy of this d	ign, permitting, biddin grants limited rights xpress purpose only. s other than those inc	g and construction of to distribute and Distribution, printing dicated is strictly

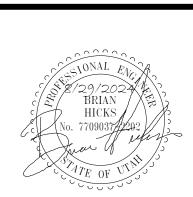


мнти ргојест по. 2024528	
Original drawing is 30 x 42. Do not scale contents of this drawing.	
REVISIONS CONTRACTOR TO VERIFY DRAWINGS IN FIELD USE REFLE LAST REVISION DATE.	С

Original drawing is 50 x 42. Do not scale contents of this drawing.			
		IFY DRAWINGS IN FIELD USE REFLE	
NO.	DATE	DESCRIPTION	
1	9/6/24	Addendum #1	
2	09/13/2024	Addendum #2	

CONSTRUCTION DOCUMENTS AUGUST 29, 2024

ELECTRICAL SCHEDULES AND NOTES

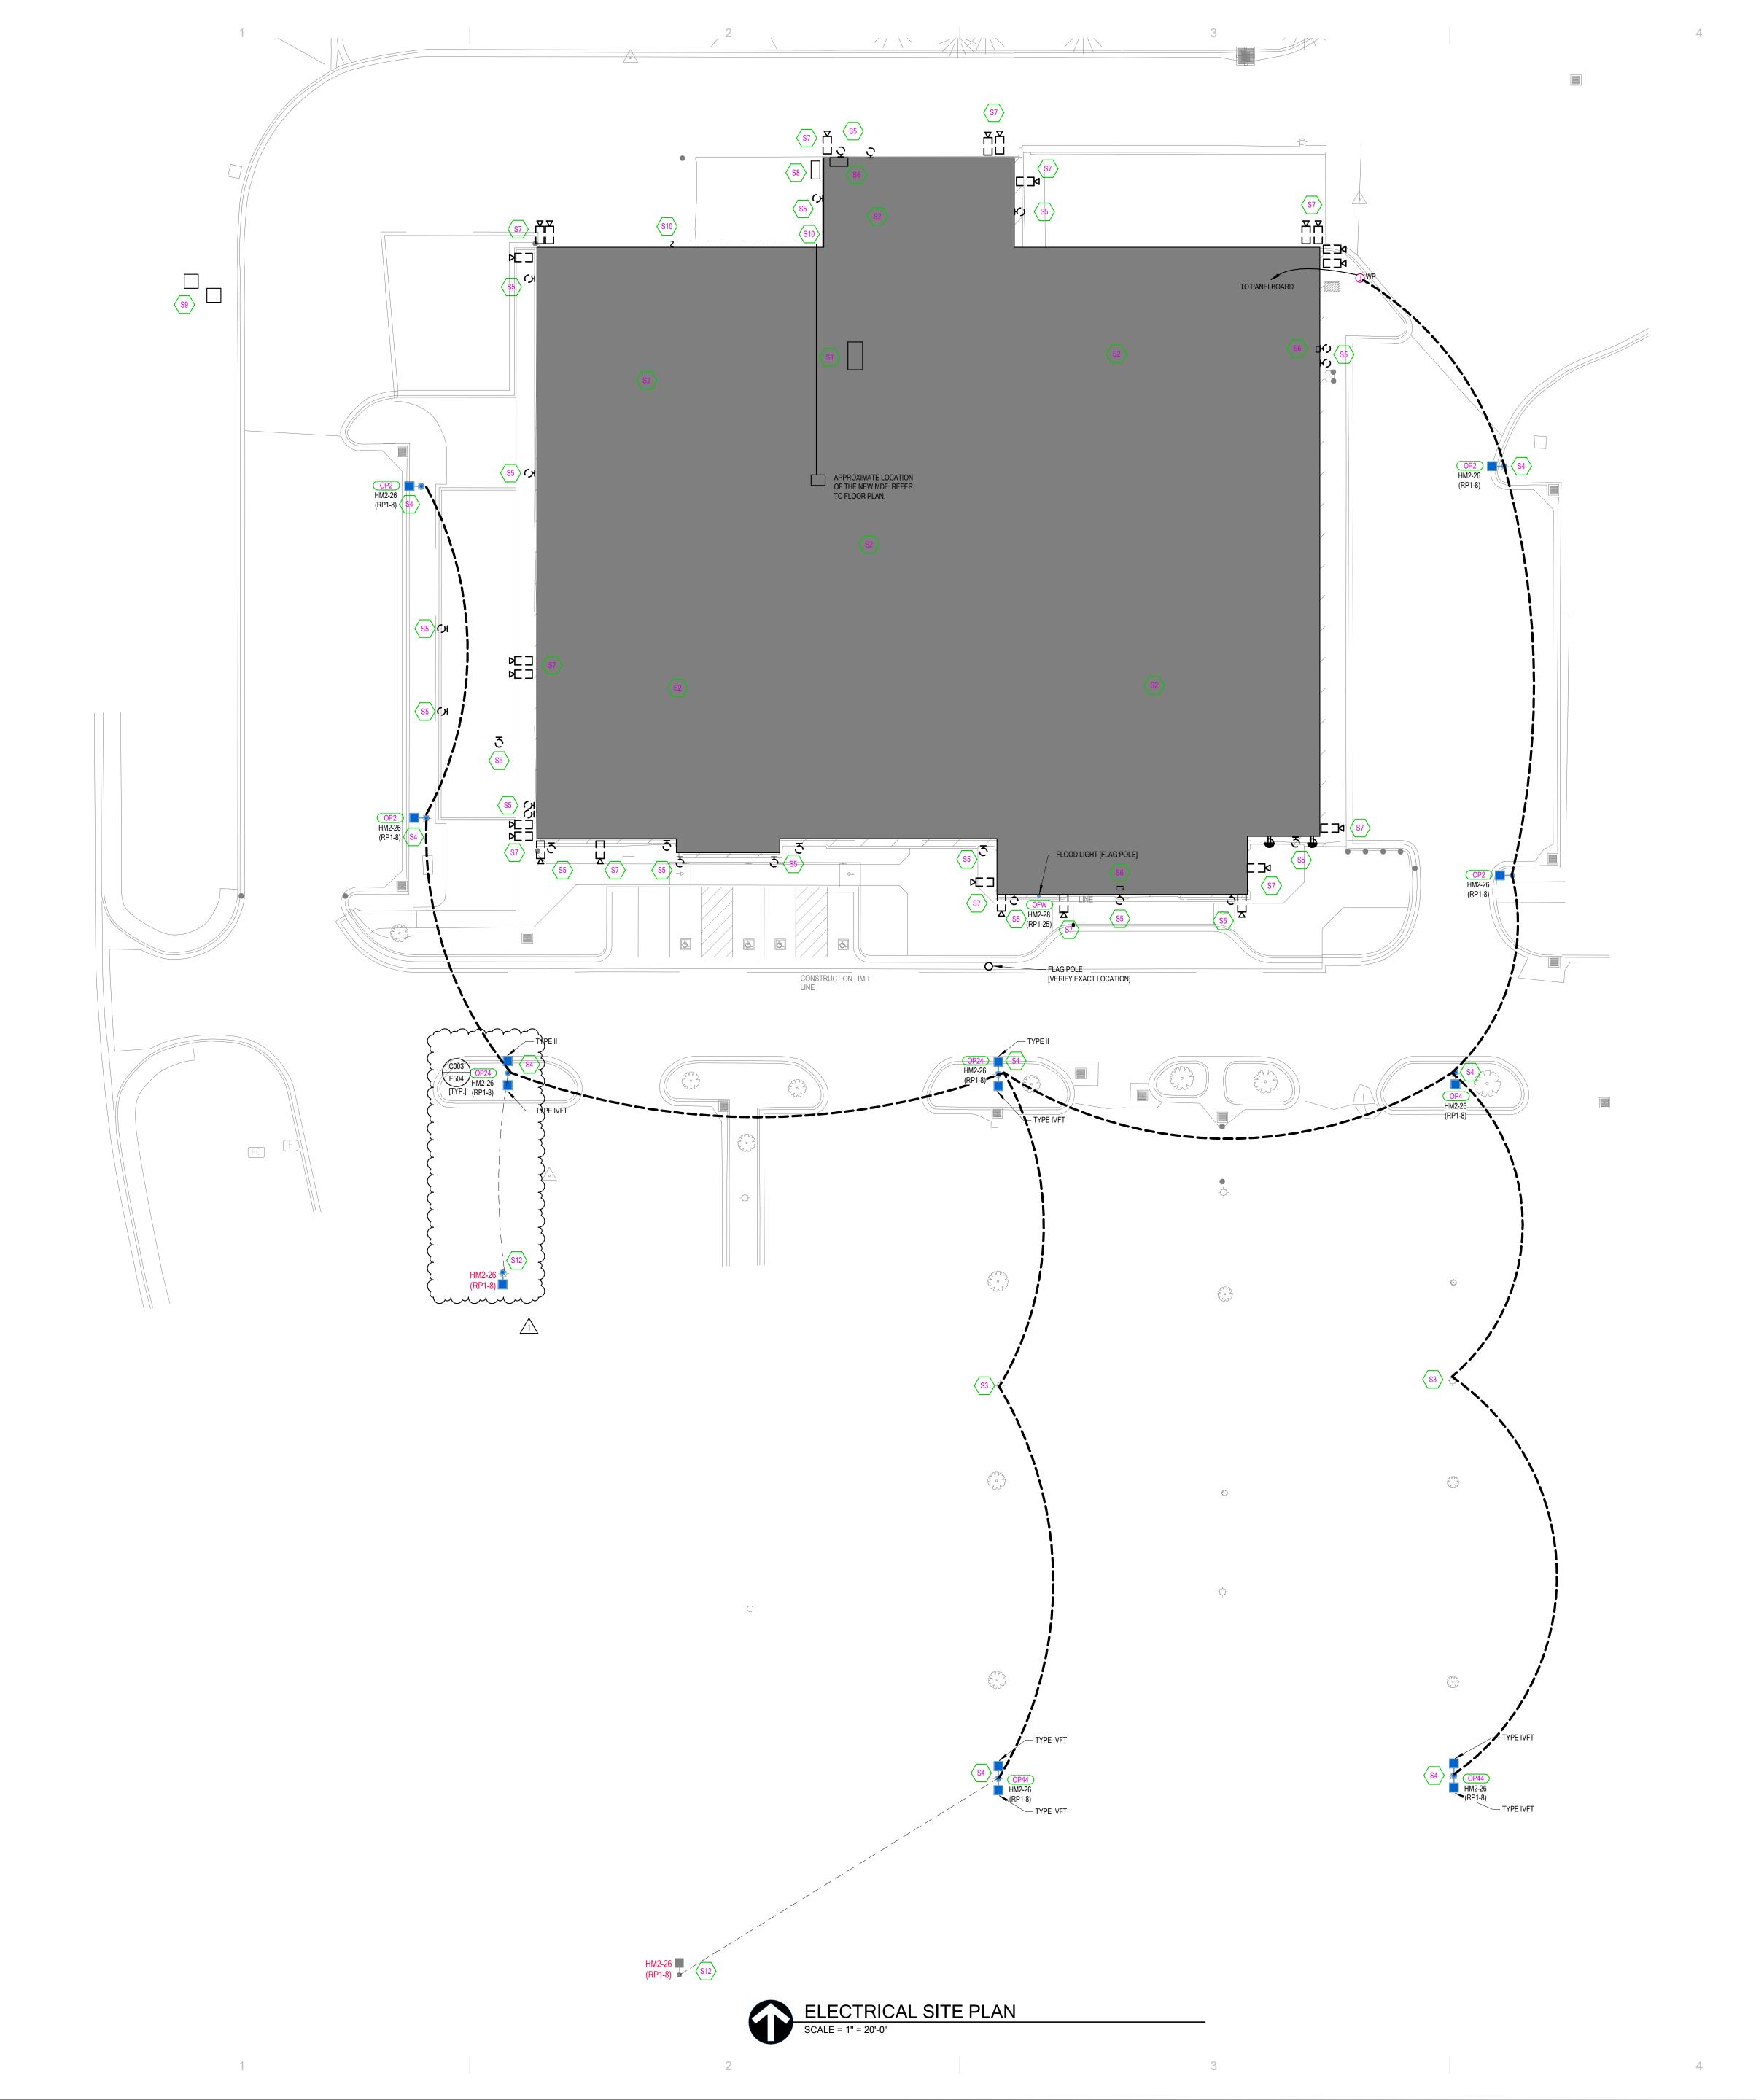

# SITE DEMOLITION GENERAL NOTES

- 1. DIVISION 26 SHALL VISIT THE SITE PRIOR TO BIDDING. BIDS SHALL SERVE AS EVIDENCE OF KNOWLEDGE OF EXISTING CONDITIONS. BIDDERS SHALL EXAMINE THE SITE AND THE COMPLETE SET OF PLANS AND SPECIFICATIONS COVERING THE ENTIRE PROJECT. THEY SHALL BECOME FULLY CONVERSANT WITH THE TYPE OF GENERAL CONSTRUCTIONS AS WELL AS ALL PERTINENT FACTS AFFECTING THE COST OF CARRYING OUT THE WORK THEY WILL CONTRACT TO PERFORM. DIVISION 26 SHALL COORDINATE PROJECT PHASING WITH THE GENERAL CONTRACTOR AND BID AND PERFORM RESPONSIBILITIES FOR THIS PROJECT TO CONTRACT EXPECTATIONS.
- DIVISION 26 SHALL CONFIRM EXACT LOCATION OF EXISTING AND NEW EQUIPMENT WITH OWNERS. ROUGH-IN LOCATIONS ARE DIAGRAMMATICALLY SHOWN ON THE DRAWINGS. EXISTING ELECTRICAL FIXTURES, DEVICES, EQUIPMENT, CIRCUITING AND/OR CONDITIONS ARE NOT SPECIFIED UNLESS NOTED ON DRAWINGS. FINAL ROUTING OF THE CONDUITS, CIRCUITING, AND CABLING SHALL BE DETERMINED BY THE CONTRACTOR AND CLOSELY COORDINATED WITH OWNER. ALL EXISTING CONDITIONS MUST BE VERIFIED WITHOUT EXCEPTION.
   DIVISION 26 SHALL BLUE STAKE THE AREA OF NEW CONSTRUCTION PRIOR TO EXCAVATION FOR FOOTINGS, ETC. IDENTIFY BURIED ELECTRICAL SYSTEMS(UTILITIES, POWER, COMMUNICATIONS, ETC.) AND COORDINATE

PART OF THIS CONTRACT.

CONTRACTOR TO CLOSELY COORDINATE ALL NEW AND EXISTING DEVICE LOCATIONS WITH CIVIL DRAWINGS. CONTRACTOR TO VERIFY ALL FINAL GRADE REQUIREMENTS WITH CIVIL DRAWINGS.

LOCATIONS WITH THE GENERAL CONTRACTOR. IF EXISTING ELECTRICAL SYSTEMS ARE DISTURBED (POWER.

AUXILIARY, ETC.) E.C. SHALL MAKE NECESSARY REPAIRS (AS APPROVED BY DISTRICT REPRESENTATIVE) AS

- 5. COORDINATE DEMOLITION AND PROJECT PHASING REQUIREMENTS WITH THE ENTIRE CONSTRUCTION SET AND GENERAL CONTRACTOR. PROVIDE SELECT DEMOLITION OF ELECTRICAL APPARATUSES IN AREAS SHOWN FOR DEMOLITION. MAKE DEMOLITION ARES SAFE AS REQUIRED. LEAVE ALL EXISTING EQUIPMENT IN PORTIONS OF THE BUILDING, SITE, AND CAMPUS NOT BEING REMODELED AND AREAS NOT YET DEMOLISHED IN WORKING.
- DURING DEMOLITION AND NEW CONSTRUCTION, THE CONTINUATION OF BUILDING SYSTEMS MAY BE NECESSARY. TRACE AND IDENTIFY EXISTING ELECTRICAL SYSTEM (POWER, LIGHTING, FIRE ALARM AND SECURITY) WIRING IN AREAS PRIOR TO DEMOLITION. ELECTRICAL CONTRACTOR SHALL DISCONNECT ALL NECESSARY EQUIPMENT TO MAKE IT SAFE FOR DEMOLITION. WHERE LIVE CIRCUITS OR FEEDERS PASS THROUGH A REMODEL AREA, CONTRACTOR SHALL MAINTAIN ELECTRIC CONTINUITY TO AND PROTECT BRANCH CIRCUITS AND/OR FEEDERS PASSING THROUGH. WHERE FEEDERS AND/OR BRANCH CIRCUITS FEED BOTH LOADS IN AREMODELED AREA AND OUTSIDE OF A REMODELED AREA, CONTRACTOR SHALL DISCONNECT AND REMOVE PORTIONS OF THE ELECTRICAL BRANCH CIRCUITS AND/OR FEEDERS WITHIN THE REMODELED AREA AND REWORK BRANCH CIRCUITS AND/OR FEEDERS TO MAINTAIN ELECTRICAL CONTINUITY TO LOADS OUTSIDE OF THE REMODELED AREA.
- DEVICES & EQUIPMENT TO BE DEMOLISHED SHALL BE REMOVED, INCLUDING ALL RELATED CONDUCTORS, RACEWAY, JUNCTION & SPLICE BOXES UP TO THE PANELBOARD/SWITCHBOARD. ALL CONDUITS AND BOXES THAT ARE SURFACE MOUNTED AND NO LONGER REQUIRE ACTIVE CIRCUITS SHALL BE COMPLETELY REMOVED. DEVICES TO BE REMOVED ON DRY WALL OR PLASTER TYPE WALLS THAT ARE TO REMAIN SHALL HAVE THE WALL SURFACE PATCHED TO MATCH THE EXISTING FINISH. THE CONTRACTOR SHALL IDENTIFY ALL DEMOLISHED AND ABANDONED BRANCH CIRCUITS. THESE SHALL BE NOTED AS SPARE ON PANELBOARD SCHEDULES. THIS INCLUDES IDENTIFYING EXISTING ABANDONED AND SPARE CIRCUITS THAT ARE CURRENTLY IDENTIFIED AS USED. THE CONTRACTOR SHALL FURNISH NEW TYPED DIRECTORIES FOR ALL PANELBOARDS.
- 3. THE OWNER HAS THE RIGHT TO RETAIN ALL SALVAGEABLE MATERIAL. ANY MATERIAL THE OWNER CHOOSES NOT TO ACCEPT SHALL BE REMOVED FROM THE SITE AND DISPOSED OF BY THE CONTRACTOR.
- 9. FULLY COORDINATE MECHANICAL EQUIPMENT ELECTRICAL CONNECTION REMOVAL AND RELOCATION WITH THE MECHANICAL CONTRACTOR. REFER TO ARCHITECTURAL, STRUCTURAL, MECHANICAL, PLUMBING DEMOLITION DRAWINGS FOR ADDITIONAL DEMOLITION INFORMATION.
- CLOSELY COORDINATE ANY REQUIRED POWER SHUTDOWNS WITH GENERAL, HEAD CUSTODIAN, AND OWNER.
   MAINTAIN EXISTING UTILITY SERVICES FOR EXISTING FACILITIES AS REQUIRED DURING THE DIFFERENT PHASES OR AS OTHERWISE NOTED. COORDINATE REQUIRED DISRUPTION OF THESE SERVICES WITH OWNER PRIOR TO DISCONNECTING. PROVIDE TEMPORARY UTILITY SERVICES TO KEEP FACILITIES IN OPERATION DURING UTILITY RELOCATION INCLUDING BUT NOT LIMITED TO FIRE WATCHES, ELECTRICAL GENERATORS, FTC.
- 2. ELECTRICAL UTILITY SERVICE FROM SPANISH FORK CITY POWER (SFCP) HAS BEEN GENERALLY COORDINATED AND GENERAL DIRECTION GIVEN HEREIN. DIVISION 26 RESPONSIBLE TO COMPLETELY COORDINATE THE EXACT PATHWAYS AND REQUIREMENTS WITH SFCP PRIOR TO ROUGH-IN. PROVIDE FIBERGLASS LONG RADIUS SWEEPS FOR ALL SFCP CONDUITS. COORDINATE ALL ROUGH-IN AND INSTALLATION REQUIREMENTS WITH LATEST SFCP ELECTRICAL SERVICE REQUIREMENTS AND CONTACT PERSON PROVIDED ON PLANS.
- VERIFY ALL EQUIPMENT LOCATIONS ON AND OFF THE SITE NECESSARY FOR SERVICE CONNECTION.
   TELCO UTILITY SERVICE FROM SPANISH FORK CITY NETWORK (SFCN) HAS BEEN GENERALLY COORDINATED AND GENERAL DIRECTION GIVEN HEREIN. DIVISION 26 RESPONSIBLE TO COMPLETELY COORDINATE THE EXACT PATHWAYS AND REQUIREMENTS WITH PROVIDERS AND OWNER PRIOR TO ROUGH-IN. PROVIDE FIBERGLASS LONG RADIUS SWEEPS FOR ALL CONDUITS. COORDINATE ALL ROUGH-IN AND INSTALLATION REQUIREMENTS WITH CONTACT PERSON PROVIDED ON PLANS. VERIFY ALL EQUIPMENT LOCATIONS ON AND OFF THE SITE NECESSARY FOR SERVICE CONNECTION.
- 15. TRENCHING AND BACKFILL: LOCATE AND PROTECT EXISTING UTILITIES AND OTHER UNDERGROUND WORK IN A MANNER WHICH WILL ENSURE THAT NO DAMAGE OR SERVICE INTERRUPTIONS WILL RESULT FROM EXCAVATING AND BACKFILLING. PERFORM EXCAVATION IN A MANNER WHICH PROTECTS WALLS, FOOTINGS, AND OTHER STRUCTURAL MEMBERS FROM BEING DISTURBED OR DAMAGED IN ANY WAY. BURIAL DEPTHS MUST COMPLY WITH NEC SECTION 300-5 (OR STATE OF UTAH REQUIREMENTS, WHICHEVER IS MORE STRINGENT), UNLESS NOTED OTHERWISE. PATCH AND REPAIR ROADS, PARKING AREAS, SIDEWALKS, CURBS, OTHER PAVED AREAS, PLANTING AND ANY OTHER DISTURBED AREAS CAUSED BY THE ELECTRICAL CONTRACTOR DURING CONSTRUCTION.
- 6. BORING, TRENCHING, ASPHALT CUTTING AND PATCH WORK BY DIVISION 26. ANY CONCRETE THAT NEEDS TO BE REMOVED TO COMPLETE WORK WILL BE THE RESPONSIBILITY OF DIVISION 26. SCHEDULING OF THE TRENCHING SHALL BE COORDINATED WITH OTHER TRADES AND APPROVED BY THE OWNER.

# SHEET KEYNOTES

- DISCONNECT EXISTING ELECTRICAL SWITCHGEAR. AFTER THE DEMO CONTRACTOR HAS REMOVED THE GEAR REMOVE THE CONDUCTORS AND CUT THE CONDUITS OFF FLUSH.
- THE INTENT OF THE CONTRACT IS TO DEMOLISH ALL EXISTING ELECTRICAL INSTALLATION. EXISTING RACEWAYS MAY BE REUSED IF THEY MEET THE INTENT OF THE SPECIFICATIONS. COORDINATE WITH THE DEMOLITION CONTRACTOR TO PRESERVE ANY DESIRED RACEWAYS.
- S3 AFTER LIGHT POLE BASE IS DELETED EXTEND AND PATCH THE EXISTING CONDUITS AS NECESSARY TO MAINTAIN THE CONDUIT RUNS FOR NEW CIRCUITING.
- PROVIDE A NEW LIGHT POLE, FIXTURE AND BASE IN APPROXIMATELY THE SAME LOCATION AS THE EXISTING AND EXTEND THE CONDUIT INTO THE POLE BASE AS REQUIRED. PROVIDE NEW CIRCUITS AS INDICATED.
- S5 REMOVE EXISTING EXTERIOR LIGHT FIXTURE.
- S6 REMOVE EXTERIOR LIGHT EMERGENCY BATTERY PACK.
- S7 REMOVE EXISTING EXTERIOR CAMERA.
- S8 DISCONNECT AND REMOVE EXISTING ELECTRICAL SERVICE ENTRANCE METERING AND MAIN SWITCH.
  COORDINATE AS REQUIRED WITH ROCKY MOUNTAIN POWER FOR ALL REQUIREMENTS. MAINTAIN EXISTING
- S9 MAINTAIN EXISTING COMMUNICATIONS GROUND BOXES.
- S10 LOCATE THE LOCATION OF THE EXISTING 4" CONDUIT RUN FROM THE COMMUNICATIONS BOXES INTO THE BUILDING. EXTEND 4" CONDUIT TO THE NEW LOCATION AND RISE UP THE EXTERIOR WALL AND STUB INTO
- THE CEILING SPACE. CONTINUE 4" CONDUIT TO THE MDF ROOM FOR COMMUNICATIONS SERVICE. PROVIDE A NEW PULL STRING FROM THE COMMUNICATIONS BOXES, VERIFY THE CORRECT BOX, TO THE MDF ROOM.
- MAINTAIN EXISTING LIGHT POLE AT THE CORNER OF THE PROPERTY (VERIFY EXACT LOCATION). RUN NEW CONDUIT AND WIRE AS REQUIRED FROM THE NEW POLE LOCATION AND RECONNECT AS REQUIRED TO MAINTAIN POWER TO THE EXISTING POLE.



MHTN Architects, Inc. 280 South 400 West Suite 250 Salt Lake City, Utah 84101 Telephone (801) 595-6700 www.mhtn.com



4225 Lake Park Blvd, Suite 275
West Valley City, UT 84120
P: 801.532.2196
F: 801.532.2305

www.bnaconsulting.com

ORDAN LEARNING CENT

©2023 MHTN ARCHITECTS, INC.

Confidentiality Notice:
This document is intended for use on the Project identified herein by individuals and companies involved in the design, permitting, bidding and construction of the Project. MHTN Architects, Inc. grants limited rights to distribute and reproduce this document for this express purpose only. Distribution, printing or copying this document for purposes other than those indicated is strictly

prohibited. If a digital copy of this document is received in error, please delete it.



мнти ргојест по.2024528	
Original drawing is 30 x 42. Do not scale contents of	t

Original drawing is 30 x 42. Do not scale contents of this drawing.

REVISIONS
CONTRACTOR TO VERIFY DRAWINGS IN FIELD USE REFLECT

 NO. △
 DATE
 DESCRIPTION

 1
 9/6/24
 Addendum #1


CONSTRUCTION DOCUMENTS AUGUST 29, 2024

ELECTRICAL SITE PLAN

SHEET NUMBER

**KEY PLAN** 

E101

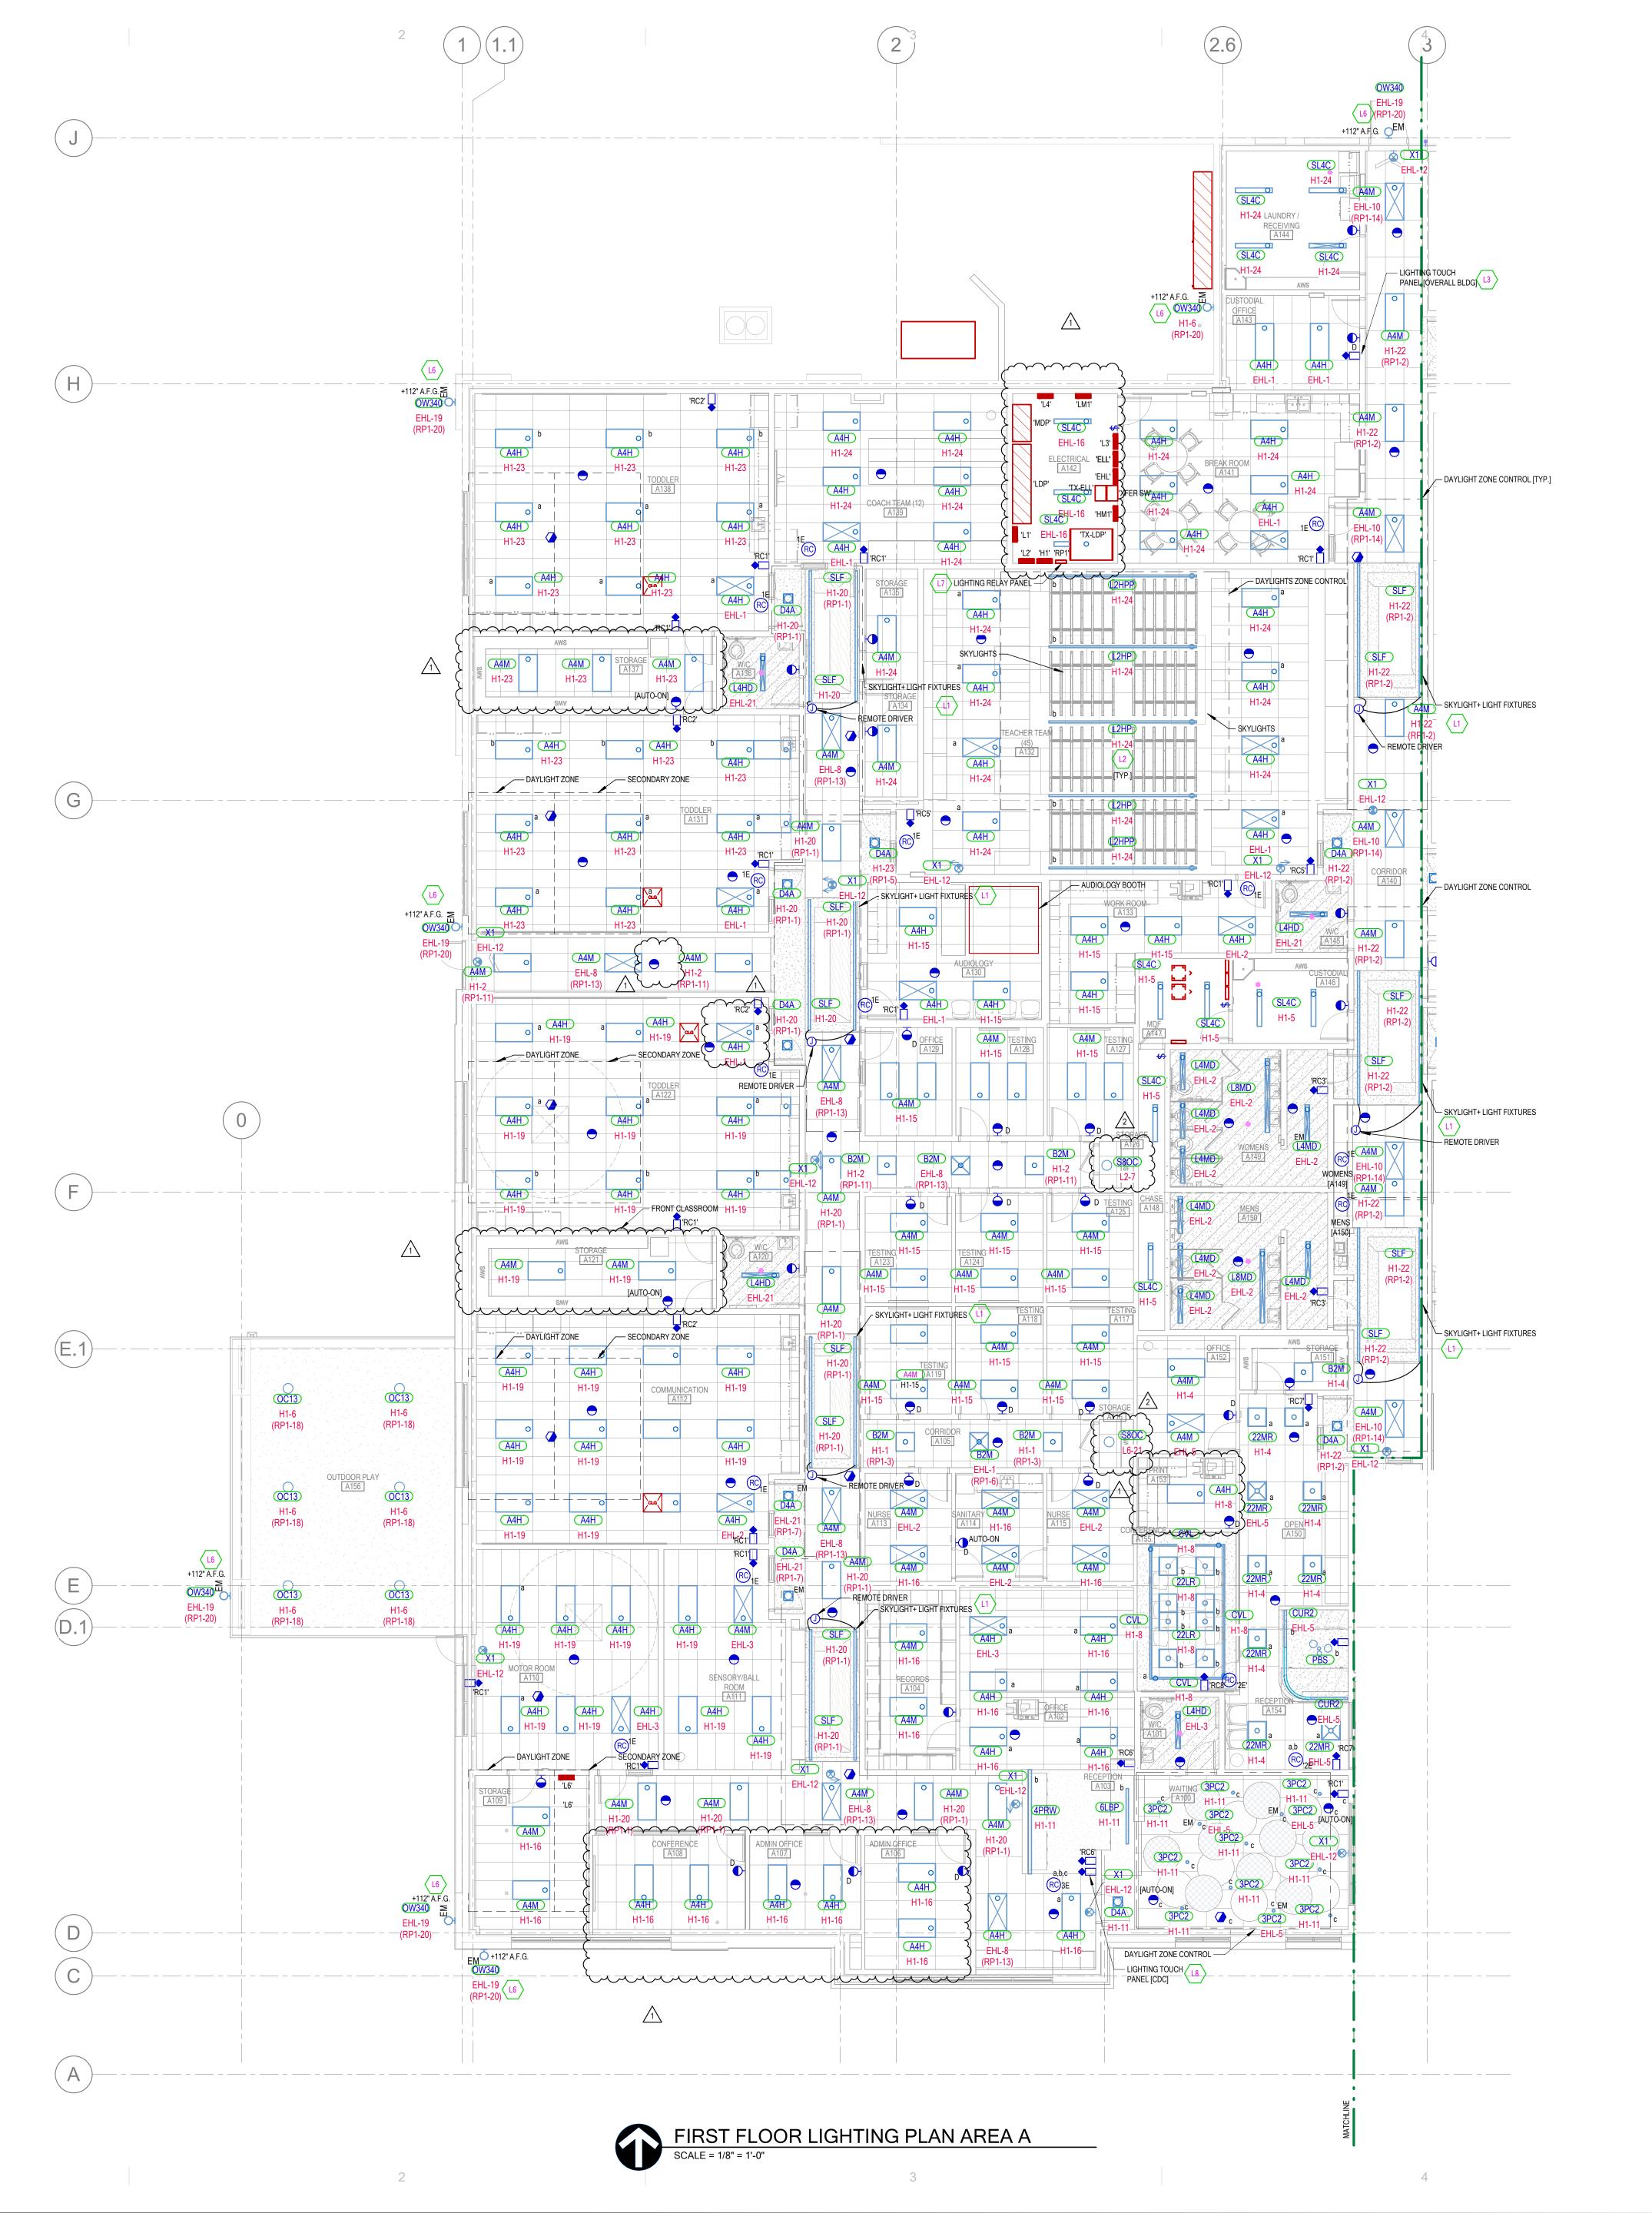

# LIGHTING GENERAL SHEET NOTES

1. DEVICE HEIGHTS SHOWN FOR REFERENCE ONLY. CONTRACTOR TO VERIFY ALL ROUGH- IN ELEVATION HEIGHTS WITH MILLWORK SHOP DRAWINGS PRIOR TO ROUGH-IN. ROUGH- IN DEVICES 6" ABOVE

- DESKTOPS, COUNTERS, ETC.

  2. REFER TO ARCHITECTURAL REFLECTED CEILING PLANS FOR ALL FIXTURE LOCATIONS WITHIN A CEILING OR CEILING COUNTERS, WITHOUT CEILINGS, EIXTURE LOCATIONS ARE DIAGRAMMATIC, THE INTENT
- OR CEILING GRID. FOR AREAS WITHOUT CEILINGS, FIXTURE LOCATIONS WITHIN A CEILING OR CEILING GRID. FOR AREAS WITHOUT CEILINGS, FIXTURE LOCATIONS ARE DIAGRAMMATIC. THE INTENT IS TO ALIGN, CENTER, OR SPACE FIXTURES BETWEEN ARCHITECTURAL AND STRUCTURAL ELEMENTS. CONTRACTOR TO PAINT EXPOSED RACEWAY TO MATCH ADJACENT SURFACES.
- 3. FIELD VERIFY EXACT FIXTURE LENGTHS FOR CONTINUOUS ILLUMINATION FOR COVES AND LINEAR RUNS. PROVIDE CONTINUOUS ILLUMINATION WITH NO MORE THAN A 1" GAP BETWEEN THE END OF THE EDGE OF THE WALL/CEILING AND THE FIXTURE.
- ELECTRICAL CONTRACTOR TO COORDINATE WITH MECHANICAL CONTRACTOR FOR PLACEMENT OF FIXTURES WITHIN MECHANICAL ROOMS.
- ALL ROOM CONTROLLERS AND/OR POWER PACKS SHALL BE INSTALLED IN THE CEILING SPACE DIRECTLY ABOVE THE ENTRY DOOR TO THE SPACE IT IS CONTROLLING.
- ALL COVE AND SKYLIGHTS MUST BE COORDINATED WITH ARCHITECTURAL DETAILS AND GC FOR EXACT LENGTHS.

  PROVIDE UNSWITCHED NORMAL CIRCUIT HOT LEG TO ALL EMERGENCY POWER CONTROL DEVICES FOR
- 8. PROVIDE UNSWITCHED HOT AHEAD OF RELAY, OCCUPANCY SENSOR, OR SWITCH TO ALL EXIT SIGNS.9. IF SHOWN, SUBSCRIPT NEAR LIGHT FIXTURES INDICATES CONTROL INTENT. PROVIDE LIGHTING

PROPER POWER SENSING.

- 9. IF SHOWN, SUBSCRIPT NEAR LIGHT FIXTURES INDICATES CONTROL INTENT. PROVIDE LIGHTING CONTROLLERS WITH THE REQUIRED NUMBER OF RELAYS/DIMMERS. PROVIDE ADDITIONAL RELAYS/DIMMERS FOR DAYLIGHT ZONES AS NEEDED.
- PROVIDE 0-10V DIMMER CONDUCTORS FOR ALL AREAS AND/OR ROOMS WHERE 0-10V DIMMING IS INDICATED BY THE RELAY PANEL SCHEDULE, WALL STATION CONTROL SEQUENCE., OR REQUIRED BY
- ALL 277V LIGHTING CIRCUITS TERMINATING AT LIGHTING CONTROL PANELS SHALL HAVE A MINIMUM LENGTH OF 20 FEET BETWEEN LIGHTING CONTROL PANEL AND BRANCH LIGHTING PANEL.
- 12. CAREFULLY COORDINATE FIXTURE PLACEMENT WITHIN BAFFLED CEILINGS. PENDANT MOUNTED FIXTURE SHALL BE MOUNTED AT THE SAME ELEVATION AS BAFFLES. COORDINATE WITH ARCHITECTURAL RCP AND DETAILS PRIOR TO ROUGH-IN.
- PROVIDE CONDUIT FROM DEVICE TO DEVICE IN OPEN AND/OR EXPOSED CEILINGS. CEILINGS WITH CLOUDS ARE CONSIDERED OPEN/EXPOSED CEILING. NO EXPOSED CABLES SHALL BE SEEN FROM
- I. CAREFULLY COORDINATE FIXTURE PLACEMENT WITHIN BAFFLED CEILINGS. PENDANT MOUNTED FIXTURES SHALL BE MOUNTED AT THE SAME ELEVATION AS BAFFLES. COORDINATE WITH ARCHITECTURAL RCP AND DETAILS PRIOR TO ROUGH-IN.
- 15. PROVIDE EXTENDED RANGE DUAL TECH. OCCUPANCY SENSOR(S) AS SHOWN THROUGHOUT CORRIDORS. PROVIDE 0-10V DIMMING ON ALL CORRIDOR LIGHTING RELAYS. OCCUPANCY SENSOR SHALL DIM CORRIDOR RELAY TO 50% OUTPUT AFTER 15 MINUTES OF INACTIVITY. LOCATE OCCUPANCY SENSOR SENSOR(S) PER MANUFACTURER FOR PROPER PLACEMENT AND ADJUSTMENT OF OCCUPANCY SENSORS.

MANUFACTURER'S REPRESENTATIVE FOR DIVISION 26 LIGHTING CONTROLS SHALL BE ACCOUNTABLE

FOR THE COMPREHENSIVE LIGHTING CONTROLS PACKAGE'S FINALIZATION IN ALIGNMENT WITH THE DESIGN INTENT DEPICTED IN THE DRAWINGS AND SPECIFICATIONS AND COMPLYING WITH IECC 2021 REQUIREMENTS. THE LIGHTING REPRESENTATIVE IS REQUIRED TO DEVELOP DETAILED SHOP DRAWINGS DEMONSTRATING THE LIGHTING CONTROL SYSTEM'S TOPOLOGY AND THE ESSENTIAL CONNECTIONS NECESSARY FOR ITS PROPER FUNCTIONING, LIGHTING CONTROL DEVICES SHOWN ARE TO PROVIDE GENERAL INTENT ONLY. MANUFACTURE'S REPRESENTATIVE TO PROVIDE ALL ADDITIONAL DEVICES AND MODIFY DEVICE LOCATIONS AS REQUIRED TO MEET IECC 2021 REQUIREMENTS..

# SHEET KEYNOTES

- L1 MOUNT FIXTURE WITHIN SKYLIGHT CHANNEL WITH FIXTURES ANGLED TO MATCH ANGLE OF SKYLIGHT OPENING. REMOTE DRIVER ABOVE ACCESSIBLE CEILING AS INDICATED. EACH SKYLIGHT HAS A UNIQUE CONSTRUCTION, COORDINATE WITH ARCHITECTURAL SKYLIGHT DETAILS ON A335 FOR MORE INFORMATION. PROVIDE DAYLIGHT ZONE CONTROL REQUIREMENTS PER IECC. LOCATE DAYLIGHT SENSOR(S) PER MANUFACTURER'S RECOMMENDATION AND WHERE REQUIRED WITHIN THE SPACE FOR PROPER COVERAGE. CONTROL LIGHT FIXTURES WITHIN THE DAYLIGHT ZONE WITH DAYLIGHT SENSOR (PHOTODIODE) AND WIRE THE FIXTURES 0-10V DRIVERS ACCORDINGLY.
- L2 MOUNT FIXTURES BETWEEN BAFFLES. MATCH BAFFLE HEIGHT.
- L3 PROVIDE >7" LIGHTING TOUCH PANEL THAT IS TIED TO THE BUILDING LIGHTING RELAY PANELS THROUGHOUT THE BUILDING. PROVIDE EASY-TO-USE GUI INTERFACE. PROGRAM GUI WITH PAGES TO CONTROL AND OVERRIDE BUILDING RELAYS E.G. EXTERIOR, PARKING, CORRIDORS, ETC. RECEIVE SIGN-OFF ON SETUP AND OVERALL FUNCTIONALITY.
- FIELD VERIFY FIXTURE ELEVATION AND LOCATION WITH ARCHITECT PRIOR TO ROUGH-IN.
- PROVIDE A 48-CIRCUIT LIGHTING CONTROL PANEL RELAY WITH 120/277V/1-POLE 0-10V DIMMING RELAYS.
  LIGHTING CONTROL PANEL MUST HAVE BUILT-IN TIME SCHEDULING, PHOTOCELL,0-10V DIMMING,
  ASTRONOMICAL CLOCK, 7-DAY SCHEDULE WITH HOLIDAYS, AND PROTECTION FOR LOSS OF POWER TO
  PREVENT LOSS OF SCHEDULE. PROVIDE CONTROL CIRCUIT AS INDICATED. ADDITIONALLY, LOCATE
  PHOTOCELL ON THE NORTH SIDE OF THE BUILDING AND TIE INTO THE CONTROLLER. PROGRAM AND CREATE
  SCHEDULES PER THE LIGHTING NARRATIVE AND THE OWNER'S REQUIREMENTS.
- PROVIDE >7" LIGHTING TOUCH PANEL THAT IS TIED TO THE BUILDING LIGHTING RELAY PANELS THROUGHOUT THE CDC PORTION OF THE BUILDING. PROVIDE EASY-TO-USE GUI INTERFACE. PROGRAM GUI WITH PAGES TO CONTROL AND OVERRIDE BUILDING RELAYS E.G. EXTERIOR, PARKING, CORRIDORS, ETC. RECEIVE SIGN-OFF



MHTN Architects, Inc. 280 South 400 West Suite 250 Salt Lake City, Utah 84101 Telephone (801) 595-6700 www.mhtn.com



www.bnaconsulting.com

# JORDAN LEARNING CENTER

©2023 MHTN ARCHITECTS, INC.

Confidentiality Notice:
This document is intended for use on the Project identified herein by individuals and companies involved in the design, permitting, bidding and construction of the Project. MHTN Architects, Inc. grants limited rights to distribute and reproduce this document for this express purpose only. Distribution, printing or copying this document for purposes other than those indicated is strictly prohibited. If a digital copy of this document is received in error, please delete it.



мнти реојест no. 2024528

Original drawing is 30 x 42. Do not scale contents of this drawing.

REVISIONS
CONTRACTOR TO VERIFY DRAWINGS IN FIELD USE REFLECT LAST REVISION DATE.

NO. DATE DESCRIPTION
1 9/6/24 Addendum #1

1 9/6/24 Addendum #1 2 09/13/2024 Addendum #2

CONSTRUCTION DOCUMENTS
AUGUST 29, 2024

FIRST FLOOR LIGHTING PLAN AREA A

SHEET NUMBER

**KEY PLAN** 

E211A



# LIGHTING GENERAL SHEET NOTES

- DEVICE HEIGHTS SHOWN FOR REFERENCE ONLY. CONTRACTOR TO VERIFY ALL ROUGH- IN ELEVATION HEIGHTS WITH MILLWORK SHOP DRAWINGS PRIOR TO ROUGH-IN. ROUGH- IN DEVICES 6" ABOVE
- DESKTOPS, COUNTERS, ETC.

  2. REFER TO ARCHITECTURAL REFLECTED CEILING PLANS FOR ALL FIXTURE LOCATIONS WITHIN A CEILING OR CEILING GRID. FOR AREAS WITHOUT CEILINGS, FIXTURE LOCATIONS ARE DIAGRAMMATIC. THE INTENT IS TO ALIGN, CENTER, OR SPACE FIXTURES BETWEEN ARCHITECTURAL AND STRUCTURAL ELEMENTS.
- CONTRACTOR TO PAINT EXPOSED RACEWAY TO MATCH ADJACENT SURFACES.

  FIELD VERIFY EXACT FIXTURE LENGTHS FOR CONTINUOUS ILLUMINATION FOR COVES AND LINEAR RUNS.
  PROVIDE CONTINUOUS ILLUMINATION WITH NO MORE THAN A 1" GAP BETWEEN THE END OF THE EDGE OF THE WALL/CEILING AND THE FIXTURE.
- ELECTRICAL CONTRACTOR TO COORDINATE WITH MECHANICAL CONTRACTOR FOR PLACEMENT OF FIXTURES WITHIN MECHANICAL ROOMS.
- ALL ROOM CONTROLLERS AND/OR POWER PACKS SHALL BE INSTALLED IN THE CEILING SPACE DIRECTLY ABOVE THE ENTRY DOOR TO THE SPACE IT IS CONTROLLING.
- ALL COVE AND SKYLIGHTS MUST BE COORDINATED WITH ARCHITECTURAL DETAILS AND GC FOR EXACT
- PROVIDE UNSWITCHED NORMAL CIRCUIT HOT LEG TO ALL EMERGENCY POWER CONTROL DEVICES FOR PROPER POWER SENSING.
- PROVIDE UNSWITCHED HOT AHEAD OF RELAY, OCCUPANCY SENSOR, OR SWITCH TO ALL EXIT SIGNS.
- 9. IF SHOWN, SUBSCRIPT NEAR LIGHT FIXTURES INDICATES CONTROL INTENT. PROVIDE LIGHTING CONTROLLERS WITH THE REQUIRED NUMBER OF RELAYS/DIMMERS. PROVIDE ADDITIONAL
- RELAYS/DIMMERS FOR DAYLIGHT ZONES AS NEEDED.

  D. PROVIDE 0-10V DIMMER CONDUCTORS FOR ALL AREAS AND/OR ROOMS WHERE 0-10V DIMMING IS INDICATED BY THE RELAY PANEL SCHEDULE, WALL STATION CONTROL SEQUENCE., OR REQUIRED BY
- ALL 277V LIGHTING CIRCUITS TERMINATING AT LIGHTING CONTROL PANELS SHALL HAVE A MINIMUM LENGTH OF 20 FEET BETWEEN LIGHTING CONTROL PANEL AND BRANCH LIGHTING PANEL.
- 2. CAREFULLY COORDINATE FIXTURE PLACEMENT WITHIN BAFFLED CEILINGS. PENDANT MOUNTED FIXTURE SHALL BE MOUNTED AT THE SAME ELEVATION AS BAFFLES. COORDINATE WITH ARCHITECTURAL RCP AND DETAILS PRIOR TO ROUGH-IN.
- PROVIDE CONDUIT FROM DEVICE TO DEVICE IN OPEN AND/OR EXPOSED CEILINGS. CEILINGS WITH CLOUDS ARE CONSIDERED OPEN/EXPOSED CEILING. NO EXPOSED CABLES SHALL BE SEEN FROM BELOW
- I. CAREFULLY COORDINATE FIXTURE PLACEMENT WITHIN BAFFLED CEILINGS. PENDANT MOUNTED FIXTURES SHALL BE MOUNTED AT THE SAME ELEVATION AS BAFFLES. COORDINATE WITH ARCHITECTURAL RCP AND DETAILS PRIOR TO ROUGH-IN.
- 5. PROVIDE EXTENDED RANGE DUAL TECH. OCCUPANCY SENSOR(S) AS SHOWN THROUGHOUT CORRIDORS. PROVIDE 0-10V DIMMING ON ALL CORRIDOR LIGHTING RELAYS. OCCUPANCY SENSOR SHALL DIM CORRIDOR RELAY TO 50% OUTPUT AFTER 15 MINUTES OF INACTIVITY. LOCATE OCCUPANCY SENSOR SENSOR(S) PER MANUFACTURER FOR PROPER PLACEMENT AND ADJUSTMENT OF OCCUPANCY SENSORS.
- 16. MANUFACTURER'S REPRESENTATIVE FOR DIVISION 26 LIGHTING CONTROLS SHALL BE ACCOUNTABLE FOR THE COMPREHENSIVE LIGHTING CONTROLS PACKAGE'S FINALIZATION IN ALIGNMENT WITH THE DESIGN INTENT DEPICTED IN THE DRAWINGS AND SPECIFICATIONS AND COMPLYING WITH IECC 2021 REQUIREMENTS. THE LIGHTING REPRESENTATIVE IS REQUIRED TO DEVELOP DETAILED SHOP DRAWINGS DEMONSTRATING THE LIGHTING CONTROL SYSTEM'S TOPOLOGY AND THE ESSENTIAL CONNECTIONS NECESSARY FOR ITS PROPER FUNCTIONING, LIGHTING CONTROL DEVICES SHOWN ARE TO PROVIDE GENERAL INTENT ONLY. MANUFACTURE'S REPRESENTATIVE TO PROVIDE ALL ADDITIONAL DEVICES AND MODIFY DEVICE LOCATIONS AS REQUIRED TO MEET IECC 2021 REQUIREMENTS..

## SHEET KEYNOTE

- MOUNT FIXTURE WITHIN SKYLIGHT CHANNEL WITH FIXTURES ANGLED TO MATCH ANGLE OF SKYLIGHT OPENING. REMOTE DRIVER ABOVE ACCESSIBLE CEILING AS INDICATED. EACH SKYLIGHT HAS A UNIQUE CONSTRUCTION, COORDINATE WITH ARCHITECTURAL SKYLIGHT DETAILS ON A335 FOR MORE INFORMATION. PROVIDE DAYLIGHT ZONE CONTROL REQUIREMENTS PER IECC. LOCATE DAYLIGHT SENSOR(S) PER MANUFACTURER'S RECOMMENDATION AND WHERE REQUIRED WITHIN THE SPACE FOR PROPER COVERAGE. CONTROL LIGHT FIXTURES WITHIN THE DAYLIGHT ZONE WITH DAYLIGHT SENSOR (PHOTODIODE) AND WIRE THE FIXTURES 0-10V DRIVERS ACCORDINGLY.
- MOUNT FIXTURES BETWEEN BAFFLES. MATCH BAFFLE HEIGHT.
- MOUNT CONTINUOUS RECESSED LINEAR DIFFUSED LED FIXTURE WITHIN EXTERIOR ARCHITECTURAL CEILING STRUCTURE. COORDINATE OPENING AND MOUNTING REQUIREMENTS WITH GC, ARCHITECTURAL DRAWINGS AND CEILING DETAILS. LIGHT FIXTURE SHALL BE CONTINUOUS THROUGHOUT. FIELD VERIFY LENGTH AND PROVIDE CONTINUOUS CHANNEL AND CORNERS AS REQUIRED FOR UNINTERRUPTED LIGHT ALONG THE ENTIRE PATH. PROVIDE 0-10V WIRING AND LOCATE REMOTE 0-10V POWER SUPPLY(S) IN PLENUM RATED BOX AND IN NEARBY ACCESSIBLE CEILING. COORDINATE QUANTITY AND TYPES WITH MANUFACTURER, LABEL CABINETS AND LOCATE EQUIPMENT FOR EASY MAINTENANCE. LIGHT FIXTURE INTENSITY TO BE EVALUATED BY ARCHITECT AND ENGINEER. ADJUSTMENTS SHALL BE MADE AS REQUIRED.
- FIELD VERIFY FIXTURE ELEVATION AND LOCATION WITH ARCHITECT PRIOR TO ROUGH-IN.
- PROVIDE >7" LIGHTING TOUCH PANEL THAT IS TIED TO THE BUILDING LIGHTING RELAY PANELS THROUGHOUT THE VIRTUAL LEARNING PORTION OF THE BUILDING. PROVIDE EASY-TO-USE GUI INTERFACE. PROGRAM GUI WITH PAGES TO CONTROL AND OVERRIDE BUILDING RELAYS E.G. EXTERIOR, PARKING, CORRIDORS, ETC. RECEIVE SIGN-OFF ON SETUP AND OVERALL FUNCTIONALITY.



MHTN Architects, Inc. 280 South 400 West Suite 250 Salt Lake City, Utah 84101 Telephone (801) 595-6700 www.mhtn.com




225 Lake Park Blvd, Suite 275
West Valley City, UT 84120
P: 801.532.2196
F: 801.532.2305
www.bnaconsulting.com

H H H

JORDAN LEARNING CENTE 3706 WEST 9800 SOUTH

©2023 MHTN ARCHITECTS, INC.

Confidentiality Notice:
This document is intended for use on the Project identified herein by individuals and companies involved in the design, permitting, bidding and construction of the Project. MHTN Architects, Inc. grants limited rights to distribute and reproduce this document for this express purpose only. Distribution, printing or copying this document for purposes other than those indicated is strictly prohibited. If a digital copy of this document is received in error, please delete it.

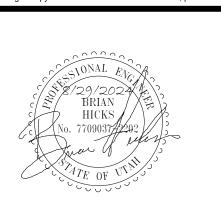

MHTN PROJECT NO. 2024528

Original drawing is 30 x 42. Do not scale contents of this drawing.

REVISIONS
CONTRACTOR TO VERIFY DRAWINGS IN FIELD USE REFLECT LAST REVISION DATE.

NO. DATE DESCRIPTION
1 9/6/24 Addendum #1

2 09/13/2024 Addendum #2

CONSTRUCTION DOCUMENTS
AUGUST 29, 2024

FIRST FLOOR LIGHTING PLAN AREA B

SHEET NUMBER

A

**KEY PLAN** 

E211B



# GENERAL POWER SHEET NOTES

COORDINATE PLACEMENT OF ELECTRICAL DEVICES WITH ARCHITECT PRIOR TO ROUGH-IN. WHERE
DEVICES ARE SHOWN IN SAME WALL SPACE, ALIGN VERTICALLY AND HORIZONTALLY. COORDINATE WITH
ARCHITECTURAL DRAWINGS, ATHLETIC SAFETY WALL PADDING AND CABINETRY DRAWINGS.

- ALL THE LOW VOLTAGE WIRE/CABLE FOR LIGHTING SENSORS, AUDIO/VISUAL EQUIPMENT, SOUND AMPLIFICATION, ETC. TO BE ROUTED THROUGH CONDUIT IN EXPOSED AND CLOUDED CEILING AREAS.
   ALL LOW VOLTAGE WIRE/CABLE FOR LIGHTING SENSORS, AUDIO/VISUAL EQUIPMENT, CLASSROOM SOUND AMPLIFICATION, ETC. TO BE PROPERLY SUPPORTED PER THE TELE/DATA SPEC. AND AT 5'-0" INTERVALS
- AMPLIFICATION, ETC. TO BE PROPERLY SUPPORTED PER THE TELE/DATA SPEC. AND AT 5'-0" INTERVALS AND TO FOLLOW BUILDING STRUCTURAL LINES. PULLING WIRE DIAGONALLY ACROSS ROOMS IS NOT ALLOWED. USING CEILING SYSTEM OR LIGHT FIXTURE SUPPORT/SEISMIC WIRES FOR SUPPORT IS NOT ALLOWED.
- PROVIDE GFCI PROTECTION ON ALL DEVICES AND EQUIPMENT PER THE NEC
  REQUIREMENTS. DEVICES SHALL BE READILY ACCESSIBLE. IF ANY OUTLET IS INSTALLED WITHIN 6 FEET OF
  OUTSIDE EDGE OF SINK, CONTRACTOR SHALL PROVIDE GFCI RECEPTACLE PER NEC, WHETHER SHOWN OR
- ALL RECEPTACLES LOCATED THROUGHOUT THE BUILDING SHALL BE TAMPER RESISTANT PER NEC 406.12.
   ELECTRICAL CONTRACTOR SHALL COORDINATE EXACT LOCATION OF ALL MECHANICAL UNITS WITH MECHANICAL CONTRACTOR. CIRCUITS TO ALL MECHANICAL EQUIPMENT SHALL BE DEDICATED UNLESS
- 7. FOR VAV POWER, PROVIDE A DEDICATED 120V/20A CIRCUIT FROM A PANEL LOCATED IN THE ELECTRICAL ROOM OF THE ASSOCIATED QUADRANT. COORDINATE EXACT LOCATION OF ALL VAV BOXES WITH MECHANICAL CONTRACTOR PRIOR TO ROUGH-IN.
- FIRE ALARM MODULES AND RELAYS AS NECESSARY FOR ALL FIRE/SMOKE DAMPERS SHOWN ON DIVISION 23 DRAWINGS. ALL FIRE/SMOKE DAMPERS SHALL HAVE A MANUAL OVERRIDE SWITCH. PROVIDE DUCT DETECTOR WITHIN 5 FEET OF EACH FIRE/SMOKE DAMPER.

  CONTRACTOR TO COORDINATE ALL LOCATIONS OF FIRE/SMOKE AND SMOKE DAMPERS WITH MECHANICAL

CONTRACTOR. CONTRACTOR TO PROVIDE POWER, MONITOR MODULES, AND RELAYS AS REQUIRED FOR A

PROVIDE 120V CIRCUIT FROM NEAREST PROVIDED CIRCUIT FOR FIRE/SMOKE DAMPER RELAYS. PROVIDE

DIVISION-26 IS RESPONSIBLE TO PROVIDE CONDUIT AND ROUGH-IN FOR ALL THERMOSTAT CONTROLS LOCATED WITHIN WALLS. COORDINATE WITH THE CONTROLS CONTRACTOR AND VERIFY EXACT LOCATION OF ALL THERMOSTATS.

# SHEET KEYNOTES

- P7 VERIFY EXACT LOCATION OF TERMINATION FOR THE AUDIOLOGY BOOTH. FEED FROM THE WALL WITH FLEX CONDUIT.
- P8 COORDINATE EXACT PLACEMENT OF THE RECEPTACLE IN THE FEATURE WALL WITH THE ARCHITECT.
- P9 VERIFY BOX LOCATIONS AND ALL TERMINATION REQUIREMENTS FOR CONNECTION TO THE ADA FUNCTION OF THE DOOR.
- P11 DRILL AND DOWEL THE NEW PAD TO THE EXISTING PAD.
- P12 LOCATE POWER, DATA, AND JUNCTION BOX FOR AV CABLING AT WALL MOUNTED PROJECTOR MOUNT. COORDINATE ROUGH-IN LOCATION CLOSELY WITH AV SUBCONTRACTOR.



MHTN Architects, Inc. 280 South 400 West Suite 250 Salt Lake City, Utah 84101 Telephone (801) 595-6700 www.mhtn.com



4225 Lake Park Blvd, Suite 275
West Valley City, UT 84120
P: 801.532.2196
F: 801.532.2305
Www.bnaconsulting.com

ORDAN LEARNING CENTER
706 WEST 9800 SOUTH

©2023 MHTN ARCHITECTS, INC.

Confidentiality Notice:
This document is intended for use on the Project identified herein by individuals and companies involved in the design, permitting, bidding and construction of the Project. MHTN Architects, Inc. grants limited rights to distribute and reproduce this document for this express purpose only. Distribution, printing or copying this document for purposes other than those indicated is strictly prohibited. If a digital copy of this document is received in error, please delete it.



мнти ркојест no. 2024528

NO.△ DATE DESCRIPTION

1 9/6/24 Addendum #1

2 09/13/2024 Addendum #2


CONSTRUCTION DOCUMENTS
AUGUST 29, 2024

FIRST FLOOR POWER PLAN -AREA A

SHEET NUMBER

**KEY PLAN** 

E311A

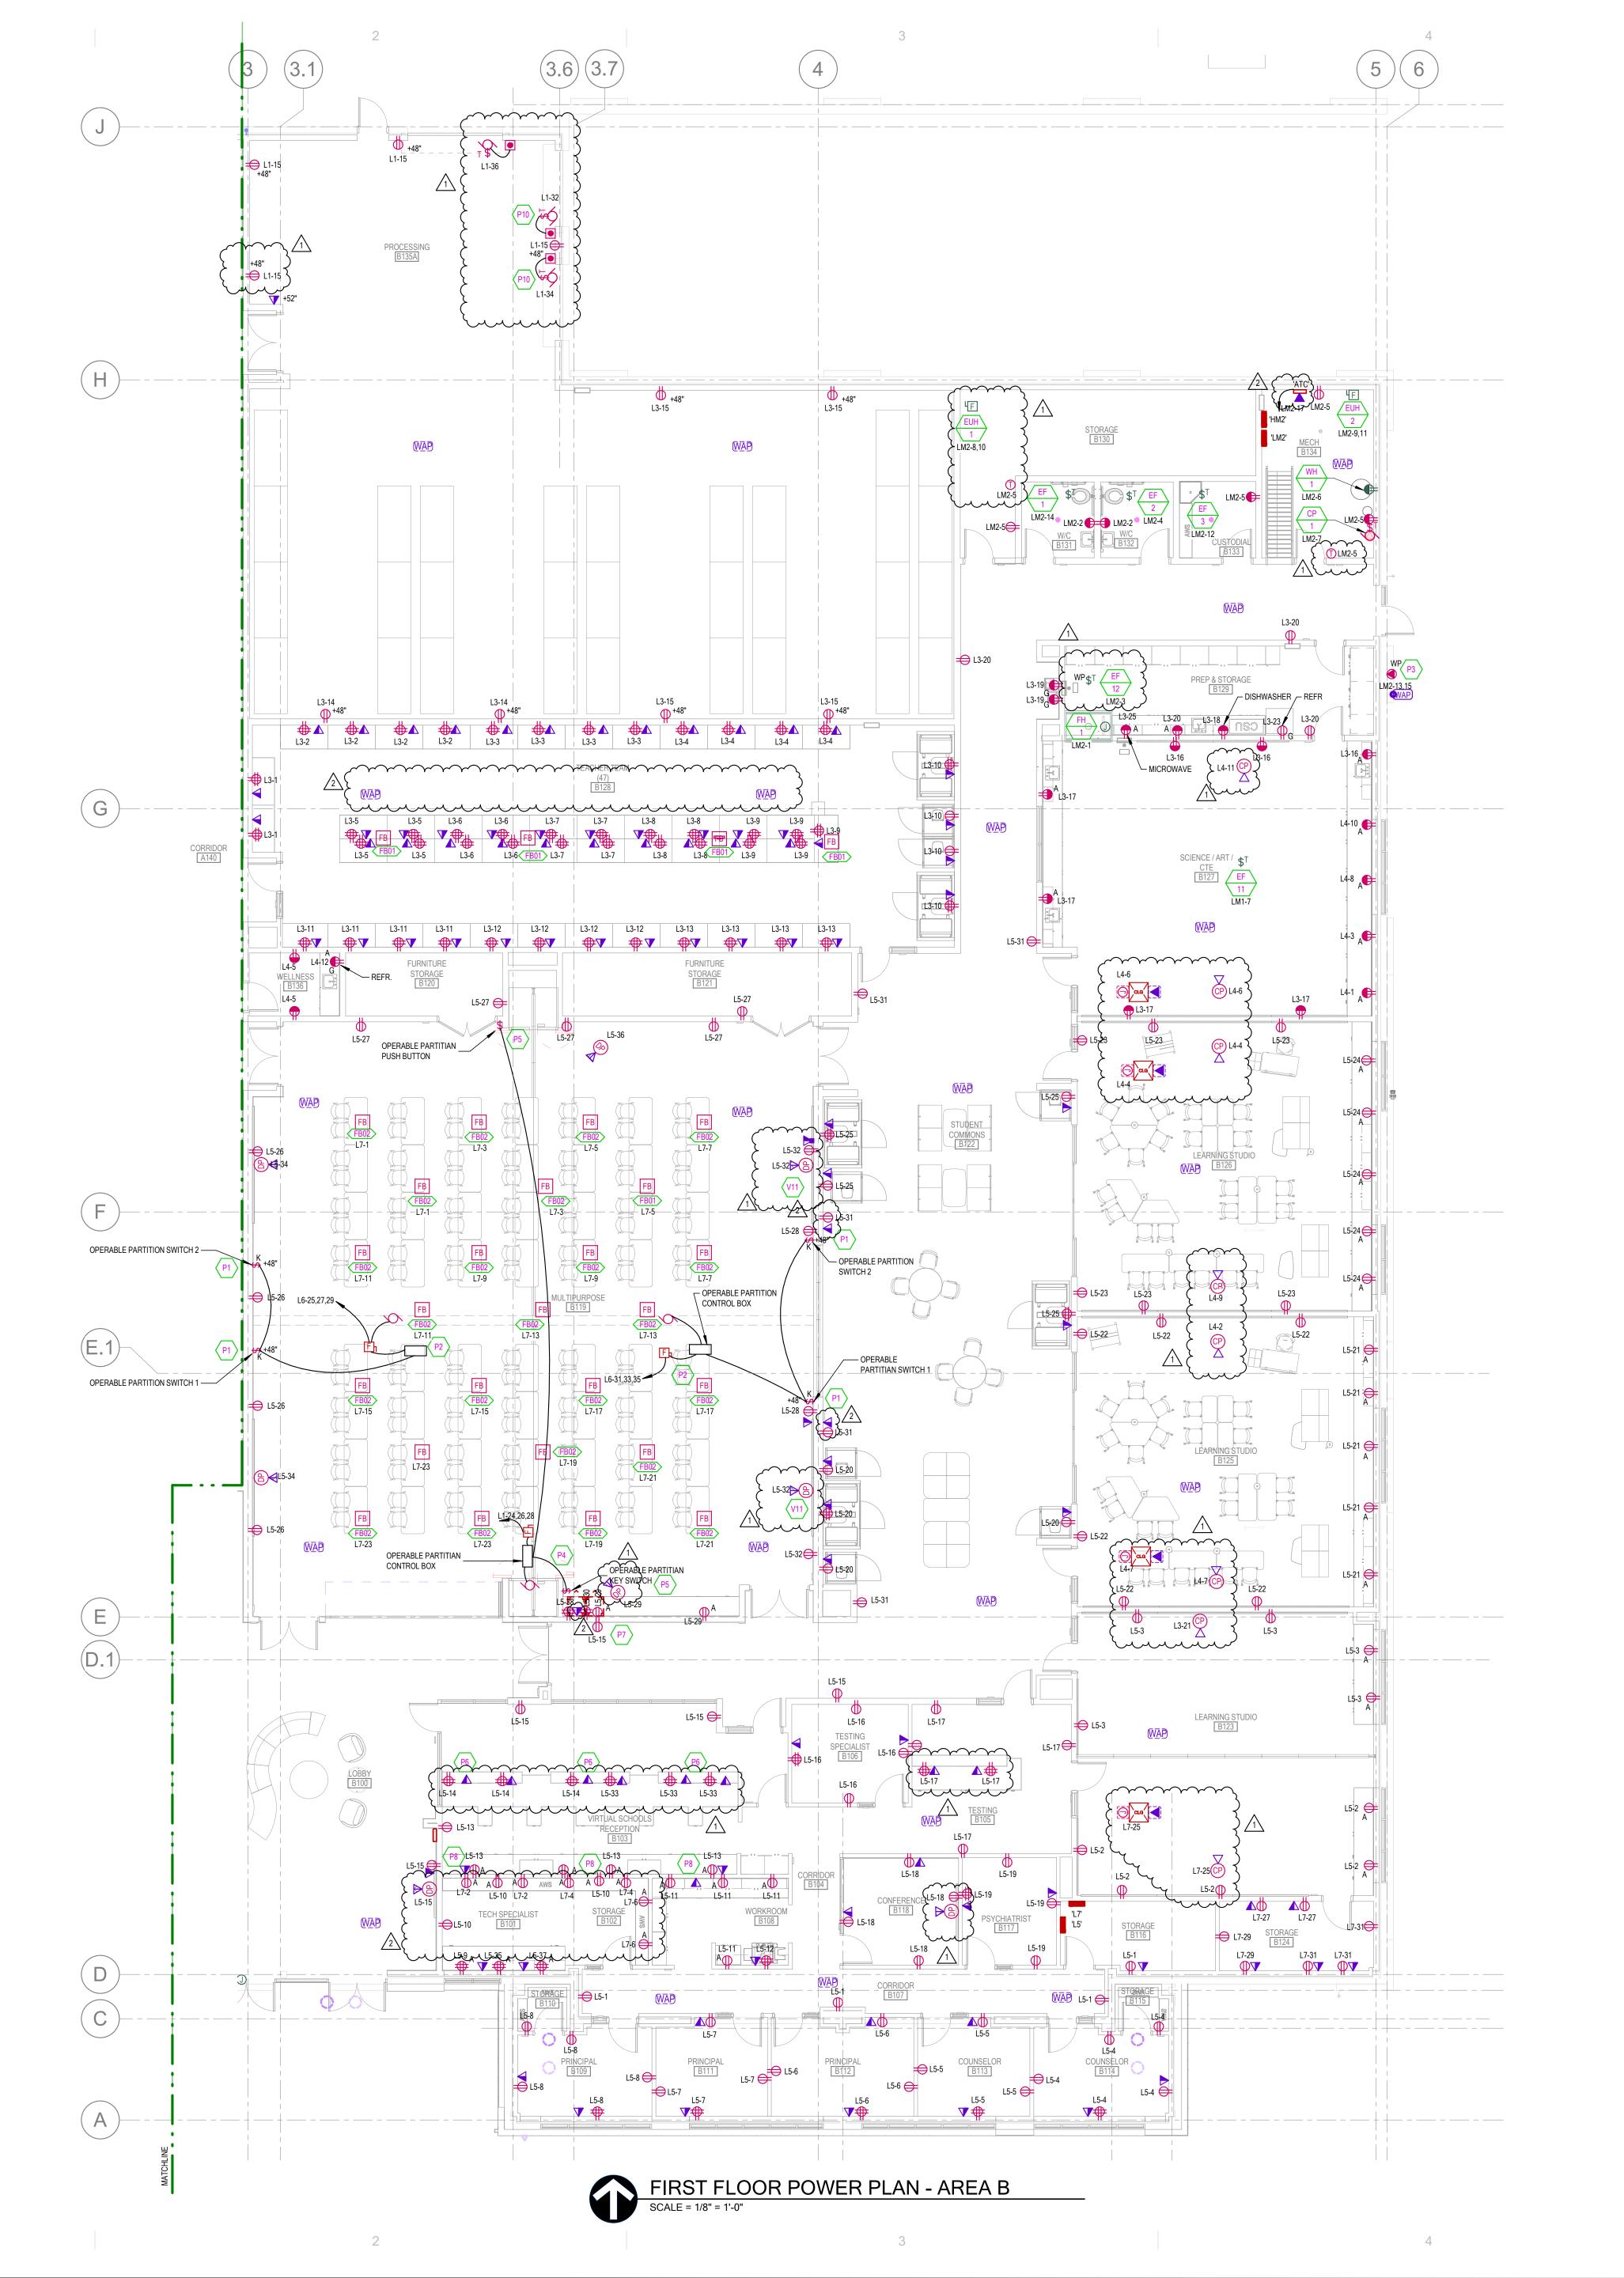

## GENERAL POWER SHEET NOTES

COORDINATE PLACEMENT OF ELECTRICAL DEVICES WITH ARCHITECT PRIOR TO ROUGH-IN. WHERE
DEVICES ARE SHOWN IN SAME WALL SPACE, ALIGN VERTICALLY AND HORIZONTALLY. COORDINATE WITH
ARCHITECTURAL DRAWINGS, ATHLETIC SAFETY WALL PADDING AND CABINETRY DRAWINGS.

- ALL THE LOW VOLTAGE WIRE/CABLE FOR LIGHTING SENSORS, AUDIO/VISUAL EQUIPMENT, SOUND AMPLIFICATION, ETC. TO BE ROUTED THROUGH CONDUIT IN EXPOSED AND CLOUDED CEILING AREAS.
   ALL LOW VOLTAGE WIRE/CABLE FOR LIGHTING SENSORS, AUDIO/VISUAL EQUIPMENT, CLASSROOM SOUND AMPLIFICATION, ETC. TO BE PROPERLY SUPPORTED PER THE TELE/DATA SPEC. AND AT 5'-0" INTERVALS
- AMPLIFICATION, ETC. TO BE PROPERLY SUPPORTED PER THE TELE/DATA SPEC. AND AT 5-0 INTERVALS AND TO FOLLOW BUILDING STRUCTURAL LINES. PULLING WIRE DIAGONALLY ACROSS ROOMS IS NOT ALLOWED. USING CEILING SYSTEM OR LIGHT FIXTURE SUPPORT/SEISMIC WIRES FOR SUPPORT IS NOT ALLOWED.
- PROVIDE GFCI PROTECTION ON ALL DEVICES AND EQUIPMENT PER THE NEC REQUIREMENTS. DEVICES SHALL BE READILY ACCESSIBLE. IF ANY OUTLET IS INSTALLED WITHIN 6 FEET OF OUTSIDE EDGE OF SINK, CONTRACTOR SHALL PROVIDE GFCI RECEPTACLE PER NEC, WHETHER SHOWN OR
- 5. ALL RECEPTACLES LOCATED THROUGHOUT THE BUILDING SHALL BE TAMPER RESISTANT PER NEC 406.12.
   6. ELECTRICAL CONTRACTOR SHALL COORDINATE EXACT LOCATION OF ALL MECHANICAL UNITS WITH
- NOTED OTHERWISE.

  FOR VAV POWER, PROVIDE A DEDICATED 120V/20A CIRCUIT FROM A PANEL LOCATED IN THE ELECTRICAL

MECHANICAL CONTRACTOR. CIRCUITS TO ALL MECHANICAL EQUIPMENT SHALL BE DEDICATED UNLESS

ROOM OF THE ASSOCIATED QUADRANT. COORDINATE EXACT LOCATION OF ALL VAV BOXES WITH MECHANICAL CONTRACTOR PRIOR TO ROUGH-IN.

PROVIDE 120V CIRCUIT FROM NEAREST PROVIDED CIRCUIT FOR FIRE/SMOKE DAMPER RELAYS. PROVIDE

FIRE ALARM MODULES AND RELAYS AS NECESSARY FOR ALL FIRE/SMOKE DAMPERS SHOWN ON DIVISION 23 DRAWINGS. ALL FIRE/SMOKE DAMPERS SHALL HAVE A MANUAL OVERRIDE SWITCH. PROVIDE DUCT

- DETECTOR WITHIN 5 FEET OF EACH FIRE/SMOKE DAMPER.

  CONTRACTOR TO COORDINATE ALL LOCATIONS OF FIRE/SMOKE AND SMOKE DAMPERS WITH MECHANICAL CONTRACTOR. CONTRACTOR TO PROVIDE POWER, MONITOR MODULES, AND RELAYS AS REQUIRED FOR A
- DIVISION-26 IS RESPONSIBLE TO PROVIDE CONDUIT AND ROUGH-IN FOR ALL THERMOSTAT CONTROLS LOCATED WITHIN WALLS. COORDINATE WITH THE CONTROLS CONTRACTOR AND VERIFY EXACT LOCATION OF ALL THERMOSTATS.

## SHEET KEYNOTES

- OPERABLE PARTITION CONTROL PANEL IS SUPPLIED BY PARTITION MANUFACTURER WITH 15' OF CABLE FROM THE MOTOR. VERIFY CONTROL PANEL MOUNTING IS WITHIN 15'. DIVISION 26 IS RESPONSIBLE TO WIRE FROM CONTROL PANEL TO FUSED DISCONNECT SWITCH AND CIRCUIT FROM PANEL AS INDICATED.
- P2 SWITCHES 1 AND 2 ARE SUPPLIED BY PARTITION MANUFACTURER INSTALLED BY DIVISION 26. PROVIDE 5#18 FROM SWITCH 2 TO SWITCH 1 AND FROM SWITCH 1 TO THE CONTROL PANEL. PROVIDE ALL TERMINATIONS AS REQUIRED. COORDINATE ALL REQUIREMENTS WITH PARTITION INSTALLER.
- P3 PROVIDE A NEMA 14-60, 60A-120/250V GRNDG PLUG IN A NEMA 3R ENCLOSURE, VERIFY EXACT LOCATION.

  P4 OPERABLE PARTITION CONTROLLER IS SUPPLIED BY THE MANUFACTURER. MOUNT CONTROLLER WITHIN 5'
  OF THE MOTOR UNIT AND DISCONNECT SWITCH. VERIFY ALL WIRING AND TERMINATION REQUIREMENTS WITH
- PARTITION INSTALLER.
- P5 KEY SWITCH AND PUSH BUTTON ARE SUPPLIED BY THE PARTITION SUPPLIER AND INSTALLED BY DIVISION 26. VERIFY ALL WIRING REQUIREMENTS.

  P6 LOCATE RECEPTACLE ON DESK RECESS. COORDINATE STUB-UP LOCATIONS WITHIN MILLWORK WITH
- ARCHITECT AND MILLWORK SHOP DRAWINGS.

  P7 VERIFY EXACT LOCATION OF TERMINATION FOR THE AUDIOLOGY BOOTH. FEED FROM THE WALL WITH FLEX
- P8 COORDINATE EXACT PLACEMENT OF THE RECEPTACLE IN THE FEATURE WALL WITH THE ARCHITECT.
- P10 POWERED OVERHEAD DOOR IS EXISTING. VERIFY EXACT LOCATION OF THE MOTOR AND CONTROLLER. PROVIDE A NEW THERMAL SWITCH AND CIRCUIT AS INDICATED.
- V11 REFERENCE DIANGRAM V302 ON SHEET T700.



MHTN Architects, Inc. 280 South 400 West Suite 250 Salt Lake City, Utah 84101 Telephone (801) 595-6700 www.mhtn.com




4225 Lake Park Blvd, Suite 275
West Valley City, UT 84120
P: 801.532.2196
F: 801.532.2305
www.bnaconsulting.com

# H H

# JORDAN LEARNING CENTER 706 WEST 9800 SOUTH

©2023 MHTN ARCHITECTS, INC.

Confidentiality Notice:
This document is intended for use on the Project identified herein by individuals and companies involved in the design, permitting, bidding and construction of the Project. MHTN Architects, inc. grants limited rights to distribute and reproduce this document for this express purpose only. Distribution, printing or copying this document for purposes other than those indicated is strictly prohibited. If a digital copy of this document is received in error, please delete it.

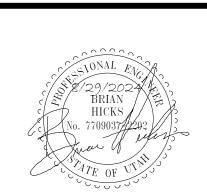

мнти ркојест no. 2024528

REVISIONS
CONTRACTOR TO VERIFY DRAWINGS IN FIELD USE REFLECT LAST REVISION DATE.

NO. △ DATE DESCRIPTION
1 9/6/24 Addendum #1

 NO. △
 DATE
 DESCRIPTION

 1
 9/6/24
 Addendum #1

 2
 09/13/2024
 Addendum #2

CONSTRUCTION DOCUMENTS
AUGUST 29, 2024

FIRST FLOOR
POWER PLAN AREA B

SHEET NUMBER

A

**KEY PLAN** 

E311B

CON	DUCT		CON				ΗE	DULI	E	
TYPE	AMP.	COND SIZE	· —	ONDU IAN.		OR ZE	4	SUL- ION	EQ. COI	GND ND.
⟨31X⟩	120	2"	;	3	1	/0	ХН	HW-2	•	4
⟨41X⟩	120	2"	_	4		//0	-	HW-2		4
⟨51X⟩	120	2"		5 *		//0		HW-2		4
⟨32X⟩	135	2"		3		2/0	-	HW-2		4
(42X)	135	2"	_	4		2/0	-	HW-2		4
⟨52X⟩ ⟨33X⟩	135 155	2"		5 * 3		2/0 3/0	-	HW-2 HW-2		4  4
\\\\\\\\\\\\\\\\\\\\\\\\\\\\\\\\\\\\\\	155	2"		3 4		3/0	-	HW-2		<del>4</del> 4
(53X)	155	3"	_	· 5 *		3/0	-	HW-2		<u>-</u> 4
⟨34X⟩	180	2"		3		1/0	-	HW-2		4
<b>44X</b>	180	3"	1	4	4	I/O	ХН	HW-2		4
(54X)	180	3"		5 *	4	1/0	ХН	HW-2	:	2
325	205	2"	;	3	2	50	ХН	HW-2		2
425	205	3"		4	2	50	ХН	HW-2		2
525	205	3"		5 *	2	50	-	HW-2	:	2
330	230	3"		3		00		HW-2		2
<u>430</u>	230	3"	_	4		00		HW-2		2
(530)	230	3"	_	5 *		00		HW-2		2
(335)	250	3"		3		50		HW-2		2
\(\left\) 435 \(\right\)	250 250	3"	-	4 5 *		50 50		HW-2 HW-2		2 2
440	270	3"		5 ^ 4		00		HW-2		<u>2</u> 2
(540)	270	3"	-	5 *		00		HW-2		<u>-</u> 2
350	310	4"	_	3		00		HW-2		 1
450	310	4"	_   .	4	5	00	ХН	HW-2		1
<b>(</b> 550 <b>)</b>	310	4"	4	4	5	00	ХН	HW-2		1
<b>(375)</b>	385	4"	;	3	7	50	ХН	HW-2		1
<u>475</u>	385	4"	4	4	7	50	ХН	HW-2		1
<b>\(575\)</b>	385	4"	,	5 *	7	50	ХН	HW-2	,	1
TYPE	MAX. O.C. PROT.	COND. AMPS	SETS	CO QUA		JCTO SIZ		CONDI SIZE		Q. GNI CONI
(325-2)	400	410	2	3		25		4"		2/0
(425-2)	400	410	2	4		25		4"		2/0
(525-2)	400	410	2	5		25		4"	+	2/0
(350-2)	600	620	2	3		50		4"	+	2/0
450-2	600	620	2	4		50		4" 4"		2/0
(550-2) (375-2)	800	620 770	2	3		50 75		4"	+	2/0 3/0
475-2	800	770	2	4		75		4"	+	3/0
(575-2)	800	770	2	5		75		4"	+	3/0
350-3	800	930	3	3		50		4"	+	3/0
375-3	1000	1150	3	3		75		4"	+	4/0
475-3	1000	1150	3	4		75		4"	-	4/0
(575-3)	1000	1150	3	5		75		4"	+	4/0
350-4	1200	1240	4	3		50		4"	+	250
450-4	1200	1240	4	4		50		4"		250
340-6	1600	1620	6	3		40	0	4"	+	350
440-6	1600	1620	6	4		40		4"	-+	350
460-6	2000	2040	6	4		60	0	4"	+	400
375-6	2000	2310	6	3		75	0	4"	_	400
475-6	2000	2310	6	4		75	0	4"	1	400
375-7	2500	2695	7	3		75	0	5"	_	600
475-7	2500	2695	7	4		75	0	5"	_	600
375-8	3000	3080	8	3		75	0	5"		600
475-8	3000	3080	8	4		75	0	5"		600
475-11	4000	4235	11	4		75	0	5"		750
ACCOR	ALLEL RUN DANCE W		PARA.	250-	122. )					


CONDUCTORS OF HYDRAULIC COMPRESSION TYPE ONLY LISTED UNDER UL 486-B MARKED "AL7CU" FOR 75° PROVIDE ALL ELECTRICAL EQUIPMENT WITH PROPER SIZING TO ACCOMMODATE ALUMINUM CONDUCTORS, COORDINATE WITH EQUIPMENT SUPPLIER.

FIRE RATED CABLE SCHEDULE									
TYPE		COND. AMPS	CONDI QUAN.	JCTOR SIZE	INSUL- ATION	EQ. GND. COND.			
44		125	4	4	MgO	8			
43		145	4	3	MgO	8			
42		170	4	2	MgO	8			
41		195	4	1	MgO	6			
41X		230	4	1/0	MgO	4			
42X		265	4	2/0	MgO	4			
43X		310	4	3/0	MgO	3			
44X		360	4	4/0	MgO	3			
425		405	4	250	MgO	2			
435		505	4	350	MgO	1			
450		620	4	500	MgO	1/0			
		FIRF R	ATED	CARI	F				

$\blacksquare$						ŭ				
FIRE RATED CABLE FOR PARALLEL RUNS										
TYPE	MAX. O.C. PROT.	COND. AMPS	SETS	CONDUCTOR QUAN. SIZE		INSUL- ATION	EQ. GND. COND.			
425-2	800	810	2	4	250	MgO	2/0			
435-2	1000	1010	2	4	350	MgO	2/0			
450-2	1200	1240	2	4	500	MgO	3/0			
450-3	1600	1860	3	4	500	MgO	4/0			
435-4	2000	2020	4	4	350	MgO	250			
435-5	2500	2525	5	4	350	MgO	350			

3000 3100 5 4 500 MgO 500 4000 4340 7 4 500 MgO 500

IN PARALLEL RUNS SIZE GND. COND. IN ACCORDANCE WITH NEC PARA. 250-122. GND. CONDUCTOR MAY BE DELETED ON SERVICE ENTRANCE CONDUCTORS

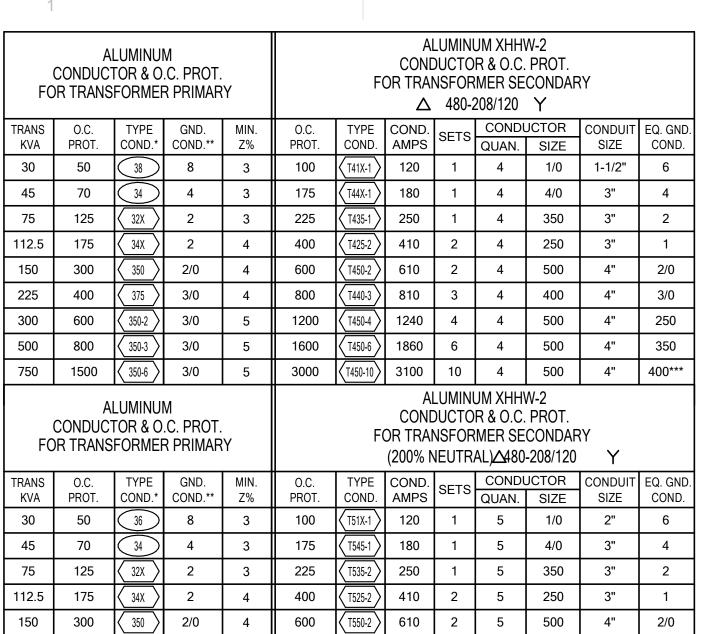

600

* SEE SCHEDULE FOR CONDUIT AND WIRE SIZE

3/0

3000

500 800

1200 | \( \tau_{550-4} \) | 1240 | 4 | 5 | 500 | 4" | 250

1600 | \( \tau_{\tau_{550-6}} \) | 1860 | 6 | 5 | 500 | 4" | 350

*** CU GROUND

【⟨T550-10⟩ **3100 10 5** 

** COPPER GROUNDING ELECRODE

# GENERAL SHEET NOTES

1. EMERGENCY EQUIPMENT INDICATED SHALL BE SELECTIVELY COORDINATED TO 0.1 SECONDS PER SPECIFICATION SECTION 26 0573. STUDY SHALL BE SUBMITTED PRIOR TO ALL OTHER EQUIPMENT

- SEE PLANS FOR LOCATIONS OF PANELBOARDS, SWITCHBOARDS TRANSFER SWITCHES, BUSWAY, TRANSFORMERS DISCONNECTS, ETC. AND PROVIDE NEMA RATED ENCLOSURES AS REQUIRED. SUBMIT DIMENSIONED DRAWINGS OF ALL ELECTRICAL ROOMS SHOWING ALL EQUIPMENT LOCATIONS
- WITHIN EACH SPACE BASED ON THE EQUIPMENT MANUFACTURER GEAR SIZES WITH ALL EQUIPMENT SHOP PROVIDE AN ARC ENERGY-REDUCING MAINTENANCE SWITCH FOR ALL OVER-CURRENT PROTECTIVE

DEVICES RATED 1200 AMPS OR HIGHER. REFER TO SPECIFICATION SECTION 26 2815 OVER-CURRENT

- PROTECTIVE DEVICES AND 240.87 OF CURRENT NATIONAL ELECTRICAL CODE (NEC). PROVIDE ELECTRONIC TRIP CIRCUIT BREAKERS FOR ALL CIRCUIT BREAKERS 400 AMPS AND ABOVE. REFER TO THE OVERCURRENT PROTECTION SPECIFICATION SECTION FOR ADDITIONAL REQUIREMENTS.
- ALL EQUIPMENT SHALL BE FULLY RATED. NO SERIES RATINGS ARE ALLOWED. REFER TO SPECIFICATION SECTIONS FOR ADDITIONAL DETAILS.
- PROVIDE PRELIMINARY SHORT CIRCUIT STUDY SUBMITTAL PRIOR TO SUBMITTAL OF ANY ELECTRICAL EQUIPMENT. REFER TO SPECIFICATION SECTION 26 0573 PROTECTIVE DEVICE STUDY. PROVIDE AIC AND ARC-FLASH HAZARD LABELS PER THE SPECIFICATIONS AND NEC.
- 8. PROVIDE A SURGE PROTECTIVE DEVICE ON EACH SWITCHBOARD AND PANELBOARD LOCATED ON THE EMERGENCY DISTRIBUTION SYSTEM. REFER TO SPECIFICATION SECTION 26 4313 SURGE-PROTECTIVE DEVICES (SPD) FOR LOCATION CATEGORY.
- REFER TO DISTRIBUTION BOARD AND PANELBOARD SCHEDULES FOR ADDITIONAL BREAKERS AND SPD GFPE PROTECTION OF THE MAIN BREAKER SHALL BE TESTED PRIOR TO THE RELEASE OF THE METER AND
- RESULTS SHALL BE SUBMITTED TO THE SCHOOL DISTRICT BUILDING OFFICIAL. PROVIDE EQUIPMENT LABELING PER SPECIFICATIONS 26 0553. THE LABEL SHALL IDENTIFY THE DEVICE OR EQUIPMENT WHERE THE POWER SUPPLE ORIGINATES, AND THE SYSTEM VOLTAGE, PHASE OR LINE AND SYSTEM AT TALL TERMINATION, CONNECTION, AND SPLICE POINTS. FOR EXAMPLE: FEEDER POWER SUPPLY FOR PANEL "XX" ORIGINATES AT PANEL "XX" (OR SWITCHBOARD "XX", TRANSFORMER "XX", SWITCH
- PROVIDE ALL REQUIRED LUG ADAPTERS, PIN REDUCERS, POLARIS LUG KITS, ETC. AS REQUIRED, PROVIDE NEC SIZED JUNCTION BOX AHEAD OF PANEL BOARD/GEAR AS NEEDED TO LOCATED AND TERMINATE CONDUCTORS ON POLARIS LUG ADAPTERS (<10' FROM FINALTERMINATION AT PANELBOARD). SIZE DOWN TO CONDUCTORS THAT FIT THE AVAILABLE LUGS AND/OR BREAKERS.

"XX", ETC.); 120/208 VOLTS, 3-PHASE, PHASE COLOR IDENTIFICATION (OR 120/240, 277/480, ETC.).

# SHEET KEYNOTES

- SQUARE D POWER LOGIC METERING.
- $ar{\hspace{0.1cm}}$  GROUND TO BUILDING STRUCTURAL STEEL, WATER MAIN AND GROUND RODS PER SPECIFICATIONS. PROVIDE 30' OF 2/0 BARE COPPER CONDUCTOR LOCATED WITHIN & NEAR THE BOTTOM OF FOOTING (MINIMUM 2" COVER)
- 4 PANEL EXTENSION WITH "MONO-FLAT" FRONT. PROVIDE MECHANICAL CONTACTORS.
- \$\langle 5 \rangle PROVIDE A USERC 339 METER BASE MOUNTED TO EXTERIOR OF CT CABINET WITH 1" NIPPLE INTO CT COMPARTMENT.
- (6) COORDINATE BASE BID OR ALTERNATE FOR PANEL CONNECTED TO THIS FEEDER.  $\langle$   7  angle Fire rated cable. Provide Ho15 fire rated trapeze rack. Refer to specification for ADDITIONAL INFORMATION.
- (8) PROVIDE AN ENERGY-REDUCING MAINTENANCE SWITCH WITH LOCAL, LIT STATUS INDICATOR TO ALLOW FOR A REDUCTION OF THE INSTANTANEOUS PICKUP AND INSTANTANEOUS DELAY SETTINGS FOR USE DURING MAINTENANCE. DEVICE SHALL MOUNT IN FACE OF DEAD-FRONT. THE SWITCH SHALL BE

**ONE-LINE DIAGRAM** 

COPPER **CONDUCTOR & CONDUIT SCHEDULE** CONDUCTOR INSUL- EQ. GND. SIZE QUAN. SIZE ATION COND. 3/4" 70 | 1-1/4" | 3 | 4 | 70 | 1-1/4" | 4 | 4 | 85 | 1-1/4" | 2 | 3 1-1/4" 1-1/2" | 4 | 3 | 95 | 1-1/2" 95 | 1-1/2" | 4 | 2 | 110 | 1-1/2" | 3 | 1 | 110 | 2" | 5 *| 1 | HH **CONDUCTOR & CONDUIT SCHEDULE** FOR PARALLEL RUNS TYPE MAX. O.C. COND. AMPS SETS CONDUCTOR CONDUIT EQ. GND QUAN. SIZE SIZE COND 4 4/0 2-1/2" 3 600 620 350 600 620 350 600 5 * 350 800 | 760 | 2 500 500 800

5 * 500

500

500


1000

1000

IN PARALLEL RUNS SIZE GND. COND. IN

ACCORDANCE WITH NEC PARA. 250-122.

GND. CONDUCTOR MAY BE DELETED

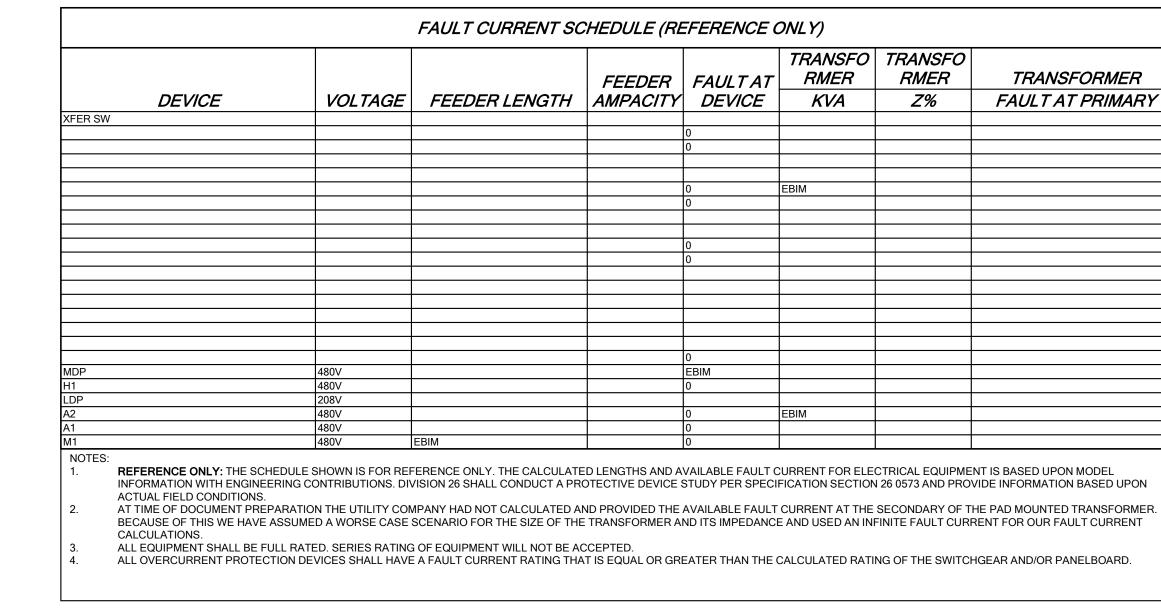

INFORMATION WITH ENGINEERING CONTRIBUTIONS. DIVISION 26 SHALL CONDUCT A PROTECTIVE DEVICE STUDY PER SPECIFICATION SECTION 26 0573 AND PROVIDE INFORMATION BASED UPON AT TIME OF DOCUMENT PREPARATION THE UTILITY COMPANY HAD NOT CALCULATED AND PROVIDED THE AVAILABLE FAULT CURRENT AT THE SECONDARY OF THE PAD MOUNTED TRANSFORMER. BECAUSE OF THIS WE HAVE ASSUMED A WORSE CASE SCENARIO FOR THE SIZE OF THE TRANSFORMER AND ITS IMPEDANCE AND USED AN INFINITE FAULT CURRENT FOR OUR FAULT CURRENT



MHTN Architects, Inc. 280 South 400 West Suite 250 Salt Lake City, Utah 84101 Telephone (801) 595-6700 www.mhtn.com



www.bnaconsulting.com

©2023 MHTN ARCHITECTS, INC. his document is intended for use on the Project identified herein by individual and companies involved in the design, permitting, bidding and construction of the Project. MHTN Architects, Inc. grants limited rights to distribute and eproduce this document for this express purpose only. Distribution, printing copying this document for purposes other than those indicated is strictly

. 0000
CONAL POR
CZ . C \ 01 ···· Z
5/28/29/2024 PS
C/ Q/ DIMAN / //30 /3
HICKS
No. 7709037/1292 // 3
The wests
June (1 // /s
THE OF UNITY
00000


мнти реојест по. 2024528
Original drawing is 30 x 42. Do not scale contents of this drawing.
REVISIONS CONTRACTOR TO VERIFY DRAWINGS IN FIELD USE REFLECT LAST REVISION DATE.
A

	3/0/24	Audendum # i
2	09/13/2024	Addendum #2

CONSTRUCTION DOCUMENTS AUGUST 29, 2024

ONE-LINE DIAGRAM

E360

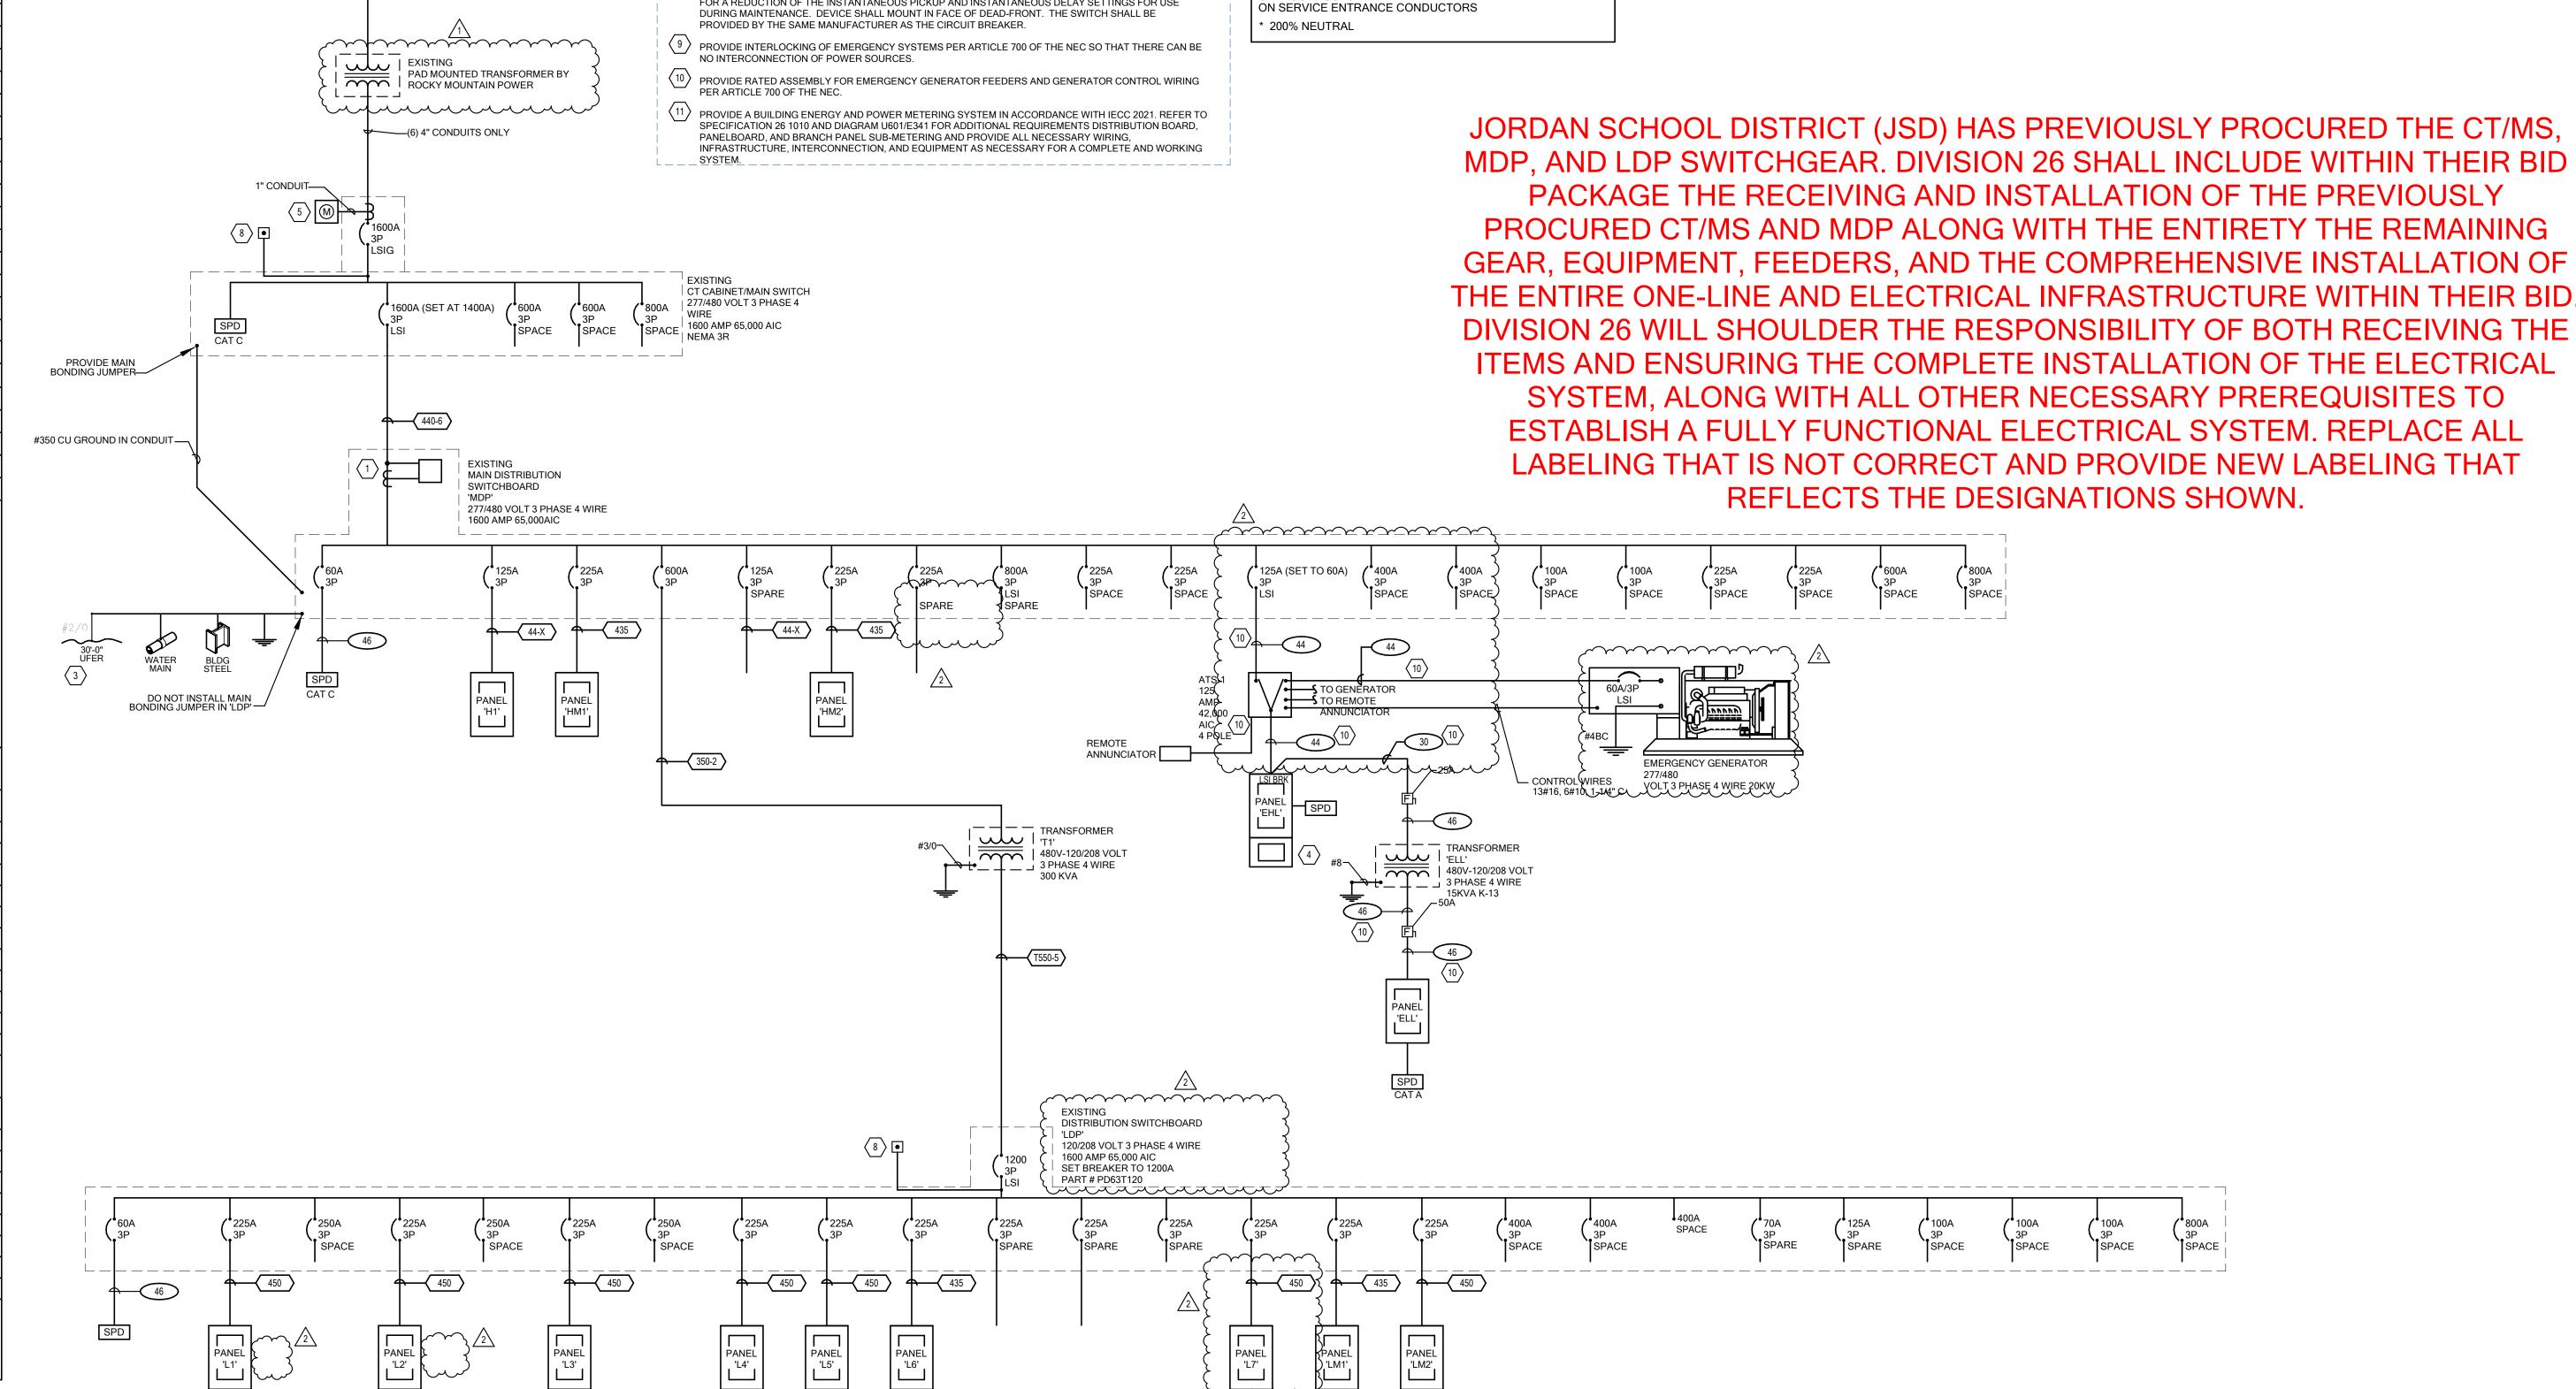

DANELDOADD CCHEDIILE	DANELDOADD COHEDILLE	DANELDOADD COHEDIUE
PANELBOARD SCHEDULE	PANELBOARD SCHEDULE	PANELBOARD SCHEDULE
PANEL: L1         TYPE:         Type 1         VOLTS:         120/208 Y         PHASE:         3         WIRES:         4           MOUNTING:         SURFACE         LOCATION:         ELECTRICAL A142         MAINS:         MLO	PANEL: L3         TYPE:         Type 1         VOLTS:         120/208 Y         PHASE:         3         WIRES:         4           MOUNTING:         SURFACE         LOCATION:         ELECTRICAL A142         MAINS:         MLO	PANEL: L5         TYPE:         Type 1         VOLTS:         120/208 Y         PHASE:         3         WIRES:         4           MOUNTING: SURFACE         LOCATION: STORAGE B116         MAINS: MLO
BUSSING:	BUSSING:	BUSSING:         FED FROM: LDP         SUBFEED LUGS           AMP: 225 A         X DOOR-IN-DOOR
ISO GROUND	ISO GROUND  200% NEUTRAL	
200% NEOTRALSPD	200% NEOTRALSPD	200% NEOTRALSPD
BRANCH BREAKERS  WIRE CIR.   CIR. WIRE	BRANCH BREAKERS  WIRE CIR.   CIR. WIRE	BRANCH BREAKERS  WIRE CIR.   CIR. WIRE
TIEM   AMPS   TYPE   POLE   SIZE   NO.   A   B   C   A   B   C   NO.   SIZE   POLE   TYPE   AMPS   ITEM	ITEM         AMPS         TYPE         POLE         SIZE         NO.         A         B         C         A         B         C         NO.         SIZE         POLE         TYPE         AMPS         ITEM           RECEPT, TEACHER TEAM (47)         20 A         1         12         1         720         1440         2         12         1         20 A         RECEPT, TEACHER TEAM (47) B128	ITEM         AMPS         TYPE         POLE         SIZE         NO.         A         B         C         A         B         C         NO.         SIZE         POLE         TYPE         AMPS         ITEM           RECEPT STORAGE B124         20 A         1         12         1         720         900         2         12         1         20 A         RECEPT LEARNING STUDIO B123
RECEPT, COACH TEAM (12) 20 A 1 12 3 1580 2160 4 12 1 25 A RECEPT, Room A138, A139  RECEPT, Room A134, A135, 20 A 1 12 5 1080 720 6 12 1 20 A RECEPT, Room A141, A142	RECEPT, TEACHER TEAM (47) 20 A 1 12 3 1440 1440 4 12 1 20 A RECEPT, TEACHER TEAM (47) B128 RECEPT, TEACHER TEAM (47) 20 A 1 12 5 1440 1440 6 12 1 20 A RECEPT, TEACHER TEAM (47) B128	RECEPT LEARNING STUDIO         20 A         1         12         3         900         1095         4         12         1         20 A         RECEPT COUNSELOR B114           RECEPT COUNSELOR B113         20 A         1         12         5         900         900         6         12         1         20 A         RECEPT COUNSELOR B112
RECEPT, Room A140, A141 20 A 1 12 7 720 360 8 12 1 20 A RECEPT, BREAK ROOM A141  * ICEMAKER 20 A GF 1 12 9 180 360 10 12 1 20 A RECEPT, CORRIDOR A140  RECEPT, Room A145, A146 20 A 1 12 11 900 1080 12 12 1 20 A RECEPT, Room A140, A143	RECEPT, TEACHER TEAM (47) 20 A 1 12 7 1440 1440 8 12 1 20 A RECEPT, TEACHER TEAM (47) B128 RECEPT, TEACHER TEAM (47) 20 A 1 12 9 1800 1440 10 12 1 20 A RECEPT, TEACHER TEAM (47) B128 RECEPT, TEACHER TEAM (47) 20 A 1 12 11 1440 12 12 12 1 20 A RECEPT, TEACHER TEAM (47) B128	RECEPT PRINCIPAL B111         20 A         1         12         7         900         1095         8         12         1         20 A         RECEPT PRINCIPAL B109           RECEPT TECH SPECIALIST         20 A         1         12         9         360         540         10         12         1         20 A         RECEPT TECH SPECIALIST B101           RECEPT WORKROOM B108         20 A         1         12         11         720         180         12         12         1         20 A         RECEPT WORKROOM B108
RECEPT, Room A149, A150 20 A 1 12 13 360 360 14 12 1 20 A RECEPT, LAUNDRY / RECEIVING  RECEPT, Room A140, B135A 20 A 1 12 15 900 180 16 12 1 GF 20 A *WASHER	RECEPT, TEACHER TEAM (47) 20 A 1 12 11 1440 12 12 1 20 A RECEPT, TEACHER TEAM (47) B128 RECEPT, TEACHER TEAM (47) 20 A 1 12 13 1440 360 14 12 1 20 A RECEPT, PROCESSING B135A RECEPT, PROCESSING B135A 20 A 1 12 15 720 540 16 12 1 20 A RECEPT, SCIENCE / ART / CTE	RECEPT WORKROOM B108         20 A         1         12         11         720         180         12         12         1         20 A         RECEPT WORKROOM B108           RECEPT VIRTUAL SCHOOLS         20 A         1         12         13         900         1080         14         12         1         20 A         RECEPT VIRTUAL SCHOOLS           RECEPT LOBBY B100         20 A         1         12         15         1400         900         16         12         1         20 A         RECEPT TESTING SPECIALIST
RECEPT, LAUNDRY / 20 A 1 12 17 360 2500 18 10 2 GF 35 A *DRYER  RECEPT, BREAK ROOM A141 20 A 1 12 19 180 2500 20	RECEPT, SCIENCE / ART / CTE 20 A 1 12 17 720 180 18 12 1 GF 20 A *DISHWASHER *WATER FOUNTAIN 20 A 1 12 19 360 720 20 12 1 20 A RECEPT, PREP & STORAGE B129	RECEPT TESTING B105 20 A 1 12 17 1260 720 18 12 1 20 A RECEPT CONFERENCE B118  RECEPT PSYCHIATRIST B117 20 A 1 12 19 900 900 20 12 1 20 A RECEPT STUDENT COMMONS
* REFRIGERATOR 20 A GF 1 12 21 1000 180 22 12 1 20 A RECEPT, WORK ROOM A133  RECEPT, WORK ROOM A133 20 A 1 12 23 720 480 24 3 20 A OPERABLE PARTITION	Other         20 A         1         12         21         700         1080         22         1         20 A         RECEPT TEACHER TEAM (45) A132           *REFRIGERATOR         20 A         GF         1         12         23         1000         720         24         1         20 A         RECEPT TEACHER TEAM (45) A132	RECEPT LEARNING STUDIO         20 A         1         12         21         900         1080         22         12         1         20 A         RECEPT LEARNING STUDIO B125           RECEPT LEARNING STUDIO         20 A         1         12         23         1080         900         24         12         1         20 A         RECEPT LEARNING STUDIO B126
* REFRIGERATOR 20 A GF 1 12 25 1000 480 26	*MICROWAVE 20 A 1 12 25 180 720 26 1 20 A RECEPT TEACHER TEAM (45) A132  SPARE 20 A 1 27 0 1080 28 1 20 A RECEPT TEACHER TEAM (45) A132  SPARE 20 A 1 27 0 0 720 30 1 20 A RECEPT TEACHER TEAM (45) A132	RECEPT STUDENT COMMONS 20 A 1 12 25 900 720 26 12 1 20 A RECEPT MULTIPURPOSE B119 RECEPT FURNITURE STORAG 20 A 1 12 27 900 360 28 12 1 20 A RECEPT MULTIPURPOSE B119
* MICROWAVE         20 A         GF         1         12         29         1200         540         30         1         20 A         RECEPT, TODDLER A138           * MICROWAVE         20 A         GF         1         12         31         1200         0         32         1         20 A         COILING DOOR           HVAC, AUDIOLOGY A130         20 A         1         12         33         500         0         34         1         20 A         COILING DOOR	SPARE         20 A          1          29         0         720         30         1         20 A         RECEPT TEACHER TEAM (45) A132           SPARE         20 A          1          31         0         0         32          1          20 A         SPARE           SPARE         20 A          1          33         0         0         34          1          20 A         SPARE	RECEPT MULTIPURPOSE B119         20 A         1         12         29         860         360         30         12         1         20 A         RECEPT MULTIPURPOSE B119           RECEPT STUDENT COMMONS         20 A         1         12         31         900         1360         32         12         1         20 A         MULTIPURPOSE B119           RECEPT VIRTUAL SCHOOLS         20 A         1         12         33         1080         1000         34         12         1         20 A         Other MULTIPURPOSE B119
SPARE         20 A          1          35         0         0         36         1         20 A         COILING DOOR           SPARE         20 A          1          37         0         0         38          1          20 A         SPARE	SPARE         20 A          1          35         0         0         36          1          20 A         SPARE           SPACE ONLY           1          37           38          1           SPACE ONLY	RECEPT STORAGE B102 20 A 1 12 35 360 500 36 12 1 20 A Other MULTIPURPOSE B119  RECEPT STORAGE B102 20 A 1 12 37 360 360 38 12 1 20 A RECEPT MULTIPURPOSE B119
SPARE         20 A          1          39         0         0         40          1          20 A         SPARE           SPARE         20 A          1          41         0         0         42          1          20 A         SPARE	SPACE ONLY          1          39           40          1          SPACE ONLY           SPACE ONLY          1          41           42          1           SPACE ONLY	SPARE         20 A          1          39         0         0         40          1          20 A         SPARE           SPARE         20 A          1          41         0         0         42          1          20 A         SPARE
FEED THRU LOAD  9680 8720 9580 TOTAL (VA)  CONNECTED LOAD TOTAL	FEED THRU LOAD  8820 10240 9100 TOTAL (VA)  CONNECTED LOAD TOTAL	FEED THRU LOAD 11995 10515 8740 TOTAL (VA) CONNECTED LOAD TOTAL
0 VA	0 VA	102 A   90 A   73 A   AMPS/PHASE   31250 VA   31250 VA   AIC RATING   22000   AMPS RMS SYSM.
Load Classification Connected Load Demand Factor Estimated Demand Panel Totals	Load Classification Connected Load Demand Factor Estimated Demand Panel Totals	Load Classification Connected Load Demand Factor Estimated Demand Panel Totals
HVAC         500 VA         100.00%         500 VA         Total Conn. Load:         26540 VA           Motor         0 VA         0.00%         0 VA         Total Conn. Load:         26540 VA	Other         700 VA         100.00%         700 VA         Total Conn. Load:         28160 VA           RECEPT         26460 VA         68.90%         18230 VA         Total Conn. Load:         28160 VA	LIGHTING         30 VA         125.00%         38 VA           Other         3500 VA         100.00%         3500 VA         Total Conn. Load: 31250 VA
Other         500 VA         100.00%         500 VA         Total Est. Demand:         24070 VA           RECEPT         14940 VA         83.47%         12470 VA         Total Conn. Current:         74 A	* REFRIGERATOR 1000 VA 100.00% 1000 VA Total Est. Demand: 19930 VA Total Conn. Current: 78 A	RECEPT         27720 VA         68.04%         18860 VA         Total Est. Demand:         22398 VA           Total Conn. Current:         87 A
* MICROWAVE 3600 VA 100.00% 3600 VA <b>Total Est. Demand Current:</b> 67 A * REFRIGERATOR 2000 VA 100.00% 2000 VA	Total Est. Demand Current: 55 A	Total Est. Demand Current: 62 A
* DRYER 5000 VA 100.00% 5000 VA NOTES: CIRCUIT BREAKER TYPE:	NOTES: CIRCUIT BREAKER TYPE:	NOTES: CIRCUIT BREAKER TYPE:
* SBLANK> THERMAL MAGNETIC CIRCUIT BREAKER  GF 5 mA GROUND FAULT CIRCUIT BREAKER  AF ARC-FAULT CIRCUIT BREAKER  CO COMBINATION AFCI/GFCI CIRCUIT BREAKER	<blank> THERMAL MAGNETIC CIRCUIT BREAKER GF 5 mA GROUND FAULT CIRCUIT BREAKER AF ARC-FAULT CIRCUIT BREAKER CO COMBINATION AFCI/GFCI CIRCUIT BREAKER</blank>	<blank> THERMAL MAGNETIC CIRCUIT BREAKER  GF 5 mA GROUND FAULT CIRCUIT BREAKER  AF ARC-FAULT CIRCUIT BREAKER  CO COMBINATION AFCI/GFCI CIRCUIT BREAKER</blank>
EG 30 mA EQUIPMENT GROUND FAULT CIRCUIT BREAKER ST SHUNT TRIP CIRCUIT BREAKER	EG 30 MA EQUIPMENT GROUND FAULT CIRCUIT BREAKER ST SHUNT TRIP CIRCUIT BREAKER	EG 30 mA EQUIPMENT GROUND FAULT CIRCUIT BREAKER ST SHUNT TRIP CIRCUIT BREAKER
PANELBOARD SCHEDULE	PANELBOARD SCHEDULE	PANELBOARD SCHEDULE
PANELBOARD SCHEDULE           PANEL: 12         TYPE: Type 1         VOLTS: 120/208 Y         PHASE: 3         WIRES: 4	PANELBOARD SCHEDULE           PANEL: L4         TYPE: Type 1         VOLTS: 120/208 Y         PHASE: 3         WIRES: 4	PANEL L6         TYPE: Type 1         VOLTS: 120/208 Y         PHASE: 3         WIRES: 4
PANEL: L2         TYPE:         Type 1         VOLTS:         120/208 Y         PHASE:         3         WIRES:         4           MOUNTING:         SURFACE         LOCATION:         ELECTRICAL A142         MAINS:         MLO	PANEL:         L4         TYPE:         Type 1         VOLTS:         120/208 Y         PHASE:         3         WIRES:         4           MOUNTING:         SURFACE         LOCATION:         ELECTRICAL A142         MAINS:         MLO	PANEL: L6         TYPE:         Type 1         VOLTS:         120/208 Y         PHASE:         3         WIRES:         4           MOUNTING:         SURFACE         LOCATION:         STORAGE A109         MAINS:         MLO
PANEL: L2         TYPE:         Type 1         VOLTS:         120/208 Y         PHASE:         3         WIRES:         4           MOUNTING:         SURFACE         LOCATION:         ELECTRICAL A142         MAINS:         MLO           BUSSING:         FED FROM:         LDP         SUBFEED LUGS           AMP:         225 A         X         DOOR-IN-DOOR	PANEL: L4         TYPE:         Type 1         VOLTS:         120/208 Y         PHASE:         3         WIRES:         4           MOUNTING: SURFACE         LOCATION: ELECTRICAL A142         MAINS: MLO           BUSSING:         FED FROM: LDP         SUBFEED LUGS           AMP: 225 A         X DOOR-IN-DOOR	PANEL: L6         TYPE:         Type 1         VOLTS:         120/208 Y         PHASE:         3         WIRES:         4           MOUNTING: SURFACE         LOCATION: STORAGE A109         MAINS: MLO           BUSSING:         FED FROM: LDP         SUBFEED LUGS           AMP: 225 A         X         DOOR-IN-DOOR
PANEL: L2         TYPE:         Type 1         VOLTS:         120/208 Y         PHASE:         3         WIRES:         4           MOUNTING:         SURFACE         LOCATION:         ELECTRICAL A142         MAINS:         MLO           BUSSING:         FED FROM:         LDP         SUBFEED LUGS           AMP:         225 A         X         DOOR-IN-DOOR           ISO GROUND         200% NEUTRAL	PANEL: L4         TYPE:         Type 1         VOLTS:         120/208 Y         PHASE:         3         WIRES:         4           MOUNTING:         SURFACE         LOCATION:         ELECTRICAL A142         MAINS:         MLO           BUSSING:         FED FROM:         LDP         SUBFEED LUGS           AMP:         225 A         X         DOOR-IN-DOOR           ISO GROUND         200% NEUTRAL	PANEL: L6         TYPE:         Type 1         VOLTS:         120/208 Y         PHASE:         3         WIRES:         4           MOUNTING:         SURFACE         LOCATION:         STORAGE A109         MAINS:         MLO           BUSSING:         FED FROM:         LDP         SUBFEED LUGS           AMP:         225 A         X         DOOR-IN-DOOR           ISO GROUND         200% NEUTRAL
PANEL: L2         TYPE:         Type 1         VOLTS:         120/208 Y         PHASE:         3         WIRES:         4           MOUNTING:         SURFACE         LOCATION:         ELECTRICAL A142         MAINS:         MLO           BUSSING:         FED FROM:         LDP         SUBFEED LUGS           AMP:         225 A         X         DOOR-IN-DOOR           ISO GROUND         200% NEUTRAL         SPD	PANEL: L4         TYPE:         Type 1         VOLTS:         120/208 Y         PHASE:         3         WIRES:         4           MOUNTING:         SURFACE         LOCATION:         ELECTRICAL A142         MAINS:         MLO           BUSSING:         FED FROM:         LDP         SUBFEED LUGS           AMP:         225 A         X         DOOR-IN-DOOR           ISO GROUND         200% NEUTRAL         SPD	PANEL: L6         TYPE:         Type 1         VOLTS:         120/208 Y         PHASE:         3         WIRES:         4           MOUNTING: SURFACE         LOCATION: STORAGE A109         MAINS: MLO         MAINS: MLO         SUBFEED LUGS           BUSSING:         AMP: 225 A         X DOOR-IN-DOOR         ISO GROUND         200% NEUTRAL         SPD
PANEL: L2         TYPE:         Type 1         VOLTS:         120/208 Y         PHASE:         3         WIRES:         4           MOUNTING:         SURFACE         LOCATION:         ELECTRICAL A142         MAINS:         MLO           BUSSING:         FED FROM:         LDP         SUBFEED LUGS           AMP:         225 A         X         DOOR-IN-DOOR           ISO GROUND         200% NEUTRAL	PANEL: L4         TYPE:         Type 1         VOLTS:         120/208 Y         PHASE:         3         WIRES:         4           MOUNTING:         SURFACE         LOCATION:         ELECTRICAL A142         MAINS:         MLO           BUSSING:         FED FROM:         LDP         SUBFEED LUGS           AMP:         225 A         X         DOOR-IN-DOOR           ISO GROUND         200% NEUTRAL	PANEL: L6         TYPE:         Type 1         VOLTS:         120/208 Y         PHASE:         3         WIRES:         4           MOUNTING:         SURFACE         LOCATION:         STORAGE A109         MAINS:         MLO           BUSSING:         FED FROM:         LDP         SUBFEED LUGS           AMP:         225 A         X         DOOR-IN-DOOR           ISO GROUND         200% NEUTRAL
PANEL: L2   TYPE:   Type 1   VOLTS:   120/208 Y   PHASE:   3   WIRES:   4	PANEL: L4	PANEL: L6
PANEL:   L2	PANEL: L4	PANEL: L6
PANEL: L2	PANEL:   L4	PANEL: L6
PANEL: L2	PANEL: L4	PANEL: L6
PANEL: L2   TyPE: Type 1	PANEL: L4	PANEL: L6
PANEL: L2   TYPE:   Type 1	NOUNTING: SURFACE   SUBSING:   Type:   Type:   Type:   LOCATION:   LECTRICAL A:142   MAINS: MLO   SUBFEDILUGS   SUBFEDILUGS	PANEL: L6
PANEL: L2   TYPE:   Type 1	PANEL: L4	PANEL: L6
PANEL: L2	MOUNTING: SURFACE	MOUNTING: SURFACE
PANEL: L2	PANEL: L4   TYPE:   Type 1   VOLTS:   120/208 Y   PHASE:   3   WIRES:   4	PANEL: L6
PANEL: L2	PANEL: L4 TYPE: Type 1 VOLTS: 120/208 Y PHASE: 3 WIRES: 4  MOUNTING: SURFACE  BUSSING: FED FROM: LDP  AMP: 225 A	PANEL: L6 TYPE: Type 1 VOLTS: 120/208 Y PHASE: 3 WIRES: 4  MOUNTING: SURFACE  BUSSING: FED FROM: LDP  AMP: 225 A SUBFEED LUGS  BRANCH BREAKERS  TIEM AMPS TYPE POLE SIZE NO. A B C A B C NO. SIZE POLE TYPE AMPS TIEM  RECEPT, SENSORVIBAL 20 A 1 112 1 720 1 720 1 2 11 1 2 20 A RECEPT, MOTOR ROOM A110  RECEPT, SENSORVIBAL 20 A 1 112 5 5 90 900 1 900 6 112 1 1 20 A RECEPT, COMPRENCE A108  RECEPT, SANTANTA 114 20 A 1 1 12 9 1 810 1 810 1 810 1 810 1 10 112 1 1 20 A RECEPT, RECORDS A104  RECEPT, SONTRAVA114 20 A 1 1 12 1 1 720 1 1080 1 180 1 10 112 1 1 20 A RECEPT, RECORDS A104  RECEPT, OFFICE A102 20 A 1 1 12 11 7 20 5 900 1 180 10 112 1 1 20 A RECEPT, RECORDS A104  RECEPT, OFFICE A102 20 A 1 1 12 11 7 20 5 900 1 180 10 112 1 1 20 A RECEPT, RECORDS A104  RECEPT, OFFICE A102 20 A 1 1 12 11 7 20 5 900 1 180 10 112 1 1 20 A RECEPT, RECORDS A104  RECEPT, OFFICE A102 20 A 1 1 12 11 7 20 5 900 1 180 10 12 11 2 1 20 A RECEPT, RECORDS A104  RECEPT, OFFICE A102 20 A 1 1 12 11 7 20 5 900 1 180 12 12 1 1 20 A RECEPT, RECORDS A104  RECEPT, OFFICE A102 20 A 1 1 12 11 7 5 50 900 1 180 12 12 1 1 20 A RECEPT, RECEPT, RECORDS A104  RECEPT, OFFICE A102 20 A 1 1 12 11 7 5 50 900 1 16 12 1 1 20 A RECEPT, RECEPT, RECORDS A104  RECEPT, OFFICE A102 20 A 1 1 12 11 7 5 50 900 1 16 12 1 1 20 A RECEPT, RECEPT, RECORDS A104  RECEPT, NURSE A113 20 A 1 1 12 19 900 90 900 900 900 900 900 900 900 9
PANEL: L2	PANEL: L4   TYPE:   Type 1   VOLTS:   120/208 Y   PHASE:   3   WIRES:   4	PANEL: L6
PANEL   L2   TYPE   Type   VOLTS:   120208 Y   PHASE   3   MIRES   4	PANEL L4	PANEL: L6
PANEL   12	PANEL   LA	PANEL L6
PANEL     2	PANEL   LA	PANEL   15
PANEL   L2	PANEL   MOUNTING: SURFACE	PANEL   L6
PANEL: 12 TYPE: Type: 1 VOLTS: 120:08 Y PHASE: 3 WIRES: 4  MOUNTING: SURFACE  BUSSING:	PANEL 14 TYPE: Type 1 VOLTS: 130/208 Y PHASE: 3 WIRES: 4  MOUNTING: SUPPACE  BUSSING:	PANEL   L6
PANEL     2	PANEL	PANEL   LS

, mande and the contraction of t

# PANELBOARD GENERAL NOTES

PROVIDE EQUIPMENT LABELING PER SPECIFICATIONS 26 0553. THE LABEL SHALL IDENTIFY THE DEVICE OR EQUIPMENT WHERE THE POWER SUPPLE ORIGINATES, AND THE SYSTEM VOLTAGE, PHASE OR LINE AND SYSTEM AT TALL TERMINATION, CONNECTION, AND SPLICE POINTS. FOR EXAMPLE: FEEDER POWER SUPPLY FOR PANEL "XX" ORIGINATES AT PANEL "XX" (OR SWITCHBOARD "XX", TRANSFORMER "XX", SWITCH "XX", ETC.); 120/208 VOLTS, 3-PHASE, PHASE COLOR IDENTIFICATION (OR 120/240, 277/480, ETC.).

PROVIDE TYPED PANELBOARD INDEXES AS EACH PANELBOARD. FILL OUT PANELBOARD'S CIRCUIT DIRECTORY CARD UPON COMPLETION OF INSTALLATION WORK. UTILIZE ACTUAL FINAL BUILDING ROOM NUMBERS, NOT ARCHITECTURAL NUMBERS USED ON DRAWINGS. IDENTIFY INDIVIDUAL LIGHTING CIRCUITS, INDIVIDUAL RECEPTACLE CIRCUITS BY ROOM SERVER, LIGHTING CIRCUITS, INDIVIDUAL RECEPTACLE CIRCUITS BY ROOM NUMBERS AND EQUIPMENT NAMES. INCLUDE ROOM NUMBER WITH EQUIPMENT CIRCUIT DESIGNATIONS. ALL DIRECTORIES TO BE TYPEWRITTEN.

PROVIDE AIC AND ARC-FLASH HAZARD LABELS PER THE SPECIFICATIONS AND NEC. ALL MECHANICAL AND KITCHEN EQUIPMENT BREAKERS TO BE SIZED PER THE MECHANICAL EQUIPMENT

SCHEDULE AND KITCHEN EQUIPMENT SCHEDULE.

minime menter and the contraction of the contractio

PROVIDE ALL REQUIRED LUG ADAPTERS, PIN REDUCERS, POLARIS LUG KITS, ETC. AS REQUIRED. PROVIDE NEC SIZED JUNCTION BOX AHEAD OF PANELBOARD/GEAR AS NEEDED TO LOCATED AND TERMINATE CONDUCTORS ON POLARIS LUG ADAPTERS (<10' FROM FINAL TERMINATION AT PANELBOARD). SIZE DOWN TO CONDUCTORS THAT FIT THE AVAILABLE LUGS AND/OR BREAKERS.

INDEX OF PANELBOARD SCHEDULE					
L1	L3	L5			
L2	L4	L6			







©2023 MHTN ARCHITECTS, INC.  Confidentiality Notice: This document is intended for use on the Project identifi		
This document is intended for use on the Project identifi		
and companies involved in the design, permitting, biddir the Project. MHTN Architects, Inc. grants limited rights reproduce this document for this express purpose only. copying this document for purposes other than those in prohibited. If a digital copy of this document is received	ig and constru to distribute a Distribution, p dicated is stric	oction nd orintin otly



BRIAN HICKS No. 77090374202  No. 77090374202  TE OF UTIM
I PROJECT NO. 2024528
al drawing is 30 x 42. Do not scale contents of this drawing.

iginal d	- i	24528 Do not scale contents of this drawing.			
EVISIONS INTRACTOR TO VERIFY DRAWINGS IN FIELD USE REFLECT IST REVISION DATE.					
0.△	DATE	DESCRIPTION			
1	9/6/24	Addendum #1			
SUE					
ON	ISTRUCT	ION DOCUMENTS			
_					
UG	UST 29,	2024			

PANELBOARD SCHEDULES

· · · · · · · · · · · · · · · · · · ·	2	3		~~~~~~~~~~~~~~~~~~~~~~~~~~~~~~~~~~~~~~~	4		5
PANELBOARD	SCHEDULE	PANEL	BOARD SCHEDULE		F	PANELBOARD SCHED	ULE
MOUNTING: SURFACE LOCA' BUSSING: FED FI	MAINS:   480/277 Y   PHASE:   3   WIRES:   4	PANEL: H1 TYPE:  MOUNTING: SURFACE  BUSSING:	Type 1 VOLTS: 480/277 Y PHASE: 3  LOCATION: ELECTRICAL A142  FED FROM: MDP  AMP: 225 A	WIRES: 4	PANEL: HM1  MOUNTING: SURFACE  BUSSING:	TYPE: Type 1 VOLTS: 480/277 Y  LOCATION: ELECTRICAL A142 FED FROM: MDP AMP: 225 A	PHASE:         3         WIRES:         4           MAINS:         MLO           SUBFEED LUGS         X         DOOR-IN-DOOR           ISO GROUND         200% NEUTRAL           SPD
LIGHTING, Room B122, B135A   20 A	A B C NO. SIZE POLE TYPE AMPS ITEM  13		408	AMPS	RT-1 20 A 3	1       1995       2660       2         -       -       3       1995       2660       4         -       -       5       1995       2660       6         -       -       5       1995       1995       1995       10         -       -       9       1995       1995       12       12       12       13       2660       1995       14       14       12       14       14       14       15       2660       1995       16       16       16       1995       18       16       1995       18       18       19       2660       2660       20       20       SIZE   POLE   TYPE   AMPS   ITEM
		NOTES:	CIRCUIT BREAKER TYPE: <blank> THERMAL MAGNETIC CIRCUIT BREAKER GF 5 mA GROUND FAULT CIRCUIT BREAKER AF ARC-FAULT CIRCUIT BREAKER CO COMBINATION AFCI/GFCI CIRCUIT BREA EG 30 mA EQUIPMENT GROUND FAULT CIR ST SHUNT TRIP CIRCUIT BREAKER</blank>	R KER	NOTES:	GF 5 mA GROUND FA AF ARC-FAULT CIRC CO COMBINATION AF	FCI/GFCI CIRCUIT BREAKER NT GROUND FAULT CIRCUIT BREAKER
PANELBOARD	SCHEDULE	PANEL	BOARD SCHEDULE		F	PANELBOARD SCHED	ULE
MOUNTING: SURFACE LOCA' BUSSING: FED FI	DLTS:   120/208 Y	PANEL: LM1 TYPE:  MOUNTING: SURFACE  BUSSING:	Type 1 VOLTS: 120/208 Y PHASE: 3  LOCATION: ELECTRICAL A142  FED FROM: LDP  AMP: 225 A	WIRES: 4  MAINS: MLO  SUBFEED LUGS X DOOR-IN-DOOR ISO GROUND 200% NEUTRAL SPD	PANEL: LM2  MOUNTING: SURFACE  BUSSING:	TYPE: Type 1 VOLTS: 120/208 Y  LOCATION: MECH B134  FED FROM: LDP  AMP: 225 A	PHASE:         3         WIRES:         4           MAINS:         MLO           SUBFEED LUGS         X         DOOR-IN-DOOR           ISO GROUND         200% NEUTRAL           SPD
ITEM	A B C NO. SIZE POLE TYPE AMPS ITEM  0 2 1 20 A SPARE  0 0 4 1 20 A SPARE  0 0 6 1 20 A SPARE  0 8 1 20 A SPARE  0 10 1 20 A SPARE  0 11 20 A SPARE  12 1 SPACE ONLY  12 1 SPACE ONLY  14 1 SPACE ONLY  16 1 SPACE ONLY  SPACE ONLY	ITEM	540     456     4 12 1       456     456     6 12 1       96     456     8 12 1       1165     600     10 12 1       65     456     14 12 1       1165     456     14 12 1       65     456     16 12 1       0     0 18 1       0     0 20 1       0 22 1     0 24 1       0 26 1     1	AMPS ITEM  20 A EF-10  20 A EF-6  20 A EF-7  20 A EF-7  20 A EF-8  20 A GENERATOR HEATER  20 A BATTERY CHARGER  20 A EF-5  20 A SPARE  20 A SPARE	RECEPT, Room B130, B133, 20 A 1  CP-1 20 A 1  EUH-2 25 A 2   BUS 20 A 2  FIRE ALARM, MECH B134 20 A 1  SPARE 20 A 1  SPARE 20 A 1  SPARE 20 A 1	12     1     1200     360     2       12     3     696     456     4       12     5     720     960     6       12     7     528     2500     8       10     9     2500     2500     10       10     -     -11     2500     456     12       12     6     13     750     456     14	SIZE         POLE         TYPE         AMPS         ITEM           12         1         20 A         RECEPT, Room B131, B132           12         1         20 A         EF-2           12         1         20 A         WH-1           10         2         25 A         EUH-1                 12         1         20 A         EF-3           12         1         20 A         EF-1           12         1         20 A         RECEPT            1          20 A         SPARE            1          20 A         SPARE            1          20 A         SPARE

AMPS RMS SYSM.

Total Conn. Load: 1440 VA Total Est. Demand: 1440 VA Total Conn. Current: 4 A Total Est. Demand Current: 4 A

Estimated Demand

1440 VA

THERMAL MAGNETIC CIRCUIT BREAKER 5 mA GROUND FAULT CIRCUIT BREAKER ARC-FAULT CIRCUIT BREAKER

COMBINATION AFCI/GFCI CIRCUIT BREAKER

30 mA EQUIPMENT GROUND FAULT CIRCUIT BREAKER
SHUNT TRIP CIRCUIT BREAKER

CIRCUIT BREAKER TYPE:

100.00%

Load Classification

PANEL: H1				_ т	/PE: _	T	уре 1		VOLTS	:	480/277	Υ	_ PHA	SE:	3		WIRES:	4
MOUNTING: SURFACE								10	CATION	· FLFC	TRICAL A	142				MA	INS: MLO	
BUSSING:				_					D FROM								-	BFEED LUGS
				_														OR-IN-DOOR
									AWII				_					
																		O GROUND
																	200	0% NEUTRAL
																	SPI	D
							RF	RANCHI	BREAKE	RS								
				WIRE	CIR.		<u> </u>					CIR.	WIRE					
ITEM	AMPS	TYPE	POLE			Α	В	С	A	В	С	NO.		POLE	TYPE	AMPS		ITEM
LIGHTING, Room A116, A126	20 A		1	12	1	44	100		145			2	12	1		20 A		SHTING
LIGHTING	20 A		1	12	3		408	1400		282	007	4	12	1				er, Room A150, A
LIGHTING, Room A146, A147,	20 A		1	12	5	154		1488	251		227	6	12	1				TDOOR PLAY A
LIGHTING, MULTIPURPOSE	20 A		1	12	7	154	250		351	107		8	12	1				er, CONFERENC LTIPURPOSE B
IGHTING, VIRTUAL SCHOOLS LIGHTING, Room A100, A103	20 A 20 A		1	12 12	9		350	415		187	715	10 12	12 12	1		20 A		CHPORPOSE B
						957		415	1100		715							
LIGHTING, Room B110, B115	20 A		1	12	13	857	4407		1198	1005		14	12	1		20 A		G, MECH B134
LIGHTING	20 A		1	12	15		1137	1001		1025	1000	16	12	1		20 A		SHTING
LIGHTING, CUSTODIAL B133	20 A		1	12	17	=		1234			1882	18	12	1		20 A		GHTING
LIGHTING	20 A		1	12	19	1445			1111			20	12	1		20 A		HTING
LIGHTING, STUDENT	20 A		1	12	21		1771			840		22	12	1		20 A		CORRIDOR A14
LIGHTING	20 A		1	12	23			1059			2699	24	12	1		20 A	-	Room A142, A14
SPARE	20 A		1		25	0			1394			26	12	1		20 A		GHTING
SPARE	20 A		1		27		0			0		28		1		20 A	SI	PARE
SPARE	20 A		1		29			0			0	30		1		20 A	S	PARE
SPARE	20 A		1		31	0			0			32		1		20 A	S	PARE
SPARE	20 A		1		33		0			0		34		1		20 A	S	PARE
SPARE	20 A		1		35			0			0	36		1	1	20 A	S	PARE
SPARE	20 A		1		37	0			0			38		1		20 A	S	PARE
SPARE	20 A		1		39		0			0		40		1		20 A	S	PARE
SPACE ONLY			1		41							42		1			SPAC	CE ONLY
SPACE ONLY			1		43							44		1			SPAC	CE ONLY
SPACE ONLY			1		45							46		1			SPAC	CE ONLY
SPACE ONLY	-		1		47							48		1	-		SPAC	CE ONLY
SPACE ONLY			1		49							50		1			SPAC	CE ONLY
SPACE ONLY			1		51							52		1			SPAC	CE ONLY
SPACE ONLY			1		53							54		1			SPA0	CE ONLY
SPACE ONLY			1		55							56		1				CE ONLY
SPACE ONLY			1		57							58		1				CE ONLY
SPACE ONLY			1		59							60		1			SPAC	CE ONLY
FEED THRU LOAD						6698	6000	9719	TOTAL	(VA)							CONNECTE	ED LOAD TOTAL
0 VA						25 A	22 A	35 A	AMPS/F									417 VA
0 VA						23 /	22 /	33 A	] AIVIF O/F	TIAGE						_		417 VA
											AIC	RATII	NG		3000	0	AMPS I	RMS SYSM.
101 17 11										T =								
oad Classification					nected		De	emand F		ESU	mated D					Pane	el Totals	
IGHTING					2047 \		-	125.00			27559 V						1 00447.74	
ther					370 V	4		100.00	%		370 VA	١				al Conn. Load		
																Est. Demand		
															Total (	Conn. Current	: 27 A	
														Total	Est. De	mand Current	: 34 A	
IOTES:								CII	RCUIT BE	REAKER	TYPE							
									<blank< td=""><td>&gt; TH</td><td>ERMAL</td><td></td><td></td><td></td><td></td><td></td><td></td><td></td></blank<>	> TH	ERMAL							
									GF AF		nA GROU C-FAUL					KER		
									CO		MBINAT					EAKER		
									EG							IRCUIT BREA	KER	
									ST	SH	IUNT TR	ir CIR	CUIIB	KEAKE	ĸ			

PANEL: LM2	WIRES:		3	SE:	_ PHA	Υ	120/208	:1	VOLTS		ype 1	T	/PE: _	_ TY				PANEL: LM1
MOUNTING: SURF	NS: MLO	MAIN				<b>4142</b>	RICAL	: ELECT	CATION	LC				_				MOUNTING: SURFACE
BUSSING:	SUBFEED LUGS								D FROM	FE				_				BUSSING:
	X DOOR-IN-DOOR				_			: 225 A	AMP									
	ISO GROUND																	
	200% NEUTRAL																	
	SPD																	
								RS	BREAKE	RANCH E	BF							
ITEM	ITEM	AMPS	TYPE	POLE	WIRE SIZE	CIR. NO.	С	В	A	С	В	Α	CIR. NO.	WIRE SIZE	POLE	TYPE	AMPS	ITEM
, PREP & STORAGE B1	EF-10	20 A		1	12	2			456			900	1	12	1		20 A	RECEPT
EF-12	EF-6	20 A		1	12	4		456			540		3	12	1		20 A	RECEPT
RECEPT, Room B130, B1	EF-7	20 A		1	12	6	456		4	456			5	12	1		20 A	EF-9
CP-1	EF-8	20 A		1	12	8			456		4405	696	7	12	1		20 A	EF-11
EUH-2	GENERATOR HEATER	20 A		1	12	10	000	600		4405	1165		9		2		20 A	ACO - 2
	BATTERY CHARGER EF-4	20 A 20 A		1	12 12	12 14	600		456	1165		1165	11		2			 ACO - 1
BUS	EF-4 EF-5	20 A		1	12	16		456	436		1165	1100	13 15				20 A 	ACU - I
FIRE ALARM, MECH B1	SPARE	20 A		1		18	0	430		0	1100		17		1		20 A	SPARE
SPARE	SPARE	20 A		1		20	0		0	0		0	19		1		20 A	SPARE
SPARE	SPARE	20 A		1		22		0	ŭ				21		1			SPACE ONLY
SPARE	SPARE	20 A		1		24	0						23		1			SPACE ONLY
SPARE	SPARE	20 A		1		26			0				25		1			SPACE ONLY
SPARE	SPARE	20 A		1		28		0					27		1			SPACE ONLY
SPARE	SPACE ONLY			1		30							29		1			SPACE ONLY
SPARE	SPACE ONLY			1		32							31		1			SPACE ONLY
SPARE	SPACE ONLY			1		34					-		33		1			SPACE ONLY
SPARE	SPACE ONLY			1		36							35		1			SPACE ONLY
SPACE ONLY	SPACE ONLY			1		38							37		1			SPACE ONLY
SPACE ONLY	SPACE ONLY			1		40							39		1			SPACE ONLY
SPACE ONLY	SPACE ONLY			1		42							41		1			SPACE ONLY
FEED THRU LOAD	CONNECTED LOAD TOTAL							()/A)	TOTAL	2677	4382	4129						FEED THRU LOAD
ł	+								ł				-					
0 VA	11187 VA							HASE	AMPS/F	22 A	38 A	36 A	l				-	0 VA
	AMPS RMS SYSM.		22000		IG .	RATIN	AIC											
Load Classification	I Totals	Panel				emand	nated De	Estir	actor	emand F	De	Load	nected	Conr				d Classification
HVAC						A	8547 V		%	100.00		A	3547 V	8				AC
POWER	11187 VA	Conn. Load:	Total			A	2640 V		%	100.00		A	2640 V	2				CEPT
RECEPT	11187 VA	st. Demand:	Total E															
	31 A	onn. Current:	Total Co															
		and Current:		Total														
NOTES:			DEALCE	DOLUT.		14401			RCUIT BE									TES:
							ERMAL 1A GROI		 BLANK: GF									
				EAKER	UIT BF	T CIRC	C-FAUL	AR	AF									
	KER	AKER RCUIT BREAK					MBINAT mA EQU		CO EG									
		·—· <b>··</b>					UNT TR		ST									

1 4

PROVIDE EQUIPMENT LABELING PER SPECIFICATIONS 26 0553. THE LABEL SHALL IDENTIFY THE DEVICE OR EQUIPMENT WHERE THE POWER SUPPLE ORIGINATES, AND THE SYSTEM VOLTAGE, PHASE OR LINE AND SYSTEM AT TALL TERMINATION, CONNECTION, AND SPLICE POINTS. FOR EXAMPLE: FEEDER POWER

SUPPLY FOR PANEL "XX" ORIGINATES AT PANEL "XX" (OR SWITCHBOARD "XX", TRANSFORMER "XX", SWITCH

ALL MECHANICAL AND KITCHEN EQUIPMENT BREAKERS TO BE SIZED PER THE MECHANICAL EQUIPMENT SCHEDULE AND KITCHEN EQUIPMENT SCHEDULE.

PROVIDE ALL REQUIRED LUG ADAPTERS, PIN REDUCERS, POLARIS LUG KITS, ETC. AS REQUIRED. PROVIDE NEC SIZED JUNCTION BOX AHEAD OF PANELBOARD/GEAR AS NEEDED TO LOCATED AND TERMINATE CONDUCTORS ON POLARIS LUG ADAPTERS (<10' FROM FINAL TERMINATION AT PANELBOARD). SIZE DOWN TO CONDUCTORS THAT FIT THE AVAILABLE LUGS AND/OR BREAKERS.

"XX", ETC.); 120/208 VOLTS, 3-PHASE, PHASE COLOR IDENTIFICATION (OR 120/240, 277/480, ETC.). PROVIDE TYPED PANELBOARD INDEXES AS EACH PANELBOARD. FILL OUT PANELBOARD'S CIRCUIT DIRECTORY CARD UPON COMPLETION OF INSTALLATION WORK. UTILIZE ACTUAL FINAL BUILDING ROOM NUMBERS, NOT ARCHITECTURAL NUMBERS USED ON DRAWINGS. IDENTIFY INDIVIDUAL LIGHTING CIRCUITS, INDIVIDUAL RECEPTACLE CIRCUITS BY ROOM SERVER, LIGHTING CIRCUITS, INDIVIDUAL RECEPTACLE CIRCUITS BY ROOM NUMBERS AND EQUIPMENT NAMES. INCLUDE ROOM NUMBER WITH EQUIPMENT CIRCUIT DESIGNATIONS. ALL DIRECTORIES TO BE TYPEWRITTEN.

PROVIDE AIC AND ARC-FLASH HAZARD LABELS PER THE SPECIFICATIONS AND NEC.

														. 3.01		mand Current	-
NOTES:								CI	RCUIT B								
									<blank GF AF CO EG ST</blank 	5 r AF CC 30	ERMAL nA GRO C-FAUL MBINAT mA EQU	UND F T CIR( TION A JIPMEI	AULT ( CUIT BI FCI/GF NT GR(	CIRCUIT REAKER CI CIRC DUND F	BREAK R CUIT BR AULT C	ŒR	sKER
			P	A۱	١E	LB	OA	٩R	D S	SC	HE	D	UL	Ε			
PANEL: LM2				_ T`	YPE: _	T	ype 1		VOLTS	S:	120/208	Υ	PH/	ASE:	3		WIRES: 4
MOUNTING: SURFACE								10	OCATION	I MECH	R134					MΔI	INS: MLO
BUSSING:				_					ED FROM		10104						SUBFEED LUG
				_													<del></del>
									AMF	225 A			_				X DOOR-IN-DOO
																	ISO GROUND200% NEUTRAISPD
		1	1	ı			ВІ	RANCH	BREAKE	RS				ı		<del></del>	
ITEM	AMPS	TYPE	POLE	WIRE	CIR.	A	В	c	A	В	c	CIR. NO.	WIRE	POLE	TYPE	AMPS	ITEM
, PREP & STORAGE B129	20 A	11172	1	12	1	1200			360			2	12	1	1117	20 A	RECEPT, Room B131, B
EF-12	20 A		1	12	3	.= 0	696			456		4	12	1		20 A	EF-2
RECEPT, Room B130, B133,	20 A		1	12	5			720			960	6	12	1		20 A	WH-1
CP-1	20 A		1	12	7	528			2500			8	10	2		25 A	EUH-1
EUH-2	25 A		2	10	9		2500			2500		10					
					11			2500			456	12	12	1		20 A	EF-3
BUS	20 A		2	6	13	750			456			14	12	1		20 A	EF-1
					15		750			900		16	12	1		20 A	RECEPT
FIRE ALARM, MECH B134	20 A		1	12	17			500			1080	18	12	1		20 A	RECEPT
SPARE	20 A		1		19	0			1080			20	12	1		20 A	RECEPT
SPARE	20 A		1		21		0			0		22		1		20 A	SPARE
SPARE	20 A		1		23			0			0	24		1		20 A	SPARE
SPARE	20 A		1		25	0			0			26		1		20 A	SPARE
SPARE	20 A		1		27		0			0		28		1		20 A	SPARE
SPARE	20 A		1		29			0			0	30		1		20 A	SPARE
SPARE	20 A		1		31	0			0			32		1		20 A	SPARE
SPARE	20 A		1		33		0			0		34		1		20 A	SPARE
SPARE	20 A		1		35			0			0	36		1		20 A	SPARE
SPACE ONLY			1		37				0			38		1		20 A	SPARE
SPACE ONLY			1		39							40		1			SPACE ONLY
SPACE ONLY			1		41							42		1			SPACE ONLY
FEED THRU LOAD						6874	7802	6216	TOTAL								CONNECTED LOAD TO
0 VA						58 A	66 A	52 A	AMPS/I	PHASE						_	20392 VA
											AIC	RATII	NG		22000	0	AMPS RMS SYSM.
Load Classification				Con	nected	Load	D	emand F	actor	Esti	mated D	emano				Pane	el Totals
HVAC				1	4752 \	/A		100.00	)%		14752 \	/A					
POWER					1500 V	'A		100.00	)%		1500 V	A			Tota	al Conn. Load	: 20392 VA
RECEPT				4	4140 V	Ά		100.00	)%		4140 V	A			Total	Est. Demand	: 20392 VA
															Total C	Conn. Current	: 57 A
														Total	Est. Der	mand Current	: 57 A
NOTES:								l Cu	RCUIT B	REAKER	TYPF						
110110.								<del>-  </del> -	<blank< td=""><td></td><td>ERMAL</td><td>MAGN</td><td>FTIC</td><td>IRCLIIT</td><td>BREAK</td><td>FR</td><td></td></blank<>		ERMAL	MAGN	FTIC	IRCLIIT	BREAK	FR	
									GF AF CO EG ST	5 r AF CC 30	nA GRO C-FAUL MBINA	UND F T CIRO TION A JIPMEI	AULT ( CUIT BI FCI/GF NT GR(	CIRCUIT REAKER CI CIRC DUND F	BREAK R CUIT BR AULT C	ŒR	KER

EHL

ELL

INDEX OF PANELBOARD SCHEDULE

H1

LM1

LM2

[1  -  -																	Est. Demand Conn. Current	
ļ.																	E-4 D	
1														-			al Conn. Load	
t.	HVAC				1	13733	vA		100.00	%		113733 \	VA			<b>-</b>	al Came I a sel	. 112722 \/A
11								יט									Pane	er rotals
	Load Classification				Core	nected	Load	D	emand F	actor	Feti	mated D						el Totals
												AIC	RATII	NG		30000	0	AMPS RMS SYSM.
F	0 VA	-					137 A	137 A	137 A	AMPS/F	PHASE						_	113733 VA
	FEED THRU LOAD						37911	37911		TOTAL								CONNECTED LOAD TO
l	FFFD THE CAR						07044	07011	07044		0.443							001NF0TED : 0 : 5 = 5
Ĺ	SPARE	20 A		1		59			0			0	60		1		20 A	SPARE
	SPARE	20 A		1		57		0			0		58		1		20 A	SPARE
t	SPARE	20 A		1		55	0			0			56		1		20 A	SPARE
t	SPARE	20 A		1		53			0			0	54		1		20 A	SPARE
H	SPARE	20 A		1		51		0			0		52		1		20 A	SPARE
H	 SPARE	20 A		1		47	0		2000	0		1995	50		 1		20 A	 SPARE
F	<u></u>					45 47		2660	2660		1995	1995	46 48	<b></b>				<b></b>
F	RT-4	20 A		3		43	2660	2660		1995	1005		44		3		20 A	RT-21
ŀ	 DT 4					41	2000		2660	1005		1995	42					 DT 01
ŀ						39		2660	2600		1995	1005	40					
ŀ	RT-22	20 A		3		37	2660	2000		1995	1005		38		3		20 A	RT-10
ŀ	 DT 00					35	0000		1995	4005		2660	36					 DT 10
F						33		1995	10		2660	0000	34					
Ļ	RT-17	20 A		3		31	1995			2660			32		3		20 A	RT-11
L						29			2660			2660	30					
L						27		2660			2660		28					
L	RT-13	20 A		3		25	2660			2660			26		3		20 A	RT-20
Ĺ						23			2660			2660	24					
						21		2660			2660		22					
	RT-14	20 A		3		19	2660			2660			20		3		20 A	RT-16
						17			2660			1995	18					
Ī						15		2660			1995		16					
T	RT-18	20 A		3		13	2660			1995			14		3		20 A	RT-23
r						11			1995			1995	12					
t						9	1000	1995		1000	1995		10					
t	RT-25	20 A		3		7	1995		1000	1995		2000	8		3		20 A	RT-24
ŀ						5		1000	1995		2000	2660	6					<b></b>
t						3		1995			2660		4					
t	RT-1	20 A	ITFE	3		1	1995			2660			2		3	TIPE	20 A	RT-19

DIST	
O C C	
CH KN	
AN S N LE/	
ORDA!	

ARCHITECTS

280 South 400 West

www.mhtn.com

4225 Lake Park Blvd, Suite 275 West Valley City, UT 84120

> P: 801.532.2196 F: 801.532.2305

www.bnaconsulting.com

Suite 250 Salt Lake City, Utah 84101 Telephone (801) 595-6700

MHTN Architects, Inc.

		C
©2023 MHTN ARCHITECTS, INC.		
Confidentiality Notice: This document is intended for use on the land companies involved in the design, per the Project. MHTN Architects, Inc. grants reproduce this document for this express copying this document for purposes other	mitting, biddin limited rights ourpose only.	g and constru to distribute ar Distribution, p



MHTN PROJECT NO. 2024528
Original drawing is 30 x 42. Do not scale contents of this drawing.
REVISIONS

	· ·	Oo not scale contents of this drawing.
CONTRA	CTOR TO VERIF	Y DRAWINGS IN FIELD USE REFLECT
NO.	DATE	DESCRIPTION
2	09/13/2024	Addendum #2
	REVISIO CONTRA LAST RE	REVISIONS CONTRACTOR TO VERIFICAST REVISION DATE.  NO.

AUGUST 29, 2024 PANELBOARD

CONSTRUCTION DOCUMENTS

SCHEDULES

PANEL: L7				_ TY	PE: _	Ty	ype 1		VOLTS	:	120/208	Y	_ PHA	SE:	3		WIRES:4
MOUNTING: SURFACE								LC	CATION	: STOR	AGE B11	6				MAIN	NS: MLO
BUSSING:				_				FE	D FROM								SUBFEED LUGS
				_													DOOR-IN-DOOR
																	ISO GROUND
																	200% NEUTRAL
																	SPD
				WIRE	CIB		BI	RANCH I	BREAKE	RS		CIB	WIRE				
ITEM	AMPS	TYPE	POLE		NO.	Α	В	С	Α	В	C	NO.	SIZE	POLE	TYPE	AMPS	ITEM
RECEPT MULTIPURPOSE B119	20 A		1		1	360			360			2		1		20 A	RECEPT STORAGE B102
RECEPT MULTIPURPOSE B119	20 A		1		3		360			360		4		1		20 A	RECEPT STORAGE B102
RECEPT MULTIPURPOSE B119	20 A		1		5			360			360	6		1		20 A	RECEPT STORAGE B102
RECEPT MULTIPURPOSE B119	20 A		1		7	360						8					
RECEPT MULTIPURPOSE B119	20 A		1		9		360					10					
RECEPT MULTIPURPOSE B119	20 A		1		11			360				12					
RECEPT MULTIPURPOSE B119	20 A		1		13	360						14					
RECEPT MULTIPURPOSE B119	20 A		1		15		360					16					
RECEPT MULTIPURPOSE B119	20 A		1		17			360				18					
RECEPT MULTIPURPOSE B119	20 A		1		19	360						20					
RECEPT MULTIPURPOSE B119	20 A		1		21		360					22					
RECEPT MULTIPURPOSE B119	20 A		1		23			540				24					
Other	20 A		1		25	1060						26					
RECEPT STORAGE B124	20 A		1		27		360					28					
RECEPT STORAGE B124	20 A		1		29			360				30					
RECEPT STORAGE B124	20 A		1		31	540						32					
SPARE	20 A		1		33		0			0		34		1		20 A	SPARE
SPARE	20 A		1		35	_		0			0	36		1		20 A	SPARE
SPARE	20 A		1		37	0	_		0	_		38		1		20 A	SPARE
SPARE	20 A		1		39		0			0		40		1		20 A	SPARE
SPARE	20 A		1		41			0			0	42		1		20 A	SPARE
FEED THRU LOAD						3400	2160	2340	TOTAL	(VA)							CONNECTED LOAD TOTA
0 VA						29 A	18 A	20 A	AMPS/F	PHASE							7900 VA
											AIC	RATII	NG .				AMPS RMS SYSM.
oad Classification				Conr	ected	Load	D	emand F	actor	Estir	mated De	emand				Panel	Totals
Other					060 V		1	100.00			1060 V						
RECEPT					840 V		+	100.00			6840 V				Tota	al Conn. Load:	7900 VA
							+						$\vdash$			Est. Demand:	
							+									Conn. Current:	
			_				+							Total		mand Current:	
														· otal	_5 561	Guileil.	
OTES:									RCUIT BE					DC: ::=			
									<blank< td=""><td></td><td>ERMAL I 1A GROU</td><td></td><td></td><td></td><td></td><td></td><td></td></blank<>		ERMAL I 1A GROU						
									AF	AR	C-FAUL	T CIRC	CUIT BR	REAKER	₹		
									CO	$\sim$	MAINIAT		ECI/GE	CLCIRC	CUIT BRI	-AKER	

 $\mathcal{L}$ 

			P	AN	1F	LB	<b>O</b> F	4K	D S		HE	<b>:</b> D	UL	.上			
PANEL: HM2					/PE: _	Т	ype 1		VOLTS	i:	480/277	Υ	_ PHA	ASE:	3		WIRES: 4
MOUNTING: SURFACE								1.0	CATION	ı. MECH	D12/					MAII	NS: MLO
				_										-			
BUSSING:				_				FE	D FROM				-				SUBFEED LUGS
									AMP	: <u>225 A</u>			_				X DOOR-IN-DOOR
																	ISO GROUND
																	200% NEUTRAL
																	SPD
							RF	RANCHI	BREAKE	RS							
				WIRE	CIB							CIR.	WIRE				
ITEM	AMPS	TYPE	POLE	SIZE		Α	В	С	Α	В	С	NO.		POLE	TYPE	AMPS	ITEM
RT-2	20 A		3		1	1995			2660			2		3		20 A	RT-9
					3		1995			2660		4					
	1				5			1995			2660	6	-	-			
RT-3	20 A		3		7	2660			2660			8		3		20 A	RT-8
-					9		2660			2660		10					
					11			2660			2660	12					
RT-15	20 A		3		13	2660			2660			14		3		20 A	RT-7
					15		2660			2660		16					
					17			2660			2660	18					
RT-5	20 A		3		19	3769			1995			20		3		20 A	RT-12
					21	5703	3769		1000	1995		22					
					23		3708	3769		1990	1995	24	<del></del>				 
			<u> </u>		-	0700		3769	1.100		1995	_					
RT-6	20 A	ļ	3		25	3769	0700		1438	- 10		26		1		20 A	LIGHTING
					27		3769			40	_	28		1		20 A	LIGHTING
					29			3769			0	30		1		20 A	SPARE
SPARE	20 A		1		31	0			0			32		1		20 A	SPARE
SPARE	20 A		1		33		0			0		34		1		20 A	SPARE
SPARE	20 A		1		35			0			0	36		1		20 A	SPARE
SPARE	20 A		1		37	0			0			38		1		20 A	SPARE
SPARE	20 A		1		39		0					40		1			SPACE ONLY
SPARE	20 A		1		41			0				42		1			SPACE ONLY
SPACE ONLY			1		43							44		1			SPACE ONLY
SPACE ONLY	-		1		45							46		1			SPACE ONLY
SPACE ONLY			1		47							48		1			SPACE ONLY
SPACE ONLY			1		49							50		1			SPACE ONLY
SPACE ONLY			1		51							52		1			SPACE ONLY
SPACE ONLY			1		53							54		1			SPACE ONLY
SPACE ONLY			1		55							56		1			SPACE ONLY
SPACE ONLY			1		57							58		1			SPACE ONLY
SPACE ONLY			1		59							60		1			SPACE ONLY
57.1.52 57.12																	
FEED THRU LOAD						26269	24871	24831	TOTAL	(VA)							CONNECTED LOAD TOTA
0 VA						95 A	90 A	<b>-</b>	AMPS/F								75970 VA
0 7/1	•					3071	3071	3071	],,,,,,,,,,,,,,,,,,,,,,,,,,,,,,,,,,,,,,	TITOL							70070 V/1
											AIC	RATII	NG		30000	0	AMPS RMS SYSM.
										-		_					
l Classification					nected		D	emand F		Esti	mated D		1			Pane	Totals
С				7	4492 \	/A		100.00	%		74492 \	/A					
HTING				•	1478 V	Ά		125.00	%		1848 V	Α			Tota	al Conn. Load:	75970 VA
															Total	Est. Demand:	76340 VA
															Total C	Conn. Current:	91 A
							+			1				Total		mand Current:	
														i Utal	_3t. Del	ana Guirent.	V= / \
ES:								CIF	RCUIT BI	REAKER	TYPE:						I
									<blank< td=""><td>&gt; TH</td><td>ERMAL</td><td></td><td></td><td></td><td>BREAK</td><td></td><td></td></blank<>	> TH	ERMAL				BREAK		
									GF						BREAK	ŒR	
									AF CO		C-FAUL				₹ CUIT BRI	FAKFR	
									EG							IRCUIT BREAI	(FR
									LG	50	1111/ L C	)		001101	, (OL )	II (OOII DI LE) (I	\

INDEX OF PANELBOARD SCHEDULE


HM2





# RDAN LEARNING CENTER

			(.)	Ο,
This document is intended for use on the Project identified herein by individuand companies involved in the design, permitting, bidding and construction of the Project. MHTN Architects, Inc. grants limited rights to distribute and reproduce this document for this express purpose only. Distribution, printing copying this document for purposes other than those indicated is strictly	©2023 MHTN ARCHITECTS, INC.			
	and companies involved in the design, per the Project. MHTN Architects, Inc. grants reproduce this document for this express copying this document for purposes other	mitting, bidding limited rights to purpose only. E than those indi	g and construction distribute and Distribution, prinicated is strictly	on of

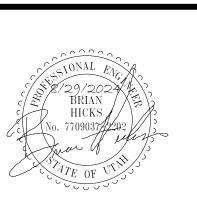

MHTN P	ROJECT NO. 20	024528
Original d	rawing is 30 x 42	. Do not scale contents of this drawing.
	_	<del>-</del>
REVISIO		IFY DRAWINGS IN FIELD USE REFLEC
	EVISION DATE.	IF T DRAWINGS IN FIELD USE REFLEC
NO.	DATE	DESCRIPTION
2	09/13/2024	Addendum #2
	00/10/2021	/ ladolidalii // L

CONSTRUCTION DOCUMENTS
AUGUST 29, 2024

PANEL BOARD SCHEDULES

**1277** 

PANFI	ROARD (	GENERAL	NOTES

PROVIDE EQUIPMENT LABELING PER SPECIFICATIONS 26 0553. THE LABEL SHALL IDENTIFY THE DEVICE OR EQUIPMENT WHERE THE POWER SUPPLE ORIGINATES, AND THE SYSTEM VOLTAGE, PHASE OR LINE AND SYSTEM AT TALL TERMINATION, CONNECTION, AND SPLICE POINTS. FOR EXAMPLE: FEEDER POWER SUPPLY FOR PANEL "XX" ORIGINATES AT PANEL "XX" (OR SWITCHBOARD "XX", TRANSFORMER "XX", SWITCH "XX" FTC.): 120/208 VOLTS: 3-PHASE, PHASE COLOR IDENTIFICATION (OR 120/240, 277/480, FTC.)

- 2. PROVIDE TYPED PANELBOARD INDEXES AS EACH PANELBOARD. FILL OUT PANELBOARD'S CIRCUIT DIRECTORY CARD UPON COMPLETION OF INSTALLATION WORK. UTILIZE ACTUAL FINAL BUILDING ROOM NUMBERS, NOT ARCHITECTURAL NUMBERS USED ON DRAWINGS. IDENTIFY INDIVIDUAL LIGHTING CIRCUITS, INDIVIDUAL RECEPTACLE CIRCUITS BY ROOM SERVER, LIGHTING CIRCUITS, INDIVIDUAL RECEPTACLE CIRCUITS BY ROOM NUMBERS AND EQUIPMENT NAMES. INCLUDE ROOM NUMBER WITH EQUIPMENT CIRCUIT DESIGNATIONS. ALL DIRECTORIES TO BE TYPEWRITTEN.
- PROVIDE AIC AND ARC-FLASH HAZARD LABELS PER THE SPECIFICATIONS AND NEC.
- . ALL MECHANICAL AND KITCHEN EQUIPMENT BREAKERS TO BE SIZED PER THE MECHANICAL EQUIPMENT SCHEDULE AND KITCHEN EQUIPMENT SCHEDULE.
- 5. PROVIDE ALL REQUIRED LUG ADAPTERS, PIN REDUCERS, POLARIS LUG KITS, ETC. AS REQUIRED. PROVIDE NEC SIZED JUNCTION BOX AHEAD OF PANELBOARD/GEAR AS NEEDED TO LOCATED AND TERMINATE CONDUCTORS ON POLARIS LUG ADAPTERS (<10' FROM FINAL TERMINATION AT PANELBOARD). SIZE DOWN TO CONDUCTORS THAT FIT THE AVAILABLE LUGS AND/OR BREAKERS.

Y1 MULLION MOUNTED CREDENTIAL CARD READER.

Y2 PRIOR TO STARTING ANY WORK OR ROUGH-IN COORDINATE WITH THE SCHOOL DISTRICT AND FIND OUT THE EXACT LOCATION AND THE MOUNTING HEIGHTS FOR THE SOLO INTERCOM DOOR STATIONS, AND DISCUSS THE OPERATIONAL REQUIREMENTS FOR EACH ONE. PROVIDE ALL OF THE NECESSARY CABLING THAT HOME RUNS BACK TO THE ACCESS CONTROL HEAD-END PANEL, THE VIDEO SURVEILLANCE NVR, AND TO THERE SIP PHONE SYSTEM. IT IS THE SECURITY CONTRACTOR IS RESPONSIBILITY TO PROVIDE A COMPLETE AND FULLY FUNCTIONING INTERCOM SYSTEM THAT MEETS THE MANUFACTURER'S SPECIFICATIONS AND OPERATES TO THE SCHOOL DISTRICTS REQUIREMENTS AND INSTRUCTIONS.

PRIOR TO STARTING ANY WORK OR ROUGH-IN COORDINATE A MEETING WITH THE SCHOOL DISTRICT AND THE MILLWORK DRAWINGS FOR THE EXACT LOCATION AND THE OPERATIONAL REQUIREMENTS FOR THE DOOR RELEASE BUTTON ON THE RECEPTIONIST DESK IN AREA #A154. PROVIDE ALL OF THE NECESSARY CABLING THAT WILL HOME RUN BACK TO THE ACCESS CONTROL HEAD-END PANEL. PROGRAM THE MOMENTARY DOOR RELEASE BUTTON TO OPERATE WITH THE ELECTRIFIED DOOR HARDWARE ON DOOR #A154. IT IS THE SECURITY CONTRACTOR RESPONSIBILITY TO PROVIDE A COMPLETE AND FULLY FUNCTIONING DOOR RELEASE SYSTEM THAT MEETS THE MANUFACTURER'S SPECIFICATIONS AND OPERATES TO THE SCHOOL DISTRICTS REQUIREMENTS AND INSTRUCTIONS.

PRIOR TO STARTING ANY WORK OR ROUGH-IN COORDINATE A MEETING WITH THE SCHOOL DISTRICT AND THE MILLWORK DRAWINGS FOR THE EXACT LOCATION AND THE OPERATIONAL REQUIREMENTS FOR THE DOOR RELEASE BUTTON ON THE RECEPTIONIST DESK IN AREA #A103. PROVIDE ALL OF THE NECESSARY CABLING THAT WILL HOME RUN BACK TO THE ACCESS CONTROL HEAD-END PANEL. PROGRAM THE MOMENTARY DOOR RELEASE BUTTON TO OPERATE WITH THE ELECTRIFIED DOOR HARDWARE ON DOOR #A100. IT IS THE SECURITY CONTRACTOR RESPONSIBILITY TO PROVIDE A COMPLETE AND FULLY FUNCTIONING DOOR RELEASE SYSTEM THAT MEETS THE MANUFACTURER'S SPECIFICATIONS AND OPERATES TO THE SCHOOL DISTRICTS REQUIREMENTS AND INSTRUCTIONS.

PRIOR TO STARTING ANY WORK OR ROUGH-IN COORDINATE A MEETING WITH THE SCHOOL DISTRICT AND THE MILLWORK DRAWINGS FOR THE EXACT LOCATION AND THE OPERATIONAL REQUIREMENTS FOR THE SCHOOL LOCKDOWN BUTTONS ON THE RECEPTIONIST DESKS. PROVIDE ALL OF THE NECESSARY CABLING THAT WILL HOME RUN BACK TO THE ACCESS CONTROL HEAD-END PANEL AND TO THE INTRUSION DETECTION HEAD-END PANEL. IT IS THE SECURITY CONTRACTOR RESPONSIBILITY TO PROVIDE A COMPLETE AND FULLY FUNCTIONING LOCKDOWN SYSTEM THAT MEETS THE MANUFACTURER'S SPECIFICATIONS AND OPERATES TO THE SCHOOL DISTRICTS REQUIREMENTS AND INSTRUCTIONS.

MOUNT SMOKE DETECTOR WITHIN SKYLIGHT. COORDINATE MOUNTING DETAILS WITH ARCHITECTURAL



MHTN Architects, Inc. 280 South 400 West Suite 250 Salt Lake City, Utah 84101 Telephone (801) 595-6700 www.mhtn.com

4225 Lake Park Blvd, Suite 275 West Valley City, UT 84120 P: 801.532.2196 F: 801.532.2305 www.bnaconsulting.com

	7	S S
©2023 MHTN ARCHITECTS,	i, INC.	
Confidentiality Notice: This document is intended for use and companies involved in the the Project. MHTN Architects, reproduce this document for this copying this document for purp prohibited. If a digital copy of the	design, permitting, biddir Inc. grants limited rights is express purpose only. coses other than those inc	ng and construction of to distribute and Distribution, printing o dicated is strictly

MHTN PROJECT NO. 2024528

REVISIONS CONTRACTOR TO VERIFY DRAWINGS IN FIELD USE REFLECT LAST REVISION DATE.


CONSTRUCTION DOCUMENTS

AUGUST 29, 2024

FIRST FLOOR SYSTEM PLAN -AREA A

**KEY PLAN** 

E411A

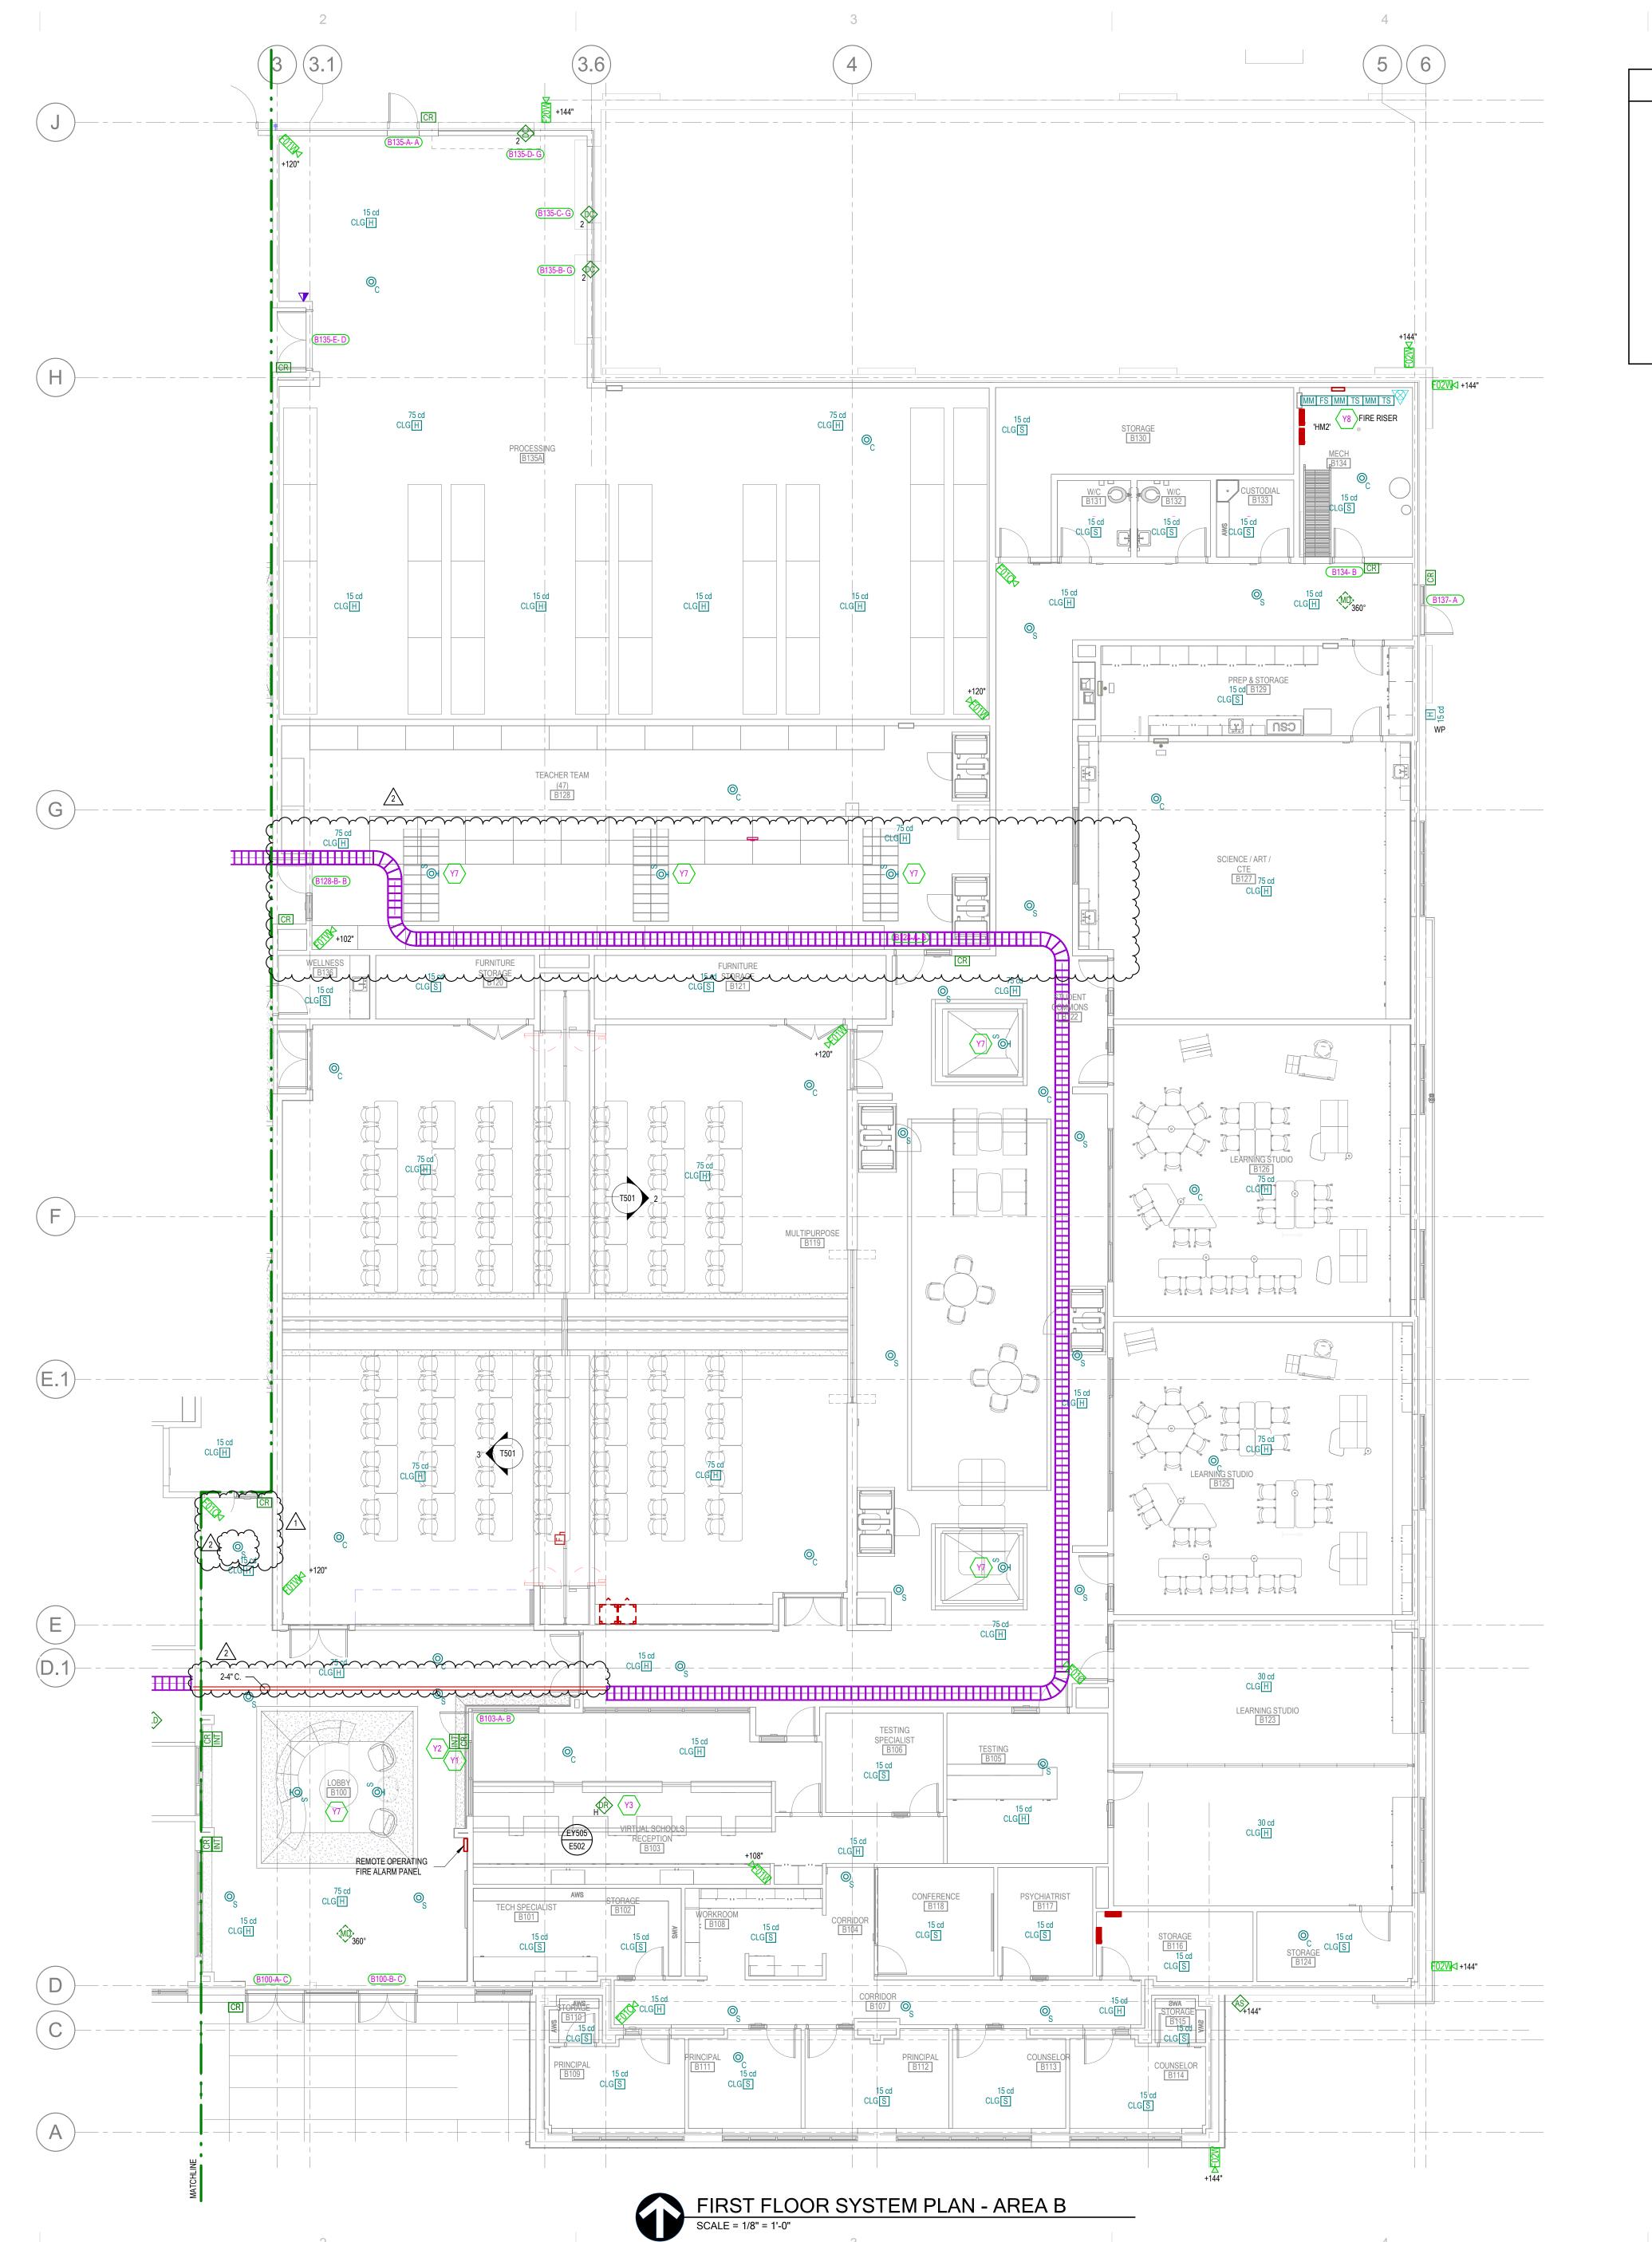

Y1 MULLION MOUNTED CREDENTIAL CARD READER.

PRIOR TO STARTING ANY WORK OR ROUGH-IN COORDINATE WITH THE SCHOOL DISTRICT AND FIND OUT THE EXACT LOCATION AND THE MOUNTING HEIGHTS FOR THE SOLO INTERCOM DOOR STATIONS, AND DISCUSS THE OPERATIONAL REQUIREMENTS FOR EACH ONE. PROVIDE ALL OF THE NECESSARY CABLING THAT HOME RUNS BACK TO THE ACCESS CONTROL HEAD-END PANEL, THE VIDEO SURVEILLANCE NVR, AND TO THERE SIP PHONE SYSTEM. IT IS THE SECURITY CONTRACTOR IS RESPONSIBILITY TO PROVIDE A COMPLETE AND FULLY FUNCTIONING INTERCOM SYSTEM THAT MEETS THE MANUFACTURER'S SPECIFICATIONS AND OPERATES TO THE SCHOOL DISTRICTS REQUIREMENTS AND INSTRUCTIONS.

PRIOR TO STARTING ANY WORK OR ROUGH-IN COORDINATE A MEETING WITH THE SCHOOL DISTRICT AND THE MILLWORK DRAWINGS FOR THE EXACT LOCATION AND THE OPERATIONAL REQUIREMENTS FOR THE DOOR RELEASE BUTTON ON THE RECEPTIONIST DESK IN AREA #A154. PROVIDE ALL OF THE NECESSARY CABLING THAT WILL HOME RUN BACK TO THE ACCESS CONTROL HEAD-END PANEL. PROGRAM THE MOMENTARY DOOR RELEASE BUTTON TO OPERATE WITH THE ELECTRIFIED DOOR HARDWARE ON DOOR #A154. IT IS THE SECURITY CONTRACTOR RESPONSIBILITY TO PROVIDE A COMPLETE AND FULLY FUNCTIONING DOOR RELEASE SYSTEM THAT MEETS THE MANUFACTURER'S SPECIFICATIONS AND OPERATES TO THE SCHOOL DISTRICTS REQUIREMENTS AND INSTRUCTIONS.

Y7 MOUNT SMOKE DETECTOR WITHIN SKYLIGHT. COORDINATE MOUNTING DETAILS WITH ARCHITECTURAL SKYLIGHT DETAIL.

FIRE RISER LOCATION. PROVIDE REQUIRED QUANTITY OF MONITOR MODULES, CONTROL MODULES, TAMPER SWITCHES, AND FLOW SWITCHES FOR A COMPLETE AND WORKING SYSTEM. REVIEW FIRE PROTECTION DRAWINGS PRIOR TO BIDDING.



MHTN Architects, Inc.
280 South 400 West
Suite 250
Salt Lake City, Utah 84101
Telephone (801) 595-6700
www.mhtn.com

### Property of the control of the c

www.bnaconsulting.com

JORDAN LEARNING CENTER
3706 WEST 9800 SOUTH

©2023 MHTN ARCHITECTS, INC.

Confidentiality Notice:
This document is intended for use on the Project identified herein by individuals and companies involved in the design, permitting, bidding and construction of the Project. MHTN Architects, Inc. grants limited rights to distribute and reproduce this document for this express purpose only. Distribution, printing or copying this document for purposes other than those indicated is strictly prohibited. If a digital copy of this document is received in error, please delete it.

SEAL



MHTN PROJECT NO. 2024528

Original drawing is 30 x 42. Do not scale contents of this drawing REVISIONS
CONTRACTOR TO VERIFY DRAWINGS IN FIELD USE RE

Original drawing is 30 x 42. Do not scale contents of this drawing.

REVISIONS
CONTRACTOR TO VERIFY DRAWINGS IN FIELD USE REFLECT LAST REVISION DATE.

NO. DATE DESCRIPTION
1 9/6/24 Addendum #1
2 09/13/2024 Addendum #2

CONSTRUCTION DOCUMENTS
AUGUST 29, 2024

FIRST FLOOR
SYSTEM PLAN
-AREA B

SHEET NUMBER

E411B

A B

V6 MOUNT ON ARTICULATING ARM. COORDINATE WITH ARCHITECT BEFORE INSTALLATION.





©2023 MHTN ARCHITECTS, INC. Confidentiality Notice:
This document is intended for use on the Project identified herein by individuals and companies involved in the design, permitting, bidding and construction of the Project. MHTN Architects, Inc. grants limited rights to distribute and reproduce this document for this express purpose only. Distribution, printing or copying this document for purposes other than those indicated is strictly prohibited. If a digital copy of this document is received in error, please delete it.



/HTN PI	ROJECT NO. 20	
VIII I I I I	100201110.20	72 1020
Original d	rawing is 30 x 42.	Do not scale contents of this drawing.
REVISIO	NS	
		FY DRAWINGS IN FIELD USE REFLECT
AST RE	VISION DATE.	
NO. $\triangle$	DATE	DESCRIPTION
2	09/13/2024	Addendum #2

CONSTRUCTION DOCUMENTS AUGUST 29, 2024

FIRST FLOOR AUDIOVISUAL PLAN AREA - B

**KEY PLAN** 





# ORDAN LEARNING CENTER

©2023 MHTN ARCHITECTS, INC.

Confidentiality Notice:
This document is intended for use on the Project identified herein by individuals and companies involved in the design, permitting, bidding and construction of the Project. MHTN Architects, inc. grants limited rights to distribute and reproduce this document for this express purpose only. Distribution, printing or copying this document for purposes other than those indicated is strictly prohibited. If a digital copy of this document is received in error, please delete it.



Original drawing is 30 x 42. Do not scale contents	HTN PROJECT NO. 2024528	
original arawing to co x 12. Do not coale contente	riginal drawing is 30 x 42. Do not scale contents	

CONSTRUCTION DOCUMENTS AUGUST 29, 2024

FIRST FLOOR AUDIOVISUAL RCP AREA - A

SHEET NUMBER

**KEY PLAN** 



- V2 DOCUMENT CAMERA. VERIFY LOCATION WITH ARCHITECT BEFORE INSTALLING.
- V4 BOTTOM OF PENDANT LOUDSPEAKERS TO BE FLUSH WITH BOTTOM OF BEAMS / CLOUDS.
- BOTTOM OF PENDANT LOUDSPEAKERS TO BE FLUSH WITH BOTTOM OF BEAMS / C

  COORDINATE ANTENNA MOUNTING LOCATION WITH ARCHITECT.





# JORDAN LEARNING CENTER

©2023 MHTN ARCHITECTS, INC.

Confidentiality Notice:
This document is intended for use on the Project identified herein by individuals and companies involved in the design, permitting, bidding and construction of the Project. MHTN Architects, inc. grants limited rights to distribute and reproduce this document for this express purpose only. Distribution, printing or copying this document for purposes other than those indicated is strictly prohibited. If a digital copy of this document is received in error, please delete it.



мнти реојест no. 2024528

CONSTRUCTION DOCUMENTS AUGUST 29, 2024

FIRST FLOOR AUDIOVISUAL RCP AREA - B

SHEET NUMBER

A

**KEY PLAN** 





# JORDAN LEARNING CENTER

©2023 MHTN ARCHITECTS, INC.

Confidentiality Notice:
This document is intended for use on the Project identified herein by individuals and companies involved in the design, permitting, bidding and construction of the Project. MHTN Architects, Inc. grants limited rights to distribute and reproduce this document for this express purpose only. Distribution, printing or copying this document for purposes other than those indicated is strictly prohibited. If a digital copy of this document is received in error, please delete it.



мнти реојест no.2024528

REVISIONS
CONTRACTOR TO VERIFY DRAWINGS IN FIELD USE REFLECT
LAST REVISION DATE.

NO. \( \triangle \triang

CONSTRUCTION DOCUMENTS
AUGUST 29, 2024

LEVEL 1
INTERCOM
OVERALL

SHEET NUMBER

**KEY PLAN** 



reproduce this document for this express purpose only. Distribution, printing or copying this document for purposes other than those indicated is strictly prohibited. If a digital copy of this document is received in error, please delete it.

SEAL

SEAL

ONAL

BRIAN

HICKS

No. 7709037 2092

Confidentiality Notice:
This document is intended for use on the Project identified herein by individuals and companies involved in the design, permitting, bidding and construction of the Project. MHTN Architects, Inc. grants limited rights to distribute and

MHTN PROJECT NO. 2024528


Original drawing is 30 x 42. Do not scale contents of this or REVISIONS
CONTRACTOR TO VERIFY DRAWINGS IN FIELD U

©2023 MHTN ARCHITECTS, INC.

CONSTRUCTION DOCUMENTS
AUGUST 29, 2024

AUDIOVISUAL ELEVATIONS

T501

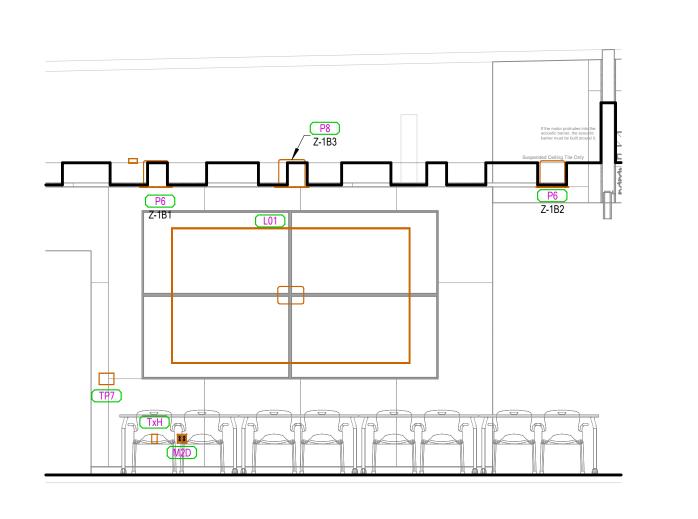



1

2 MULTIPURPOSE ROOM EAST ELEVATIONS


SCALE = 1/4" = 1'-0"




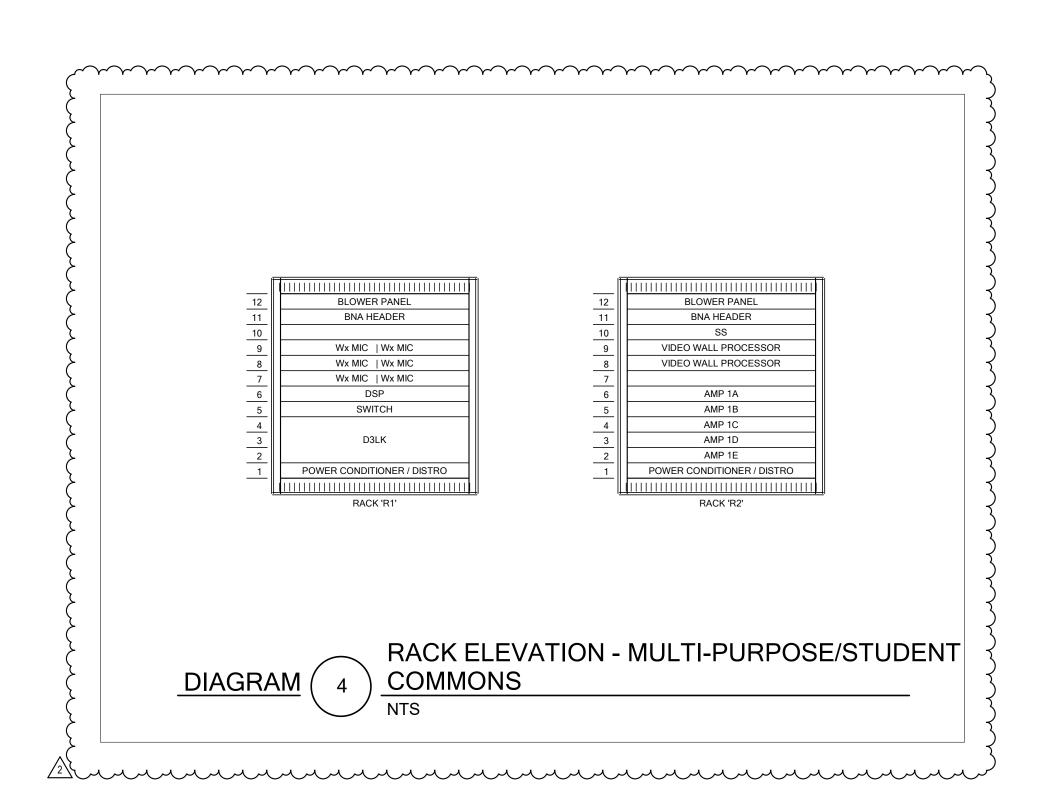

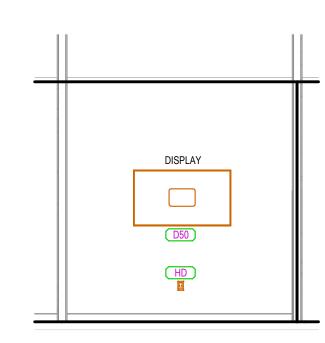

1 CONFERENCE ROOM/TESTING ROOM ELEVATIONS
SCALE = 1/4" = 1'-0"

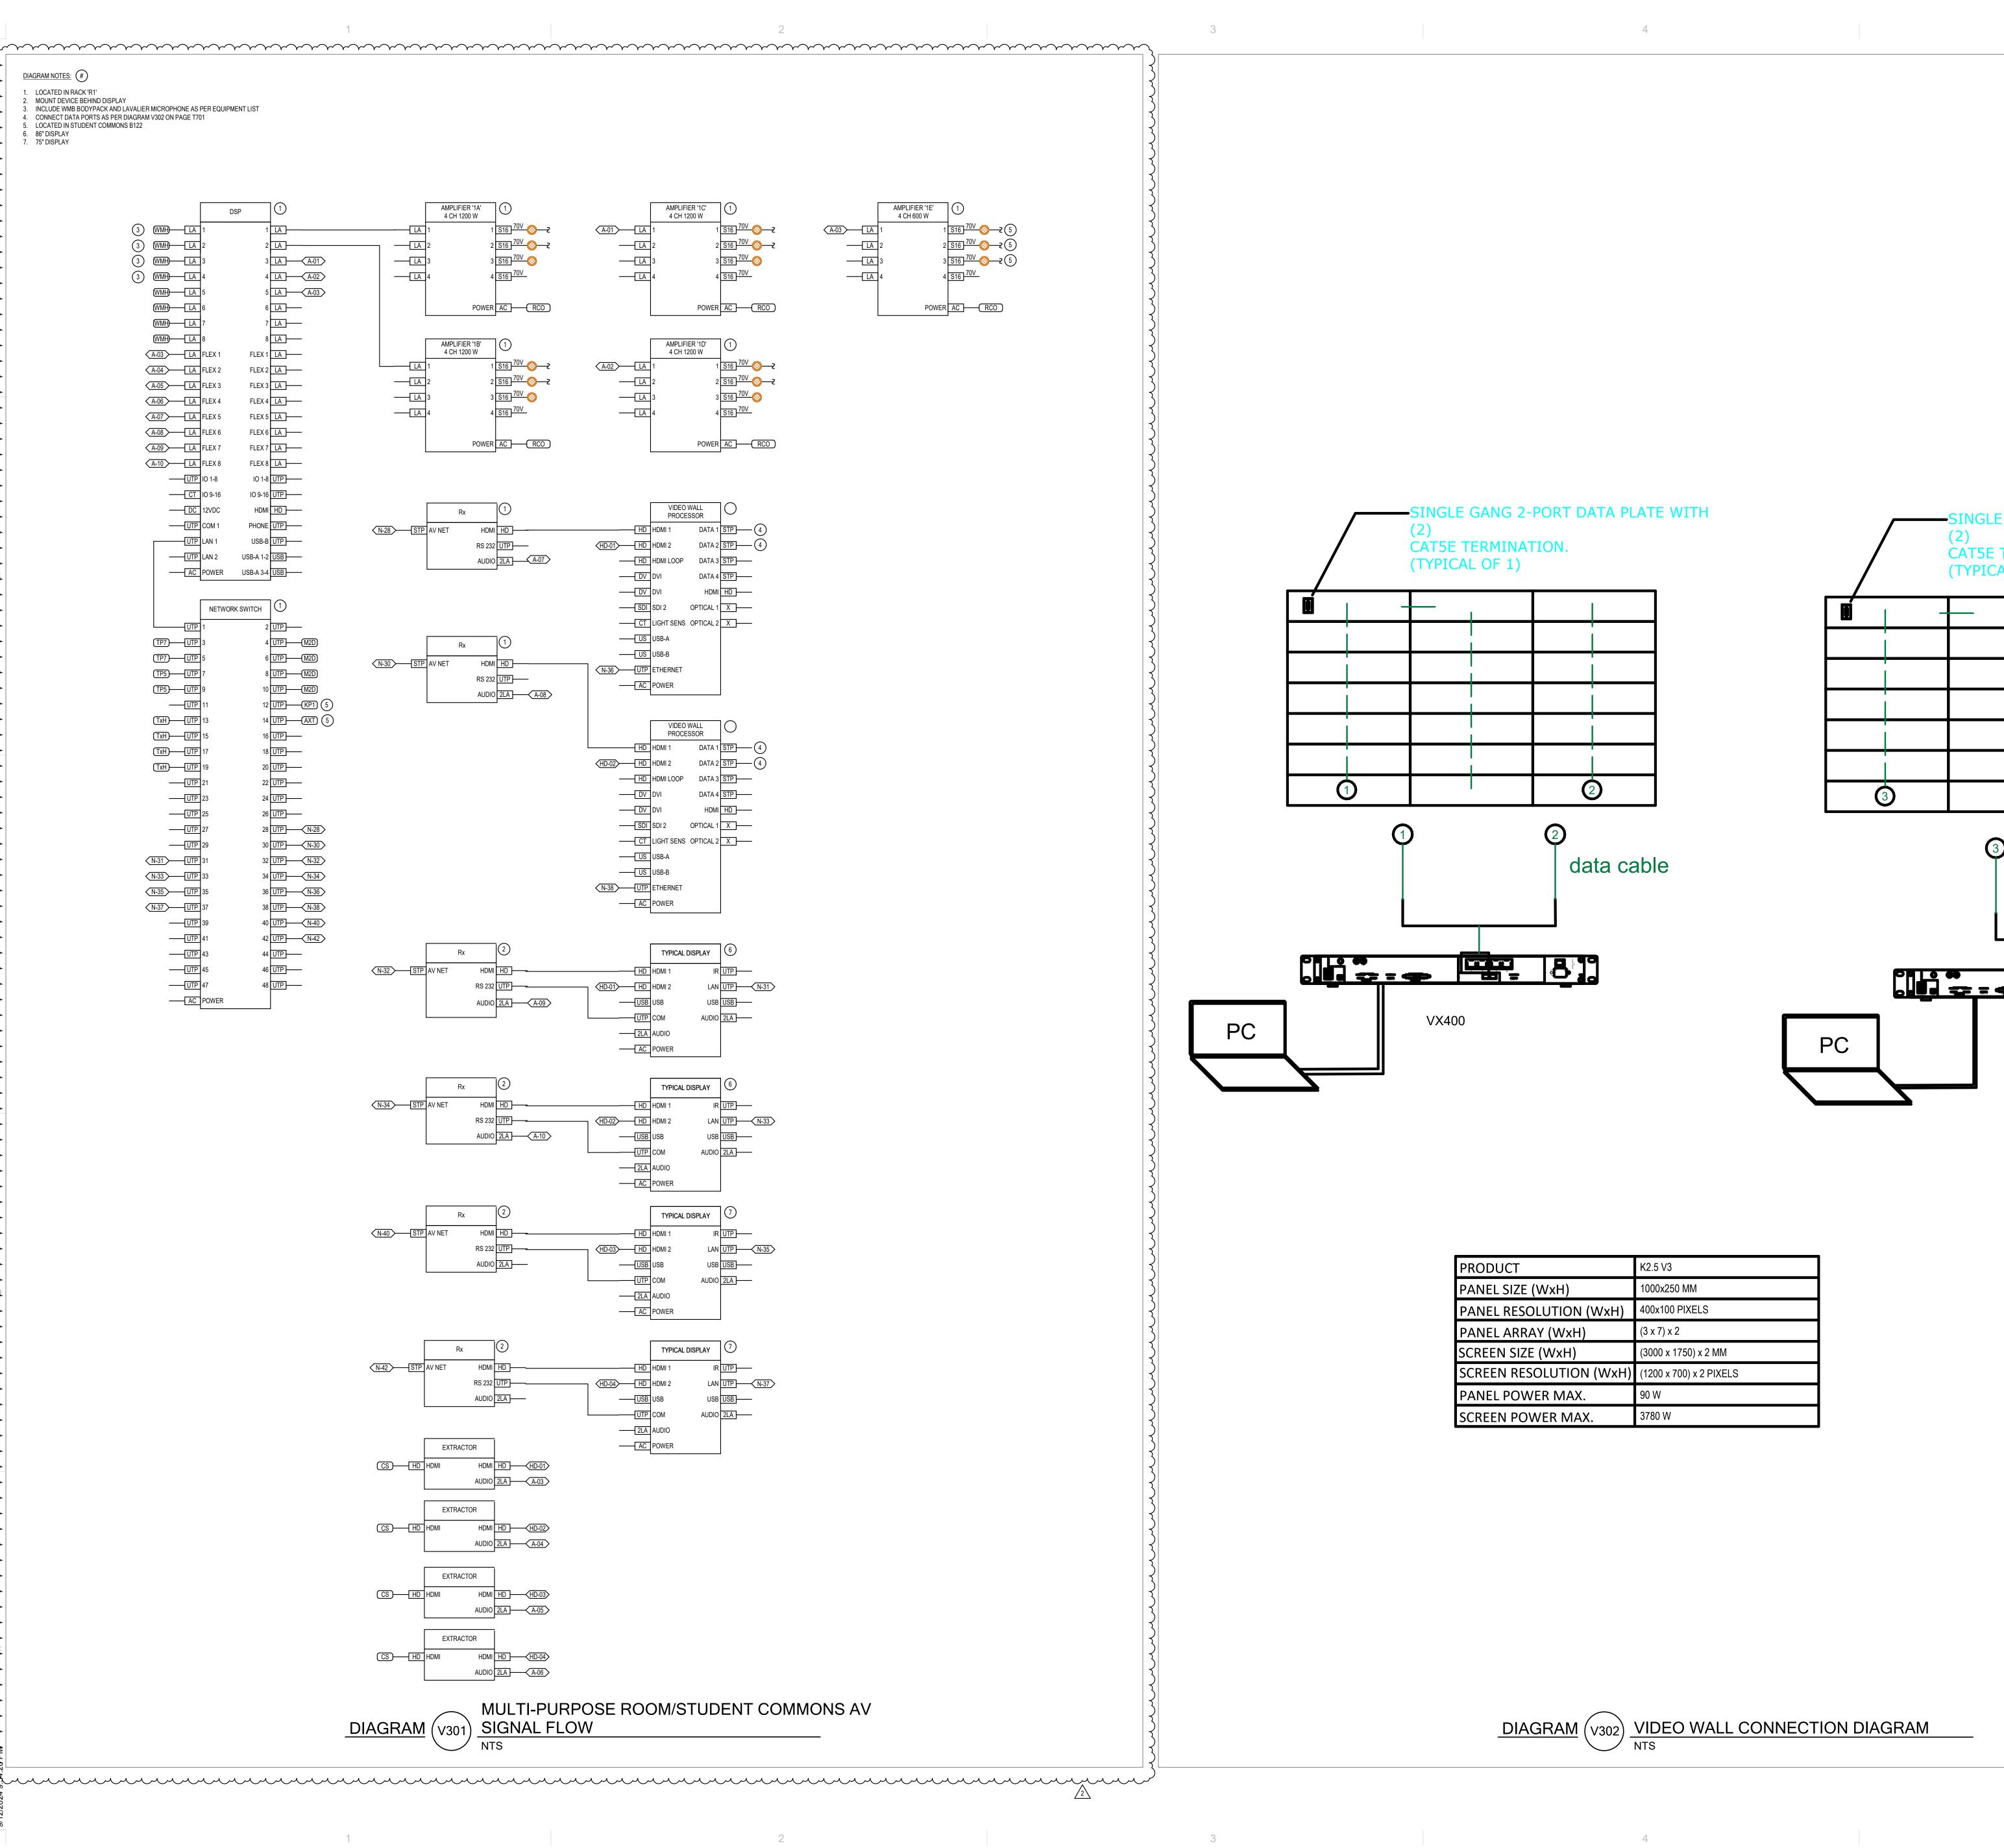

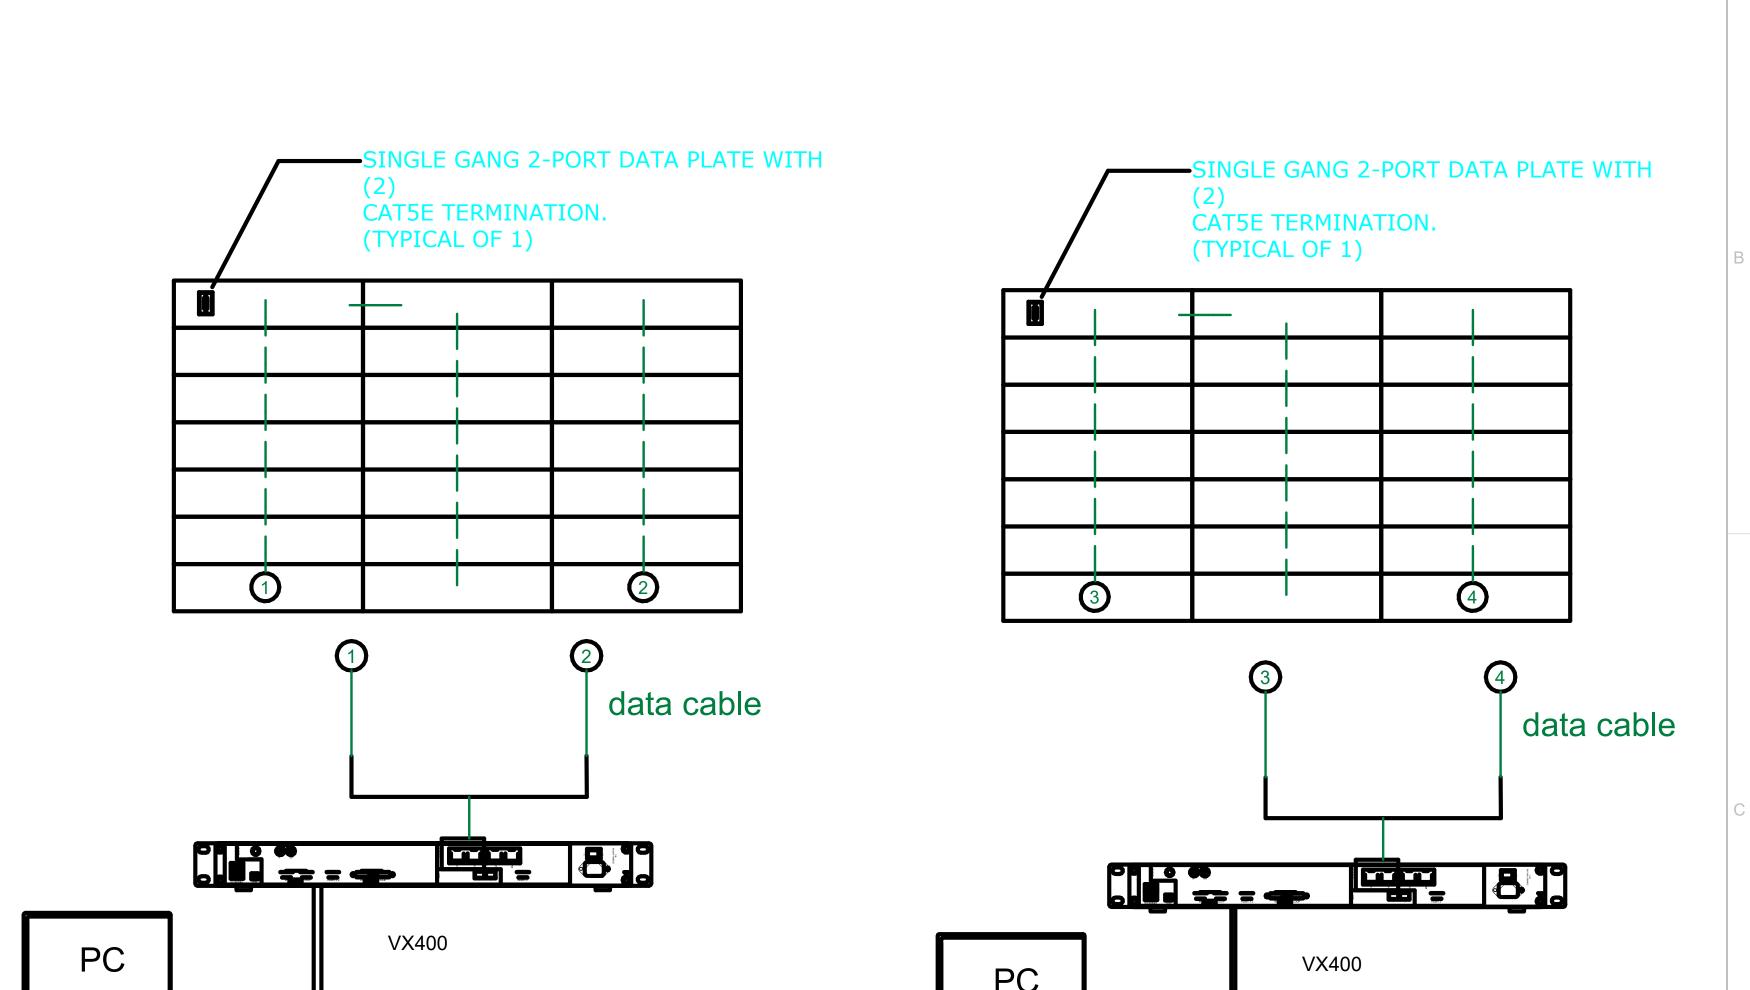

PRODUCT	K2.5 V3
PANEL SIZE (WxH)	1000x250 MM
PANEL RESOLUTION (WxH)	400x100 PIXELS
PANEL ARRAY (WxH)	(3 x 7) x 2
SCREEN SIZE (WxH)	(3000 x 1750) x 2 MM
SCREEN RESOLUTION (WxH)	(1200 x 700) x 2 PIXELS
PANEL POWER MAX.	90 W
SCREEN POWER MAX.	3780 W

DIAGRAM (V302) VIDEO WALL CONNECTION DIAGRAM



Salt Lake City, Utah 84101 Telephone (801) 595-6700

www.mhtn.com



www.bnaconsulting.com

TRIC

<u>S</u>

乙川

©2023 MHTN ARCHITECTS, INC. Confidentiality Notice: This document is intended for use on the Project identified herein by individuals and companies involved in the design, permitting, bidding and construction of the Project. MHTN Architects, Inc. grants limited rights to distribute and reproduce this document for this express purpose only. Distribution, printing or copying this document for purposes other than those indicated is strictly prohibited. If a digital copy of this document is received in error, please delete it.




MHTN PROJEC	т по. 2024528	8
Original drawing is	s 30 x 42. Do not so	cale contents of this drawing.
REVISIONS CONTRACTOR LAST REVISION		WINGS IN FIELD USE REFLECT

 NO. △
 DATE
 DESCRIPTION

 2
 09/13/2024
 Addendum #2

CONSTRUCTION DOCUMENTS AUGUST 29, 2024

AUDIOVISUAL **DIAGRAMS** 

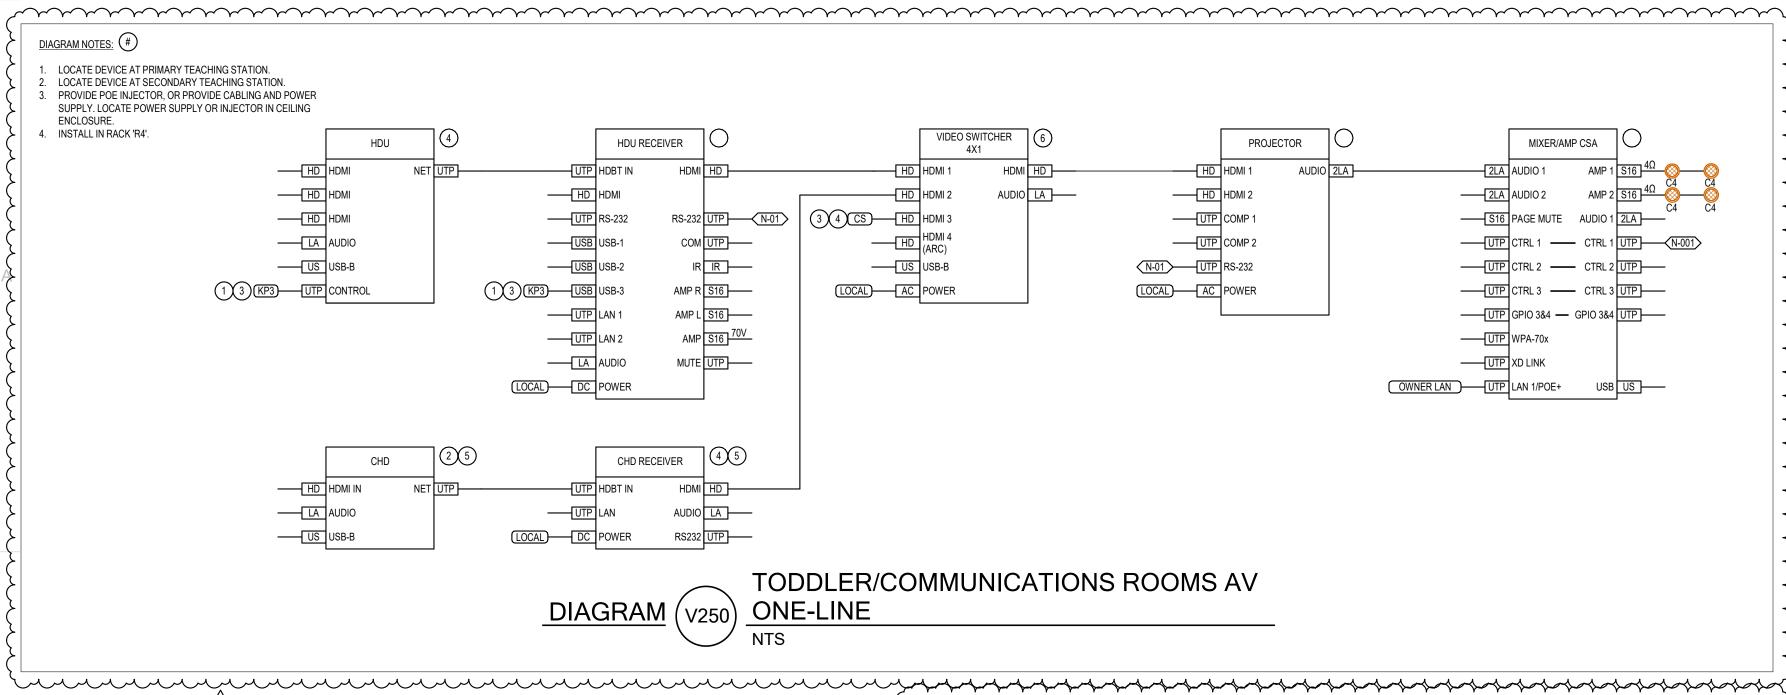



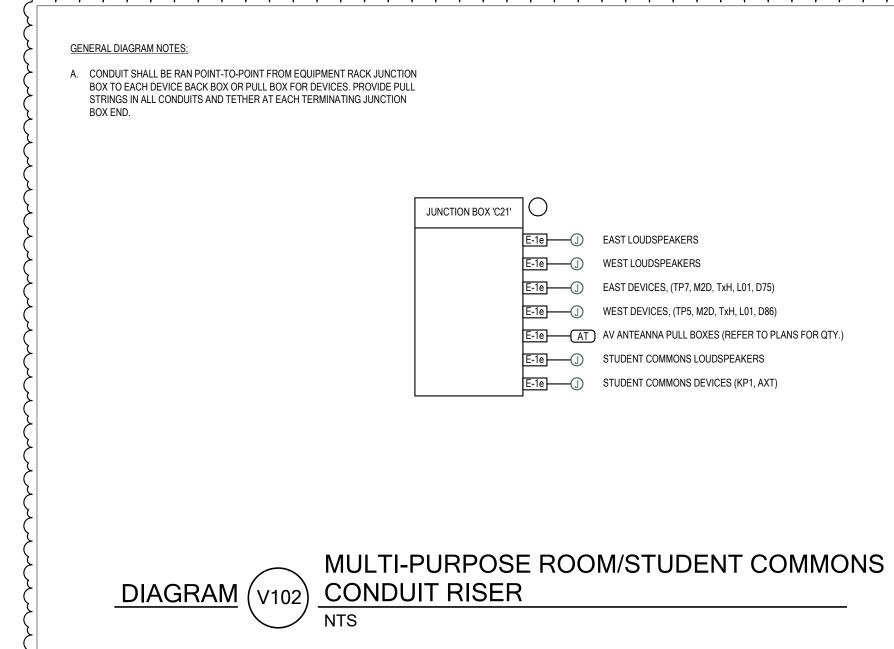


DIAGRAM NOTES: (#)

1 4



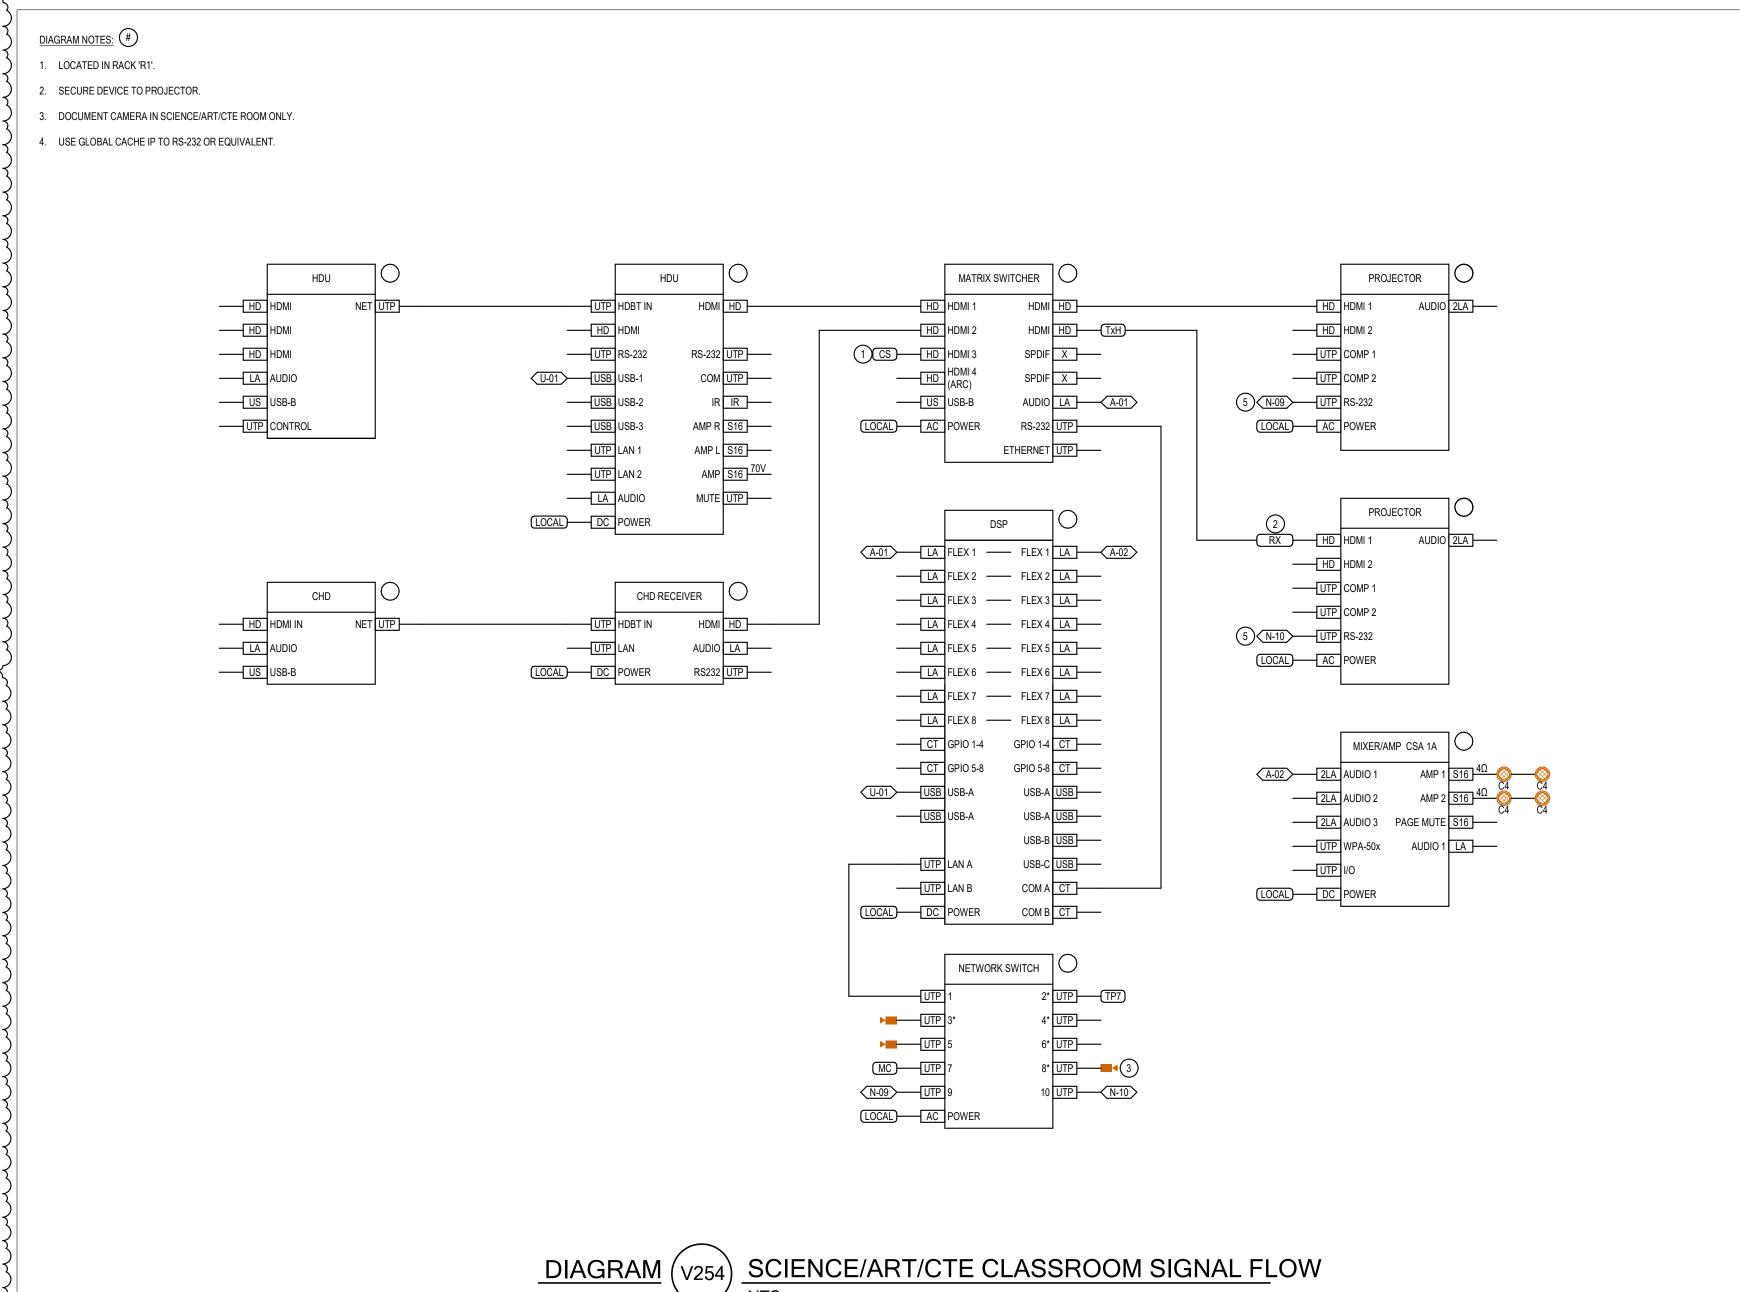

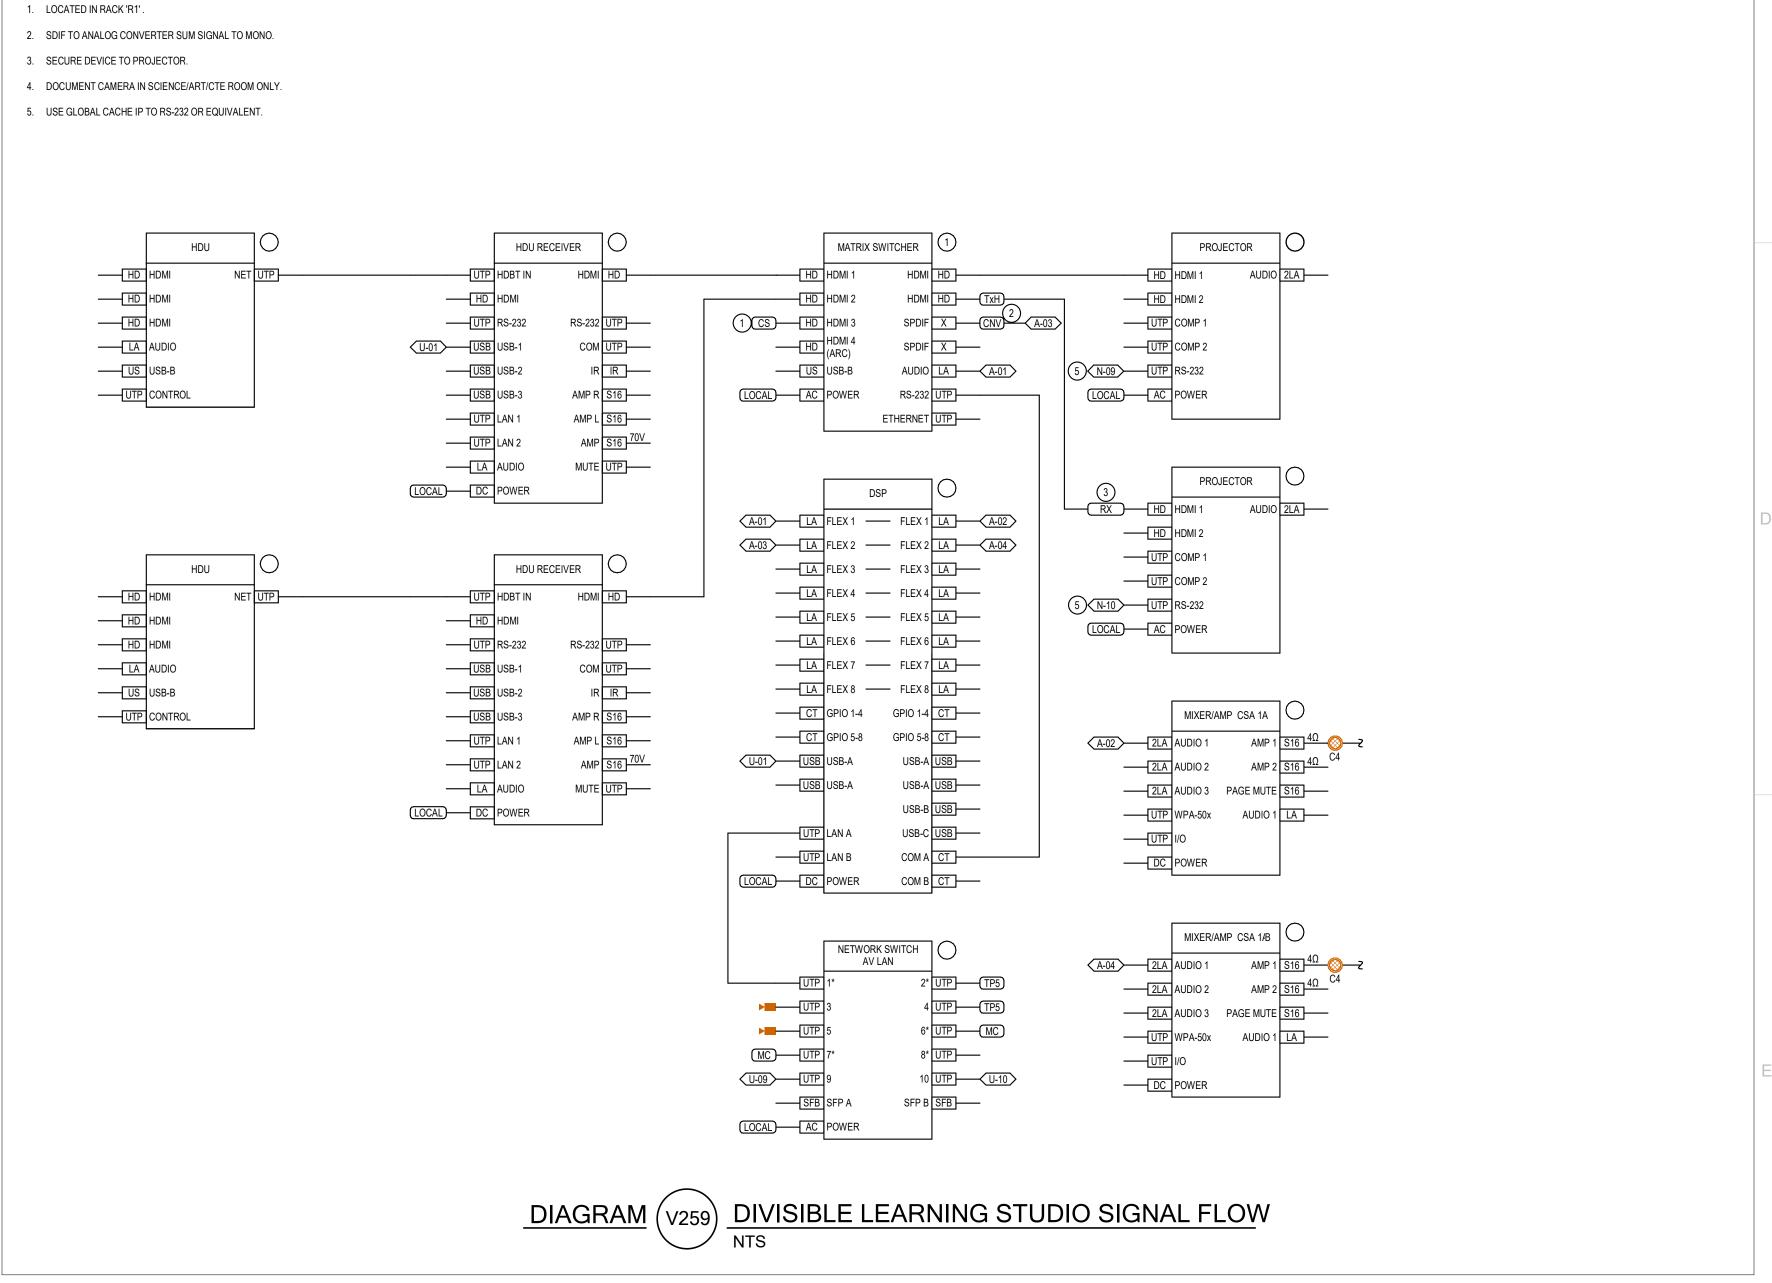





RC

S

# JORDAN LEARNING CENTER

©2023 MHTN ARCHITECT	S, INC.	
Confidentiality Notice: This document is intended fo and companies involved in the Project. MHTN Architects reproduce this document for copying this document for punchibited. If a digital copy of	e design, permitting, bidd s, Inc. grants limited rights this express purpose only	ing and construction of s to distribute and . Distribution, printing or ndicated is strictly



Original drawing is 30 x 42. Do not scale contents of this drawing.  REVISIONS CONTRACTOR TO VERIFY DRAWINGS IN FIELD USE REFLECT LAST REVISION DATE.		
NO.	DATE	DESCRIPTION
NO.∠∆ 2	09/13/2024	Addendum #2

AUDIOVISUAL DIAGRAMS