ADDENDUM NO. 5 October 11, 2024

TO THE PLANS AND PROJECT MANUAL FOR

# **CORNER CANYON HS FIELD HOUSE**

12943 South 700 East DRAPER UT, 84020

Prepared by:



233 South Pleasant Grove Blvd., Suite 105 Pleasant Grove, Utah 84062 (801) 769-3000 Office

This addendum issued October 11, 2024, is hereby made a part of the contract documents. It shall be the responsibility of each Contractor to notify his subcontractors of the contents of this addendum. In case of conflict between drawings, specifications and the Addendum, this Addendum shall govern. All changes, corrections, deletions and/or additions to the initial bidding documents shall be included in the bid.



**11 OCT '24** 

# ADDENDUM NO. 5

October 11, 2024

# **CORNER CANYON HS FIELD HOUSE**

# 12943 South 700 East DRAPER UT, 84020


# Architectural Items:

1. <u>Sheet A890</u> - See the attached revised sheet for items noted by revision cloud Mark 5

# Mechanical & Plumbing Items:


1. <u>Mechanical Addendum-</u> See attached - CCHS Fieldhouse - Mechanical Addendum 05.


END OF ADDENDUM NO. 5 - CORNER CANYON HS FIELD HOUSE

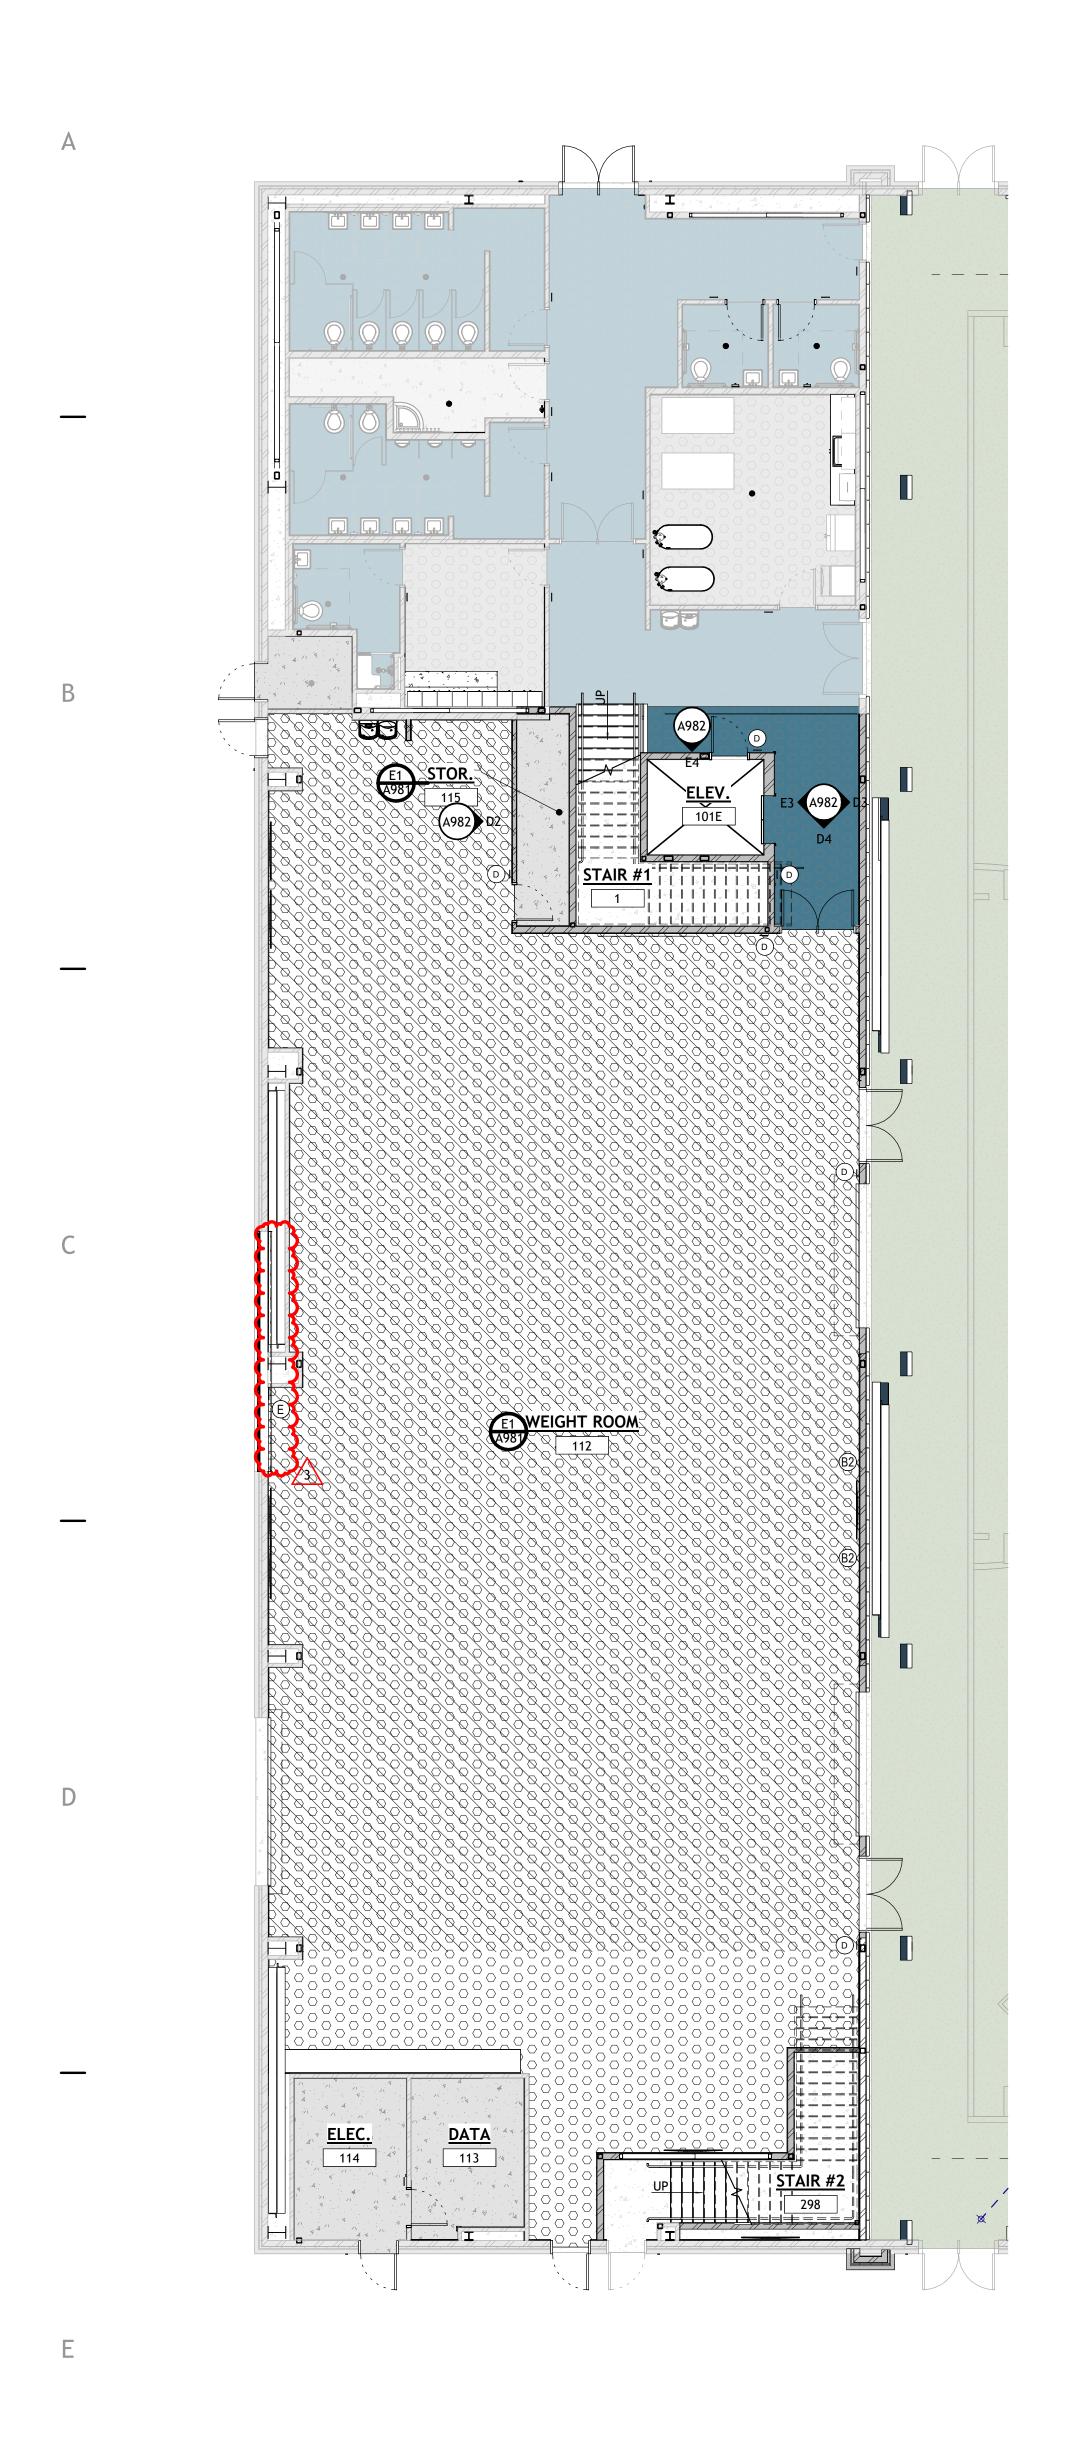

2

A980 SCALE: 1/8" = 1'-0"

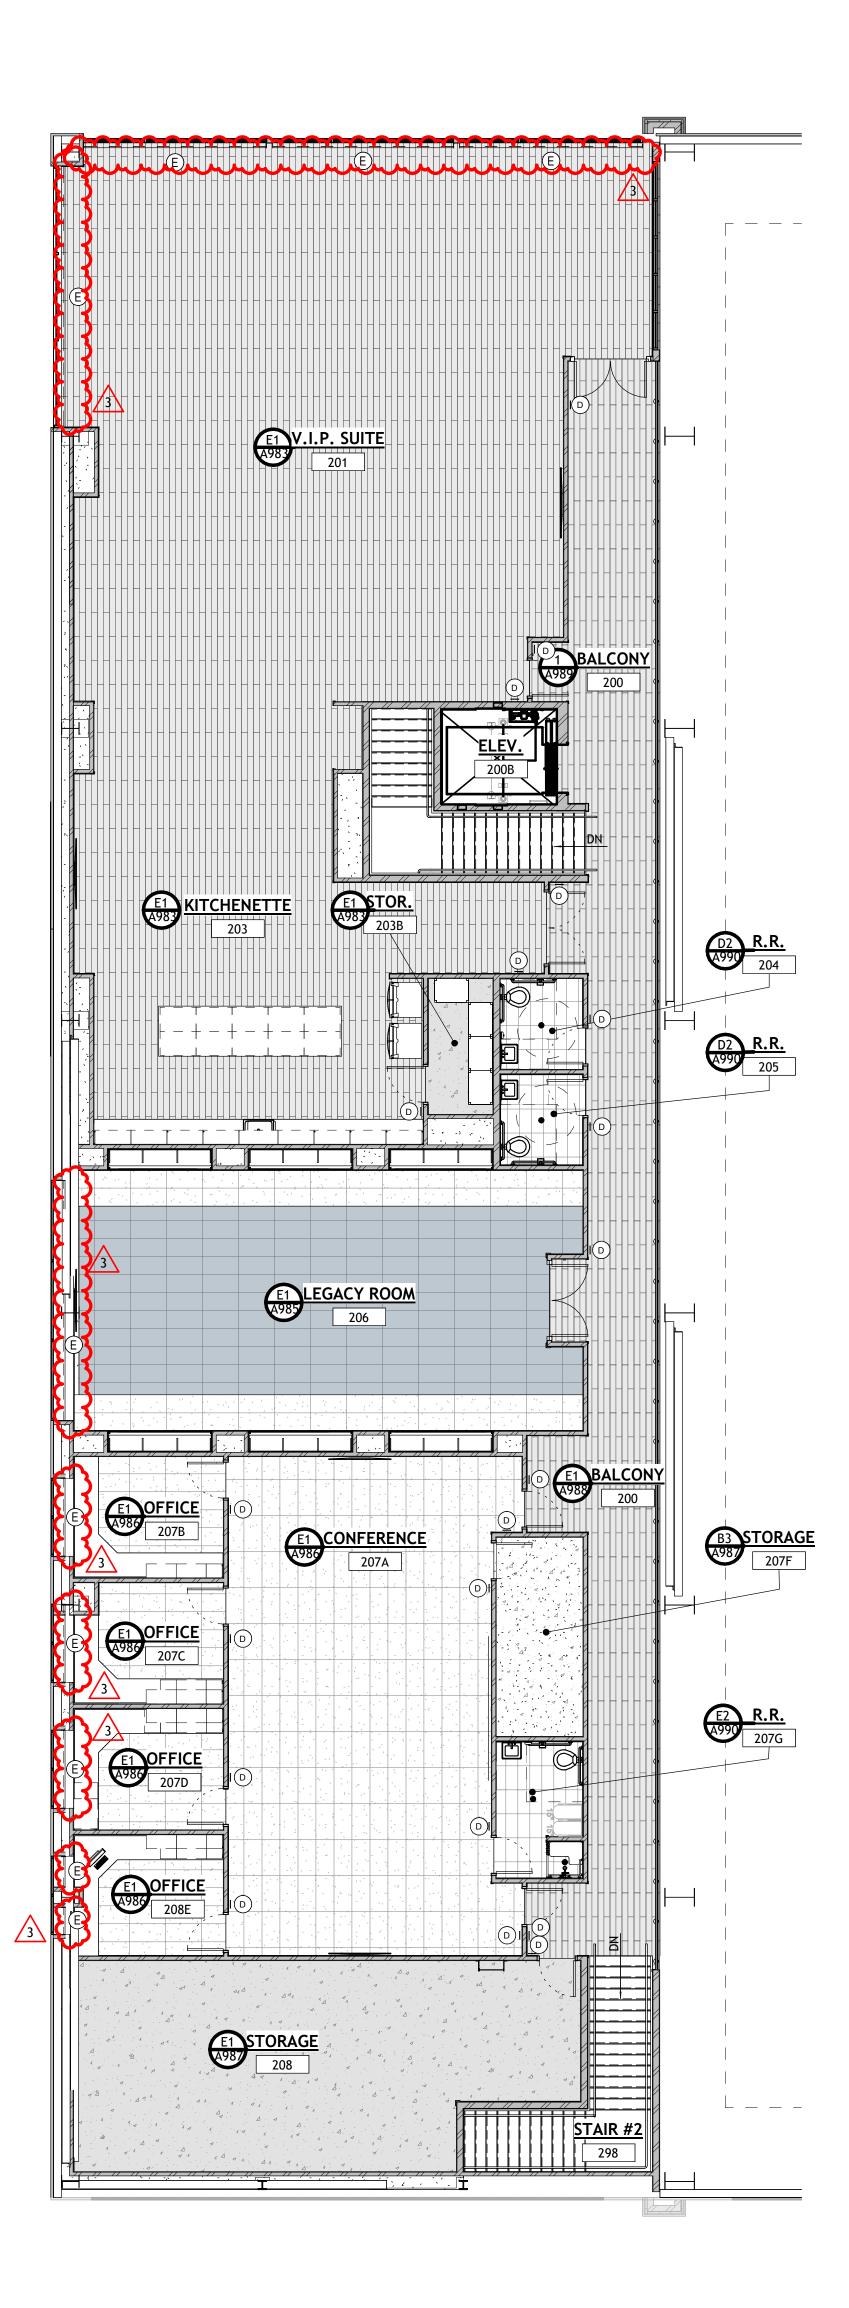

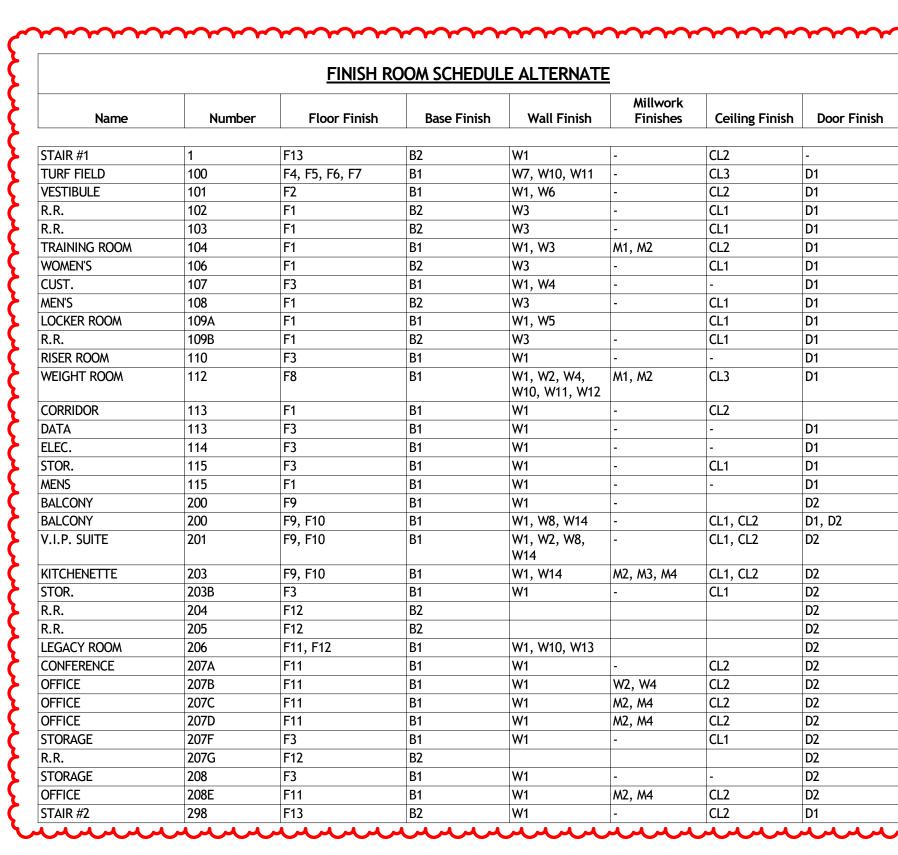

CODE	
1-FLOOR FINSH	IES
F1	RUBBER
F2	RUBBER
F3	EPOXY P
F4	TURF TY
F5	TURF TY
F6	TURF TY
F7	TURF TY
F8	EXISTING
F9	LUXURY
F10	LUXURY
F11	CARPET
F12	CARPET
F13	PORCEL
2- BASE FINISH	IES
B1	6" RUBBE
B2	CORRES

	INISH
W1	GENERA
W2	ACCENT
W3	PORCEL
W4	CERAMI
W5	EPOXY F
W6	PORCEL
W7	WALL PA
W8	ACCENT
W9	ACCENT
W10	PAINTED
W11	FIELD MI
W12	DIAMON
W13	PLASTIC
	PANELS
W14	TEXTILE
4- MILLWC	RK FINISHES
M1	PLASTIC
	1 1/0110
M2	PLASTIC
	PLASTIC COUNTE
	PLASTIC COUNTE SOLID SI
M2	PLASTIC COUNTE SOLID SI
M2 M3 M4	PLASTIC COUNTE SOLID SI PLASTIC
M2 M3 M4 5-CEILING	PLASTIC COUNTE SOLID SI PLASTIC FINISH
M2 M3 M4 5-CEILING CL1	FINISH
M2 M3 M4 5-CEILING CL1 CL2	PLASTIC COUNTE SOLID SI PLASTIC FINISH PAINTED ACOUST
M2 M3 M4 5-CEILING	PLASTIC COUNTE SOLID SI PLASTIC FINISH PAINTEE ACOUST
M2 M3 M4 5-CEILING CL1 CL2 CL3 6-DOOR F	PLASTIC COUNTE SOLID SI PLASTIC FINISH PAINTEE ACOUST PAINTEE
M2 M3 M4 5-CEILING CL1 CL2 CL3	FINISH PAINTED PAINTED PAINTED
M2 M3 M4 5-CEILING CL1 CL2 CL3 6-DOOR F	PLASTIC COUNTE SOLID SI PLASTIC FINISH PAINTEE ACOUST PAINTEE INISHES PAINTEE WOOD D
M2 M3 M4 5-CEILING CL1 CL2 CL3 6-DOOR F D1	PLASTIC COUNTE SOLID S PLASTIC FINISH PAINTEE NISHES PAINTEE



	<u>FINISH R</u>	OOM SCHEDUL	<u>E ALTERNATE</u>			
Number	Floor Finish	Base Finish	Wall Finish	Millwork Finishes	Ceiling Finish	Door Finish
4	512	22	144			1
1	F13	B2	W1	-	CL2	-
100 101	F4, F5, F6, F7 F2	B1 B1	W7, W10, W11	-	CL3 CL2	D1 D1
101	F2	B2	W1, W6 W3	-	CL2 CL1	D1
102	F1	B2 B2	W3	-	CL1	D1
103	F1	B2 B1	W1, W3	- M1, M2	CL1 CL2	D1
104	F1	B1 B2	W3	///1, ///2	CL2 CL1	D1
107	F3	B2 B1	W1, W4	-	-	D1
107	F1	B1 B2	W3	-	CL1	D1
109A	F1	B1	W1, W5		CL1	D1
109A	F1	B2	W3	-	CL1	D1
110	F3	B1	W1	-	-	D1
112	F8	B1	W1, W2, W4,	M1, M2	CL3	D1
			W10, W11, W12		CLS	
113	F1	B1	W1	-	CL2	
113	F3	B1	W1	-	-	D1
114	F3	B1	W1	-	-	D1
115	F3	B1	W1	-	CL1	D1
115	F1	B1	W1	-	-	D1
200	F9	B1	W1	-		D2
200	F9, F10	B1	W1, W8, W14	-	CL1, CL2	D1, D2
201	F9, F10	B1	W1, W2, W8, W14	-	CL1, CL2	D2
203	F9, F10	B1	W1, W14	M2, M3, M4	CL1, CL2	D2
203B	F3	B1	W1	-	CL1	D2
204	F12	B2				D2
205	F12	B2				D2
206	F11, F12	B1	W1, W10, W13			D2
207A	F11	B1	W1	-	CL2	D2
207B	F11	B1	W1	W2, W4	CL2	D2
207C	F11	B1	W1	M2, M4	CL2	D2
207D	F11	B1	W1	M2, M4	CL2	D2
207F	F3	B1	W1	-	CL1	D2
207G	F12	B2				D2
208	F3	B1	W1	-	-	D2
208E	F11	B1	W1	M2, M4	CL2	D2
298	F13	B2	W1	-	CL2	D1

INTERIOR FIN	NISH SCHEDULE	
ODUCT NAME / NUMBER	COLOR / FINISH	

MATERIAL	MANUFACTURER	PRODUCT NAME / NUMBER	COLOR / FINISH	SIZE	COMMENTS
TYPE 1	MONDO FLOORING	RAMFLEX	MARINE BLUE G986	ROLO	
TYPE 2	MONDO FLOORING	SPORT IMPACT	DARK GREY S018	ROLLS	No INTERLOCKING
PAINTED CONCRETE	SHERWIN WILLIAMS	-	KNITTING NEEDLES SW7672	him	
′PE 1	-	-	-	-	NIC - OWNER PROVIDED
'PE 2	-	-	-	-	NIC - OWNER PROVIDED
'PE 3	-	-	-	_	NIC - OWNER PROVIDED
/PE 4	-	-	_		NIC - OWNER PROVIDED
G RUBBER		_	_		
VINYL TILE	JJ FLOORING	STEP BY STEP 5MM	ALL PURPOSE	18" X 36"	INSTALLATION: ASHLAR
VINYL TILE ACCENT	JJ FLOORING	STEP BY STEP 5MM	DENIM 1134	18" X 36"	INSTALLATION: ASHLAR
TILE	PATCRAFT	ORGANIC INTERRUPTION. STYLE: LINEAR TENSION		18" X 36"	
					INSTALLATION: STAGGARED
TILE	PATCRAFT	ORGANIC INTERRUPTION. STYLE: LINEAR TENSION	HARBOR 00460	18" X 36"	INSTALLATION: STAGGARED
AIN FLOOR TILE	DALTILE	-	-	-	-
ER BASE	JOHNSONITE BY TARKETT	MANDALAY	BURNT UMBER 63	6"	
SPONDING TILE BASE	-	-	•	-	
L PAINT	SHERWIN WILLIAMS	-	PURE WHITE SW7005	-	SHEEN: EGGSHELL
PAINT	SHERWIN WILLIAMS	-	DRESS BLUES SW9167	-	SHEEN: EGGSHELL
AIN WALL TILE	DALTILE	SYNCHRONIC	WHITE SY30 MATTE	12X24	GROUT: CBP, "ASH" #642 / INSTALLATION: VERTICAL STRAIGHT STACK
C WALL TILE	DALTILE	COLOR WHEEL LINEAR	MATTE SUEDE GRAY 0782	4X16	GROUT: CBP, "PEWTER" #19 / INSTALLATION: HORIZONTAL STRAIGHT STACK
PAINTED CONCRETE	SHERWIN WILLIAMS		KNITTING NEEDLES SW7672	-	
AIN WALL TILE	DALTILE	VOLUME 1.0	SONIC WHITE VL75	12x24	GROUT: CBP, "ASH" #642 / INSTALLATION: HORIZONTAL STRAIGHT STACK
				2'X6' TYPICAL	COLOR TO BE SELECTED BY INTERIOR DESIGNER
PAINT 2	- SHERWIN WILLIAMS		- KNITTING NEEDLES SW7672	2 AU TIFICAL	
		-		-	FINISH: EGGSHELL
PAINT 3	SHERWIN WILLIAMS	-	DOMINO SW6989	-	FINISH: EGGSHELL
METAL STRUCTURE	SHERWIN WILLIAMS	•	DRESS BLUES SW9167	-	FINISH: SEMI-GLOSS
	SHERWIN WILLIAMS	-	PURE WHITE SW7005	_	FINISH: SEMI-GLOSS
D PLATE	INPRO	-	STAINLESS STEEL DIAMOND PLATE	E -	FINISH WITH CORNER GUARDS IN SAME DIAMOND PLATE PATTERN
LAMINATE WALL	FORMICA	-	WALNUT RIFTWOOD 9283-NG	-	USE FRY REGLET 1/2" MILLWORK REVEAL INBETWEEN MDF WRAPPED PANEL
WALLCOVERING	SBR TECHNOLOGIES	-	-	-	CUSTOM WALLCOVERING. BRANDING PROVIDED BY OWNER.
LAMINATE MILLWORK	FORMICA	-	STORM 912-58	-	-
LAMINATE RTOP	WILSONART	-	GREY PAMPAS 4168-60	-	EASED EDGE
URFACE	FORMICA	EVERFORM	GAMMA GRAY 417	3CM	EASED EDGE.USED AS WINDOW SILLS AS WELL
LAMINATE MILLWORK	FORMICA	-	WALNUT RIFTWOOD 9283-NG	-	
) GYPSUM BOARD	SHERWIN WILLIAMS	-	PURE WHITE SW7005	-	FINISH: FLAT
IC CEILING TILE	-	-	-	-	•
) STRUCTURE	SHERWIN WILLIAMS	-	DRESS BLUES SW9167	-	FINISH: SEMI-GLOSS
) METAL DOOR & TRIM	SHERWIN WILLIAMS	-	DOMINO SW6989	-	TRIM OF DOOR MATCH EXISTING, SHEEN - SEMI-GLOSS
	SHERWIN WILLIAMS	-	-	-	SHEEN: SEMI-GLOSS
			•	1	

WALL FURNISHINGS LEGEND	
(A1) 6'-0" × 4'-0" MARKER BOARD	
A2 12'-0" x 4'-0" MARKER BOARD	
B1 24" X 36" MIRROR	
B2 48" X 72" MIRROR	
C1 24" X 72" WALL PADDING	
C2 18" X 72" I-BEAM WALL PAD	DDING
C3 10" X 132" CROSS BEAM WAL	L PADDING
B" X 8" SIGNAGE, SEE SHI	EET A004
E SEE WINDOW TYPES MANUAL WINDOW	/ SHADES - SEE SPECS
F SEE WINODW TYPES MOTORIZED WIND	DOW SHADES - SEE SPECS
NOTE: COORDINATE FINAL LOCATION WITH OWNER AND ARC	CHITECT PRIOR

# \* ALL SHADES IN MAIN AND AUXILIARY GYMS TO BE 1% TRANSMISSION, ALL OTHERS TO BE 5%

# GENERAL NOTES

- A. GENERAL CONTRACTOR SHALL VERIFY ALL CONDITIONS AND DIMENSIONS PRIOR TO CONSTRUCTION. REPORT ANY SIGNIFICANT DISCREPANCIES TO THE
- ARCHITECT. B. PROVIDE 18" MINIMUM CLEAR FLOOR SPACE AT PULL SIDE OF ALL DOORS. PROVIDE C. MILLWORK SHOWN FOR CLARITY. PROVIDE FLOORING UNDER EQUIPMENT,
- MILLWORK AND COUNTERTOPS. D. SEE INTERIOR ELEVATIONS ON A850 SHEETS AND MILLWORK DETAILS ON A550
- SHEETS E. FINAL FINISH SELECTION TO BE COORDINATED WITH ARCHITECT, OWNER AND
- INTERIOR DESIGNER. F. CONTRACTOR TO VERIFY TRANSITION STRIP DIMENSIONS WITH MATERIAL
- THICKNESS. G. SEE ELECTRICAL SHEETS FOR LOCATIONS OF OUTLETS, SWITCHES, DATA, TELEPHONE, TELEVISON, INTERCOMES, CLOCKS, SPEAKERS, HORNS, STROBES,
- ETC. H. PROVIDE 3" DIAMETER HOLE THRU CONTER TOP AT ALL POWER AND DATE OUTLEST BELOW CABINET. PROVIDE 3MM PVC SLEEVE AROUND OPENING. COORDINATE WITH ELECTRICAL SHEETS. DRILL OPENING AFTER MILLWORK AS BEEN INSTALLED FOR ACCURATE LOCATION WITH ELECTRICAL. I. FINAL LOCATION OF ALL RESTROOM EQUIPMENT TO BE COORDINATED WITH
- OWNER PRIOR TO INSTALLATION. J. CHAMFER ALL EXPOSED CORNERS ON COUNTERTOPS.
- K. ALL WINDOWS TO RECIEVE SOLID SURFACE SILLS. SEE A802 & SPECIFICATIONS FOR FINISH DETAILS. L. PROVIDE STAINLESS STEEL CORNER GUARDS AT ALL DRYWALL CORNERS PER
- DETAIL D4/A560. M. PROVIDE SCHULTER TRIM PIECE ON ALL EXPOSED TILE EDGES AND EXTERIOR CORNERS. SEE SPECIFICATIONS
- N. ALL ROOMS TO RECIEVE ROOM SIGNS AT EACH ENTRY INTO SPACE. PLAN FOR APPROPRIATE AMOUNT PER ROOM.
- O. A PREINSTALLTION MEETING IS TO BE SCHEDULED WITH THE OWNER, ARCHITECT, GENERAL CONTRACTOR, GYMNASIUM EQUIPMENT SUBCONTRACTOR, AND THE MULTI-PURPOSE ROOM FLOORING SUBCONTRACTOR TO COORDINATE THE LAYOUT AND INSTALLTION OF THE GYMNASIUM EQUIPMENT AND THE FLOOR GAME LINES.
- P. PROVIDE FLOOR TRANSITION STRIPS AT ALL FLOOR MATERIAL TRANSITIONS PER DETAILS. SHEETS A550.





# ALTERNATE -FINISHINGS PLANS

SHEET TITLE

# THIS DRAWING SET IS INTENDED TO BE PRINTED IN COLOR

# **BID SET**

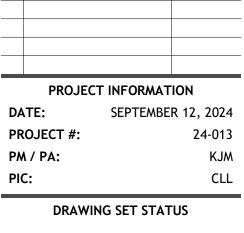

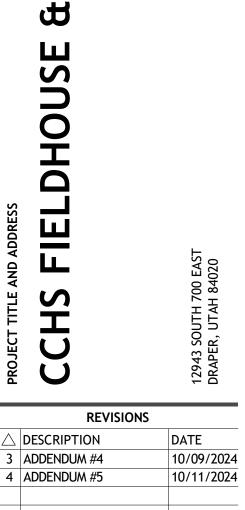

2


CE

U


0

S




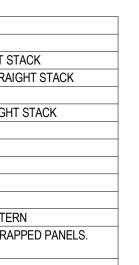



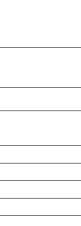



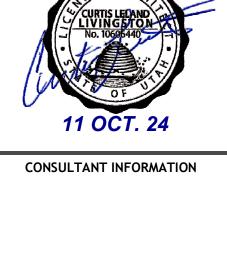



PROFESSIONAL STAMP

Corner Canyon High School Fieldhouse & soccer Fields Canyons School District

# **MECHANICAL ADDENDUM 05**

October 11, 2024

# **Revisions to the Specifications:**

Item: Section #: Description:

5.1 220000-2.5.C Add exposed hose bibbs under lavatory.

- HB-3 Hose Bibb: Chicago Faucet No. 952 (No. 998 where connected to exposed piping) 3/4" chrome plated hose bibb with No. 293-6 handle and 3/4" threaded outlet with integral vacuum breaker.
- 5.2 220000-2.5.C Add 2-compartment counter mounted sink.
- S-2 Sink: Elkay PSR-3319 33" x 19-1/2" x 7" deep with (2) each 14" x 14" bowls, 20 ga. stainless steel self-rimming sink, soft satin finish with 2-hole flush fittings deck and sound dampening. Single lever Chicago 1100-L9-317ABCP 8" swing spout kitchen deck faucet, and vandalproof aerator, flexible supplies, crumb cup strainer with the tailpiece and cast brass P-trap.

# APPROVED MANUFACTURERS' PRODUCTS:

N/A

# **Revisions to the Drawings:**

Item:	Sheet #:	Description:
5.1	P501	Plumbing Fixture Schedule - Added S-2, F-1, HB-3

# Attachments:

Drawings

P501

End of Addendum 05

# Autodesk Docs:/ 10/11/2024 11:2

— Ε

—

Α

1

2

1

3 4

# PLUMBING EQUIPMENT SCHEDULE

WH-1	WATER HEATER: ELECTRIC, PACKAGED TYPE, 74 GALLONS PER HOUR RECOVERY THRU 100°F TEMP. RISE. HEATER SHALL BE 50 GALLON, FACTORY INSULATED HOT WATER STORAGE TANK WITH ASME RATED GLASS LINED TANK. COMPLETE WITH P & T RELIEF VALVE, FACTORY WIRED AND TESTED. UPPER AND LOWER LIMIT OPERATING THERMOSTATS, COMBINATION HIGH AND LOW PRESSURE SAFETY CONTROLS AND ALL CONTROLS FOR AUTOMATIC OPERATION. SET AT 120°F. POWER: 480/3/60, 2 ELEMENTS AT 4500 WATTS EACH. TOTAL FLA @ 480/3/60 = 16.2 A DIMENSIONS: 47-1/2"H x 22" DIA. WEIGHT: 140 LBS MANUFACTURER: BRADFORD WHITE MODEL: E32-50S-3
CP-1	PUMP: IN-LINE RECIRCULATING, 120 DEG. F. WATER, 2.0 GPM AT 15 FT. HEAD, 1/6 H.P., 120/1/60, 1750 RPM, 3/4" CONNECTIONS. ALL BRONZE CONSTRUCTION. MANUFACTURER: BELL & GOSSETT MODEL: SERIES PR

EX-1 EXPANSION TANK: BLADDER TYPE, DOMESTIC 120° HOT WATER, 12.5 GAL. TOTAL VOLUME, 10.0 GALLONS ACCEPTANCE VOLUME. FACTORY AIR CHARGE 55 PSI, 16-1/4" DIA. x 17-1/4" HIGH. COMPLETE WITH STEEL SHELL AND HEAVY DUTY BUTYL DIAPHRAGM. MANUFACTURER: AMTROL PUMP: AST-30

		PLUMBING FIXTURE SCHEDULE						IEDULE
	SYMBOL	FIXTURE	WASTE	VENT	C.W.	H.W.	TEMP. W.	NOTES (1)
	$\frac{\text{WC}}{1}$	WATER CLOSET	4"	2"	1"			WALL MOUNTED - FLUSH VALVE
	$\frac{WC}{2}$	WATER CLOSET	4"	2"	1"			WALL MOUNTED - FLUSH VALVE (ADA)
	$\frac{\text{WC}}{3}$	WATER CLOSET	4"	2"	1"			FLOOR MOUNTED - SENSOR FLUSH (ADA)
	$\left\langle \begin{array}{c} U\\ 1\end{array}\right\rangle$	URINAL	3"	2"	1"			WALL MOUNTED - SENSOR FLUSH
	$\left\langle \begin{array}{c} U\\ 2 \end{array} \right\rangle$	URINAL	3"	2"	1"			WALL MOUNTED - SENSOR FLUSH (ADA)
	$\begin{pmatrix} L \\ 1 \end{pmatrix}$	LAVATORY	1-1/2"	1-1/2"	1/2"	1/2"	1/2"	WALL MOUNTED - (ADA) W/ASSE TV-1
	S A	SINK	1-1/2"	1-1/2"	1/2" ~~~~~~~~~~~~~~~~~~~~~~~~~~~~~~~~~~~~	1/2"	᠁ᢅ	
<u></u>	$\left\{ \begin{array}{c} \\ \\ \\ \\ \\ \\ \\ \\ \\ \\ \\ \\ \\ \\ \\ \\ \\ \\ \\$	SINK	1-1/2"	1-1/2"	1/2"	1/2"		2-COMPARTMENT COUNTER MOUNTED
<u> </u>		SHOWER	u	<u></u> .	 1/2"			
	SS SS							
/ <u>&gt;</u>	$\left\{ \begin{array}{c} F \\ 1 \end{array} \right\}$	FILL FAUCET	-	-	1/2"	1/2"		WALL MOUNTED
<u> </u>		DRINKING FOUNTAIN	1-1/2"	1-1/2"	1/2"			WALL-MOUNTED-BELEVELWIFFIBOTTLE FILLER ON LOW SIDE 120/1/60
	$\left( \begin{array}{c} HB \\ 1 \end{array} \right)$	HOSE BIBB			3/4"			EXTERIOR NON-FREEZE
<u> </u>	HB 		~~~~~~~~~~~~~~~~~~~~~~~~~~~~~~~~~~~~~~	~~ <del>~</del> ~~~		$\sim$	~~~~	INTERIOR WALL BOX ኍ፞፞፞፞፞፞፞፞፞
	$\left\{ \begin{array}{c} HB\\ 3 \end{array} \right\}$	HOSE BIBB			3/4"			INTERIOR W/INTEGRAL VACUUM BREAKER (TOILET ROOMS)
2		TEMPERING VALVE			ـــــــــــــــــــــــــــــــــــــ	1/2"	ىرىپى 1/2"	MOUNT UNDER LAVATORY
		ICE MAKER BOX			1/2"			SEE DETAIL 8/P602
	(FD) 1	FLOOR DRAIN	2"	1-1/2"				W/DEEP SEAL TRAP AND ASSE TRAP GUARD
	$\left\langle \begin{array}{c} SD\\ 1 \end{array} \right\rangle$	SHOWER DRAIN	2"	2"				W/DEEP SEAL TRAP AND ASSE TRAP GUARD
	$\overline{\left< \frac{FS}{1} \right>}$	FLOOR SINK	2"	2"				12"x12" PROVIDE GRATE
	(RD) 1	ROOF DRAIN PRIMARY						SEE PLANS FOR SIZE
	RD / 2	ROOF DRAIN SECONDARY						SEE PLANS FOR SIZE
	$\overrightarrow{DN}$	DOWN SPOUT NOZZLE						SEE PLANS FOR SIZE

NOTES:

(1) CONTRACTOR SHALL VERIFY EXACT LOCATION OF ALL PLUMBING FIXTURES AND DRAINS WITH ARCHITECTURAL DRAWINGS PRIOR TO ROUGH-IN OR INSTALLATION. (2) 12" LENGTH. CENTER BASIN IN BLOCK COURSE.

BRANCH WATER LINE SCHEDULE									
FIXTURE	FIXTURE	TOTAL QUANTITY OF FIXTURES SERVED BY A GIVEN PIPE SIZE							
TIXTOIL	UNITS	1/2"	3/4"	1"	1 1/4"	1-1/2"	2"		
WATER CLOSET	10			1	2	3	8		
URINAL	5		1	2	3	6	20		
LAVATORY	2	1	3	5	7	15	50		
SERVICE SINK	4		1	2	3	7	25		
DRINKING FOUNTAIN	1	2	6	10	15	30			
HOSE BIBB	3		1	3	5	10	33		
WALL HYDRANT	3		1	3	5	10	33		
TOTAL FIXTURE UNITS SERVED BY PIPE SIZE		2	6	10	15	30	100		

NOTE: MINIMUM PIPE SIZE TO ANY FIXTURE TO BE 1/2". WHERE PIPE SIZE IS SHOWN ON DRAWINGS, IT SHALL BE FOLLOWED. IN THE EVENT PIPE SIZES ARE NOT SHOWN, THE SIZE OF ANY BRANCH LINE SHALL BE DETERMINED BY USING THIS TABLE. FIND SUM OF TOTAL FIXTURE UNITS ON BRANCH LINE, THEN REDUCE TOTAL BY SUBTRACTING OFF INDIVIDUAL FIXTURE UNITS FOR EACH SUCCESSIVE FIXTURE ALONG THE BRANCH LINE.

# PLUMBING PIPING LEGEND

DESCRIPTION	SYMBOL				
WASTE (BELOW GRADE)					
VENT					
COLD WATER					
HOT WATER (120 DEG.F.)					
HOT WATER RECIRCULATING (120 DEG.F.)					
TEMPERED WATER	T				
GAS 4 OUNCE)	G4oz				
GAS (5LB)	G5#				
DRAIN	D				
PRIMARY ROOF DRAIN					
SECONDARY ROOF DRAIN	SRD				

