
PROJECT: 22812 - GENETIC SCIENCES LEARNING CENTER
PROJECT ADDRESS: 295 CHIPETA WAY
SLC, UT 84108

TO: University of Utah:

This revision forms a part of and modifies the Contract Documents for the subject Prime, dated "10.30.2024 – CONSTRUCTION DOCUMENTS."

I. BID QUESTION RESPONSES

1. Q: On page D100- The plan notes "remove carpet and flooring throughout", "patch and repair holes as needed". Please clarify if the intent is to patch the existing holes in the raised access floor or the slab beneath.
A: The contractor is to patch existing holes in the raised floor. See attached drawings.
2. Q: Sheet D100 demolition note 6 indicates "protect shades and pull cords, coordinate replacement of damaged shades with Owner". For bidding purposes please indicate the currently assumed quantity of shades that need to be replaced.
A: (1) shade missing. (1) shade cloth is damaged. All others are currently functioning properly. (4) shades require shortening where new walls at Conference room 4S130 and Director office 4S155 are to be constructed.
3. Q: Sheet A200 provides details for the Wall Type B1. Wall type B1 shows suspended sound absorbing ceiling supports on what appears to be the ceiling of the Video Production 4S100 room. On A100 RCP plan page it shows the ceiling as gypsum board. Please confirm the following rooms do not receive a suspended ceiling system: Video Office 4S105, Sound Studio 4S120A, Video Production 4S100, Storage 4S100A, Storage 4S100B.
A: The suspended ceiling has been removed as part of Addendum-01. See updated wall types and wall tags on 1/A200 for clarification on the wall/ceiling configuration in these rooms.
4. Q: Please indicate if the "Backdrop" shown on 1/A200 and 18/A200 is OFOI. If contractor furnished and/or installed please specify material.
A: Backdrop shown is OFOI. Contractor to provide blocking at top of wall for mounting. Coordinate size and location with owner.
5. Q: On sheet MH101 general sheet notes 11 & 20 indicate that the general contractor is to hire a 3rd party Test & Balance and Commissioning Agent. Please confirm that it is acceptable for the Test & Balance and Commissioning Agent to be a sub-tier subcontractor under the mechanical contractor.
A: University of Utah to contract the Commissioning Agent. Contractor is to provide the TAB. Owner has confirmed it is acceptable for TAB agent to be sub-tier under the mechanical contractor.
6. Q: Please indicate the floor to deck height for the tenant improvement areas affected.
A: 15'-0" floor to deck, raised floor measures approx. 6".
7. Q: Please confirm that the Sanitary Sewer (SS) piping shown on PL101 is to be installed in the Level 3 Ceiling even though it is shown on the Level 4 Water plan.
A: Yes, the sanitary sewer for the fixtures on level 4 will be run in the ceiling of level 3.
8. Q: For the new Sanitary Sewer piping in the Level 3 Ceiling, what will the working conditions be? Will this work be off-hours or weekends?
A: Contractor to provide notice to owner as indicated in specifications prior to commencing work.

Work in this area is expected to be performed before 8am/after 5pm.

9. Q: For the new Sanitary Sewer piping in Level 3 Ceiling serving new Level 4 fixtures, there will be 3 or 4 Core Drills. What will the working conditions be for the Core Drills?
A: Contractor to provide notice to owner as indicated in specifications prior to commencing work. Disruptive work is expected to be performed before 8am/after 5pm.
10. Q: Spec 233113 Paragraphs 3.7 and 3.8 require Duct Cleaning of new and existing ducts. Please provide marked-up plans clearly showing the extents of which ducts do and don't need to be cleaned
A: Existing ductwork between gridline C & D and Between 5 & 9 on the 4th floor needs to be cleaned
11. Q: Please provide an HVAC Duct Insulation Spec.
A: See attached Duct Insulation Spec.
12. Q: Are there any approved/restricted Control Wiring Subcontractors for the Thermostat replacements identified by Sheet Note 6/MH101?
A: Approved: Johnson Controls
13. Q: Controls Schematics and/or Specs have not been provided. Please provide a model number for the desired Thermostats that shall be used to replace the existing Thermostats identified by Sheet Note 6/MH101.
A: Provide Johnson Controls TEC3000 series thermostats
14. Q: Can a spec for the raised access floor spec please be provided?
A: No manufacturer or model is specified in record drawings. Based on labels on existing salvaged tiles, we believe the product is: Maxcess RWC-200, R2F2.
15. Q: Can a shelving track spec please be provided?
A: We believe the product required is: Eagle Group SDFT-18. Contractor is to verify with owner.
16. Q: Can flat file storage spec please be provided?
A: Basis of Design (or approved equal): Olpin Group, Flat file cabinet. Size and base as indicated in updated addendum-01 documents. Color: #90 Pure White.
17. Q: Can a metal privacy curtain spec please be provided?
A: See spec section 122200 - Curtains and Drapes
18. Q: Can a spec please be provided for the custom glass print that is wanted per 1/201?
A: See spec section 101100 - Visual Display Units, 2.2,A
19. Q: Can a specs for ALT #1 doors that are to be replaced please be provided?
A: See spec section 081416
20. Q: Please advise if the contractor is responsible for devices and cabling for data audio visual and security?
A: Contractor is responsible for all raceways only. Refer to associated riser diagrams in drawings.
21. Q: Please advise if the contractor is to provide the backdrop called out per 18/A200. If so can spec for the backdrop please be provided?
A: See question 4 response.
22. Q: Plans call for a markerboard and glass board but there is only a glass board in the specs. Please advise if the contractor is to provide markerboards. If so, can a spec for the markerboards please be provided?
A: See spec section 101100 - Visual Display Units, 2.2,A & 2.2,B for items noted GW1 and GW2 and section 2.3,A for items noted MB1.
23. Q: Please advise if the contractor is tying into the existing sewer line under existing access floor or if the contractor is to core drill to level 3 to tie into the existing?
A: See question 7 response.

24. Q: On A200 there is a light grade grid around the walls. Please advise what this is, and if the contractor is responsible to do anything with it?
A: Hatch indicates where raised floor is to be patched at new walls that run floor to deck. See wall type B1 for more info.
25. Q: A supplier of the fire treated material has ½ inch fire treated not 5/8 as called out on the plans. Please advise if the contractor can use ½ inch instead of 5/8 inch
A: ½" fire treated material is acceptable so long as required alignments outlined in the construction documents are met.
26. Q: In talking with a subcontractor about modifying existing blinds. The sub proposes that the owner go with new blinds as it will be cheaper then removing, storing, modifying and reinstalling the old blinds. Please advise if the blinds called out to be modified and reinstalled can be replaced with new?
A: New blinds are acceptable so long as they are an exact match to the existing blinds.
27. Q: Please provide fixture type identification for what appears to be recess fixtures in room 4S130.
A: Refer to attached EL101 sheet. Recessed can light fixture ID is (D4).
28. Q: Please provide location of fixture type WM14 on drawing.
A: Fixture WM14 is located in the booth. Refer to sheet EL101 in drawings.
29. Q: Please provide manufacturer and AIC rating of panel 4EE for proper breaker pricing.
A: See attached sheet EP601 for updated AIC rating. AIC rating is 10,000. Contractor to field verify and provide as required in bid.
30. Q: Please provide manufacturer and AIC rating of panel UL17B for proper breaker pricing.
A: Refer to panel schedules on EP601 in drawings. AIC rating is 22,000. Contractor to field verify and provide as required in bid.

II. SPECIFICATIONS

ARCHITECTURAL

1. 085673 Sound Control Windows spec added

MECHANICAL

1. 230713 Duct Insulation spec added

II. DRAWINGS

- A. The following sheet(s) are Reissued and, designated ___ADDENDUM-01___12/20/2024___:

ARCHITECTURAL

1. G102 Construction barrier and staging area noted, general notes added
2. D100 1 / patch and repair holes in raised floor as needed for new floor finish
Noted to remove wallpaper under exterior windows
3. A100 2 / new ceiling detail 14 noted on drawings
Added B2 and B3 top of wall versions to wall type B1. Suspended sound absorbing ceiling removed from wall type B1.
4. A120 FF&E Schedule: modified Flat File Storage, updated identifier to PN-1
A200 Added B2 and B3 top of wall versions to wall type B1. Suspended sound absorbing ceiling removed from wall type B1.
Updated wall tags at Video Office, Sound Studio, Sound Office and Video production.
5. A201 Added TD (Towel Dispenser) and SD (Soap Dispenser) to legend, owner provided, contractor to provide blocking in walls
8, 15, 20 / dimensioned seams added to felt wall panels
25 / dimensioned seams added to textured felt wall panel

- 35, 39 / noted for contractor to provide blocking for paper towel and soap dispensers, dimensions added
- 6. A500 3 / Millwork door bid alternate clarification and door thickness dimension provided
- 7. A501 14 / SOFFIT DETAIL - ACT / GYP added
- 8. A515 8 / plywood noted, align material
9 / Plan detail callout added
11, 12, 13 / plywood noted
14 / M3 – SNACK BAR PLAN DETAIL added
- 9. A516 1, 3 / Millwork adjustments
10 / additional adjustable shelves to upper and lower cabinets
- 10. A517 3, 4, 5 / counter height adjustment, flat file storage dimension update, added center support for island
- 11. A601 13 / Door-mounted blackout shade added to detail
14 / Updated acoustic window STC requirement
- 12. A900 Updated renderings

MECHANICAL

- 1. M101 Relocated thermostat from Touchdown 4S110 to Booth 4S115
- 2. ME501 Clarification on detail naming

ELECTRICAL

- 1. EP101 Relocation of receptacles and data devices
- 2. EP601 Updated AIC value for panel 4EE
- 3. EL101 Relocation of light switch in Booth room and updated light fixture tag
- 4. EL602 Update lighting fixture schedule
- 5. EY101 Added/relocated fire alarm devices and updated candela ratings

END OF ADDENDUM-01



SECTION 085673 - ALUMINUM SOUND CONTROL WINDOWS

PART 1 - GENERAL

1.1 SUMMARY

A. Section Includes:

1. Aluminum sound control windows and accessories for installation.

1.2 REFERENCES

A. American Society for Testing and Materials (ASTM)

1. ASTM E90: Standard Test Method for Laboratory Measurement of Airborne Sound Transmission Loss of Building Partitions and Elements.

1.3 COORDINATION

- A. Finish Matching: Coordinate all exposed exterior aluminum components and trim to ensure uniform and consistent color and appearance. Use products specified in this Section as a benchmark. Architect's decision will be final as to whether a proposed product matches.

1.4 ACTION SUBMITTALS

A. Product Data: For each type of product.

1. Include construction details, material descriptions, glazing and fabrication methods, dimensions of individual components and profiles, hardware, and finishes.

B. Shop Drawings:

1. Plans, elevations, sections, hardware, accessories, insect screens, operational clearances, and details of installation, including anchor, flashing, and sealant installation.

C. Samples for Initial Selection: Manufacturer's standard color sheets, showing full range of available colors for each type of exposed finish.

D. Samples for Verification: Actual sample of finished products for each type of exposed finish:

1. Exposed Aluminum Finishes: Manufacturers' standard size.
2. Exposed Hardware: Full-size units.

- E. Product Schedule: For aluminum windows. Use same designations indicated on Drawings.

1.5 INFORMATIONAL SUBMITTALS

- A. Test and Evaluation Reports:
 - 1. Product Test Reports: For each aluminum window, for tests performed by qualified testing agency.
- B. Field Quality-Control Reports: For aluminum windows.
- C. Qualification Statements: For manufacturer and Installer.
- D. Sample warranties.

1.6 CLOSEOUT SUBMITTALS

- A. Warranty Documentation:
 - 1. Manufacturers' special warranties.

1.7 QUALITY ASSURANCE

- A. Manufacturer Qualifications: A manufacturer capable of fabricating aluminum sound control windows that meet or exceed performance requirements indicated and of documenting this performance by test reports and calculations.
- B. Installer Qualifications: Authorized representative who is trained and approved by aluminum window manufacturer.

1.8 DELIVERY, STORAGE, AND HANDLING

- A. Deliver aluminum windows to Project site in original, unopened packages and store them in accordance with manufacturer's written instructions. Protect aluminum windows against damage from moisture, humidity, temperature extremes, direct sunlight, surface contamination, and other causes.
- B. Handle aluminum windows in a manner that prevents damage before, during, and after installation.

1.9 FIELD CONDITIONS

- A. Environmental Limitations: Do not install aluminum windows outside of limits recommended in writing by manufacturer.

1.10 WARRANTY

- A. Special Warranty: Manufacturer agrees to repair or replace aluminum windows that fail in materials or workmanship within specified warranty period.
 - 1. Failures include, but are not limited to, the following:
 - a. Failure to meet performance requirements.
 - b. Structural failures, including excessive deflection, water leakage, condensation, and air infiltration.
 - c. Faulty operation of movable sash and hardware.
 - d. Deterioration of materials and finishes beyond normal weathering.
 - e. Failure of insulating glass.
 - 2. Warranty Period:
 - a. Window: Five years from date of Substantial Completion.
 - b. Glazing Units: Five years from date of Substantial Completion.
 - c. Hardware: Three years from date of Substantial Completion.
 - d. Aluminum Finish: 10 years from date of Substantial Completion.

PART 2 - PRODUCTS

2.1 SOURCE LIMITATIONS

- A. Obtain aluminum sound control windows from single source from single manufacturer.

2.2 PERFORMANCE REQUIREMENTS

- A. Performance Class and Grade: AAMA/WDMA/CSA 101/I.S.2/A440 as follows:
 - 1. Minimum Performance Class: CW.
 - 2. Minimum Performance Grade: 30.
- B. Performance Requirements:
 - 1. Acoustical Characteristics: Acoustical panels to perform as specified when tested in accordance with ASTM E90.

2.3 ALUMINUM SOUND CONTROL WINDOWS

- A. Basis-of-Design: Product subject to compliance with requirements, provide Acoustical Surfaces inc., Noise S.T.O.P. Studio 6 soundproof window or comparable product.
- B. Provide manufacturer's standard aluminum window assemblies consisting of frames, sashes, glass, hardware, fasteners, and all components and accessories as required for a complete installation.

- C. Glazing System: 1" clear insulated glass (I.G.) unit made from two pieces of ¼" tempered-laminated glass with ½" airspace, with additional 3/8" clear tempered-laminated glass.
- D. Glazing Angle: Standard – 4 degrees
- E. Window size: as indicated in drawings.
- F. Window Frame:
 - 1. Frame Composition: Anodized Aluminum
 - 2. Frame size: 6-3/8"
 - 3. Frame Finish: Powder coat - white.
 - 4. Acoustical Insert: Sound Silencer – Class A Fire Rated
- G. Window Performance:
 - 1. Acoustical Performance
 - a. Sound Transmission Class (STC) per ASTM E90 – 55
- H. Fasteners: Noncorrosive and compatible with window members, trim, hardware, anchors, and other components.
 - 1. Exposed Fasteners: Avoid exposed fasteners to greatest extent possible. For application of hardware, use fasteners that match finish hardware being fastened.

2.4 ACCESSORIES

- A. Attachment hardware for windows as specified by manufacturer for installation.

2.5 FABRICATION

- A. Fabricate aluminum windows in sizes indicated. Include a complete system for assembling components and anchoring windows.
- B. Glaze aluminum windows in the factory.
- C. Complete fabrication, assembly, finishing, hardware application, and other work in the factory to greatest extent possible. Disassemble components only as necessary for shipment and installation.

2.6 GENERAL FINISH REQUIREMENTS

- A. Comply with NAAMM/NOMMA AMP 500 "Metal Finishes Manual for Architectural and Metal Products," for recommendations for applying and designating finishes.
- B. Protect mechanical finishes on exposed surfaces from damage by applying a strippable, temporary protective covering before shipping.

- C. Appearance of Finished Work: Noticeable variations in same piece are unacceptable. Variations in appearance of adjoining components are acceptable if they are within the range of approved Samples and are assembled or installed to minimize contrast.

2.7 ALUMINUM FINISHES

- A. Baked-Enamel or Powder-Coat Finish: AAMA 2603 except with a minimum dry film thickness of 1.5 mils (0.04 mm). Comply with coating manufacturer's written instructions for cleaning, conversion coating, and applying and baking finish.
 - 1. Color and Gloss: As selected by Architect from manufacturer's full range.

PART 3 - EXECUTION

3.1 EXAMINATION

- A. Examine openings, substrates, structural support, anchorage, and conditions, with Installer present, for compliance with requirements for installation tolerances and other conditions affecting performance of the Work.
- B. Verify rough opening dimensions, levelness of sill plate, and operational clearances.
- C. Proceed with installation only after unsatisfactory conditions have been corrected.

3.2 INSTALLATION

- A. Comply with manufacturer's written instructions for installing windows, hardware, accessories, and other components. For installation procedures and requirements not addressed in manufacturer's written instructions, comply with installation requirements in ASTM E2112.
- B. Install windows level, plumb, square, true to line, without distortion or impeding thermal movement, anchored securely in place to structural support, and in proper relation to wall flashing and other adjacent construction to produce weathertight construction.

3.3 CLEANING AND PROTECTION

- A. Clean exposed surfaces immediately after installing windows using manufacturer's written instructions. Avoid damaging finishes. Remove excess sealants, glazing materials, dirt, and other substances.
- B. Remove and replace glass that has been broken, chipped, cracked, abraded, or damaged during construction period.
- C. Protect window surfaces from contact with contaminating substances resulting from construction operations. If contaminating substances do contact window surfaces,

085673 - ALUMINUM SOUND CONTROL WINDOWS

remove contaminants immediately in accordance with manufacturer's written instructions.

END OF SECTION 085673

SECTION 230713 - DUCT INSULATION

SECTION 230713 - DUCT INSULATION

PART 1 - GENERAL

1.1 RELATED DOCUMENTS

- A. Drawings and general provisions of the Contract, including General and Supplementary Conditions and Division 01 Specification Sections, apply to this Section.

1.2 SUMMARY

- A. Section includes insulating the following duct services:
 - 1. Indoor, concealed supply and outdoor air.
 - 2. Indoor, exposed supply and outdoor air.
- B. Related Sections:
 - 1. Section 230719 "HVAC Piping Insulation."
 - 2. Section 233113 "Metal Ducts" for duct liners.

1.3 ACTION SUBMITTALS

- A. Product Data: For each type of product indicated. Include thermal conductivity, water-vapor permeance thickness, and jackets (both factory- and field-applied if any).
 - 1. For adhesives and sealants, documentation including printed statement of VOC content.

1.4 INFORMATIONAL SUBMITTALS

- A. Qualification Data: For qualified Installer.

1.5 QUALITY ASSURANCE

- A. Installer Qualifications: Skilled mechanics who have successfully completed an apprenticeship program or another craft training program certified by the Department of Labor, Bureau of Apprenticeship and Training.
- B. Surface-Burning Characteristics: For insulation and related materials, as determined by testing identical products according to ASTM E 84, by a testing agency acceptable to authorities having jurisdiction. Factory label insulation and jacket materials and adhesive, mastic, tapes, and cement material containers, with appropriate markings of applicable testing agency.
 - 1. Insulation Installed Indoors: Flame-spread index of 25 or less, and smoke-developed index of 50 or less.
 - 2. Insulation Installed Outdoors: Flame-spread index of 75 or less, and smoke-developed index of 150 or less.

1.6 DELIVERY, STORAGE, AND HANDLING

- A. Packaging: Insulation material containers shall be marked by manufacturer with appropriate ASTM standard designation, type and grade, and maximum use temperature.

SECTION 230713 - DUCT INSULATION

1.7 COORDINATION

- A. Coordinate sizes and locations of supports, hangers, and insulation shields specified in Section 230529 "Hangers and Supports for HVAC Piping and Equipment."
- B. Coordinate clearance requirements with duct Installer for duct insulation application. Before preparing ductwork Shop Drawings, establish and maintain clearance requirements for installation of insulation and field-applied jackets and finishes and for space required for maintenance.
- C. Coordinate installation and testing of heat tracing.

1.8 SCHEDULING

- A. Schedule insulation application after pressure testing systems and, where required, after installing and testing heat tracing. Insulation application may begin on segments that have satisfactory test results.
- B. Complete installation and concealment of plastic materials as rapidly as possible in each area of construction.

PART 2 - PRODUCTS

2.1 INSULATION MATERIALS

- A. Comply with requirements in "Duct Insulation Schedule, General," "Indoor Duct and Plenum Insulation Schedule," articles for where insulating materials shall be applied.
- B. Products shall not contain asbestos, lead, mercury, or mercury compounds.
- C. Products that come in contact with stainless steel shall have a leachable chloride content of less than 50 ppm when tested according to ASTM C 871.
- D. Insulation materials for use on austenitic stainless steel shall be qualified as acceptable according to ASTM C 795.
- E. Foam insulation materials shall not use CFC or HCFC blowing agents in the manufacturing process.
- F. Provide fiberglass faced duct wrap Type IV with factory applied flame retardant foil reinforced Kraft facing FRK-25, U.L. Label.
- G. Glass-Fiber Blanket: Glass fibers bonded with a thermosetting resin; suitable for maximum use temperature up to 450 deg F in accordance with ASTM C411. Comply with ASTM C553, Type II, and ASTM C1290, Type III with factory-applied FSK jacket. Factory-applied jacket requirements are specified in "Factory-Applied Jackets" Article.
- H. Glass-Fiber Board Insulation: Glass fibers bonded with a thermosetting resin; suitable for maximum use temperature between 35 deg F and 250 deg F for jacketed and between 35

SECTION 230713 - DUCT INSULATION

deg F and 450 deg F for unfaced in accordance with ASTM C411. Comply with ASTM C612, Type IA or Type IB. For duct and plenum applications, provide insulation unfaced

2.2 ADHESIVES

- A. Materials shall be compatible with insulation materials, jackets, and substrates and for bonding insulation to itself and to surfaces to be insulated unless otherwise indicated.
- B. ASJ Adhesive, and FSK Jacket Adhesive: Comply with MIL-A-3316C, Class 2, Grade A for bonding insulation jacket lap seams and joints.
 - 1. **Products:** Subject to compliance with requirements, provide one of the following:
 - a. [Childers Brand, Specialty Construction Brands, Inc., a business of H. B. Fuller Company; CP-82.](#)
 - b. [Eagle Bridges - Marathon Industries; 225.](#)
 - c. [Foster Brand, Specialty Construction Brands, Inc., a business of H. B. Fuller Company; 85-50.Mon-Eco Industries, Inc.; 22-25.](#)
 - 2. For indoor applications, adhesive shall have a VOC content of 50 g/L or less when calculated according to 40 CFR 59, Subpart D (EPA Method 24).

2.3 MASTICS

- A. Materials shall be compatible with insulation materials, jackets, and substrates; comply with MIL-PRF-19565C, Type II.
 - 1. For indoor applications, use mastics that have a VOC content of 50 g/L or less when calculated according to 40 CFR 59, Subpart D (EPA Method 24).
- B. Vapor-Barrier Mastic: Water based; suitable for indoor use on below ambient services.
 - 1. **Products:** Subject to compliance with requirements, provide one of the following:
 - a. [Foster Brand, Specialty Construction Brands, Inc., a business of H. B. Fuller Company; 30-80/30-90.](#)
 - b. [Vimasco Corporation; 749.](#)
 - 2. Water-Vapor Permeance: ASTM E 96/E 96M, Procedure B, 0.013 perm at 43-mil dry film thickness.
 - 3. Service Temperature Range: Minus 20 to plus 180 deg F.
 - 4. Solids Content: ASTM D 1644, 58 percent by volume and 70 percent by weight.
 - 5. Color: White.

2.4 FACTORY-APPLIED JACKETS

- A. Insulation system schedules indicate factory-applied jackets on various applications. When factory-applied jackets are indicated, comply with the following:
 - 1. ASJ: White, kraft-paper, fiberglass-reinforced scrim with aluminum-foil backing; complying with ASTM C 1136, Type I.
 - 2. FSK Jacket: Aluminum-foil, fiberglass-reinforced scrim with kraft-paper backing; complying with ASTM C1136, Type II.

SECTION 230713 - DUCT INSULATION

2.5 TAPES

- A. ASJ Tape: White vapor-retarder tape matching factory-applied jacket with acrylic adhesive, complying with ASTM C 1136.
1. **Products:** Subject to compliance with requirements, provide one of the following:
 - a. [ABI, Ideal Tape Division](#); 428 AWF ASJ.
 - b. [Avery Dennison Corporation](#), Specialty Tapes Division; Fasson 0836.
 - c. [Compac Corporation](#); 104 and 105.
 - d. [Venture Tape](#); 1540 CW Plus, 1542 CW Plus, and 1542 CW Plus/SQ.
 2. Width: 3 inches.
 3. Thickness: 11.5 mils.
 4. Adhesion: 90 ounces force/inch in width.
 5. Elongation: 2 percent.
 6. Tensile Strength: 40 lbf/inch in width.
 7. ASJ Tape Disks and Squares: Precut disks or squares of ASJ tape.
- B. Aluminum-Foil Tape: Vapor-retarder tape with acrylic adhesive.
1. **Products:** Subject to compliance with requirements, provide one of the following:
 - a. [ABI, Ideal Tape Division](#); 488 AWF.
 - b. [Avery Dennison Corporation](#), Specialty Tapes Division; Fasson 0800.
 - c. [Compac Corporation](#); 120.
 - d. [Venture Tape](#); 3520 CW.
 2. Width: 2 inches.
 3. Thickness: 3.7 mils.
 4. Adhesion: 100 ounces force/inch in width.
 5. Elongation: 5 percent.
 6. Tensile Strength: 34 lbf/inch in width.

2.6 SECUREMENTS

- A. Bands:
1. **Products:** Subject to compliance with requirements, provide one of the following:
 - a. [ITW Insulation Systems](#); Gerrard Strapping and Seals.
 - b. [RPR Products, Inc.](#); Insul-Mate Strapping, Seals, and Springs.
 2. Stainless Steel: ASTM A 167 or ASTM A 240/A 240M, Type 304 or Type 316; 0.015 inch thick, 3/4 inch wide with wing seal or closed seal.
 3. Aluminum: ASTM B 209, Alloy 3003, 3005, 3105, or 5005; Temper H-14, 0.020 inch thick, 3/4 inch wide with wing seal or closed seal.
 4. Springs: Twin spring set constructed of stainless steel with ends flat and slotted to accept metal bands. Spring size determined by manufacturer for application.
- B. Insulation Pins and Hangers:
1. Capacitor-Discharge-Weld Pins: Copper- or zinc-coated steel pin, fully annealed for capacitor-discharge welding, 0.135-inch- diameter shank, length to suit depth of insulation indicated.
 - a. **Products:** Subject to compliance with requirements, provide one of the following:
 - 1) [AGM Industries, Inc.](#); CWP-1.
 - 2) [GEMCO; CD.](#)

- 3) [Midwest Fasteners, Inc.](#); CD.
 - 4) [Nelson Stud Welding](#); TPA, TPC, and TPS.
2. Cupped-Head, Capacitor-Discharge-Weld Pins: Copper- or zinc-coated steel pin, fully annealed for capacitor-discharge welding, 0.135-inch- diameter shank, length to suit depth of insulation indicated with integral 1-1/2-inch galvanized carbon-steel washer.
 - a. **Products:** Subject to compliance with requirements, provide one of the following:
 - 1) [AGM Industries, Inc.](#); CHP-1.
 - 2) [GEMCO](#); Cupped Head Weld Pin.
 - 3) [Midwest Fasteners, Inc.](#); Cupped Head.
 - 4) [Nelson Stud Welding](#); CHP.
 3. Metal, Adhesively Attached, Perforated-Base Insulation Hangers: Baseplate welded to projecting spindle that is capable of holding insulation, of thickness indicated, securely in position indicated when self-locking washer is in place. Comply with the following requirements:
 - a. **Products:** Subject to compliance with requirements, provide one of the following:
 - 1) [AGM Industries, Inc.](#); Tactoo Perforated Base Insul-Hangers.
 - 2) [GEMCO](#); Perforated Base.
 - 3) [Midwest Fasteners, Inc.](#); Spindle.
 - b. Baseplate: Perforated, galvanized carbon-steel sheet, 0.030 inch thick by 2 inches square.
 - c. Spindle: Copper- or zinc-coated, low-carbon steel, aluminum, or stainless steel, fully annealed, 0.106-inch- diameter shank, length to suit depth of insulation indicated.
 - d. Adhesive: Recommended by hanger manufacturer. Product with demonstrated capability to bond insulation hanger securely to substrates indicated without damaging insulation, hangers, and substrates.
 4. Nonmetal, Adhesively Attached, Perforated-Base Insulation Hangers: Baseplate fastened to projecting spindle that is capable of holding insulation, of thickness indicated, securely in position indicated when self-locking washer is in place. Comply with the following requirements:
 - a. **Products:** Subject to compliance with requirements, provide one of the following:
 - 1) [GEMCO](#); Nylon Hangers.
 - 2) [Midwest Fasteners, Inc.](#); Nylon Insulation Hangers.
 - b. Baseplate: Perforated, nylon sheet, 0.030 inch thick by 1-1/2 inches in diameter.
 - c. Spindle: Nylon, 0.106-inch- diameter shank, length to suit depth of insulation indicated, up to 2-1/2 inches.
 - d. Adhesive: Recommended by hanger manufacturer. Product with demonstrated capability to bond insulation hanger securely to substrates indicated without damaging insulation, hangers, and substrates.
 5. Self-Sticking-Base Insulation Hangers: Baseplate welded to projecting spindle that is capable of holding insulation, of thickness indicated, securely in position indicated when self-locking washer is in place. Comply with the following requirements:
 - a. **Products:** Subject to compliance with requirements, provide one of the following:
 - 1) [AGM Industries, Inc.](#); Tactoo Self-Adhering Insul-Hangers.
 - 2) [GEMCO](#); Peel & Press.
 - 3) [Midwest Fasteners, Inc.](#); Self Stick.
 - b. Baseplate: Galvanized carbon-steel sheet, 0.030 inch thick by 2 inches square.

SECTION 230713 - DUCT INSULATION

- c. Spindle: Copper- or zinc-coated, low-carbon steel, aluminum, or stainless steel, fully annealed, 0.106-inch- diameter shank, length to suit depth of insulation indicated.
 - d. Adhesive-backed base with a peel-off protective cover.
 - 6. Insulation-Retaining Washers: Self-locking washers formed from 0.016-inch- thick, galvanized-steel, aluminum, or stainless-steel sheet, with beveled edge sized as required to hold insulation securely in place but not less than 1-1/2 inches in diameter.
 - a. **Products:** Subject to compliance with requirements, provide one of the following:
 - 1) [AGM Industries, Inc.](#); RC-150.
 - 2) [GEMCO](#); R-150.
 - 3) [Midwest Fasteners, Inc.](#); WA-150.
 - 4) [Nelson Stud Welding](#); Speed Clips.
 - b. Protect ends with capped self-locking washers incorporating a spring steel insert to ensure permanent retention of cap in exposed locations.
 - 7. Nonmetal Insulation-Retaining Washers: Self-locking washers formed from 0.016-inch-thick nylon sheet, with beveled edge sized as required to hold insulation securely in place but not less than 1-1/2 inches in diameter.
 - a. **Manufacturers:** Subject to compliance with requirements, provide products by one of the following:
 - 1) [GEMCO](#).
 - 2) [Midwest Fasteners, Inc.](#)
 - C. Staples: Outward-clinching insulation staples, nominal 3/4-inch- wide, stainless steel or Monel.
 - D. Wire: 0.062-inch soft-annealed, stainless steel.
 - 1. **Manufacturers:** Subject to compliance with requirements, provide products by one of the following:
 - a. [C & F Wire](#).
- 2.7 CORNER ANGLES
- A. PVC Corner Angles: 30 mils thick, minimum 1 by 1 inch, PVC according to ASTM D 1784, Class 16354-C. White or color-coded to match adjacent surface.
 - B. Aluminum Corner Angles: 0.040 inch thick, minimum 1 by 1 inch, aluminum according to ASTM B 209, Alloy 3003, 3005, 3105, or 5005; Temper H-14.
 - C. Stainless-Steel Corner Angles: 0.024 inch thick, minimum 1 by 1 inch, stainless steel according to ASTM A 167 or ASTM A 240/A 240M, Type 304 or Type 316.

PART 3 - EXECUTION

3.1 EXAMINATION

- A. Examine substrates and conditions for compliance with requirements for installation tolerances and other conditions affecting performance of insulation application.
 - 1. Verify that systems to be insulated have been tested and are free of defects.

SECTION 230713 - DUCT INSULATION

2. Verify that surfaces to be insulated are clean and dry.

B. Proceed with installation only after unsatisfactory conditions have been corrected.

3.2 PREPARATION

A. Surface Preparation: Clean and dry surfaces to receive insulation. Remove materials that will adversely affect insulation application.

3.3 GENERAL INSTALLATION REQUIREMENTS

A. Duct insulation wrap in exposed corridors shall be canvas covered and painted to match existing duct insulation.

B. Install insulation materials, accessories, and finishes with smooth, straight, and even surfaces; free of voids throughout the length of ducts and fittings.

C. Install insulation materials, vapor barriers or retarders, jackets, and thicknesses required for each item of duct system as specified in insulation system schedules.

D. Install accessories compatible with insulation materials and suitable for the service. Install accessories that do not corrode, soften, or otherwise attack insulation or jacket in either wet or dry state.

E. Install insulation with longitudinal seams at top and bottom of horizontal runs.

F. Install multiple layers of insulation with longitudinal and end seams staggered.

G. Keep insulation materials dry during application and finishing.

H. Install insulation with tight longitudinal seams and end joints. Bond seams and joints with adhesive recommended by insulation material manufacturer.

I. Install insulation with least number of joints practical.

J. Where vapor barrier is indicated, seal joints, seams, and penetrations in insulation at hangers, supports, anchors, and other projections with vapor-barrier mastic.

1. Install insulation continuously through hangers and around anchor attachments.

2. For insulation application where vapor barriers are indicated, extend insulation on anchor legs from point of attachment to supported item to point of attachment to structure. Taper and seal ends at attachment to structure with vapor-barrier mastic.

3. Install insert materials and install insulation to tightly join the insert. Seal insulation to insulation inserts with adhesive or sealing compound recommended by insulation material manufacturer.

K. Apply adhesives, mastics, and sealants at manufacturer's recommended coverage rate and wet and dry film thicknesses.

L. Install insulation with factory-applied jackets as follows:

SECTION 230713 - DUCT INSULATION

1. Draw jacket tight and smooth.
 2. Cover circumferential joints with 3-inch- wide strips, of same material as insulation jacket. Secure strips with adhesive and outward clinching staples along both edges of strip, spaced 4 inches o.c. Adhere insulation with 4" strips of Insulation Bonding Adhesive at 8" on center.
 3. Overlap jacket longitudinal seams at least 2 inches. Clean and dry surface to receive self-sealing lap. Staple laps with outward clinching staples along edge at 4 inches o.c. Adhere insulation with 4" strips of Insulation Bonding Adhesive at 8" on center. Cover longitudinal joints with 3-inch wide strips, of same material as insulation jacket.
 - a. For below ambient services, apply vapor-barrier mastic over staples.
 4. Cover joints and seams with tape, according to insulation material manufacturer's written instructions, to maintain vapor seal.
 5. Where vapor barriers are indicated, apply vapor-barrier mastic on seams and joints and at ends adjacent to duct flanges and fittings.
- M. Cut insulation in a manner to avoid compressing insulation more than 75 percent of its nominal thickness.
- N. Finish installation with systems at operating conditions. Repair joint separations and cracking due to thermal movement.
- O. Repair damaged insulation facings by applying same facing material over damaged areas. Extend patches at least 4 inches beyond damaged areas. Adhere, staple, and seal patches similar to butt joints.

3.4 PENETRATIONS

- A. Insulation Installation at Roof Penetrations: Install insulation continuously through roof penetrations.
1. Seal penetrations with flashing sealant.
 2. For applications requiring only indoor insulation, terminate insulation above roof surface and seal with joint sealant. For applications requiring indoor and outdoor insulation, install insulation for outdoor applications tightly joined to indoor insulation ends. Seal joint with joint sealant.
 3. Extend jacket of outdoor insulation outside roof flashing at least 2 inches below top of roof flashing.
 4. Seal jacket to roof flashing with flashing sealant.
- B. Insulation Installation at Aboveground Exterior Wall Penetrations: Install insulation continuously through wall penetrations.
1. Seal penetrations with flashing sealant.
 2. For applications requiring only indoor insulation, terminate insulation inside wall surface and seal with joint sealant. For applications requiring indoor and outdoor insulation, install insulation for outdoor applications tightly joined to indoor insulation ends. Seal joint with joint sealant.
 3. Extend jacket of outdoor insulation outside wall flashing and overlap wall flashing at least 2 inches.
 4. Seal jacket to wall flashing with flashing sealant.

SECTION 230713 - DUCT INSULATION

- C. Insulation Installation at Interior Wall and Partition Penetrations (That Are Not Fire Rated): Install insulation continuously through walls and partitions.
- D. Insulation Installation at Fire-Rated Wall and Partition Penetrations: Terminate insulation at fire damper sleeves for fire-rated wall and partition penetrations. Externally insulate damper sleeves to match adjacent insulation and overlap duct insulation at least 2 inches.
 - 1. Comply with requirements in Section 078413 "Penetration Firestopping" for firestopping and fire-resistive joint sealers.
- E. Insulation Installation at Floor Penetrations:
 - 1. Duct: For penetrations through fire-rated assemblies, terminate insulation at fire damper sleeves and externally insulate damper sleeve beyond floor to match adjacent duct insulation. Overlap damper sleeve and duct insulation at least 2 inches.
 - 2. Seal penetrations through fire-rated assemblies. Comply with requirements in Section 078413 "Penetration Firestopping."

3.5 INSTALLATION OF FLEXIBLE ELASTOMERIC INSULATION

- A. Seal longitudinal seams and end joints with manufacturer's recommended adhesive to eliminate openings in insulation that allow passage of air to surface being insulated.

3.6 INSTALLATION OF MINERAL-FIBER INSULATION

- A. Blanket Insulation Installation on Ducts and Plenums: Secure with adhesive and insulation pins.
 - 1. Apply adhesives according to manufacturer's recommended coverage rates per unit area, for 100 percent coverage of duct and plenum surfaces.
 - 2. Apply adhesive to entire circumference of ducts and to all surfaces of fittings and transitions.
 - 3. Install either capacitor-discharge-weld pins and speed washers or cupped-head, capacitor-discharge-weld pins on sides and bottom of horizontal ducts and sides of vertical ducts as follows:
 - a. On duct sides with dimensions 18 inches (450 mm) and smaller, place pins along longitudinal centerline of duct. Space 3 inches (75 mm) maximum from insulation end joints, and 16 inches (400 mm) o.c.
 - b. On duct sides with dimensions larger than 18 inches (450 mm), place pins 16 inches (400 mm) o.c. each way, and 3 inches (75 mm) maximum from insulation joints. Install additional pins to hold insulation tightly against surface at cross bracing.
 - c. Pins may be omitted from top surface of horizontal, rectangular ducts and plenums.
 - d. Do not over-compress insulation during installation.
 - e. Impale insulation over pins and attach speed washers.

- f. Cut excess portion of pins extending beyond speed washers or bend parallel with insulation surface. Cover exposed pins and washers with tape matching insulation facing.
 4. For ducts and plenums with surface temperatures below ambient, install a continuous unbroken vapor barrier. Create a facing lap for longitudinal seams and end joints with insulation by removing 2 inches (50 mm) from one edge and one end of insulation segment. Secure laps to adjacent insulation section with 1/2-inch (13-mm) outward-clinching staples, 1 inch (25 mm) o.c. Install vapor barrier consisting of factory- or field-applied jacket, adhesive, vapor-barrier mastic, and sealant at joints, seams, and protrusions.
 - a. Repair punctures, tears, and penetrations with tape or mastic to maintain vapor-barrier seal.
 - b. Install vapor stops for ductwork and plenums operating below 50 deg F (10 deg C) at 18-foot (5.5-m) intervals. Vapor stops shall consist of vapor-barrier mastic applied in a Z-shaped pattern over insulation face, along butt end of insulation, and over the surface. Cover insulation face and surface to be insulated a width equal to two times the insulation thickness, but not less than 3 inches (75 mm).
 5. Overlap unfaced blankets a minimum of 2 inches (50 mm) on longitudinal seams and end joints. At end joints, secure with steel bands spaced a maximum of 18 inches (450 mm) o.c.
 6. Install insulation on rectangular duct elbows and transitions with a full insulation section for each surface. Install insulation on round and flat-oval duct elbows with individually mitered gores cut to fit the elbow.
 7. Insulate duct stiffeners, hangers, and flanges that protrude beyond insulation surface with 6-inch- (150-mm-) wide strips of same material used to insulate duct. Secure on alternating sides of stiffener, hanger, and flange with pins spaced 6 inches (150 mm) o.c.
- B. Board Insulation Installation on Ducts and Plenums: Secure with adhesive and insulation pins.
 1. Apply adhesives according to manufacturer's recommended coverage rates per unit area, for 100 percent coverage of duct and plenum surfaces.
 2. Apply adhesive to entire circumference of ducts and to all surfaces of fittings and transitions.
 3. Install either capacitor-discharge-weld pins and speed washers or cupped-head, capacitor-discharge-weld pins on sides and bottom of horizontal ducts and sides of vertical ducts as follows:
 - a. On duct sides with dimensions 18 inches (450 mm) and smaller, place pins along longitudinal centerline of duct. Space 3 inches (75 mm) maximum from insulation end joints, and 16 inches (400 mm) o.c.
 - b. On duct sides with dimensions larger than 18 inches (450 mm), space pins 16 inches (400 mm) o.c. each way, and 3 inches (75 mm) maximum from insulation joints. Install additional pins to hold insulation tightly against surface at cross bracing.

SECTION 230713 - DUCT INSULATION

- c. Pins may be omitted from top surface of horizontal, rectangular ducts and plenums.
 - d. Do not over-compress insulation during installation.
 - e. Cut excess portion of pins extending beyond speed washers or bend parallel with insulation surface. Cover exposed pins and washers with tape matching insulation facing.
4. For ducts and plenums with surface temperatures below ambient, install a continuous unbroken vapor barrier. Create a facing lap for longitudinal seams and end joints with insulation by removing 2 inches (50 mm) from one edge and one end of insulation segment. Secure laps to adjacent insulation section with 1/2-inch (13-mm) outward-clinching staples, 1 inch (25 mm) o.c. Install vapor barrier consisting of factory- or field-applied jacket, adhesive, vapor-barrier mastic, and sealant at joints, seams, and protrusions.
 - a. Repair punctures, tears, and penetrations with tape or mastic to maintain vapor-barrier seal.
 - b. Install vapor stops for ductwork and plenums operating below 50 deg F (10 deg C) at 18-foot (5.5-m) intervals. Vapor stops shall consist of vapor-barrier mastic applied in a Z-shaped pattern over insulation face, along butt end of insulation, and over the surface. Cover insulation face and surface to be insulated a width equal to two times the insulation thickness, but not less than 3 inches (75 mm).
 5. Install insulation on rectangular duct elbows and transitions with a full insulation section for each surface. Groove and score insulation to fit as closely as possible to outside and inside radius of elbows. Install insulation on round and flat-oval duct elbows with individually mitered gores cut to fit the elbow.
 6. Insulate duct stiffeners, hangers, and flanges that protrude beyond insulation surface with 6-inch- (150-mm-) wide strips of same material used to insulate duct. Secure on alternating sides of stiffener, hanger, and flange with pins spaced 6 inches (150 mm) o.c.

3.7 FIELD-APPLIED JACKET INSTALLATION

- A. Where glass-cloth jackets are indicated, install directly over bare insulation or insulation with factory-applied jackets.
 1. Draw jacket smooth and tight to surface with 2-inch (50-mm) overlap at seams and joints.
 2. Embed glass cloth between two 0.062-inch- (1.6-mm-) thick coats of lagging adhesive.
 3. Completely encapsulate insulation with coating, leaving no exposed insulation.
- B. Where FSK jackets are indicated, install as follows:
 1. Draw jacket material smooth and tight.
 2. Install lap or joint strips with same material as jacket.
 3. Secure jacket to insulation with manufacturer's recommended adhesive.

SECTION 230713 - DUCT INSULATION

4. Install jacket with 1-1/2-inch (38-mm) laps at longitudinal seams and 3-inch- (75-mm-) wide joint strips at end joints.
 5. Seal openings, punctures, and breaks in vapor-retarder jackets and exposed insulation with vapor-barrier mastic.
- C. Where PVC jackets are indicated, install with 1-inch (25-mm) overlap at longitudinal seams and end joints; for horizontal applications, install with longitudinal seams along top and bottom of tanks and vessels. Seal with manufacturer's recommended adhesive.
1. Apply two continuous beads of adhesive to seams and joints, one bead under lap and the finish bead along seam and joint edge.
- D. Where metal jackets are indicated, install with 2-inch (50-mm) overlap at longitudinal seams and end joints. Overlap longitudinal seams arranged to shed water. Seal end joints with weatherproof sealant recommended by insulation manufacturer. Secure jacket with stainless-steel bands 12 inches (300 mm) o.c. and at end joints.

3.8 FIRE-RATED INSULATION SYSTEM INSTALLATION

- A. Where fire-rated insulation system is indicated, secure system to ducts and duct hangers and supports to maintain a continuous fire rating.
- B. Insulate duct access panels and doors to achieve same fire rating as duct.
- C. Install firestopping at penetrations through fire-rated assemblies. Fire-stop systems are specified in Section 078413 "Penetration Firestopping."

3.9 FINISHES

- A. Insulation with ASJ, Glass-Cloth, or Other Paintable Jacket Material: Paint jacket with paint system identified below and as specified in Section 099113 "Exterior Painting" and Section 099123 "Interior Painting."
 1. Flat Acrylic Finish: Two finish coats over a primer that is compatible with jacket material and finish coat paint. Add fungicidal agent to render fabric mildew proof.
 - a. Finish Coat Material: Interior, flat, latex-emulsion size.
- B. Flexible Elastomeric Thermal Insulation: After adhesive has fully cured, apply two coats of insulation manufacturer's recommended protective coating.
- C. Color: Final color as selected by Architect. Vary first and second coats to allow visual inspection of the completed Work.
- D. Do not field paint aluminum or stainless-steel jackets.

SECTION 230713 - DUCT INSULATION

3.10 FIELD QUALITY CONTROL

- A. Perform tests and inspections.
- B. Tests and Inspections:
 - 1. Inspect ductwork, randomly selected by Engineer, by removing field-applied jacket and insulation in layers in reverse order of their installation. Extent of inspection shall be limited to one location(s) for each duct system defined in the "Duct Insulation Schedule, General" Article.
- C. All insulation applications will be considered defective Work if sample inspection reveals noncompliance with requirements.

3.11 DUCT INSULATION SCHEDULE, GENERAL

- A. Plenums and Ducts Requiring Insulation:
 - 1. Indoor, supply, return, and transfer air.
- B. Items Not Insulated:
 - 1. Metal ducts with duct liner of sufficient thickness to comply with energy code and ASHRAE/IESNA 90.1.
 - 2. Factory-insulated flexible ducts.
 - 3. Flexible connectors.
 - 4. Vibration-control devices.
 - 5. Factory-insulated access panels and doors.

3.12 INDOOR DUCT AND PLENUM INSULATION SCHEDULE


- A. Concealed, round, supply-air duct insulation shall be the following:
 - 1. Mineral-Fiber Blanket Wrap: 1-1/2 inches thick and 0.75-lb/cu. ft. nominal density.
- B. Concealed, rectangular, return-air duct insulation shall be the following:
 - 1. Liner: Glass-Fiber Board: 1-1/2 inches thick and 2 lb/cu. ft.

END OF SECTION 230713

CODE PLAN LEGEND

STUDIO LP

331 S RIO GRANDE ST
SUITE 307
SLC, UT 84101
PH: 8017395569
BAYLEE@STUDIOARCH.COM

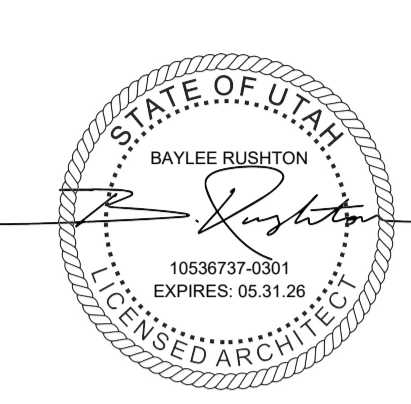

- NO. OF OCCUPANTS
- TOTAL NO. OF OCCUPANTS AT EXIT
- STAIR: XX OCC, X-X" R, X-X" P: LOCATION (EXIT WIDTH FACTOR), OCCUPANT NUMBER, REQUIRED STAIR WIDTH, PROVIDED STAIR WIDTH
- EXITING PATH OF TRAVEL
- ACCESSIBLE TRAVEL PATH
- FREIGHT ELEVATOR ACCESS
- FEC FIRE EXTINGUISHER (EXISTING)
- 2 HR. RATED WALL

OCC LOAD/FUNCTION

- BUSINESS
- ASSEMBLY (UNCONCENTRATED)
- ACCESSORY STORAGE, EQUIP ROOM
- CIRCULATION
- NOT IN SCOPE
- OCCUPANCY IS TYPE 8 UNLESS NOTED OTHERWISE

GENERAL NOTES

1. BUILDING IS OCCUPIED DURING CONSTRUCTION. IT IS CONTRACTOR'S RESPONSIBILITY TO PROVIDE A SAFE CONSTRUCTION BARRIER AND EXIT THROUGH THE BUILDING AS NEEDED.
2. STAGING AREA IS ADJACENT TO OWNER FURNITURE STORAGE AREA. FURNITURE TO BE PROTECTED DURING CONSTRUCTION.

GENETIC SCIENCE
LEARNING CENTER

CONSTRUCTION DOCUMENTS

DFCM SEAL

No.	Description	Date
1	ADDENDUM 1	12/20/2024




GLSC
296 CHIPETA WAY
SALT LAKE CITY, UT 84108


22812
10.30.2024

CODE PLANS


G102
Scale As indicated

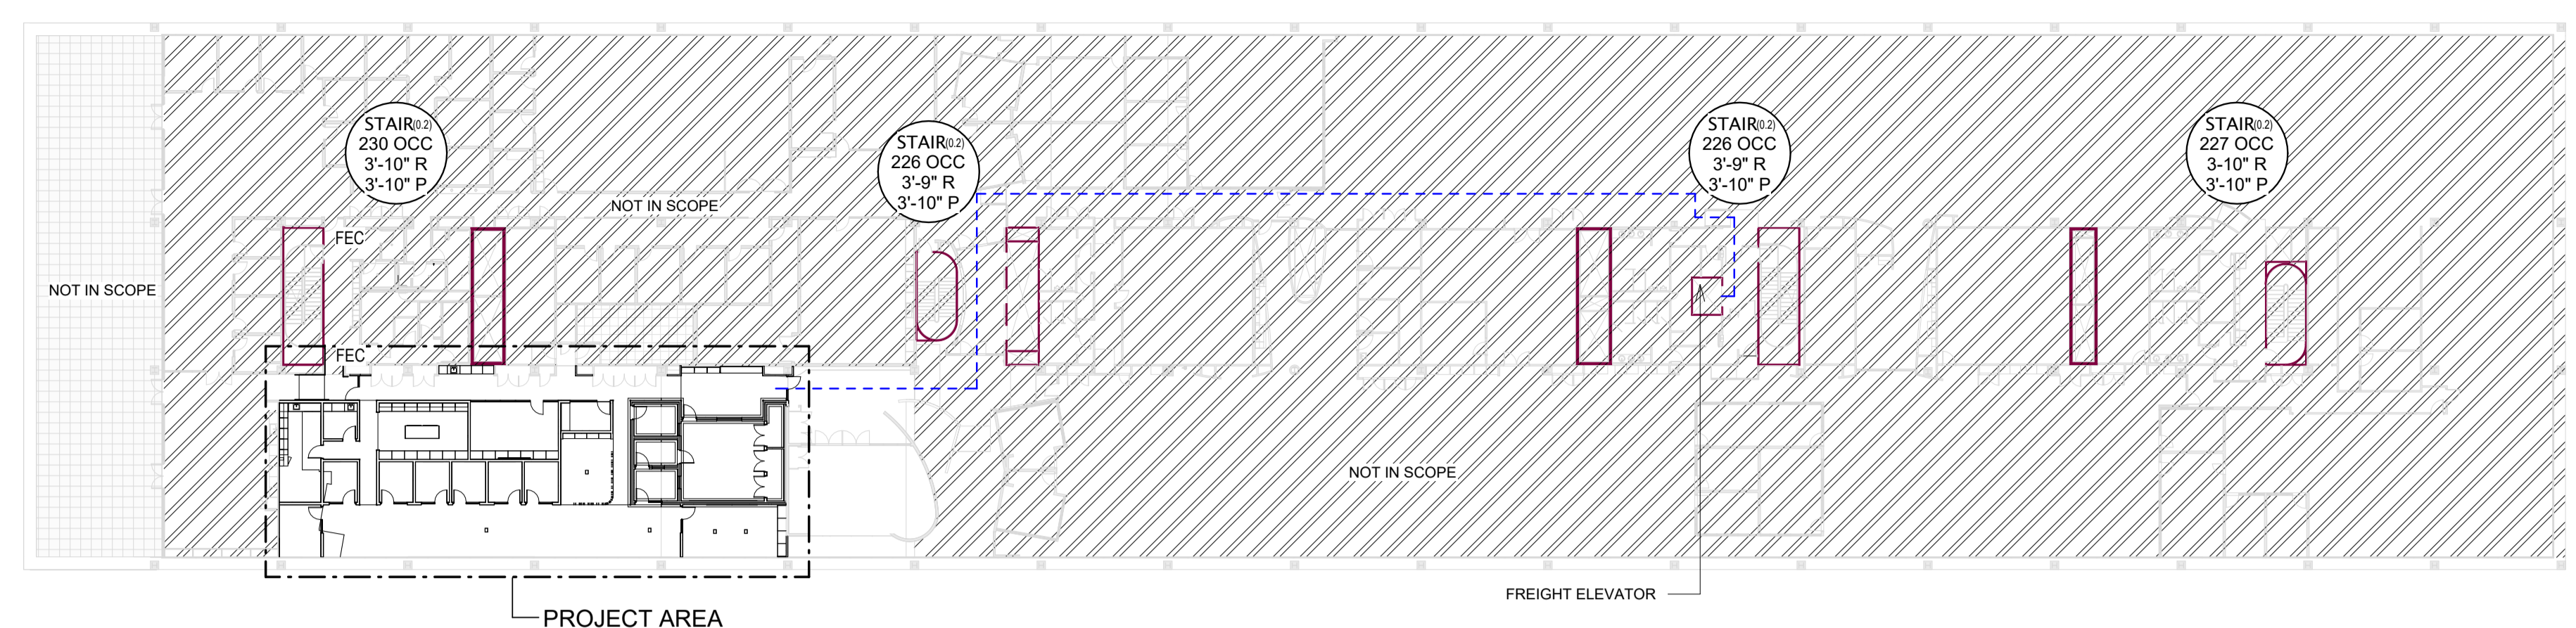


5 LEVEL 4 CODE PLAN
G102 1/32" = 1'-0"

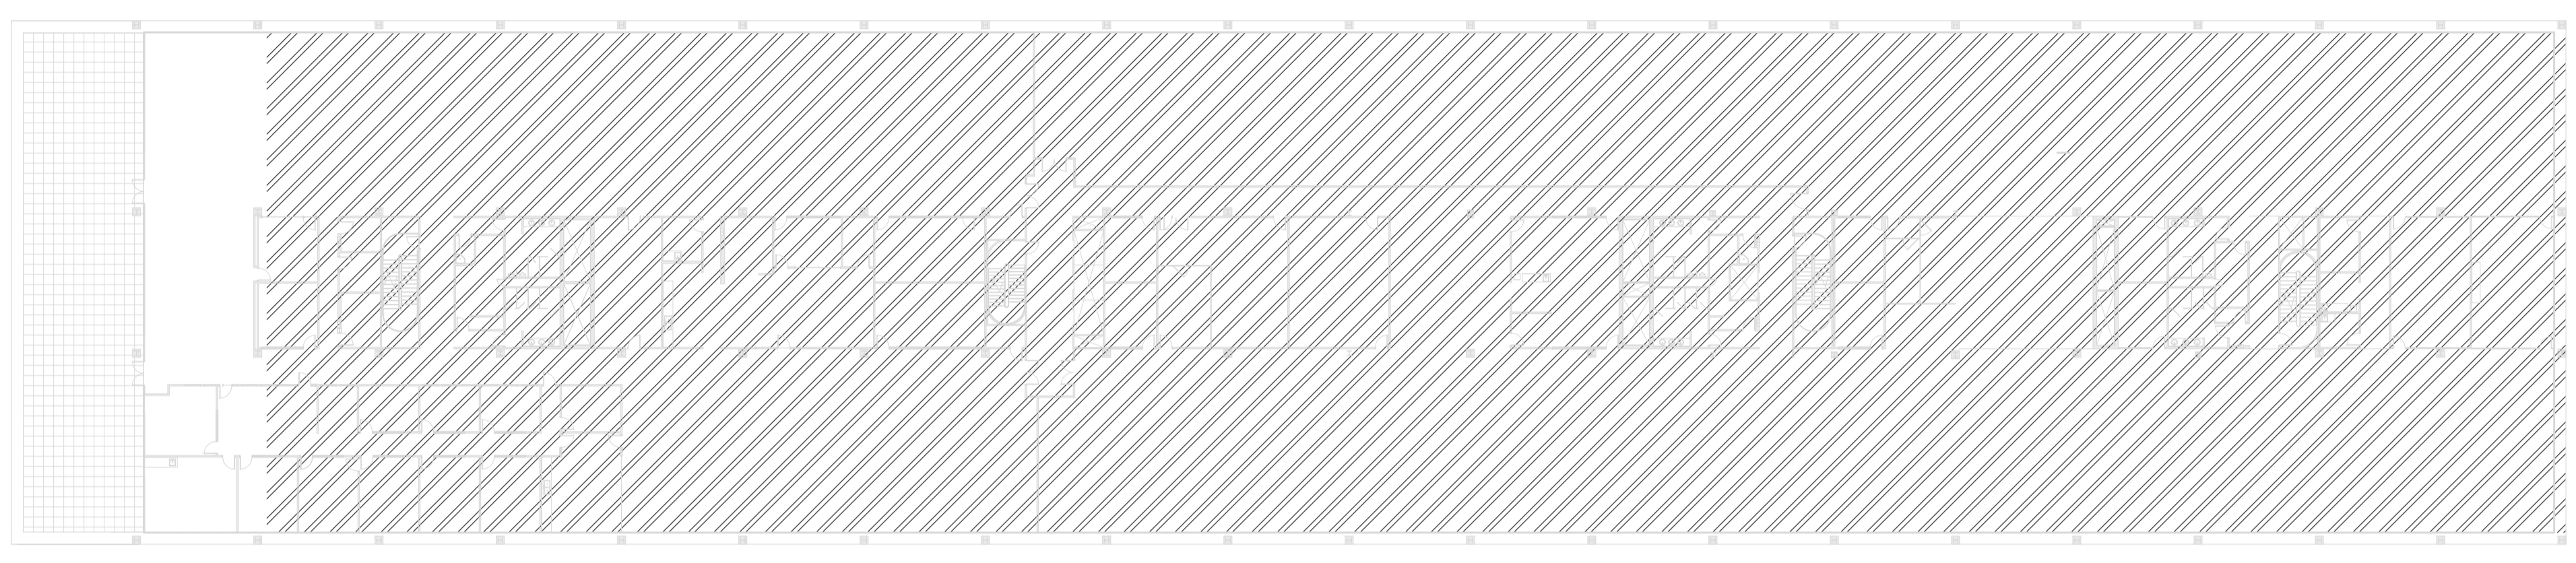


4 LEVEL 3 CODE PLAN - FOR REFERENCE ONLY
G102 1/32" = 1'-0"

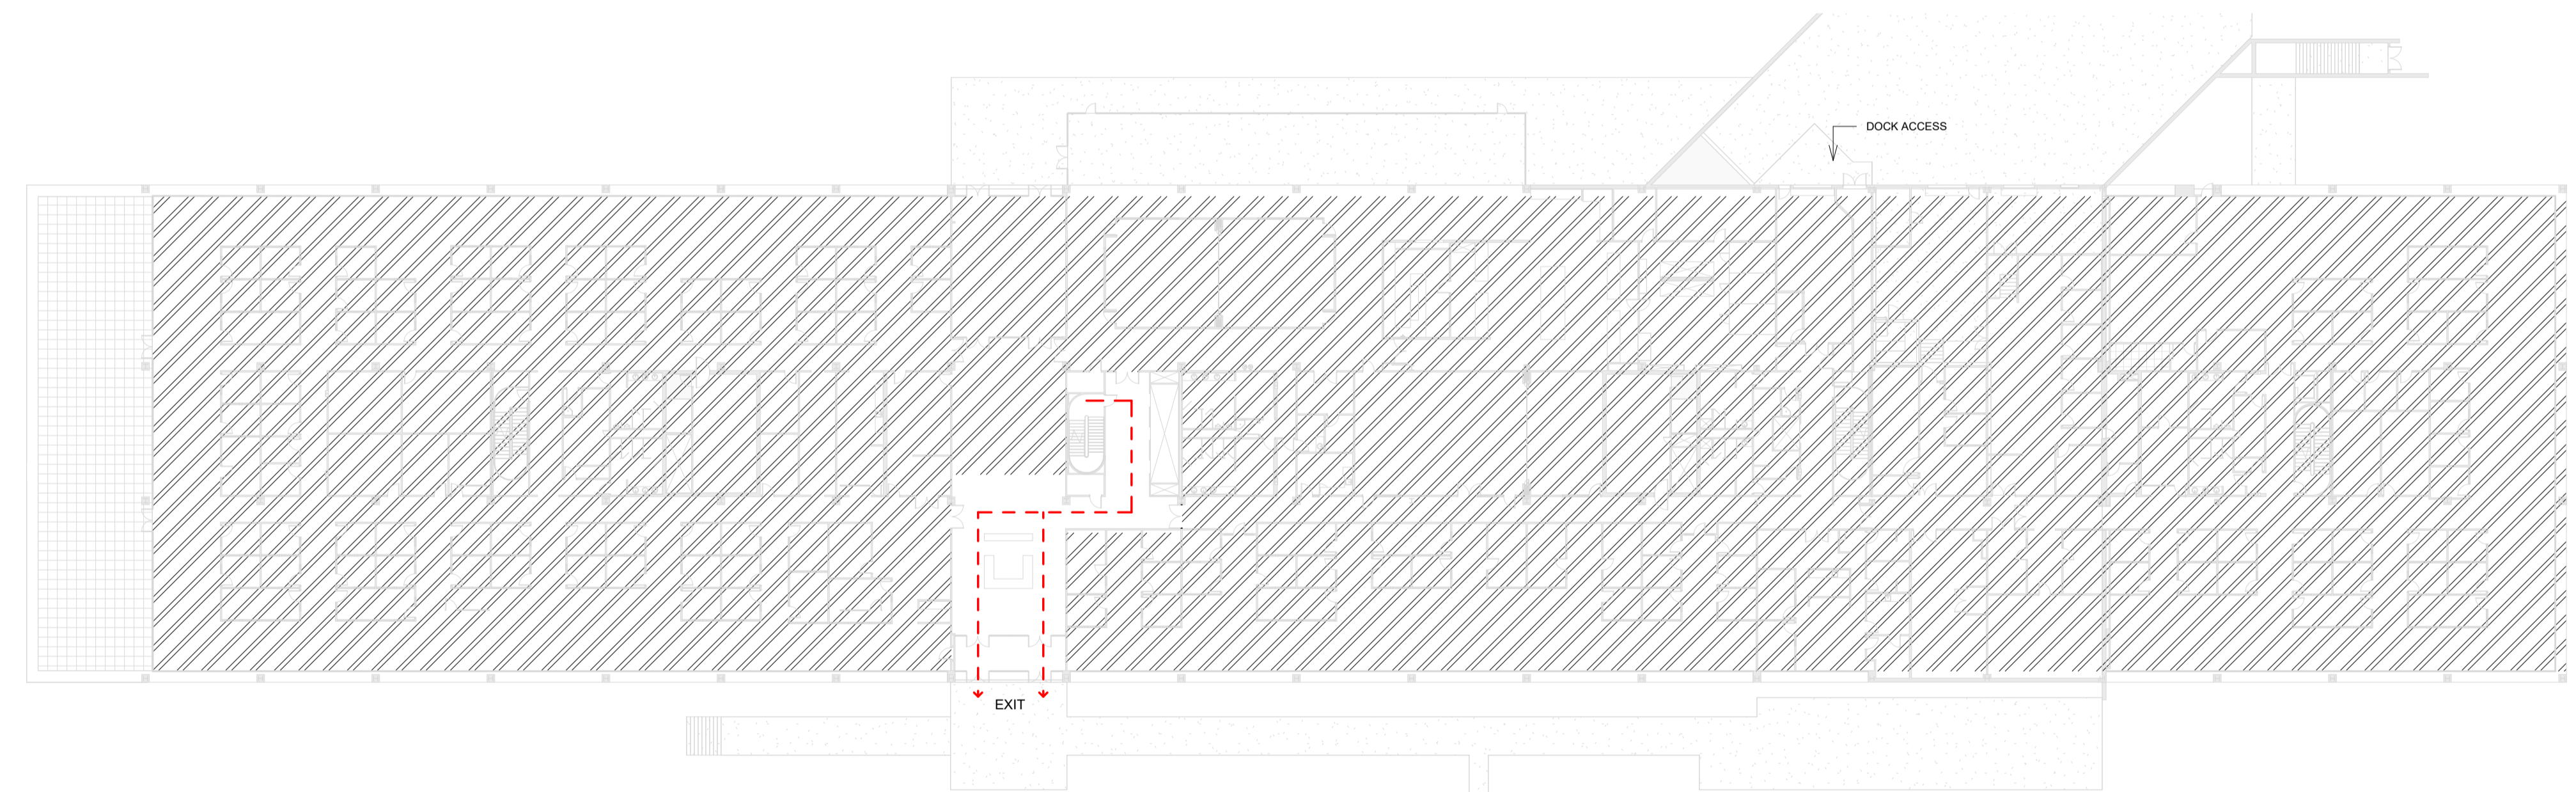


3 LEVEL 2 CODE PLAN - FOR REFERENCE ONLY
G102 1/32" = 1'-0"

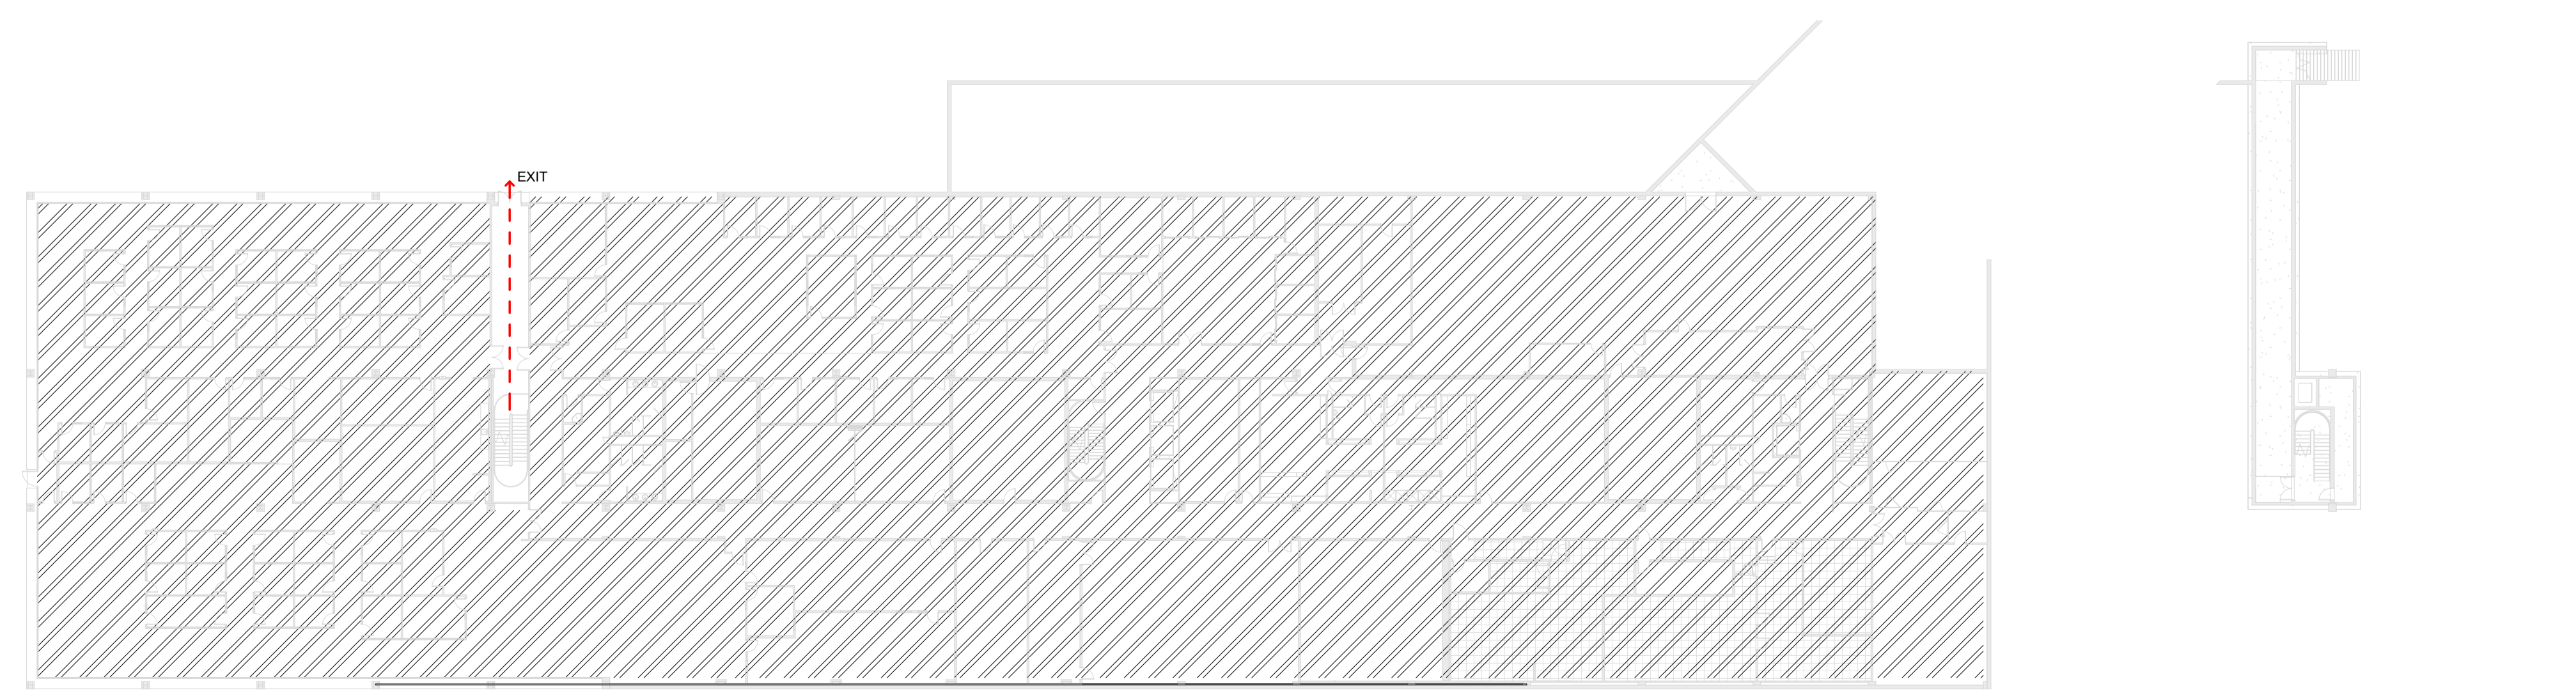

2 LEVEL 1 CODE PLAN - FOR REFERENCE ONLY
G102 1/32" = 1'-0"

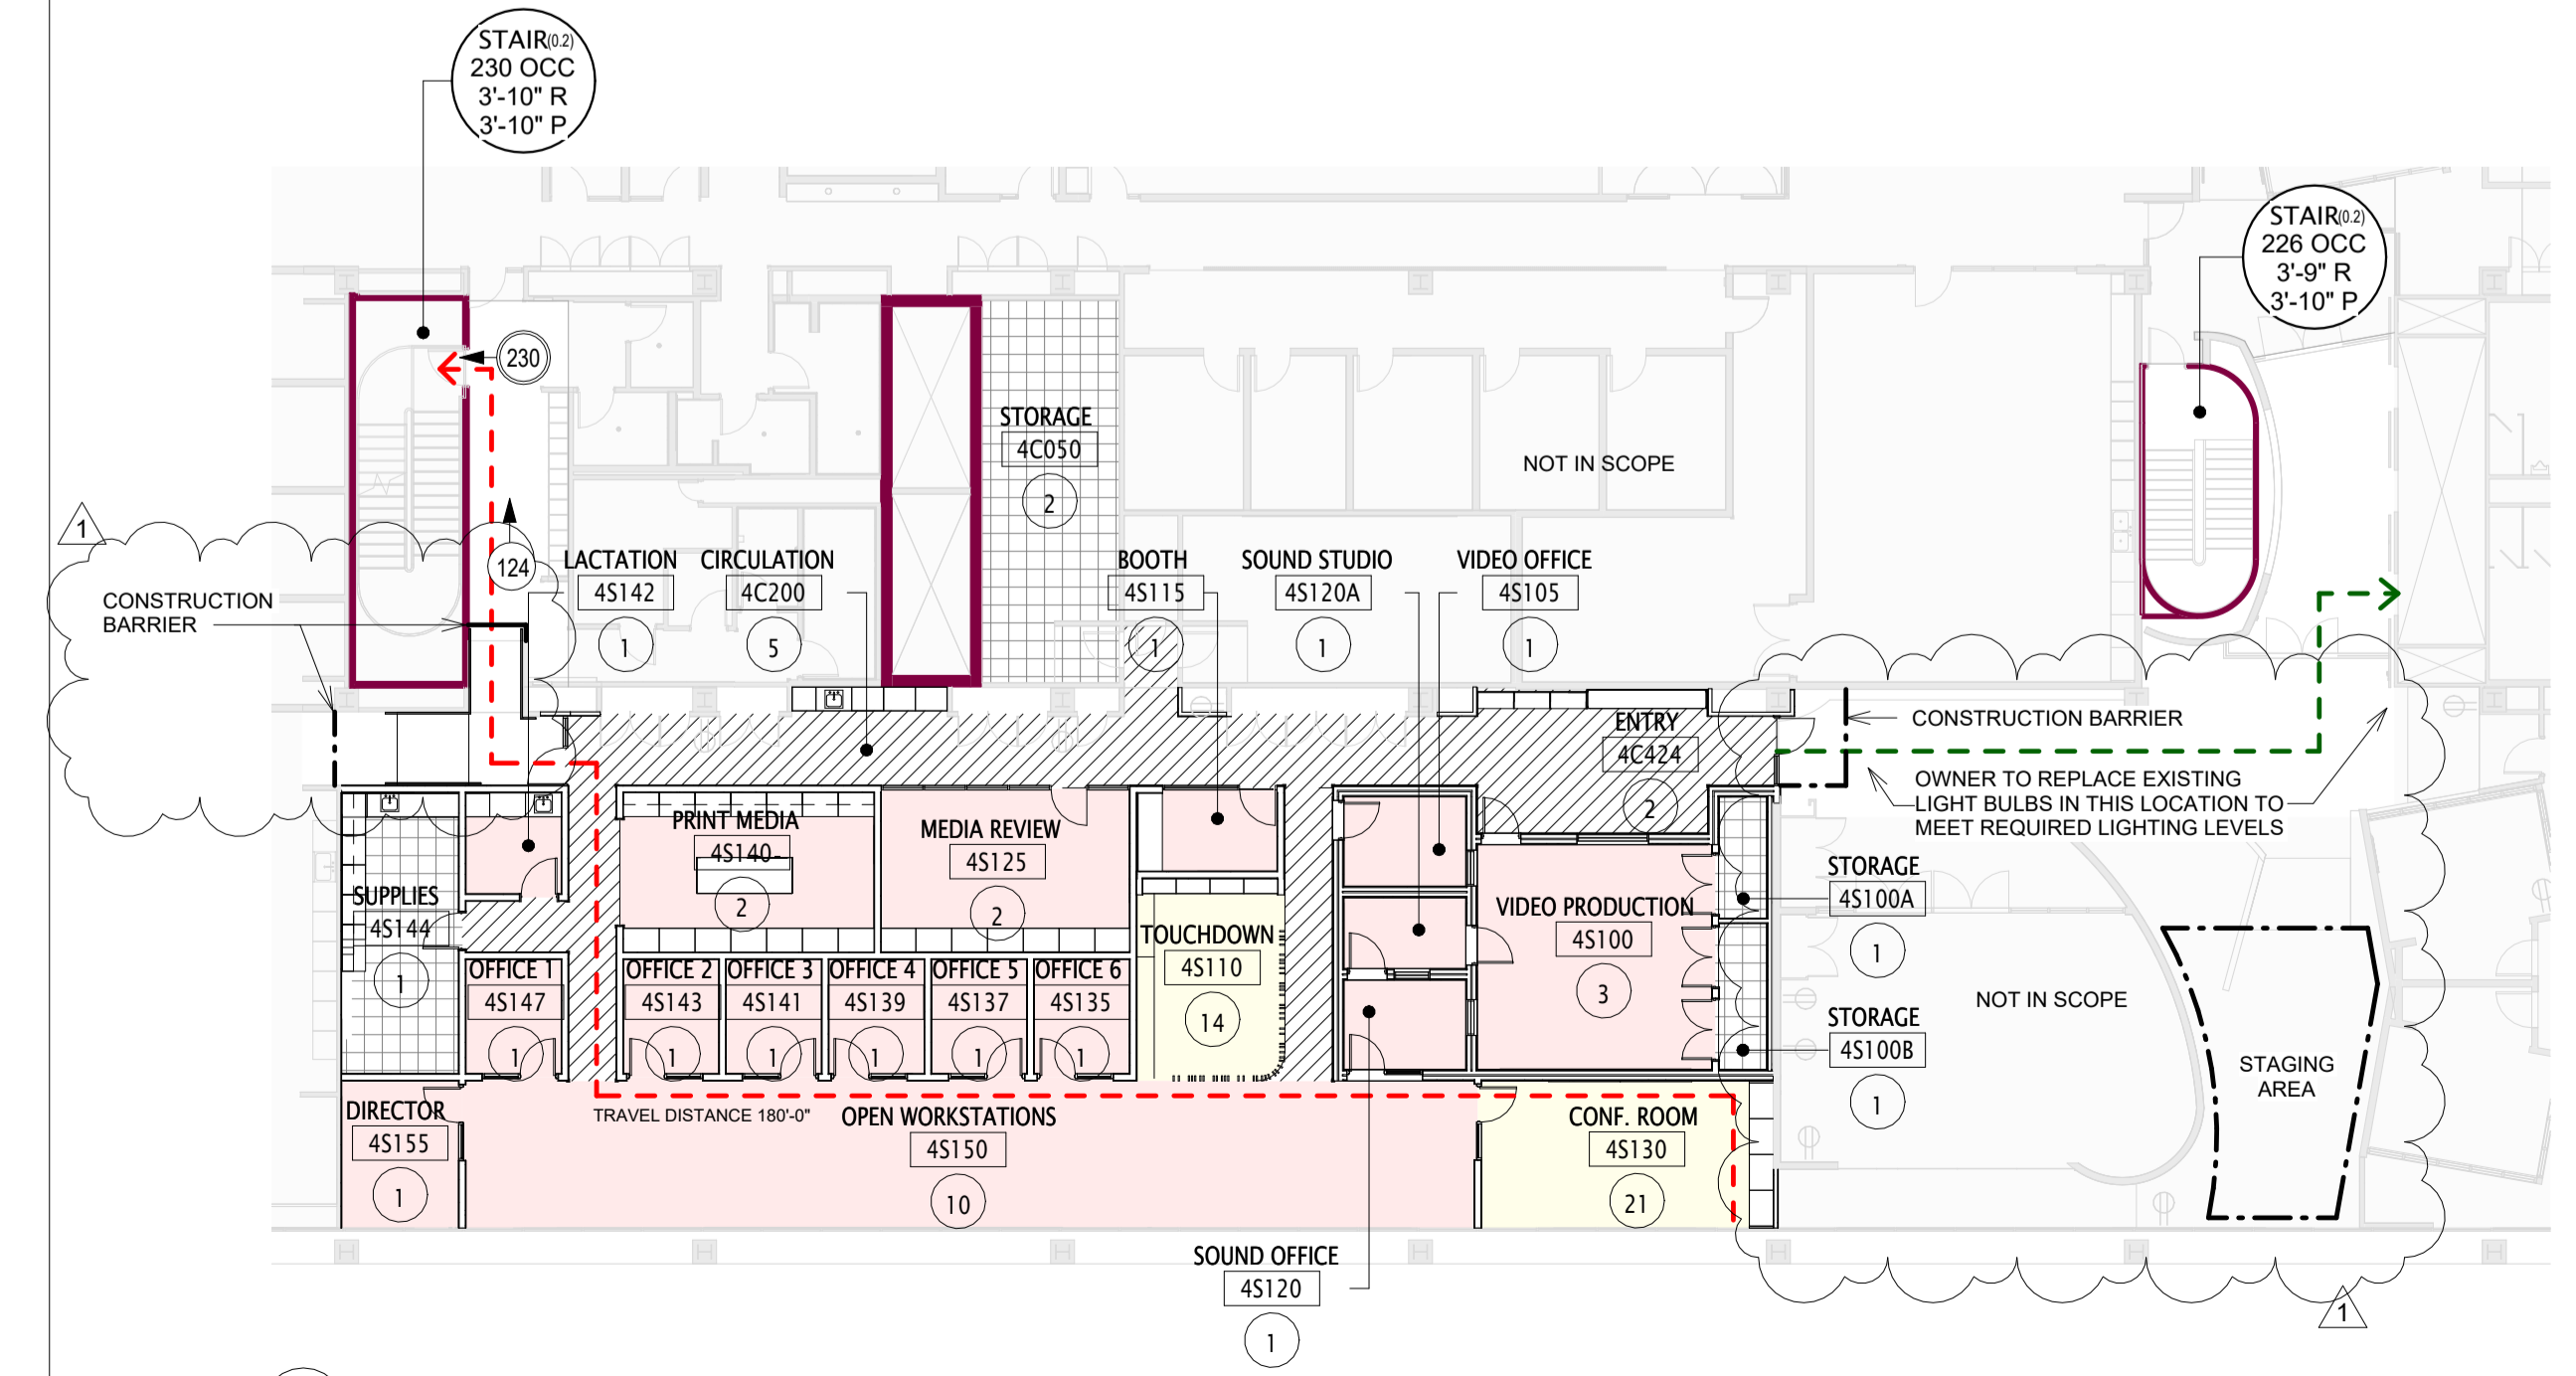

1 LEVEL 4 OCCUPANCY CODE PLAN
G102 1/16" = 1'-0"

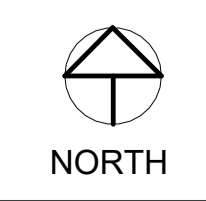



COMM RM CIRCULATION



BEHIND BREAKROOM



ENTRANCE HALLWAY, FACING EAST



EXISTING OFFICES, FACING EAST



HALLWAY FROM BREAK ROOM, FACING EAST



STORAGE AND BAR, FACING NORTH




GLASS OFFICE, FACING WEST




EXISTING OFFICES, FACING WEST



OPEN SPACE WINDOWS, FACING SOUTH

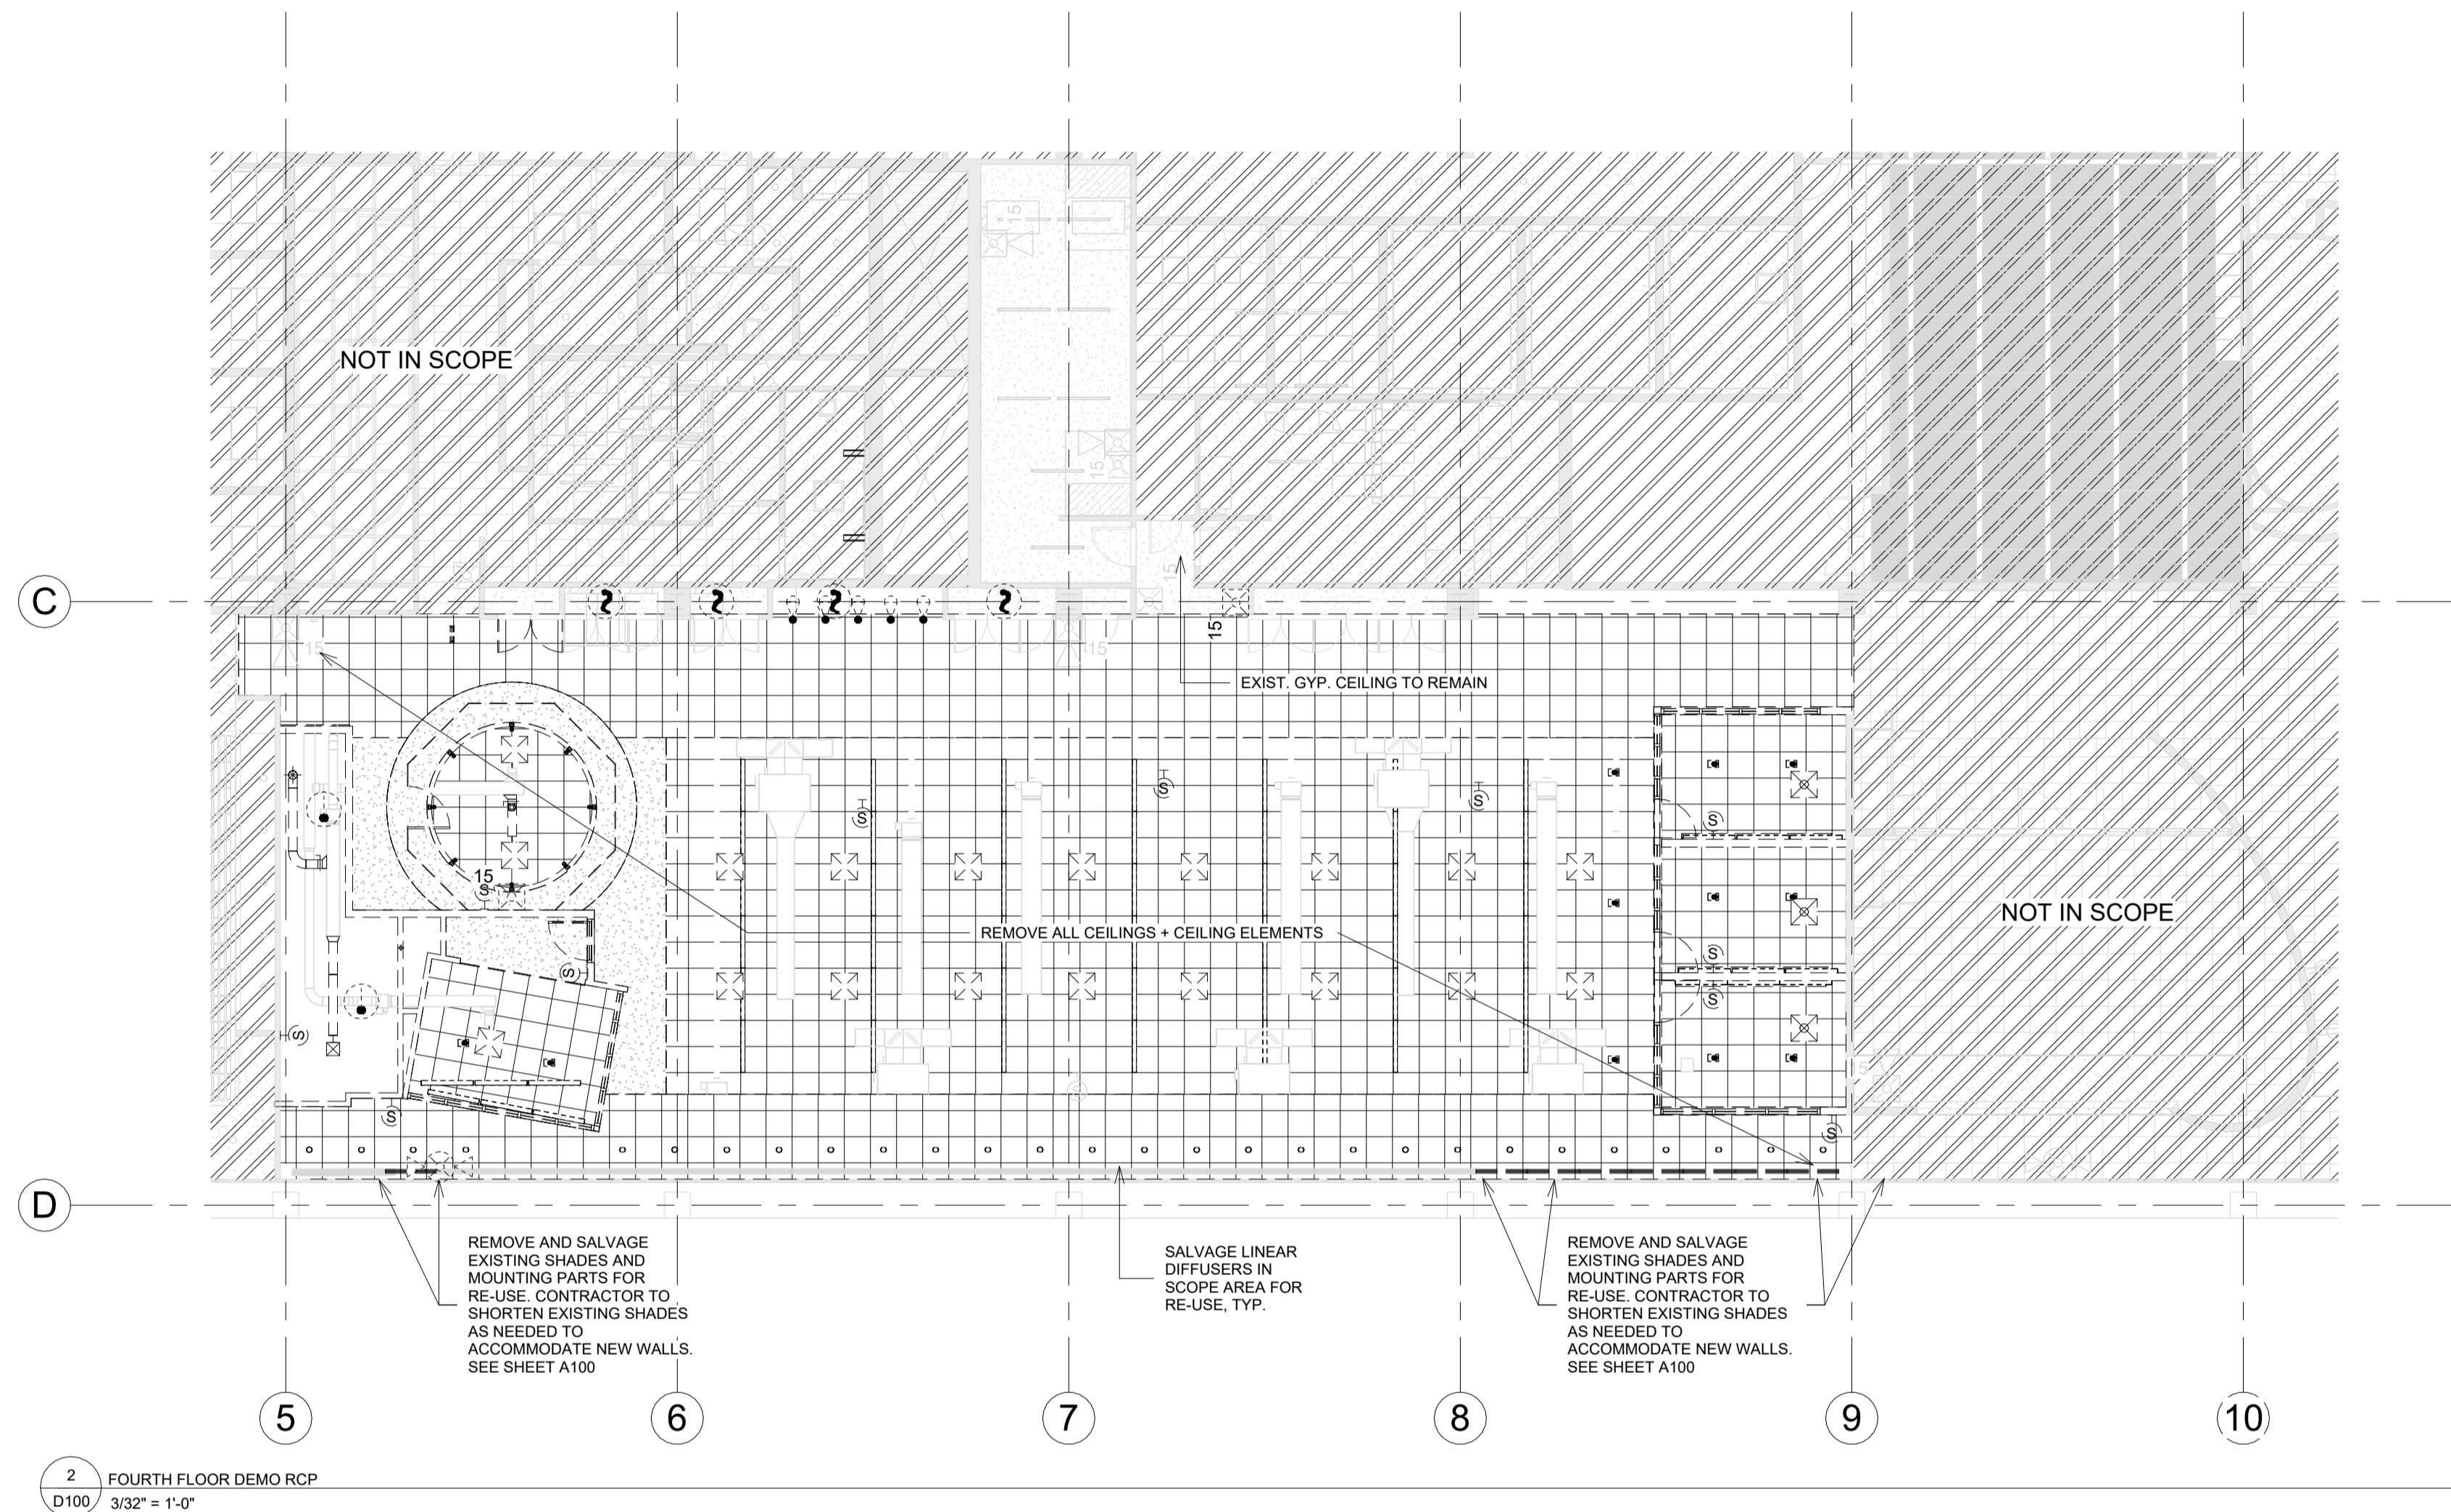

2 FOURTH FLOOR DEMO RCP
D100/ 3/32" = 1'-0"

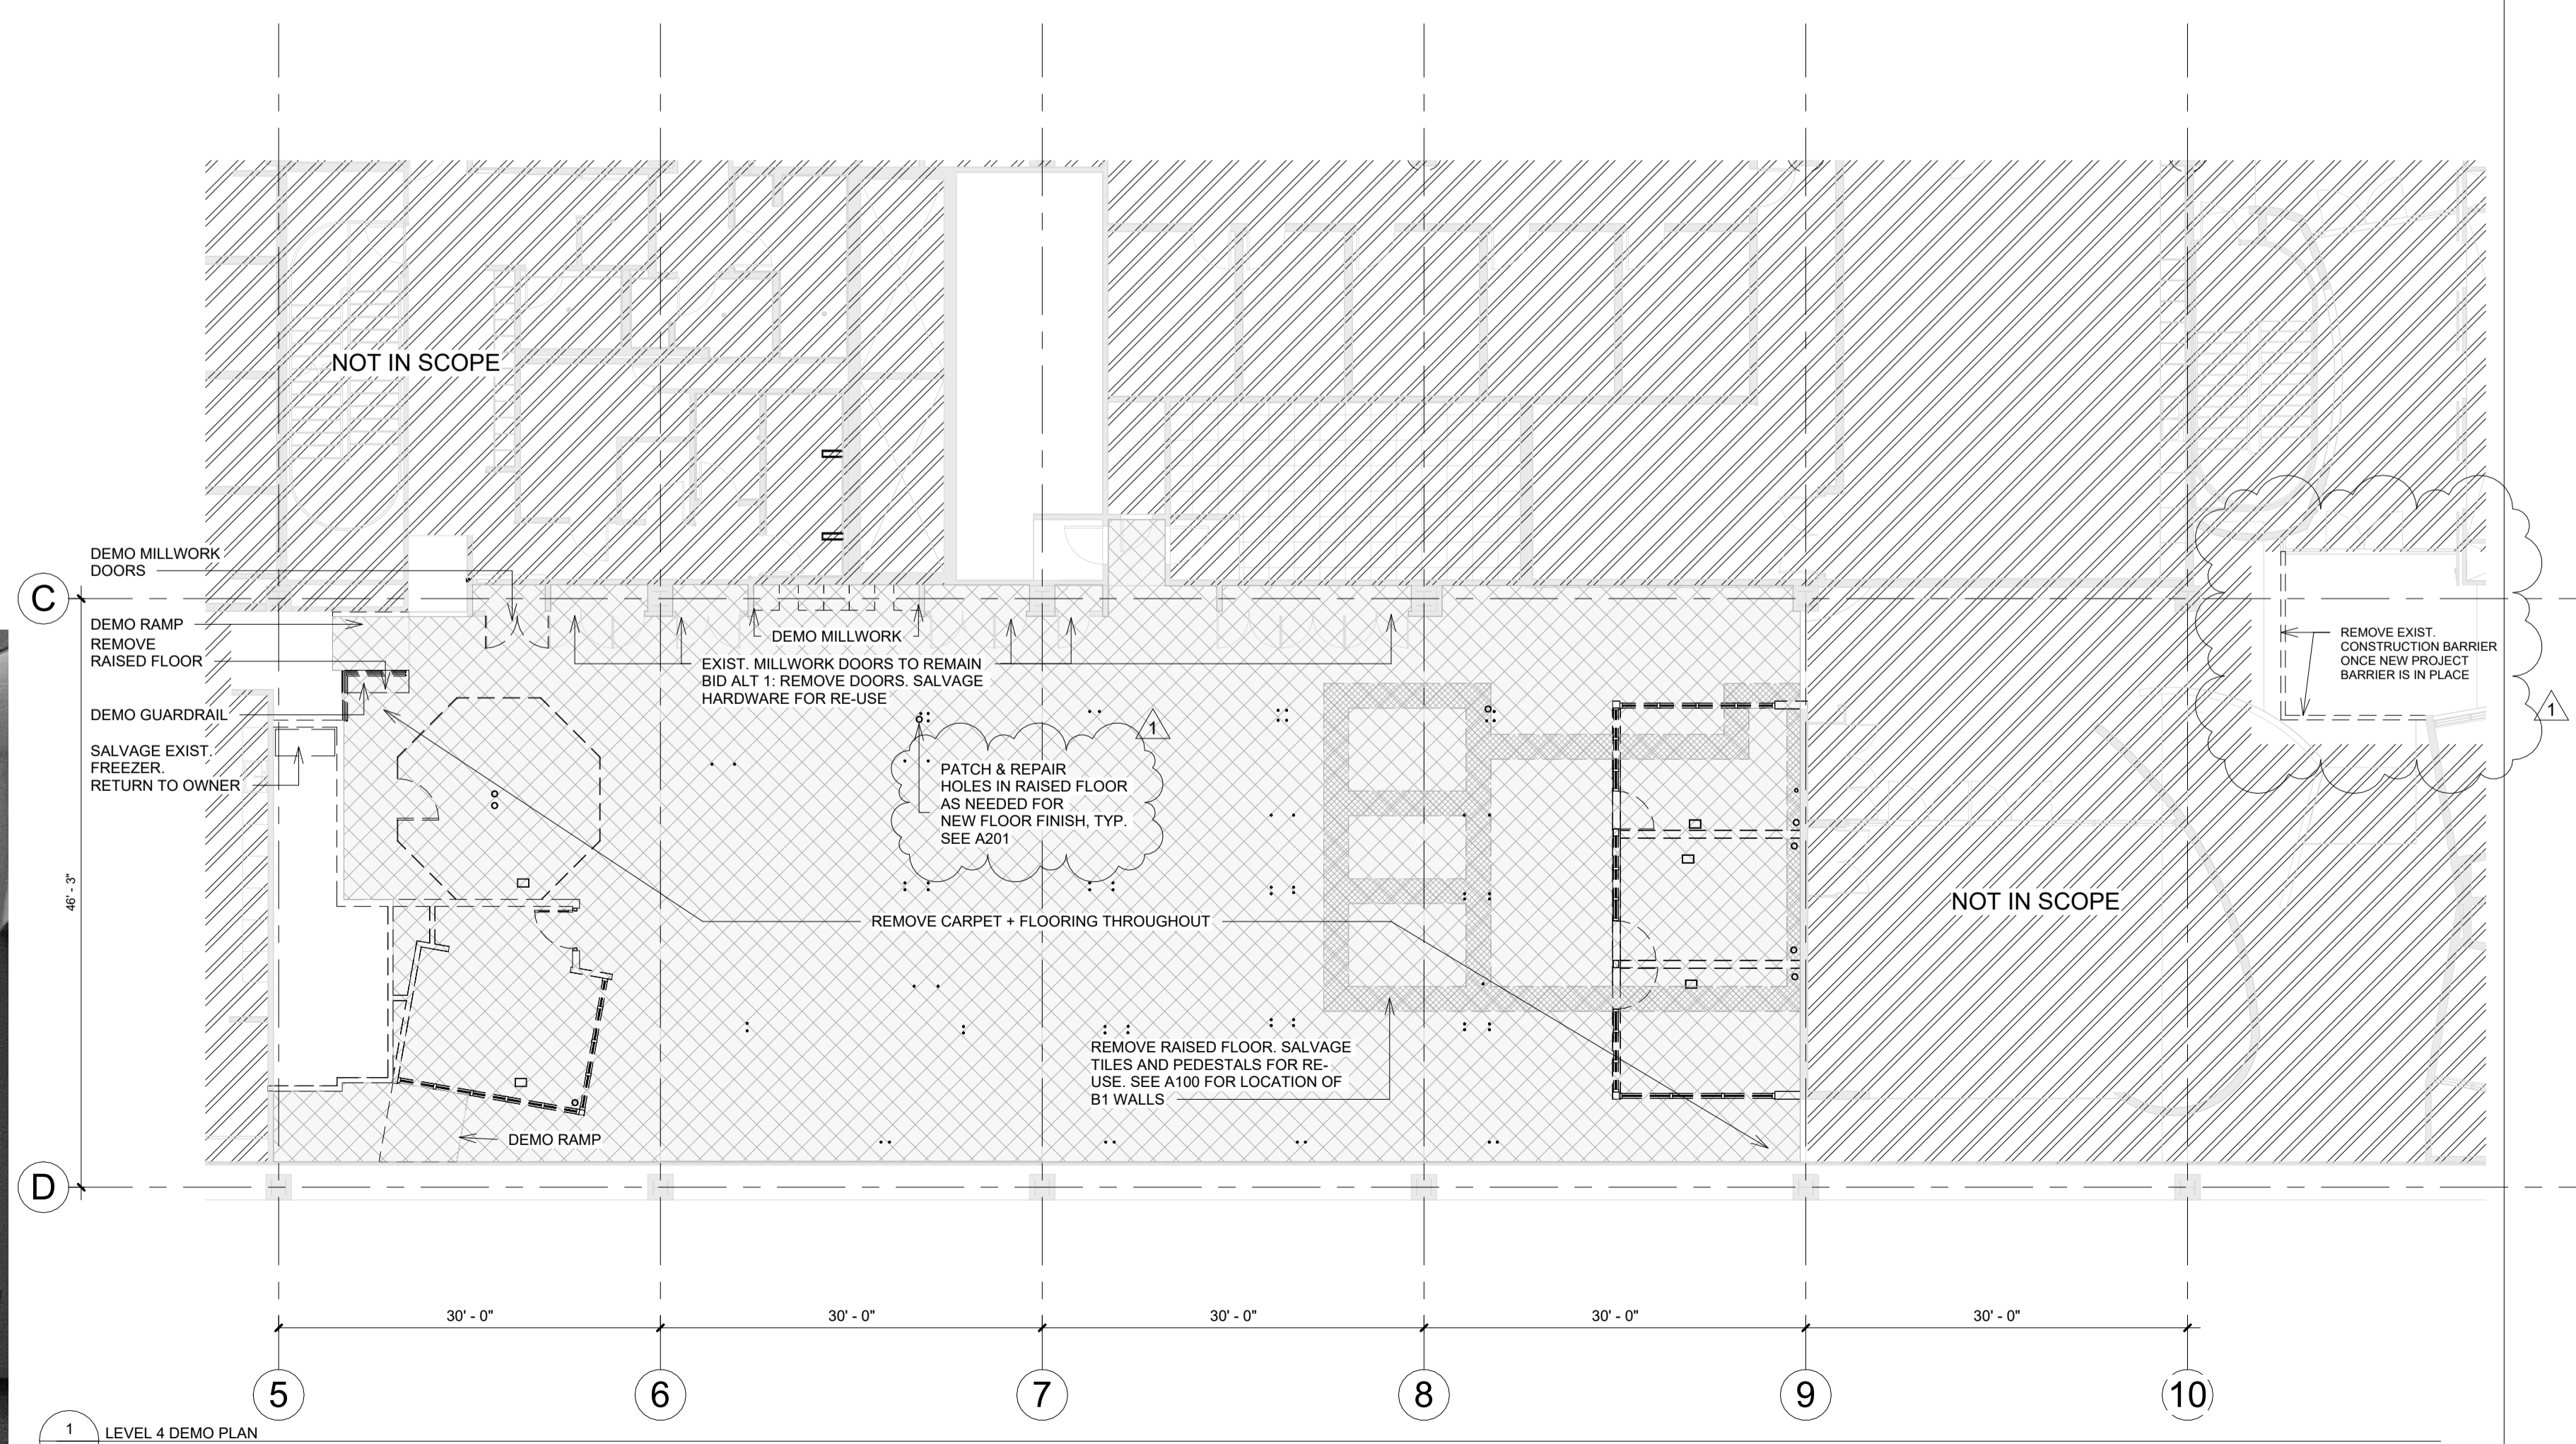


1 LEVEL 4 DEMO PLAN
D100/ 3/32" = 1'-0"

DEMOLITION LEGEND

- TO BE REMOVED
- DOOR & FRAME TO BE REMOVED
- EXISTING TO REMAIN
- ACCESS FLOOR TO BE REMOVED
- CARPET TILE TO BE REMOVED
- NOT IN SCOPE

DEMOLITION NOTES

1. PROTECT EXISTING WALLS AND FLOORING THAT WILL REMAIN.
2. FIRE SPRINKLER PIPE TO REMAIN.
3. PATCH AND REPAIR EXISTING CONDITIONS DAMAGED DURING CONSTRUCTION.
4. BUILDING IS OCCUPIED DURING CONSTRUCTION. IT IS CONTRACTOR'S RESPONSIBILITY TO PROVIDE A SAFE CONSTRUCTION BARRIER AND EXIT THROUGH BUILDING AS NEEDED.
5. ALL EXISTING BUILDING PRIMARY STRUCTURE TO REMAIN.
6. PROTECT SHADES AND HULL CORNERS. COORDINATE REPLACEMENT OF DAMAGED SHADES WITH OWNER.
7. ALL CONDUIT, PIPES, AND MECHANICAL ELEMENTS THAT ARE NO LONGER IN USE TO BE REMOVED. TRACE + TRACK ALL ELEMENTS PRIOR TO REMOVAL TO VERIFY THAT THEY AREN'T BEING USED BY OTHER ROOMS/AREAS.
8. BUILDING IS OCCUPIED DURING CONSTRUCTION. IT IS CONTRACTOR'S RESPONSIBILITY TO PROVIDE A SAFE CONSTRUCTION BARRIER AND EXIT THROUGH THE BUILDING AS NEEDED.

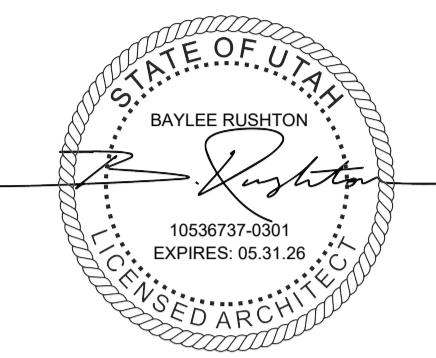

GENETIC SCIENCE
LEARNING CENTER

CONSTRUCTION DOCUMENTS

DFCM SEAL

No	Description	Date
1	ADDENDUM 1	12/20/2024



GS LC
296 CHIPETA WAY
SALT LAKE CITY, UT 84108


22812
10.30.2024

DEMOLITION
PLANS

D100
Scale As indicated



BASE BID / BID ALTERNATE 1

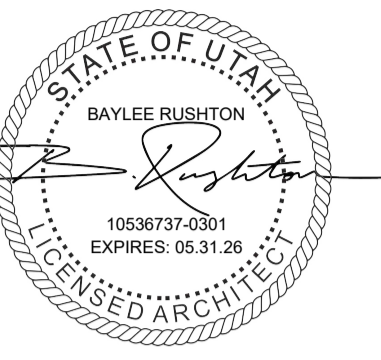

GENETIC SCIENCE LEARNING CENTER

CONSTRUCTION DOCUMENTS

DFCM SEAL

No.	Description	Date
1	ADDENDUM 1	12/20/2024



GS LC
295 CHIPETA WAY
SALT LAKE CITY, UT 84108

22812
10.30.2024

PLAN + RCP

A100
Scale As indicated

PLAN LEGEND

- EXISTING TO REMAIN
- NOT IN SCOPE
- APPROX. AREA OF NEW RAISED FLOOR TO MATCH EXISTING
- PATCH RAISED FLOOR AT NEW FLOOR TO DECK WALLS
- FB - FLOOR BOX
- CG - CORNER GUARD

PLAN NOTES

- ARCHITECTURAL NOTES:
- VERIFY ALL EXISTING CONDITIONS PRIOR TO COMMENCING WORK.
 - CONTRACTOR TO BECOME FAMILIAR WITH ALL DRAWINGS + EXISTING CONDITIONS. BRING DISCREPANCIES TO ARCHITECT IN A TIMELY FASHION PRIOR TO PROCEEDING WITH WORK.
 - PROVIDE TEMPORARY DUST PROTECTION @ ALL AREAS OF CONSTRUCTION.
 - PROTECT SHADES AND ROLL CURBS. COORDINATE REPLACEMENT OF DAMAGED SHADES WITH OWNER.















CEILING LEGEND


- GYPSUM BOARD CEILING
- AP1MS1 - 2' x 2' ACOUSTIC CEILING
- AP2MS1 - 2' x 4' ACOUSTIC CEILING
- AP3 / MS1 - 2' x 2' HIGH CAC ACOUSTIC CEILING
- AF1MS2 - 2X2 FELT CEILING IN T-GRID
- 2X2 LIGHT FIXTURE
- ACCESS PANEL
- 2X4 LIGHT FIXTURE
- 1X4 LIGHT FIXTURE
- LINEAR LIGHT FIXTURE
- RECESSED CAN LIGHT FIXTURE
- FELT - F2 - COLOR: PINK
- FELT - F4 - COLOR: ORANGE

CEILING NOTES

- ARCHITECTURAL:
- FIELD VERIFY ALL CONDITIONS PRIOR TO COMMENCING WORK
 - ALL CEILING HEIGHTS MEASURED FROM FINISHED FLOOR
- MECHANICAL NOTES:
- ALIGN ALL DIFFUSERS AS SHOWN
 - REFER TO MECH. DRAWINGS
- ELECTRICAL:
- ALIGN ALL LIGHT FIXTURES AND CEILING ELEMENTS AS SHOWN
 - REFER TO ELEC. DRAWINGS

WALL TYPES

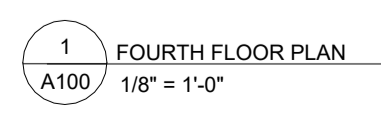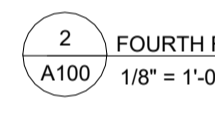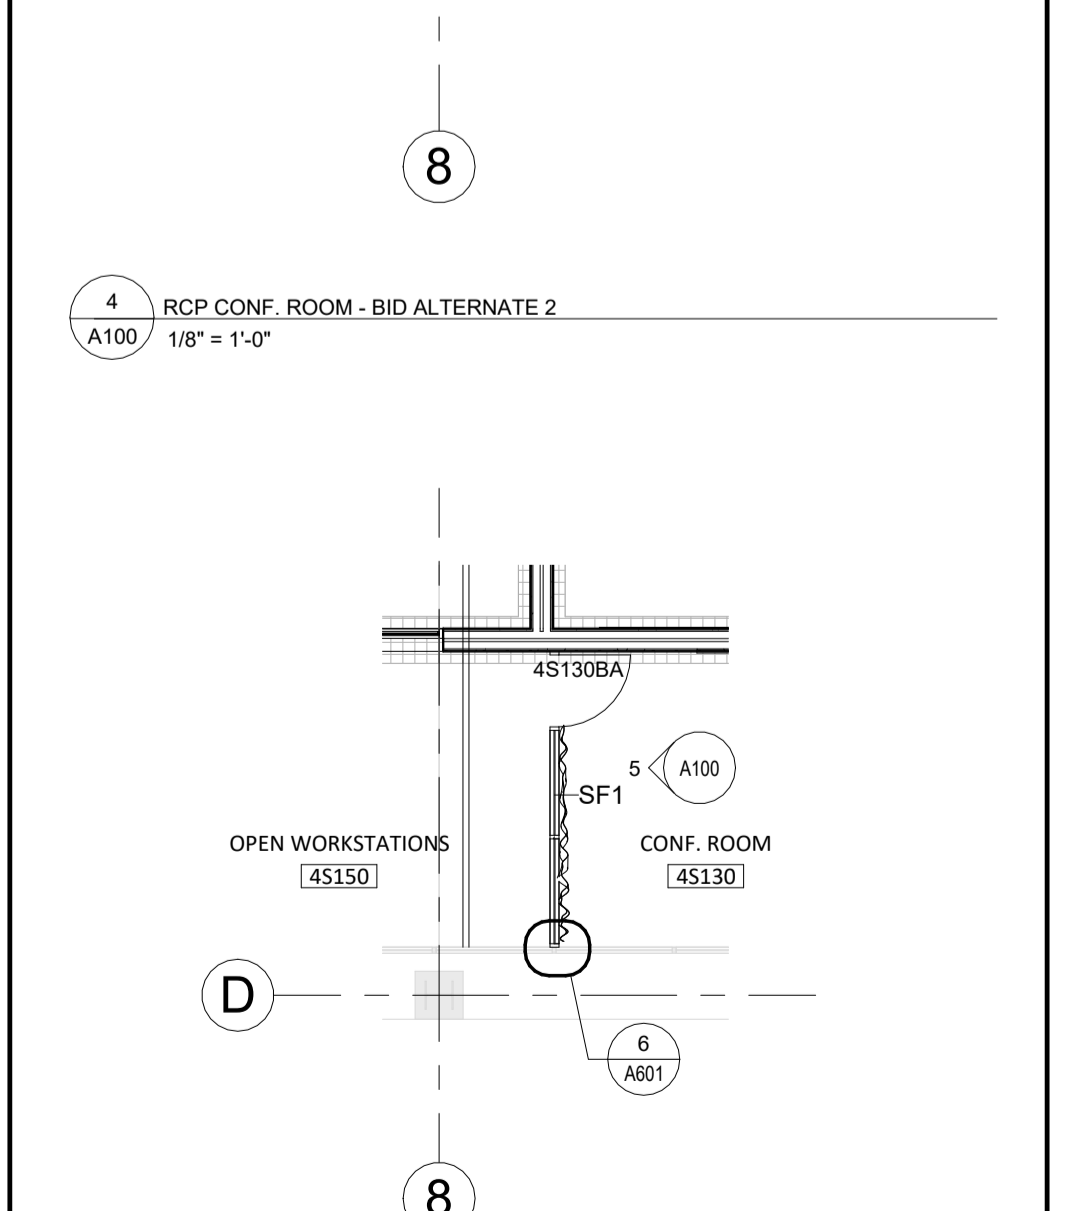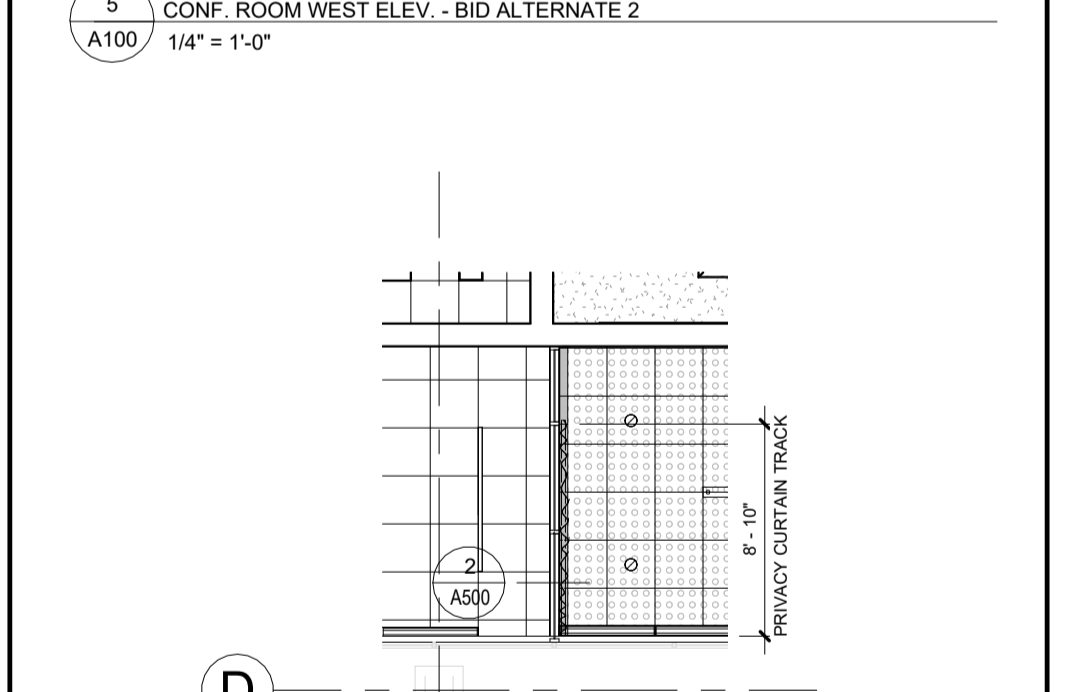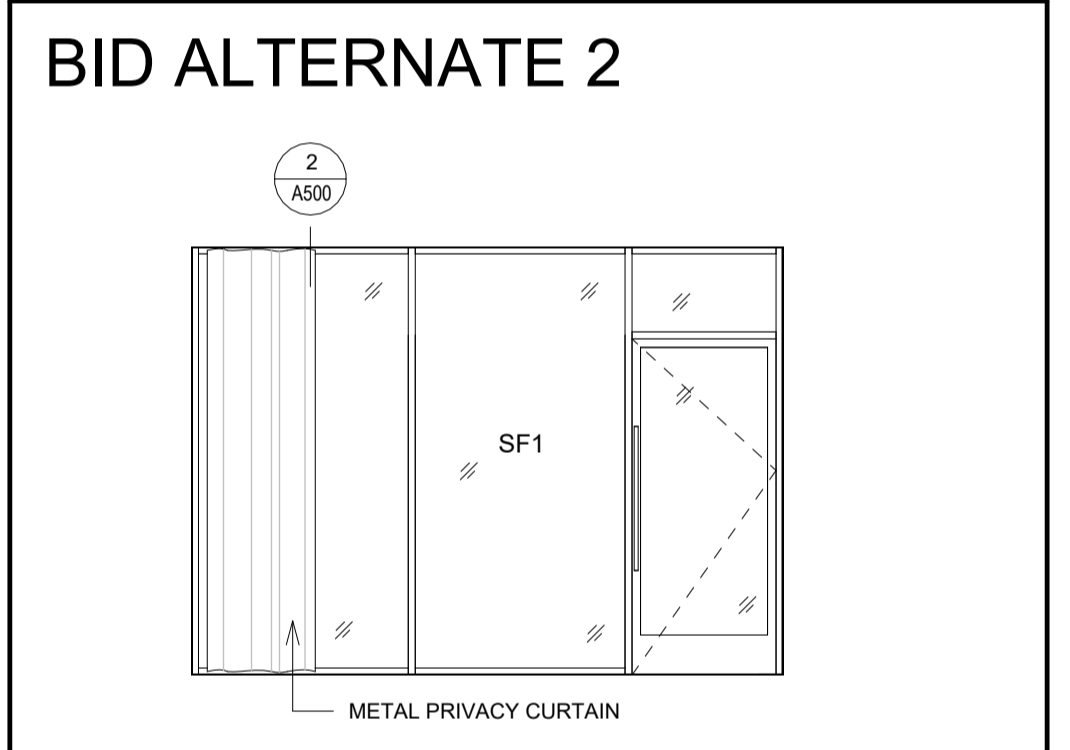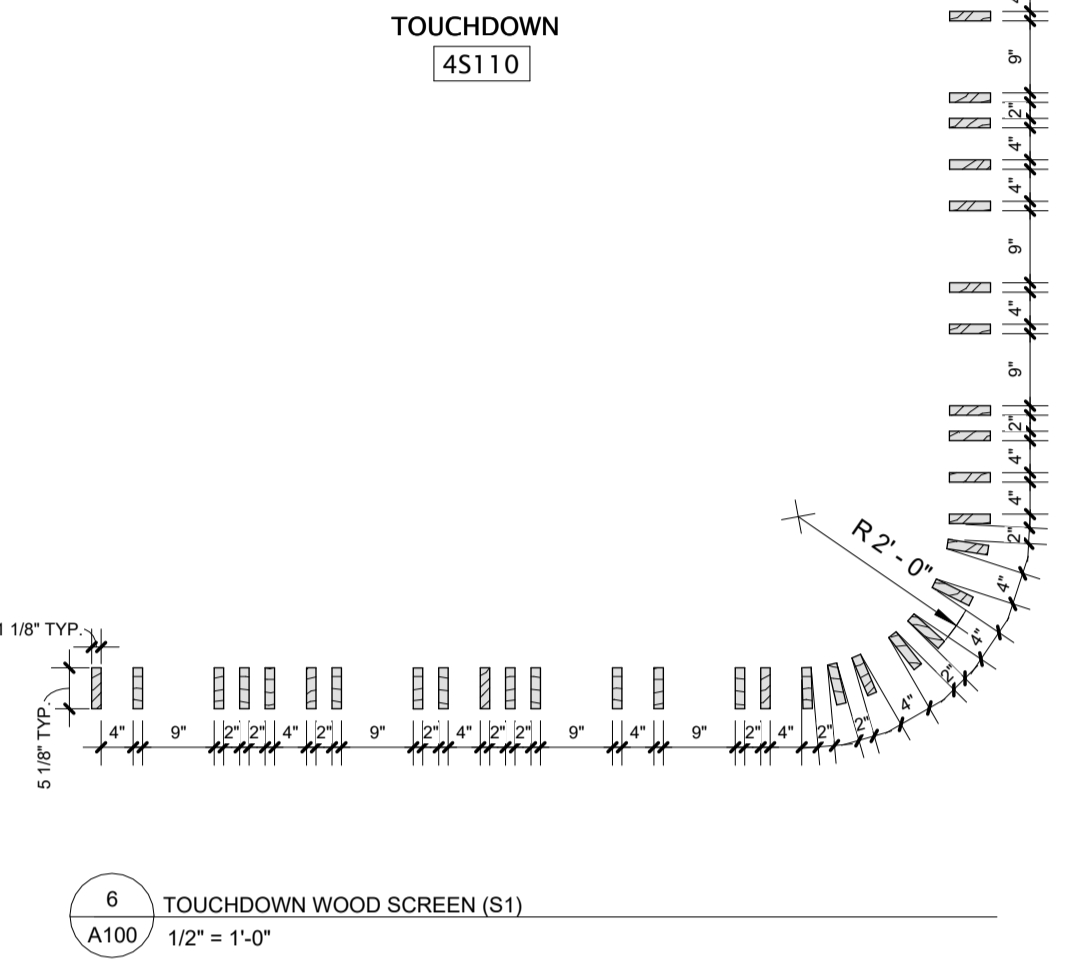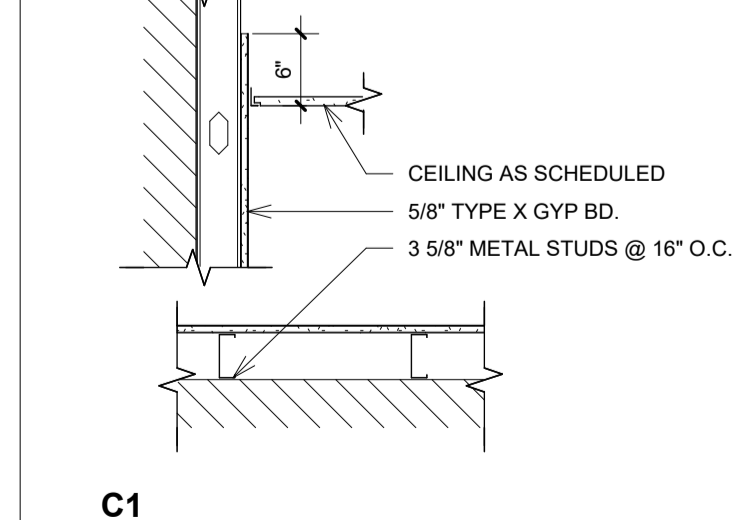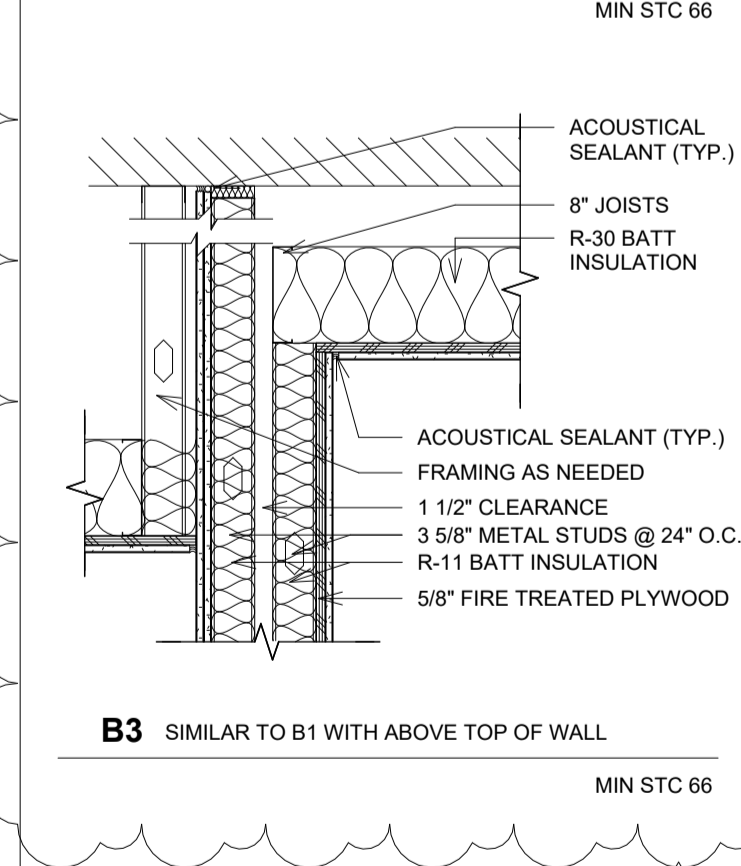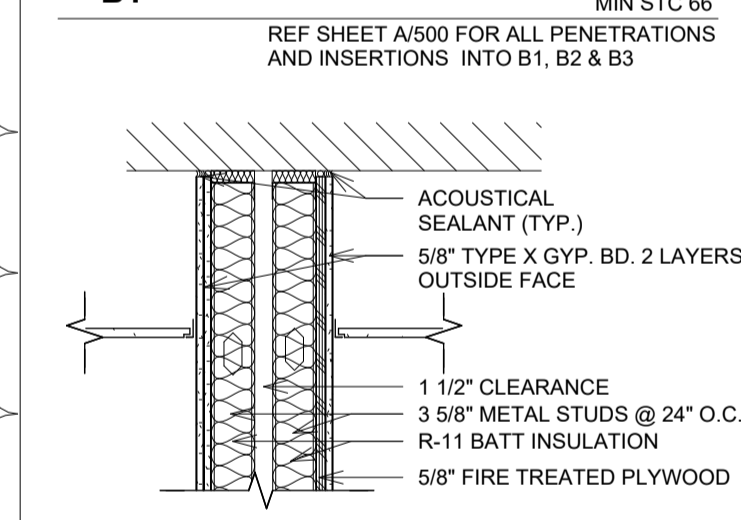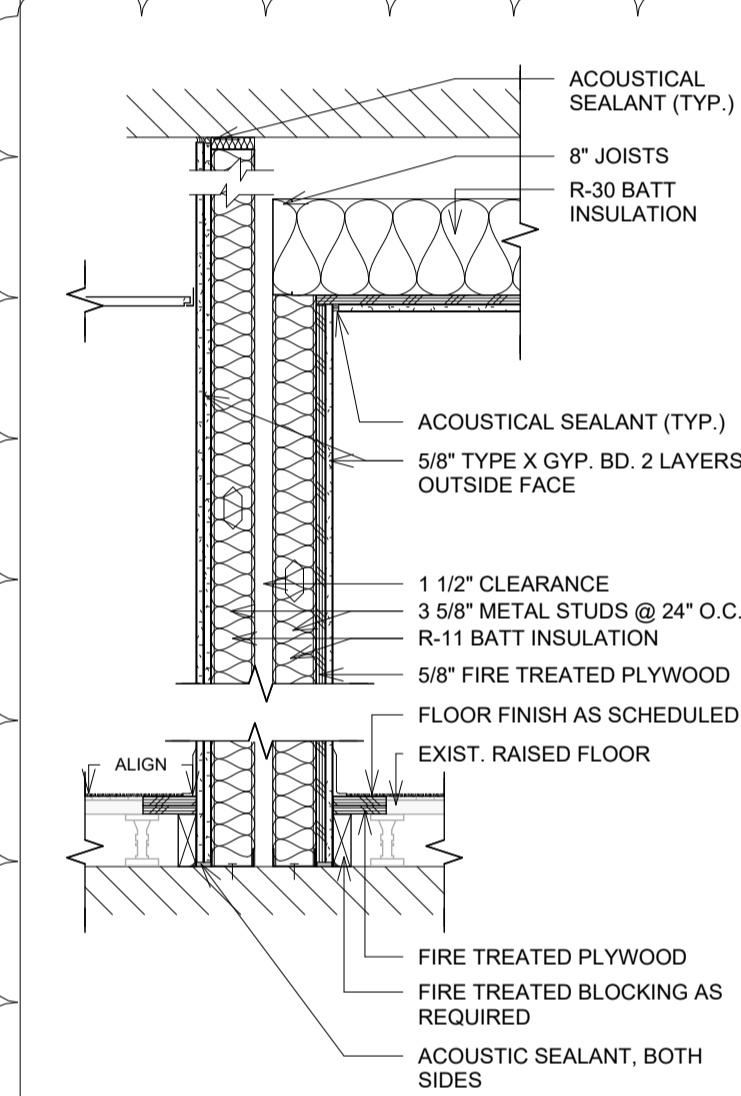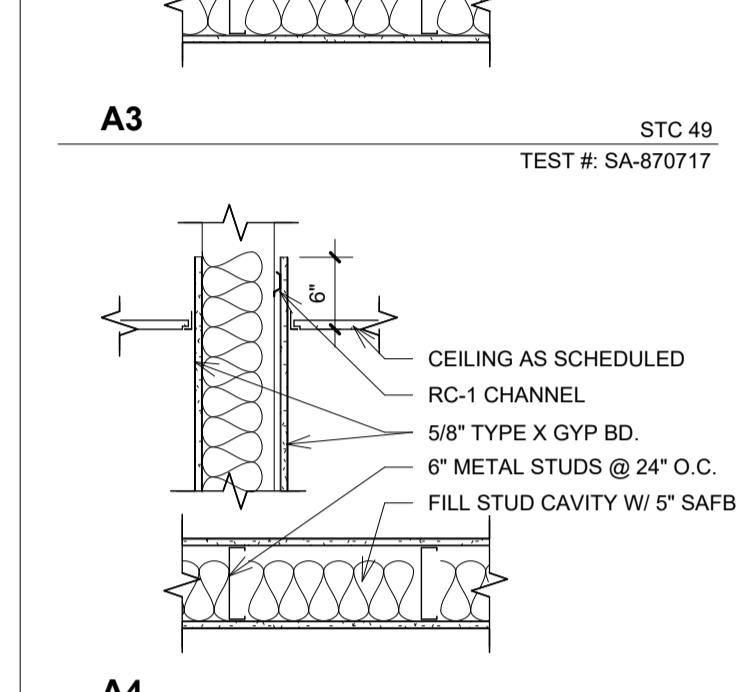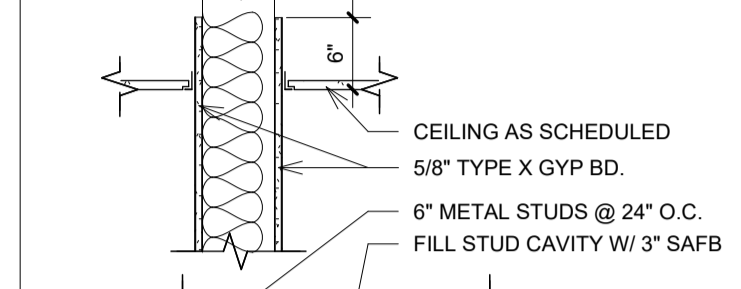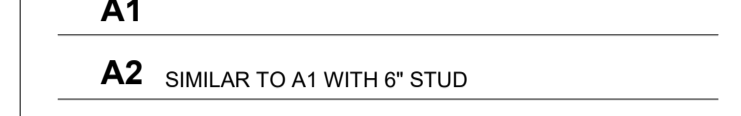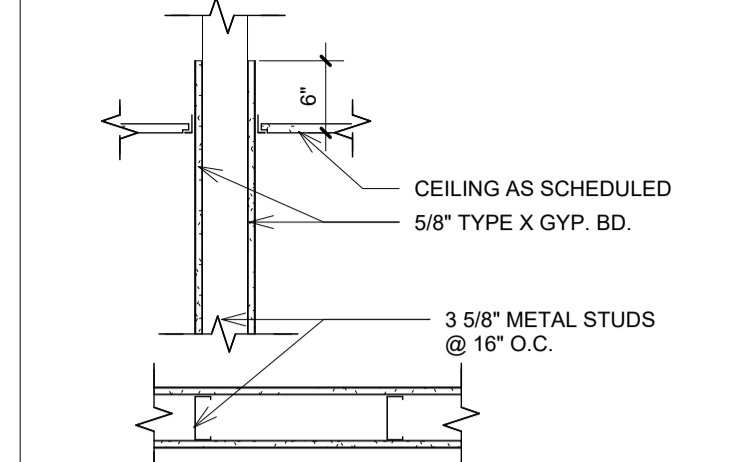

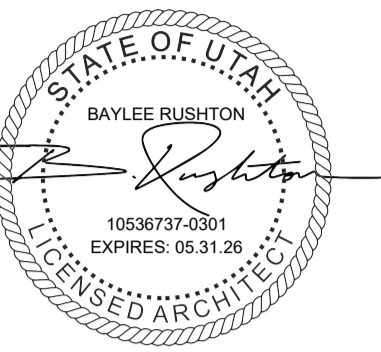

**GENETIC SCIENCE
LEARNING CENTER**

CONSTRUCTION DOCUMENTS

DFCM SEAL

No	Description	Date
1	ADDENDUM 1	12/20/2024



GSLC
296 CHIPETA WAY
SALT LAKE CITY, UT 84108

22812
10.30.2024

FF&E PLAN

A120


Scale 1/8" = 1'-0"

FF & E SCHEDULE					
Identifier	Quantity	Type	Dimensions	Installation	Notes
CIRCULATION	1	Water & Ice Machine		Contractor Furnished, Contractor Installed	Quercus 985-16
CONFERENCE	1	TV - 75" Conference	62.5" L x 15" W x 38" tall	Owner Furnished, Owner Installed	
COE-1	1	TV - 75" Conference	62.5" L x 15" W x 38" tall	Owner Furnished, Owner Installed	
MEDIA REVIEW	1	TV - 80" Media Review	39" L x 47" W x 50" tall	Owner Furnished, Owner Installed	
MIN-1	1	TV - 80" Media Review	39" L x 47" W x 50" tall	Owner Furnished, Owner Installed	
PRINT MEDIA	1	Owner Provided Caddy	11" L x 19" W x 24" tall	Owner Furnished, Owner Installed	
PE-1	1	NP Desktop 1000	16" x 20.5" W x 38" tall	Owner Furnished, Owner Installed	
PE-2	1	Sharp MX-5441	18" x 20" W x 40" tall	Owner Furnished, Owner Installed	
PE-3	1	Flat File Storage Cabinets	30" D x 43" W x 13" H	Contractor Furnished, Contractor Installed	(2) Cabinet units stacked with matching 4" base
PC-1	4	Flat File Storage Cabinets	30" D x 43" W x 13" H	Contractor Furnished, Contractor Installed	
SOUND OFFICE	1	Pod/booth	62" L x 11" W x 5' H	Owner Furnished, Owner Installed	
SOE-1	1	Pod/booth	62" L x 11" W x 5' H	Owner Furnished, Owner Installed	
SOE-2	2	Standing Speakers	18" L x 14" W x 23" H	Owner Furnished, Owner Installed	
STORAGE	10	Existing Compact Shelving	18" L	Owner Furnished, Owner Installed	
STN-1	1	Shelving Track	18" L	Contractor Furnished, Contractor Installed	Contractor to coordinate w/ owner on compatible track. Install per manufacturer's recommendation.
SUPPLIES	1	Mini Fridge		Owner Furnished, Owner Installed	
SE-1	1	Mini Fridge		Owner Furnished, Owner Installed	
SE-2	1	Shield Lab Table	72" L x 30" W x 38" tall	Owner Furnished, Owner Installed	
SE-3	1	Chemical Cabinet		Owner Furnished, Owner Installed	
TOUCHDOWN SPACE	1	TV - 75" Touchdown	62.5" L x 15" W x 38" tall	Owner Furnished, Owner Installed	
TE-1	1	TV - 75" Touchdown	62.5" L x 15" W x 38" tall	Owner Furnished, Owner Installed	




1 FF&E FLOOR PLAN - FOR REFERENCE ONLY
A120 1/8" = 1'-0"




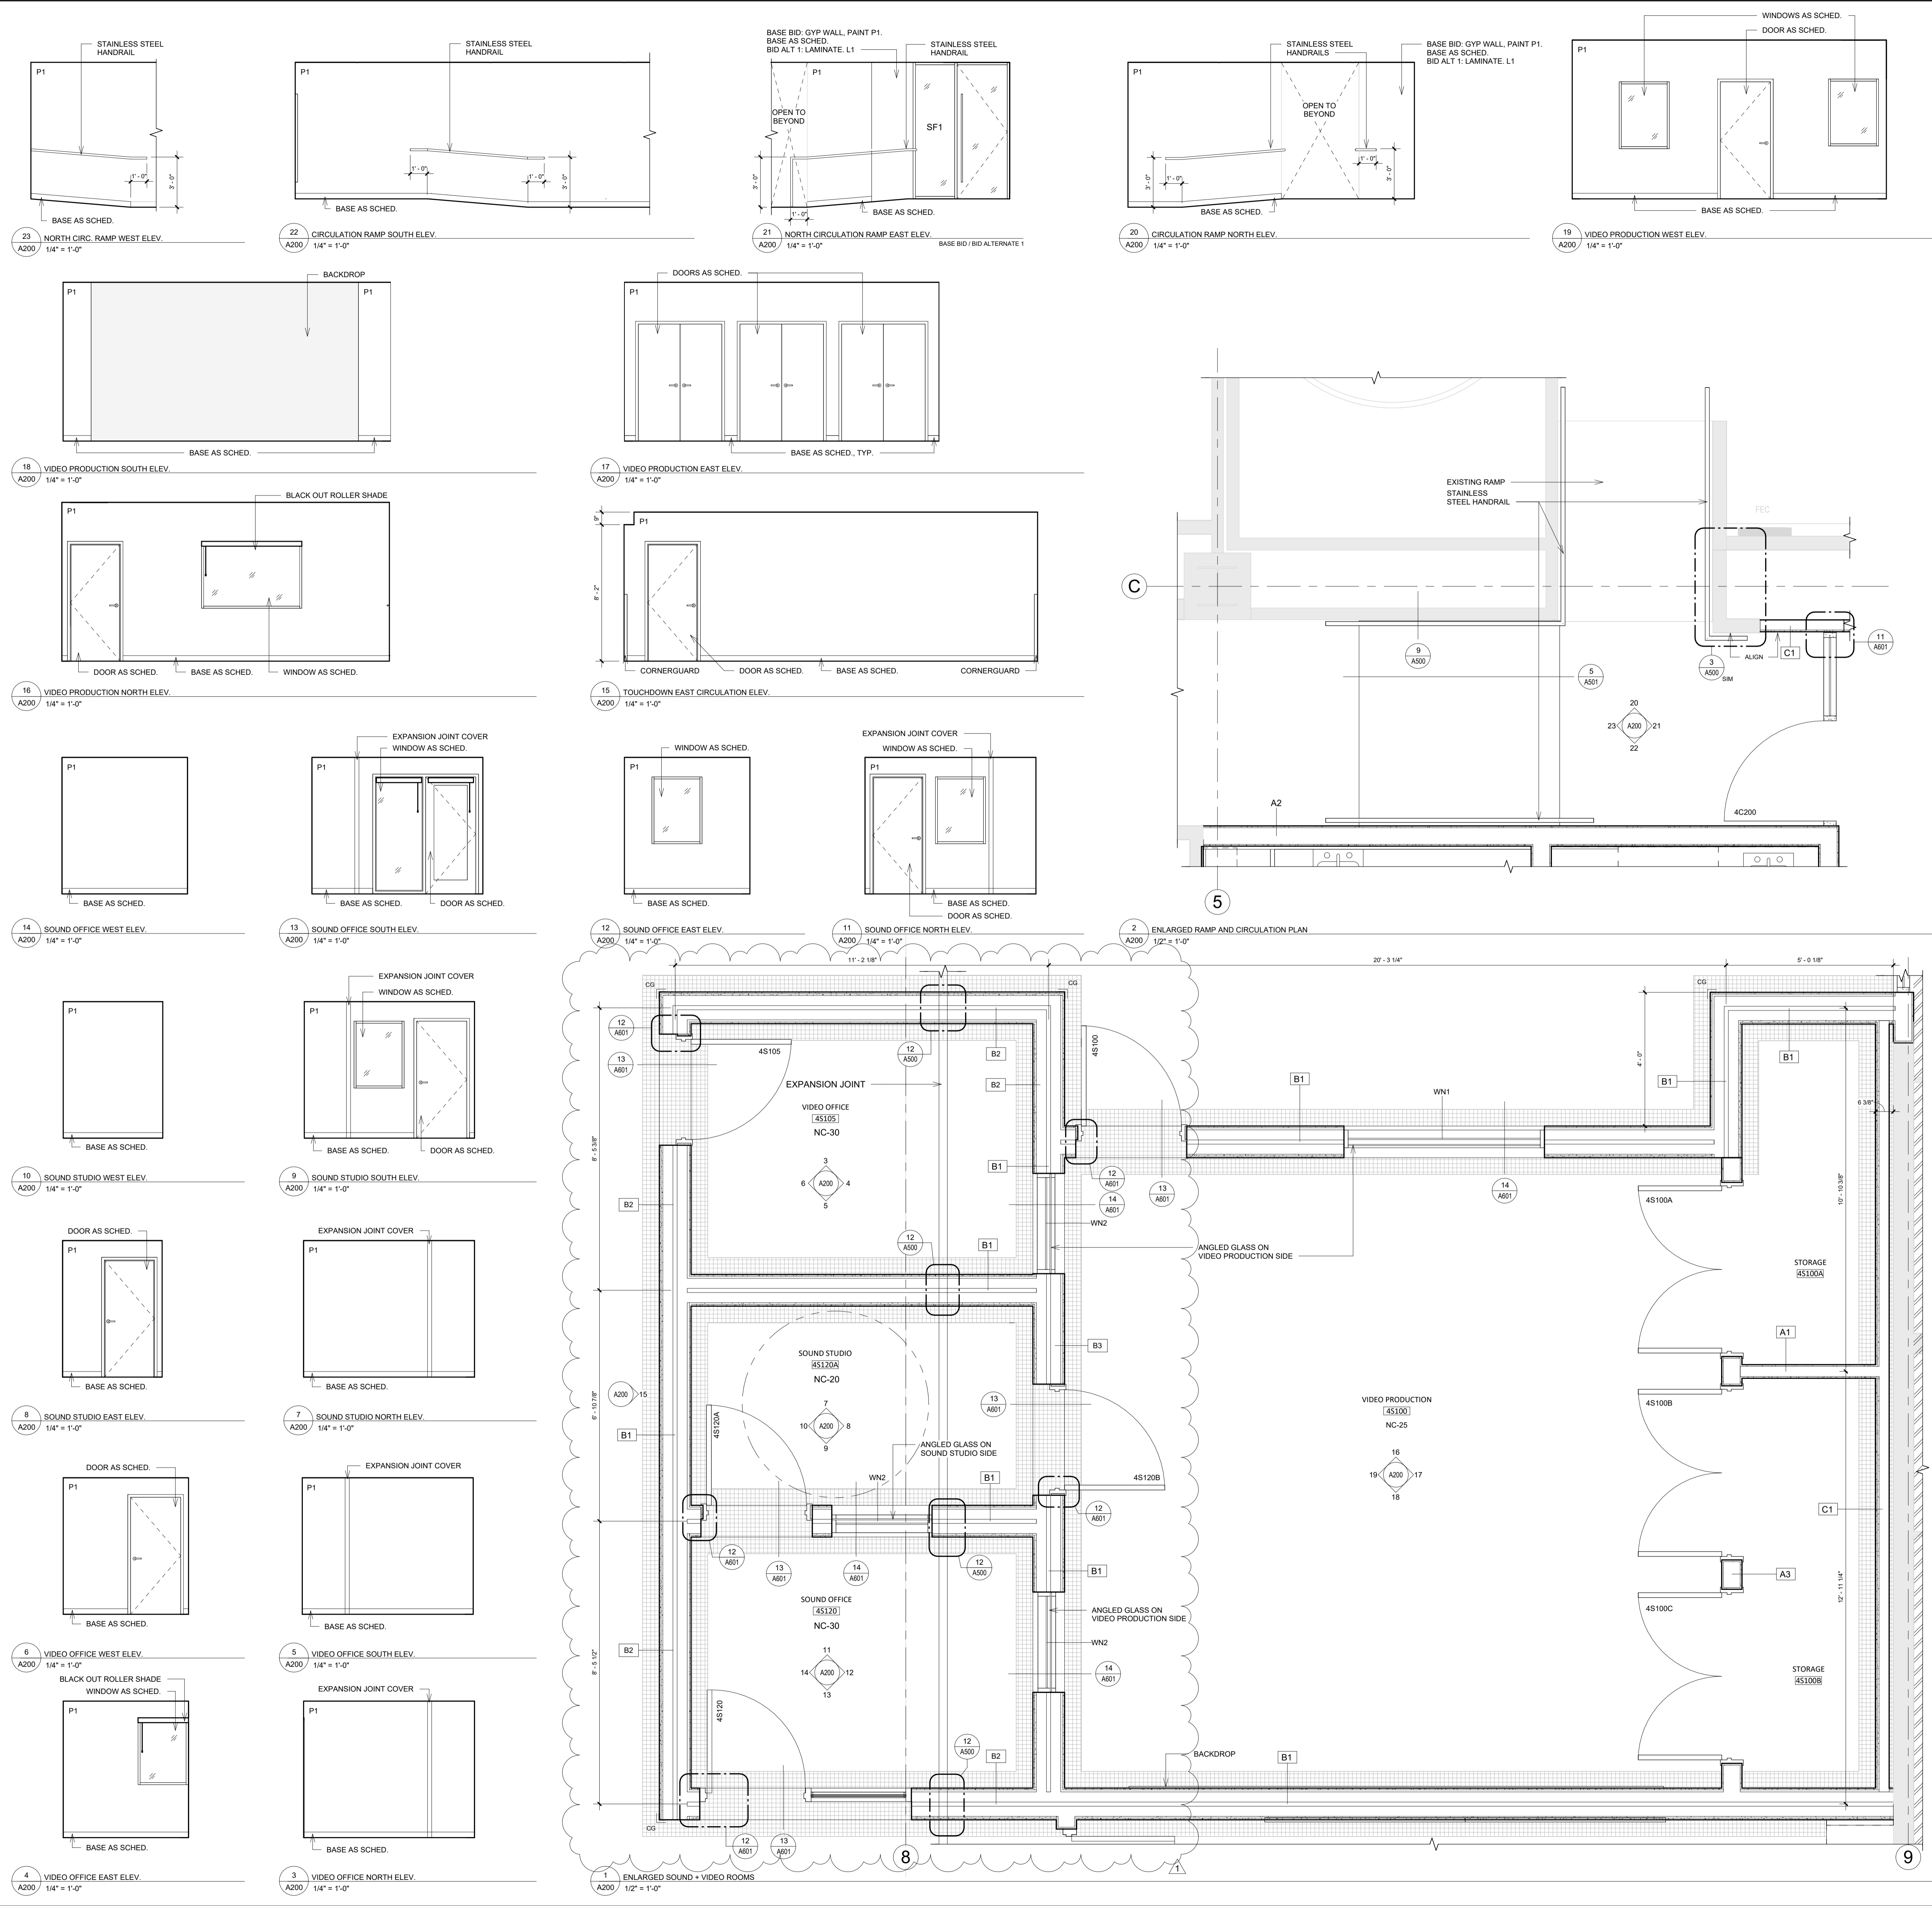

WALL TYPES

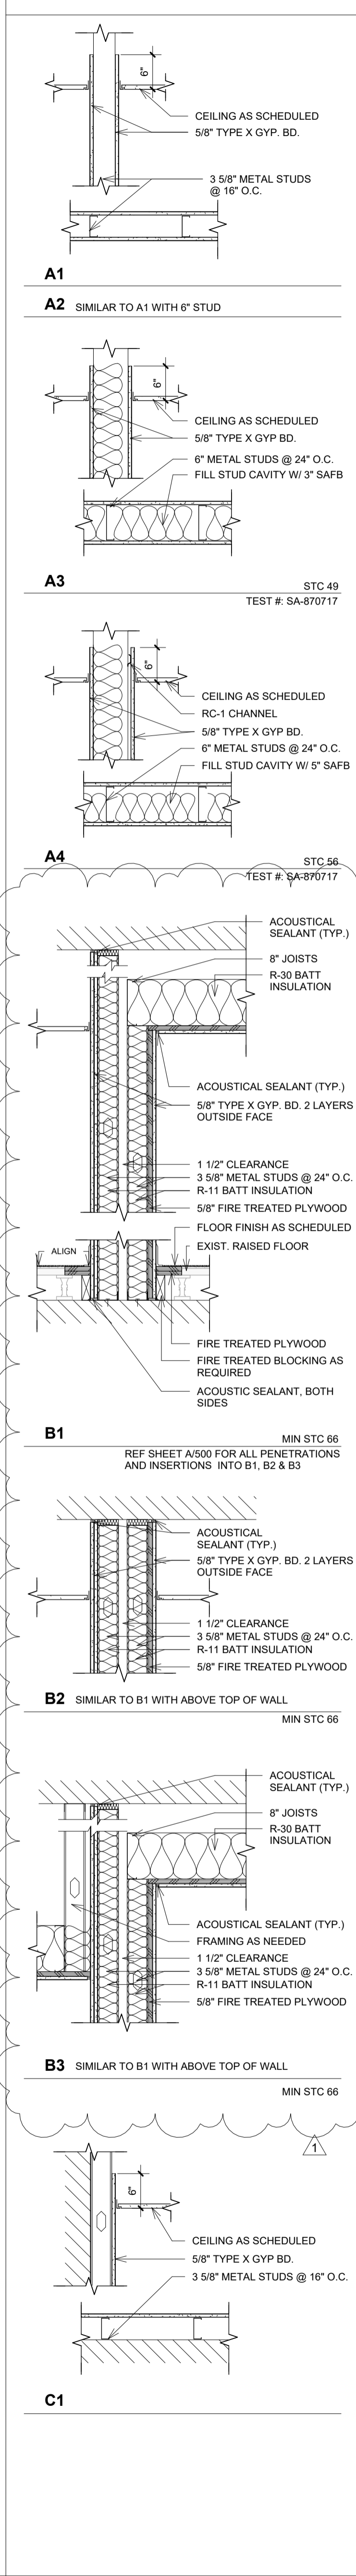


PLAN LEGEND

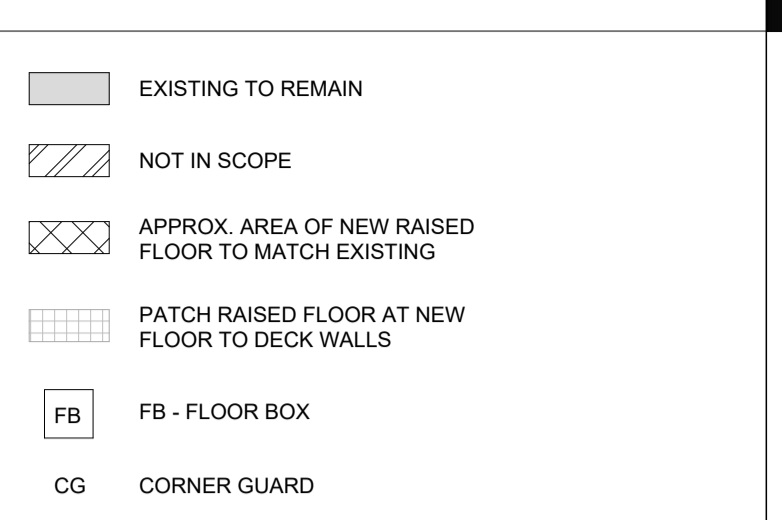

PLAN NOTES

- ARCHITECTURAL NOTES:
1. VERIFY ALL EXISTING CONDITIONS PRIOR TO COMMENCING WORK.
 2. CONTRACTOR TO BECOME FAMILIAR WITH ALL DRAWINGS + EXISTING CONDITIONS. BRING DISCREPANCIES TO ARCHITECT IN A TIMELY FASHION PRIOR TO PROCEEDING WITH WORK.
 3. PROVIDE TEMPORARY DUST PROTECTION @ ALL AREAS OF CONSTRUCTION.
 4. PROTECT SHADES AND ROLL CORDS. COORDINATE REPLACEMENT OF DAMAGED SHADES WITH OWNER.

CEILING LEGEND

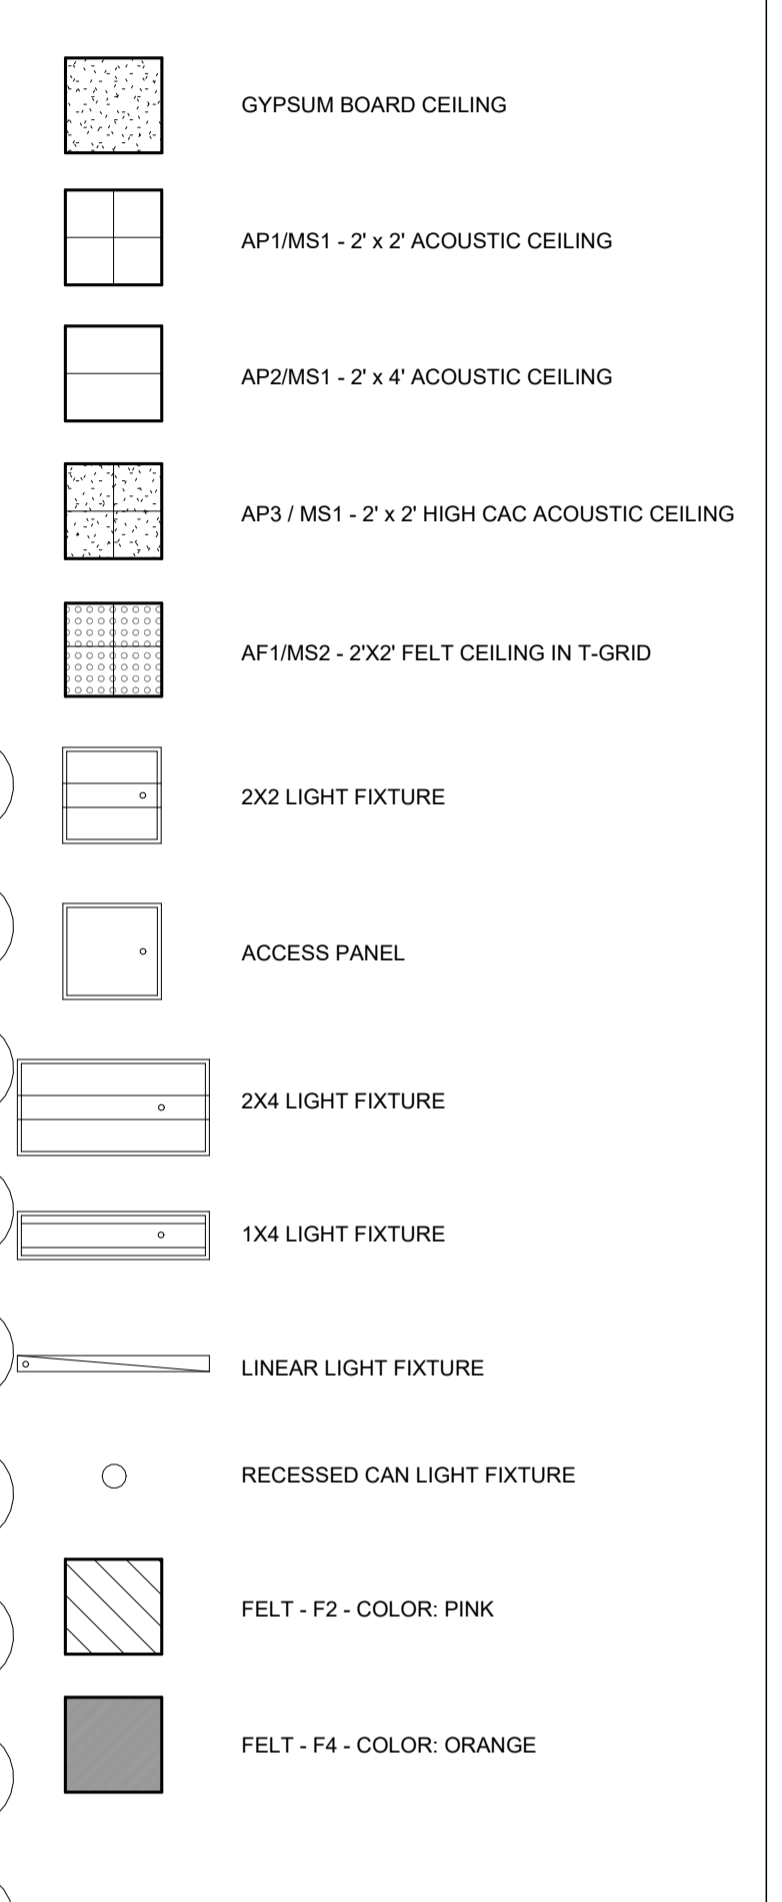


CEILING NOTES

- ARCHITECTURAL:
1. FIELD VERIFY ALL CONDITIONS PRIOR TO COMMENCING WORK
 2. ALL CEILING HEIGHTS MEASURED FROM FINISHED FLOOR
- MECHANICAL NOTES:
1. ALIGN ALL DIFFUSERS AS SHOWN
 2. REFER TO MECH. DRAWINGS
- ELECTRICAL:
1. ALIGN ALL LIGHT FIXTURES AND CEILING ELEMENTS AS SHOWN
 2. REFER TO ELEC. DRAWINGS

ELEV. LEGEND

- P1 = PAINT, COLOR: 7566 WESTHIGHLAND WHITE
- P2 = PAINT, COLOR: 6494 LAKESHORE
- F1 = FELT, COLOR: GREEN
- F2 = FELT, COLOR: PINK
- F3 = FELT, COLOR: PURPLE
- F4 = FELT, COLOR: ORANGE
- RP1 = RESIN PANEL, COLOR: KILT + WHITE OUT
- L1 = LAMINATE, COLOR: AGED ASH
- L2 = LAMINATE, COLOR: HUNTER GREEN
- TL1 = LAMINATE TEXTURED PANEL, FINISH: FILA, SALINAS OAK
- TF1 = FELT TEXTURED PANEL, FINISH: BOLLA, MIDNIGHT
- WS1 = WOOD SCREEN, SPECIES/FINISH: AMERICAN OAK / NATURAL
- SS1 = SOLID SURFACE COUNTERTOP, COLOR: FROSTY WHITE MIRAGE
- UP1 = UPHOLSTERY, COLOR: NICO 016 POSH
- RB1 = RUBBER BASE, COLOR: TQ2 SHARK FIN
- RB2 = RUBBER BASE, COLOR: GREY WG
- GW1 = GLASS WALL, SEE SPEC.
- GW2 = GLASS WALL, SEE SPEC.
- MB1 = MARKER BOARD 4'X6', SEE SPEC.
- TD = TOWEL DISPENSER BY OWNER, PROVIDE BLOCKING IN WALLS
- SD = SOAP DISPENSER BY OWNER, PROVIDE BLOCKING IN WALLS

331 S RIO GRANDE ST
SUITE 307
SLC, UT 84101
PH: 8017395569
BAYLE@STUDIO.LPARCH.COM

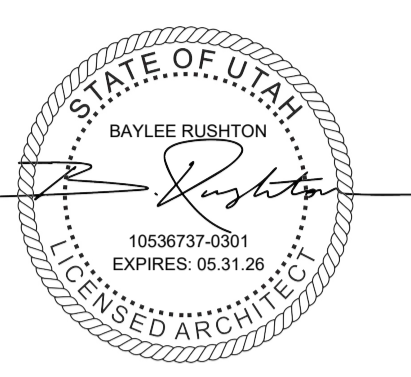

**GENETIC SCIENCE
LEARNING CENTER**

CONSTRUCTION DOCUMENTS

DFCM SEAL


No	Description	Date
1	ADDENDUM 1	12/20/2024




GSCLC
296 CHIPETA WAY
SALT LAKE CITY, UT 84108

22812
10.30.2024
ENLARGED PLAN
+ ELEVATIONS


A200
Scale As indicated

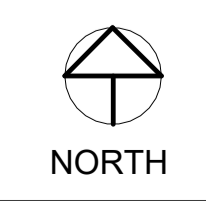

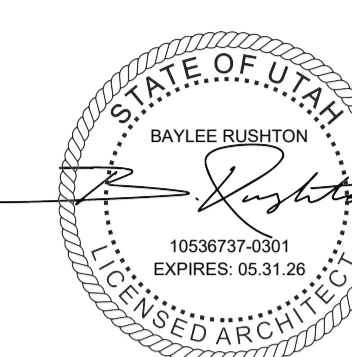

ELEV. LEGEND

- P1 = PAINT, COLOR: 7566 WESTHIGHLAND WHITE
- P2 = PAINT, COLOR: 8484 LAKESHORE
- F1 = FELT, COLOR: GREEN
- F2 = FELT, COLOR: PINK
- F3 = FELT, COLOR: PURPLE
- F4 = FELT, COLOR: ORANGE
- RP1 = RESIN PANEL, COLOR: KILT + WHITE OUT
- L1 = LAMINATE, COLOR: AGED ASH
- L2 = LAMINATE, COLOR: HUNTER GREEN
- TL1 = LAMINATE TEXTURED PANEL, FINISH: FILA, SALINAS OAK
- TF1 = FELT TEXTURED PANEL, FINISH: BOLA, MIDNIGHT
- WS1 = WOOD SCREEN, SPECIES/FINISH: AMERICAN OAK / NATURAL
- SS1 = SOLID SURFACE COUNTERTOP, COLOR: FROSTY WHITE MIRAGE
- UP1 = UPHOLSTERY, COLOR: NICO 016 POSH
- RB1 = RUBBER BASE, COLOR: TG2 SHARK FIN
- RB2 = RUBBER BASE, COLOR: GREY WG
- GW1 = GLASS WALL, SEE SPEC.
- GW2 = GLASS WALL, SEE SPEC.
- MB1 = MARKER BOARD 4'X8', SEE SPEC.
- TD = TOWEL DISPENSER BY OWNER, PROVIDE BLOCKING IN WALLS
- SD = SOAP DISPENSER BY OWNER, PROVIDE BLOCKING IN WALLS

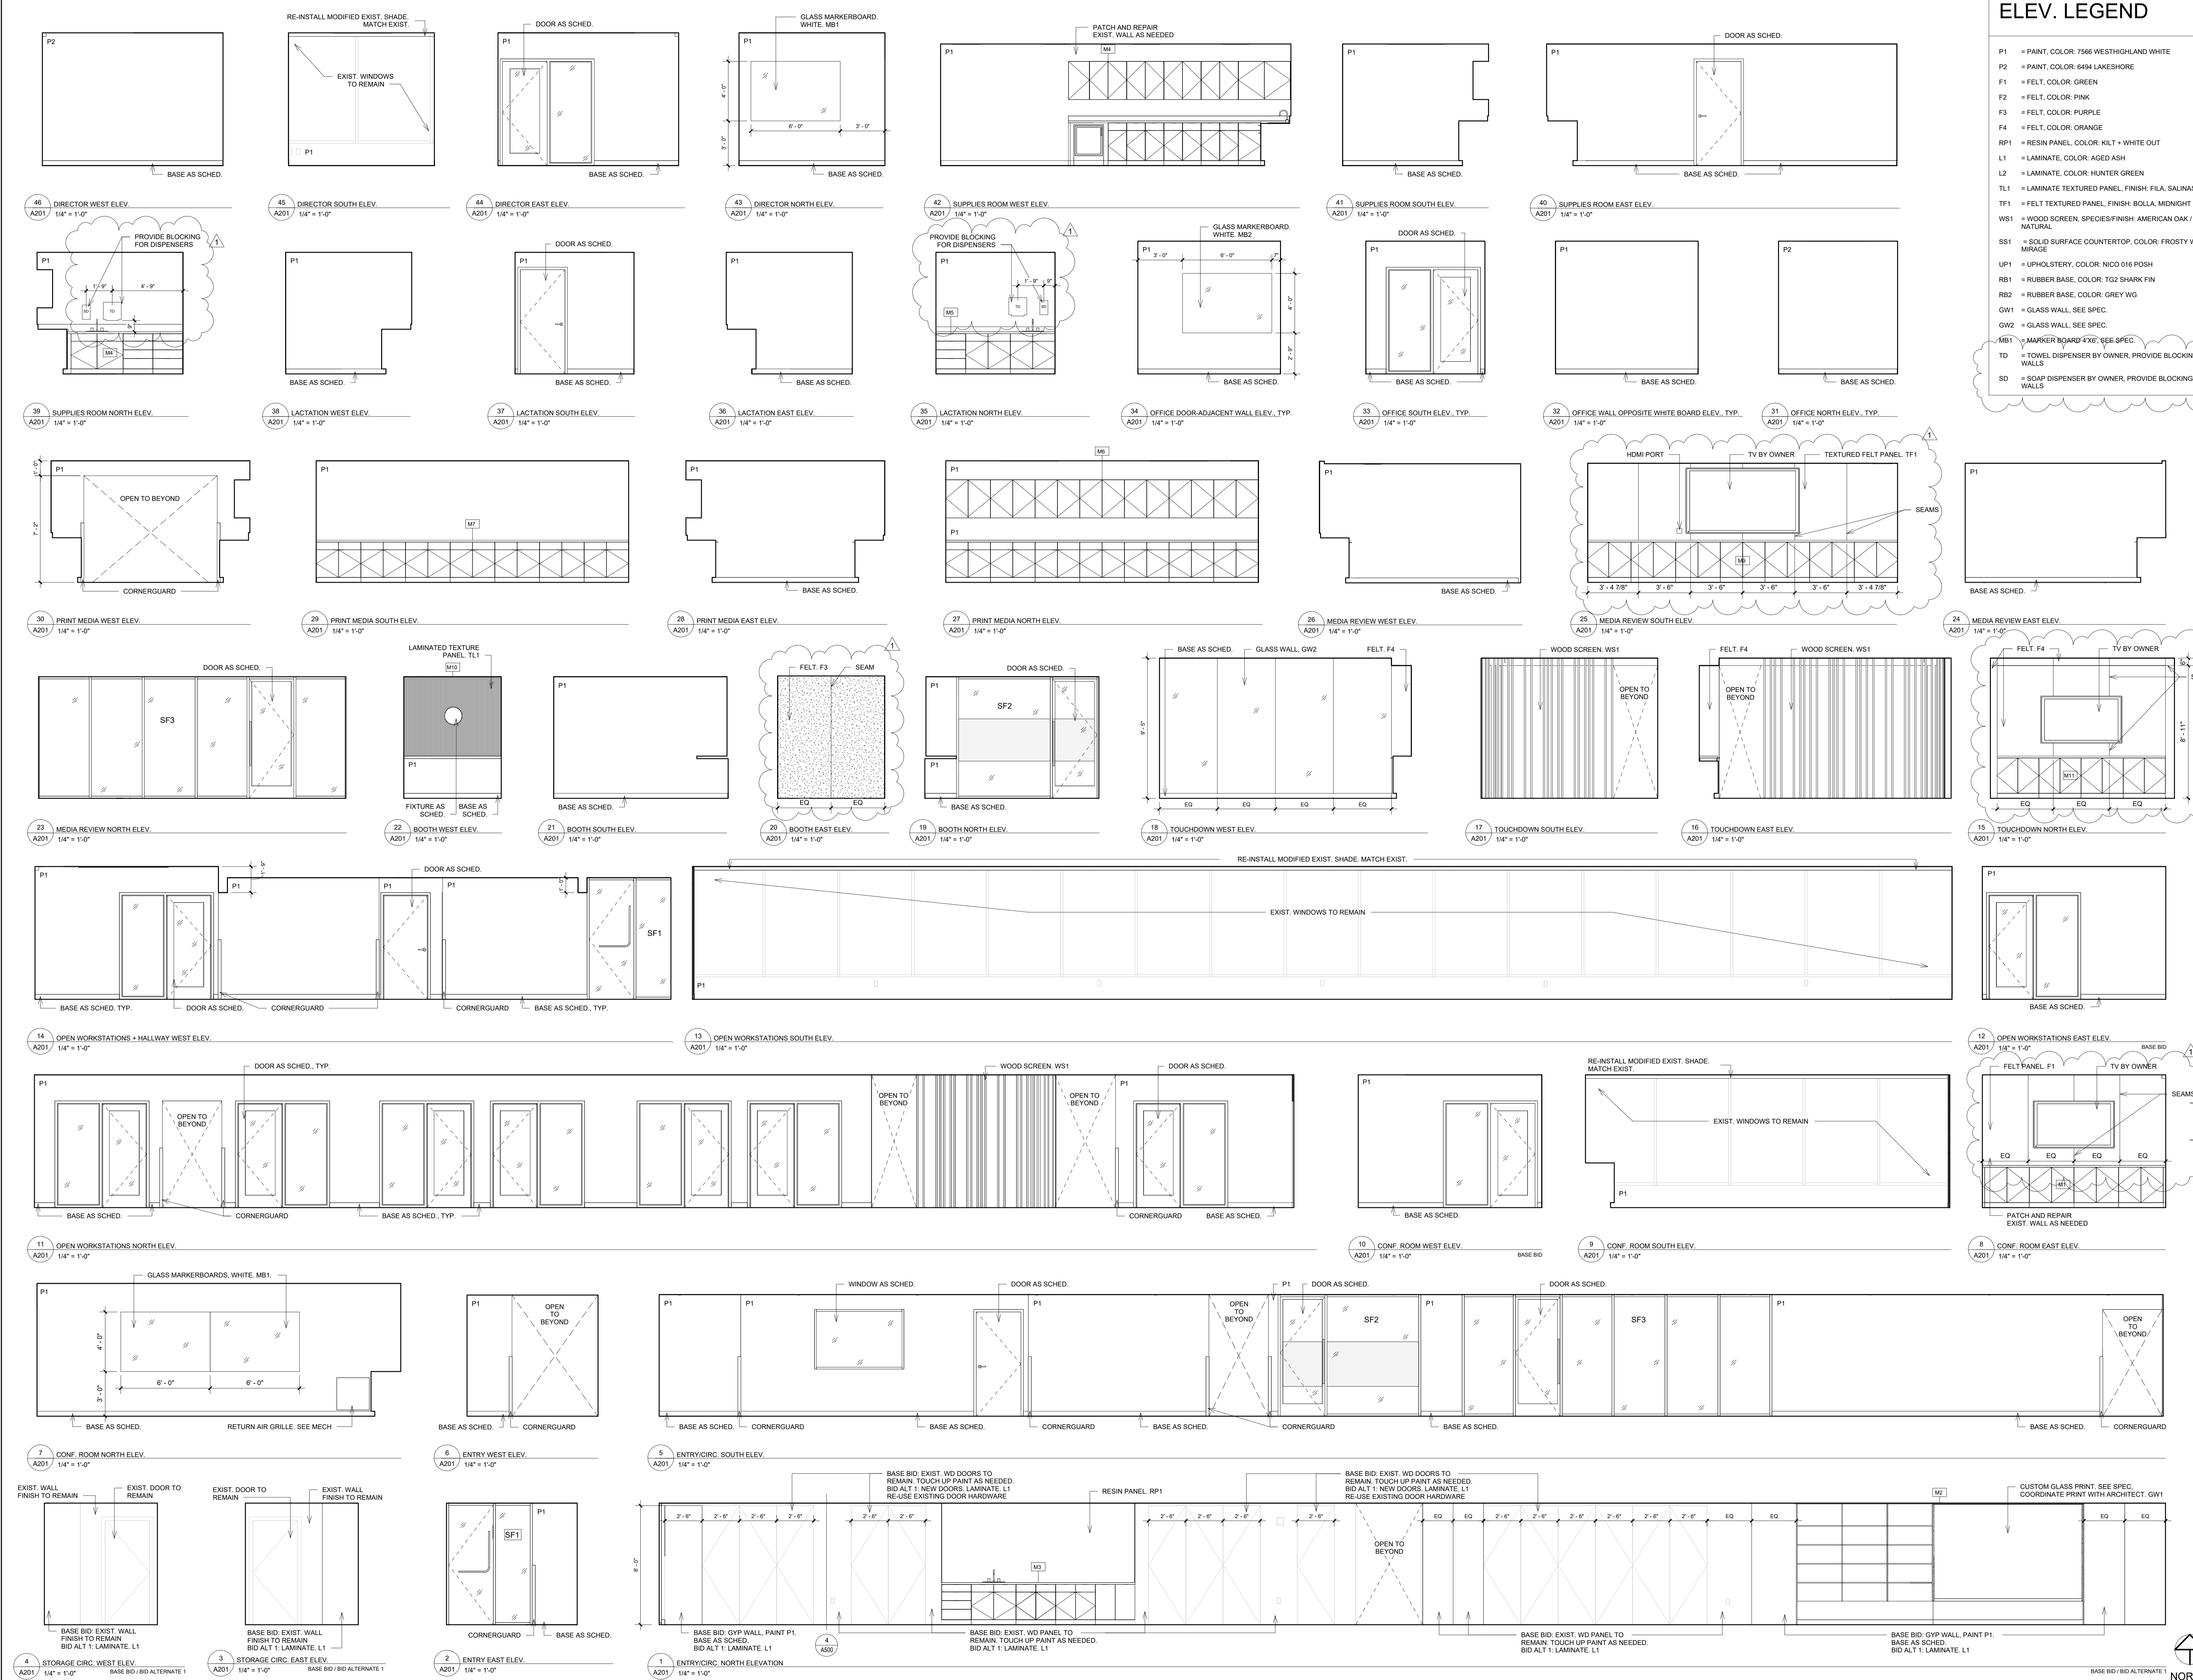

**GENETIC SCIENCE
LEARNING CENTER**

CONSTRUCTION DOCUMENTS

DFCM SEAL

No	Description	Date
1	ADDENDUM 1	12/20/2024





GSCLC
296 CHIPETA WAY
SALT LAKE CITY, UT 84108


22812
10.30.2024
INTERIOR
ELEVATIONS

A201
Scale 1/4" = 1'-0"




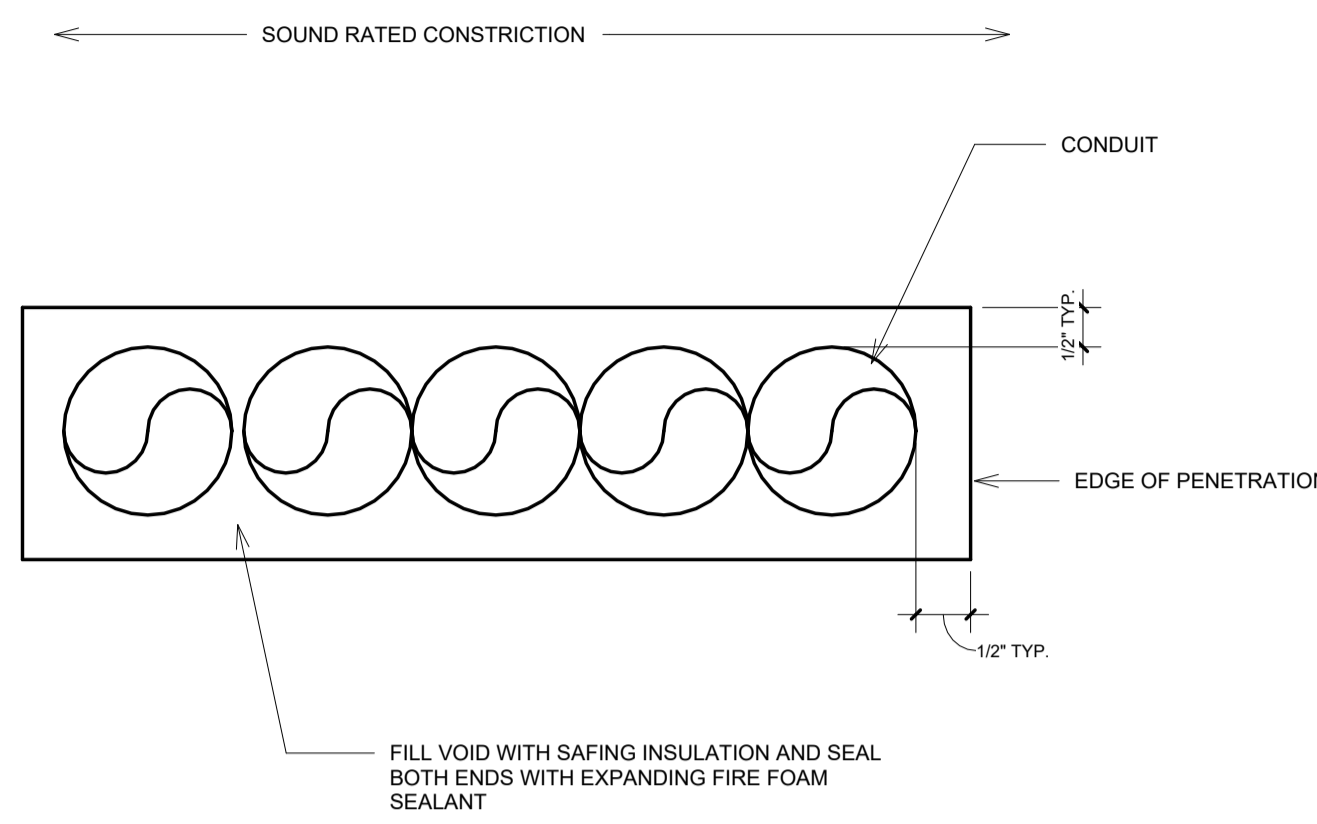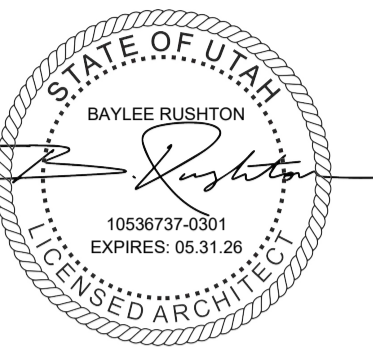


18 TYPICAL MULTIPLE PIPE OR CONDUIT PENETRATION THROUGH SOUND-RATED CONSTRUCTION
A500 / 3" = 1'-0"

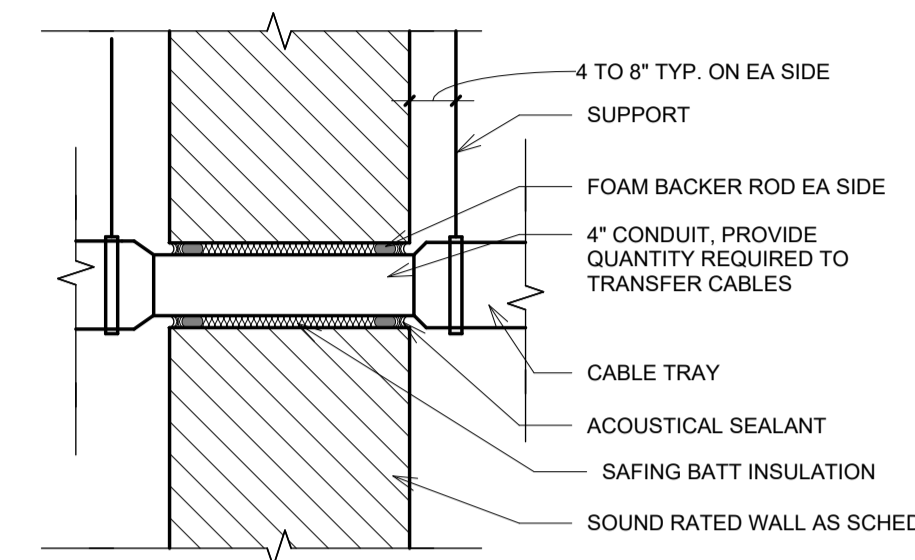

14 TYP. CABLE TRAY AT SOUND RATED WALL
A500 / 3" = 1'-0"

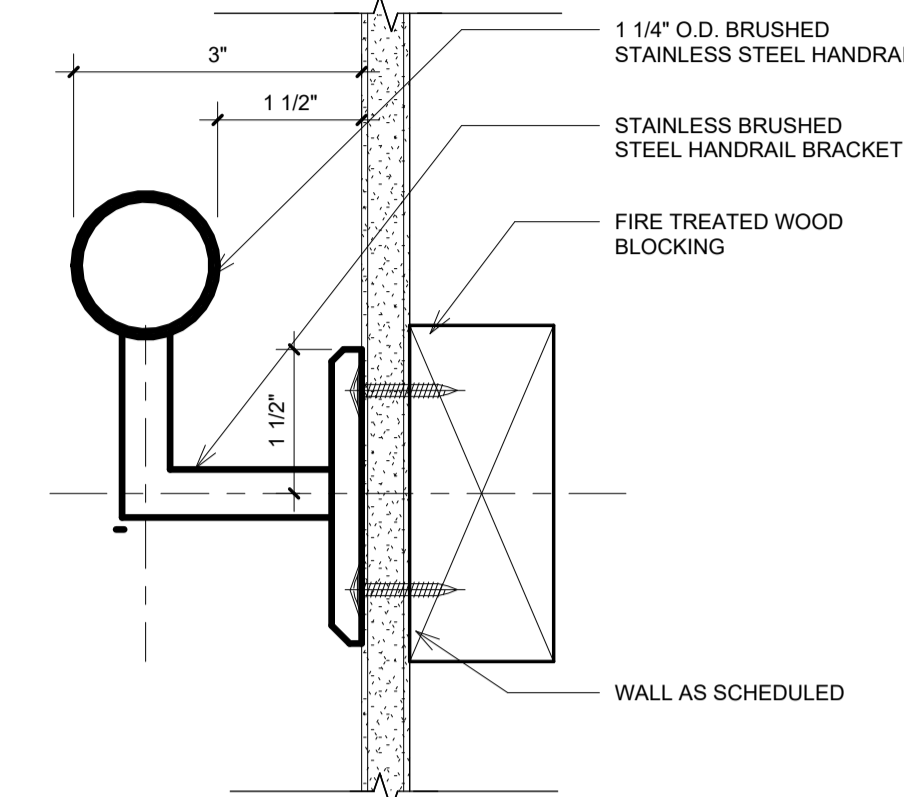


9 HANDRAIL DETAIL - FRAMED
A500 / 6" = 1'-0"

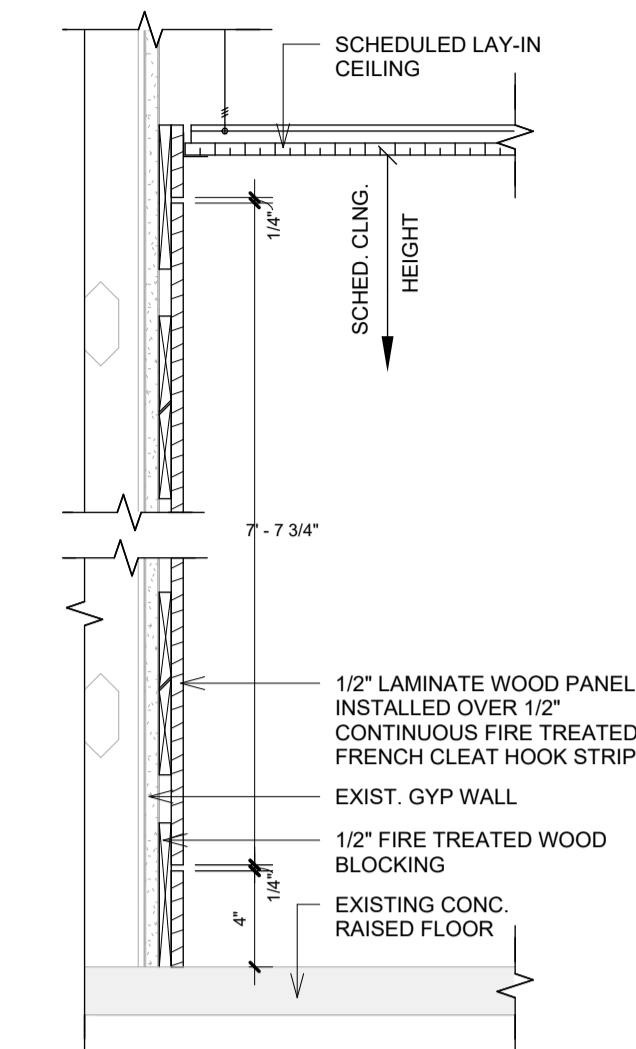


4 LAMINATE WALL PANEL
A500 / 1 1/2" = 1'-0"

BID ALTERNATE 1

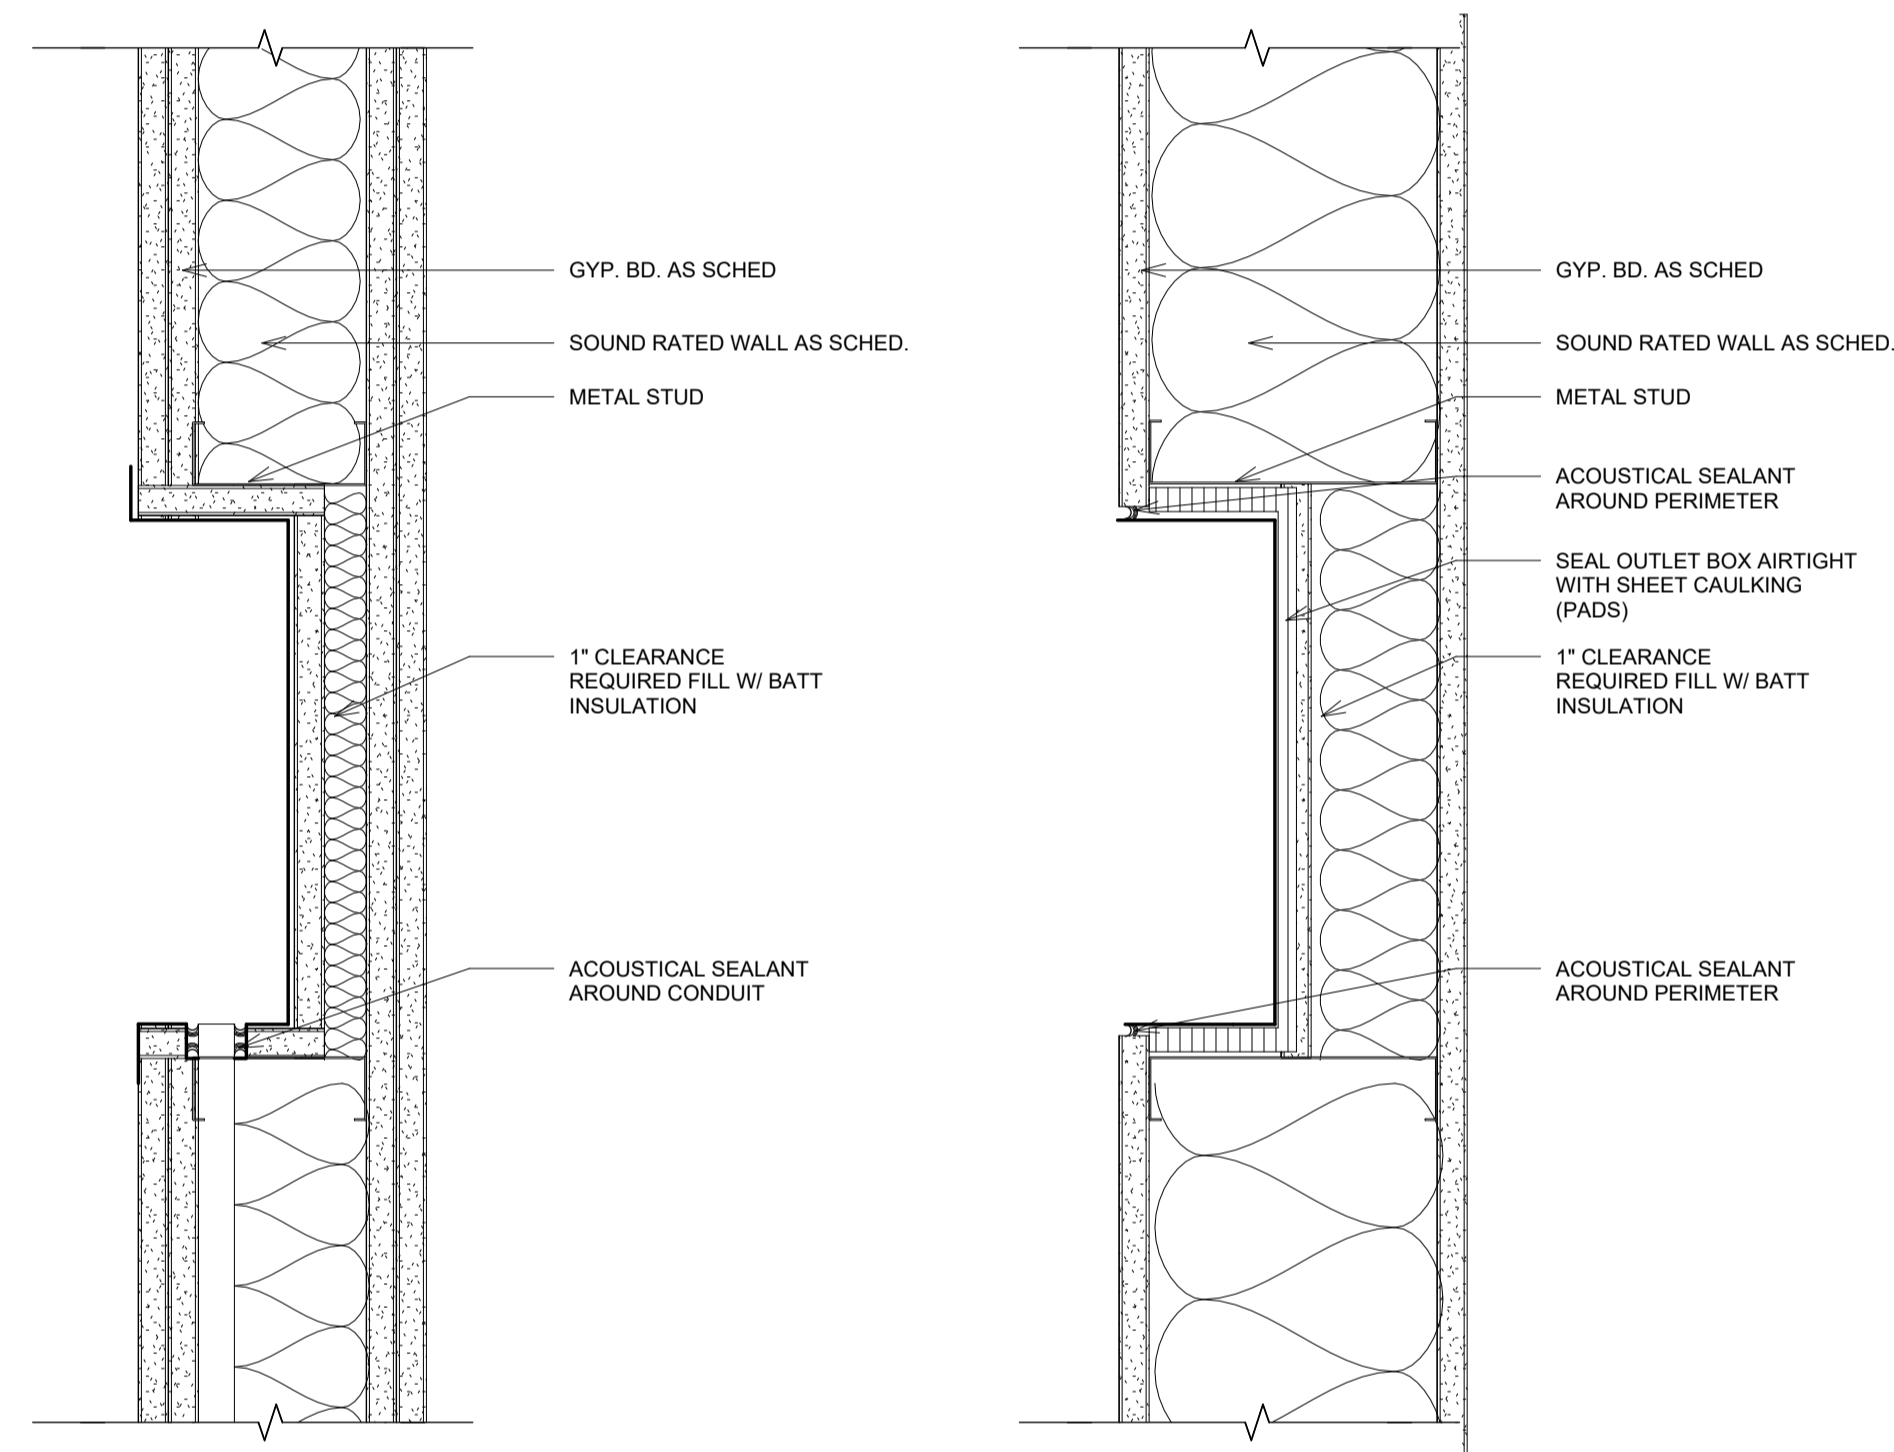


NOTES:
1. LINE TOP, BOTTOM, BACK AND SIDES WITH ONE LAYER 5" GYPSUM BOARD OR 2 pcf SHEET LEAD.
2. APPLICABLE AT ALL SOUND-RATED CONSTRUCTION INCLUDING INTERIOR INSULATED ASSEMBLIES


NOTES:
1. LINE TOP, BOTTOM, BACK, AND SIDES WITH ONE LAYER 5" GYPSUM BOARD OR 2 pcf SHEET LEAD.
2. APPLICABLE AT ALL SOUND-RATED CONSTRUCTION INCLUDING INTERIOR INSULATED ASSEMBLIES

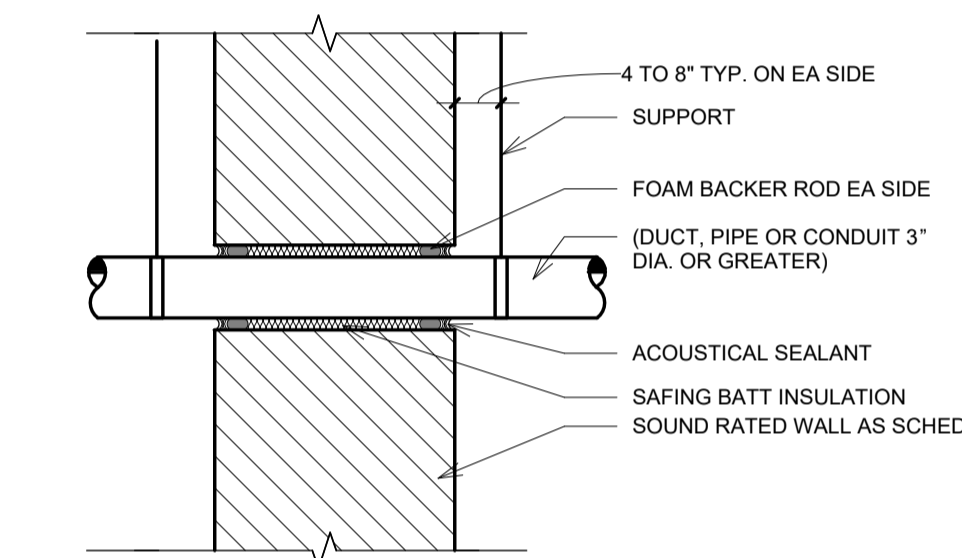

13 TYP. CONDUIT OR DUCT THROUGH SOUND RATED WALL
A500 / 3" = 1'-0"

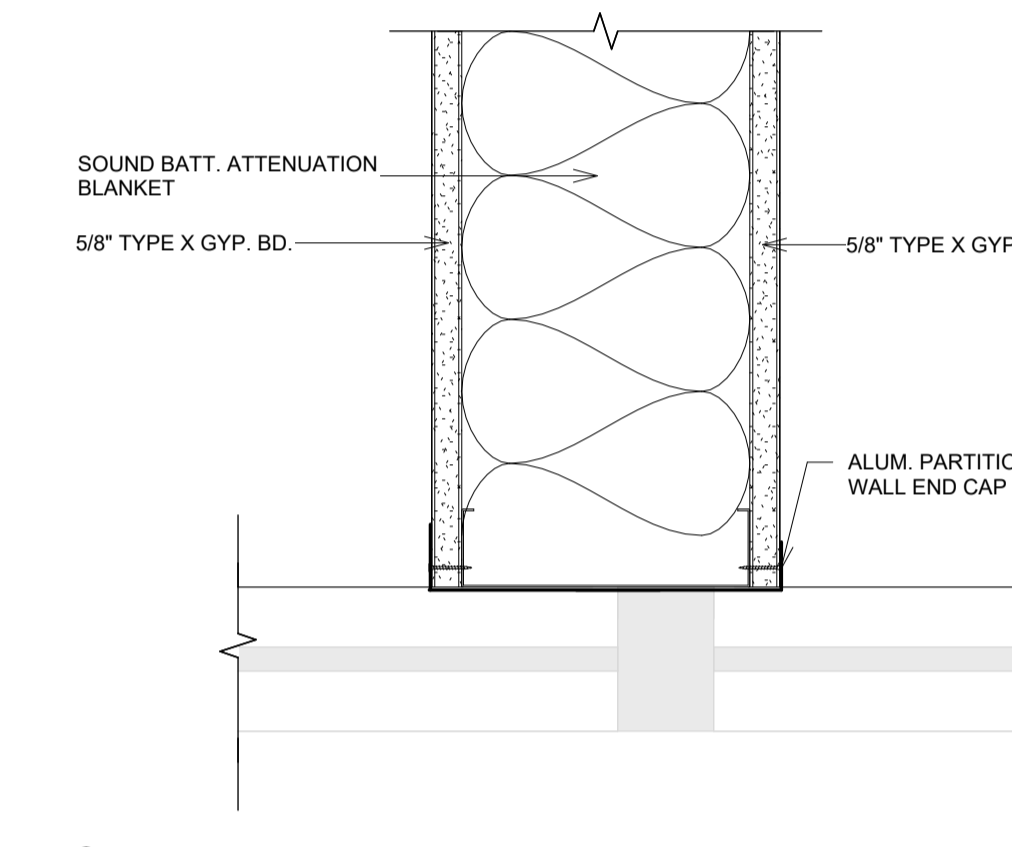


8 WALL AT EXTERIOR STOREFRONT
A500 / 3" = 1'-0"

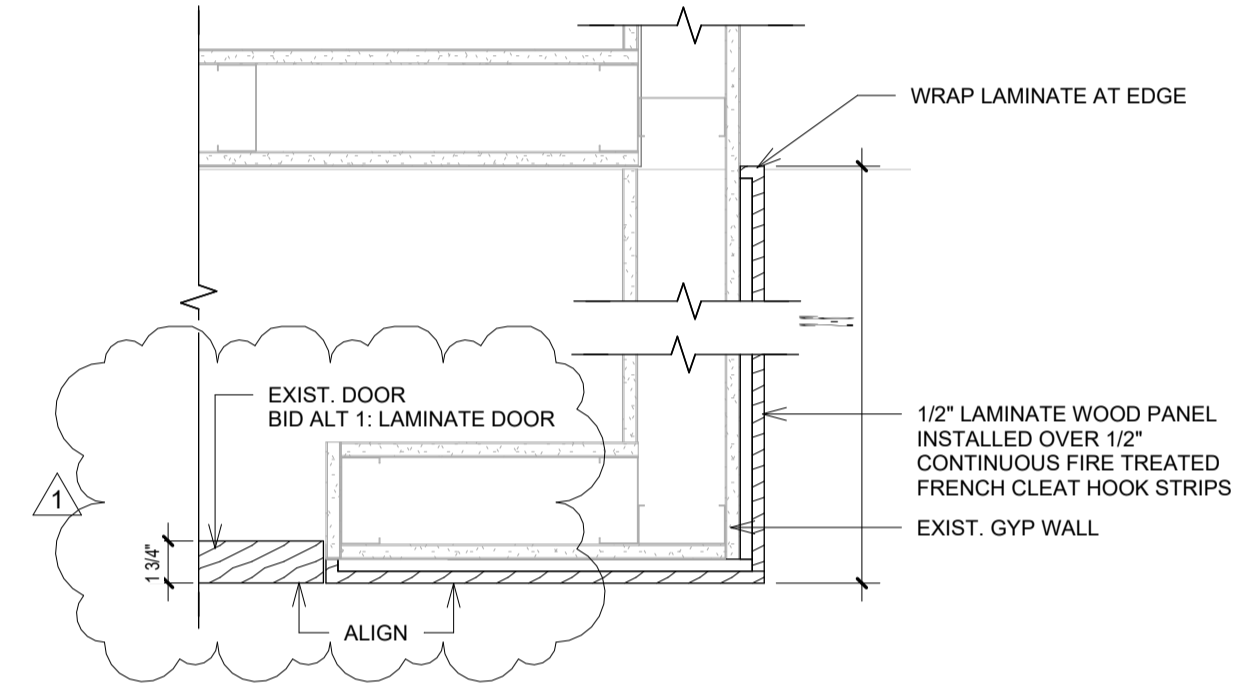


3 LAMINATE CORNER/DOOR
A500 / 1 1/2" = 1'-0"


BID ALTERNATE 1

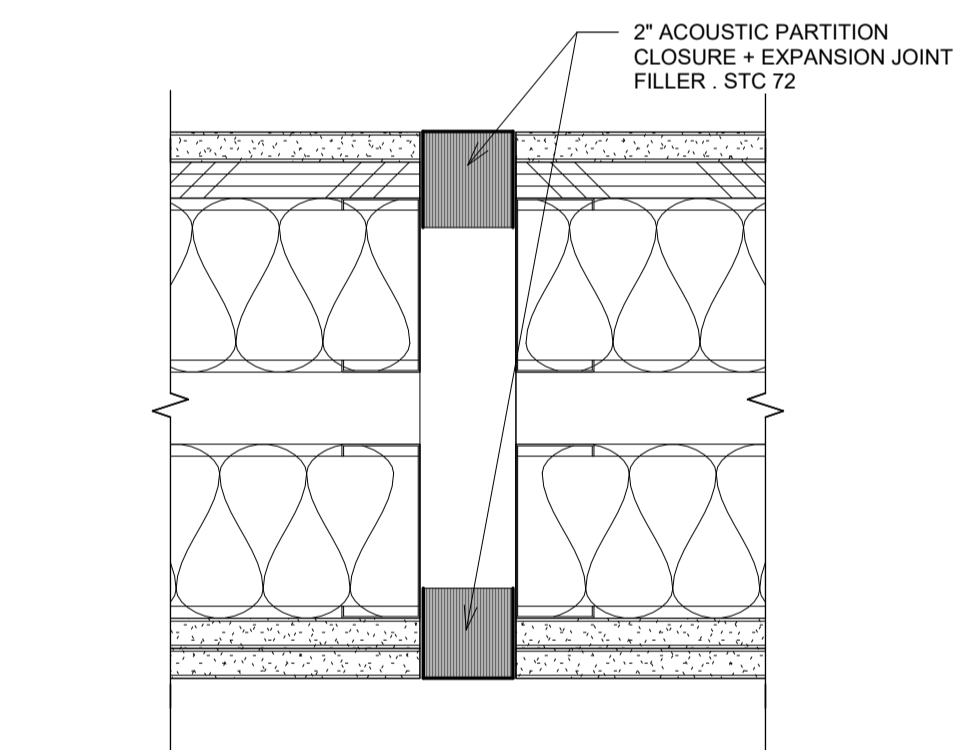

12 ACOUSTIC EXPANSION JOINT FILLER (W/2, C/2 SIM)
A500 / 3" = 1'-0"

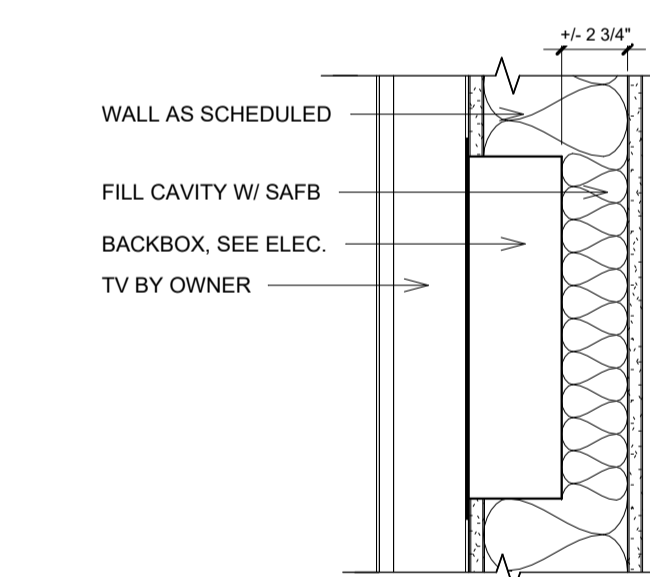


7 TV BACKBOX
A500 / 1 1/2" = 1'-0"

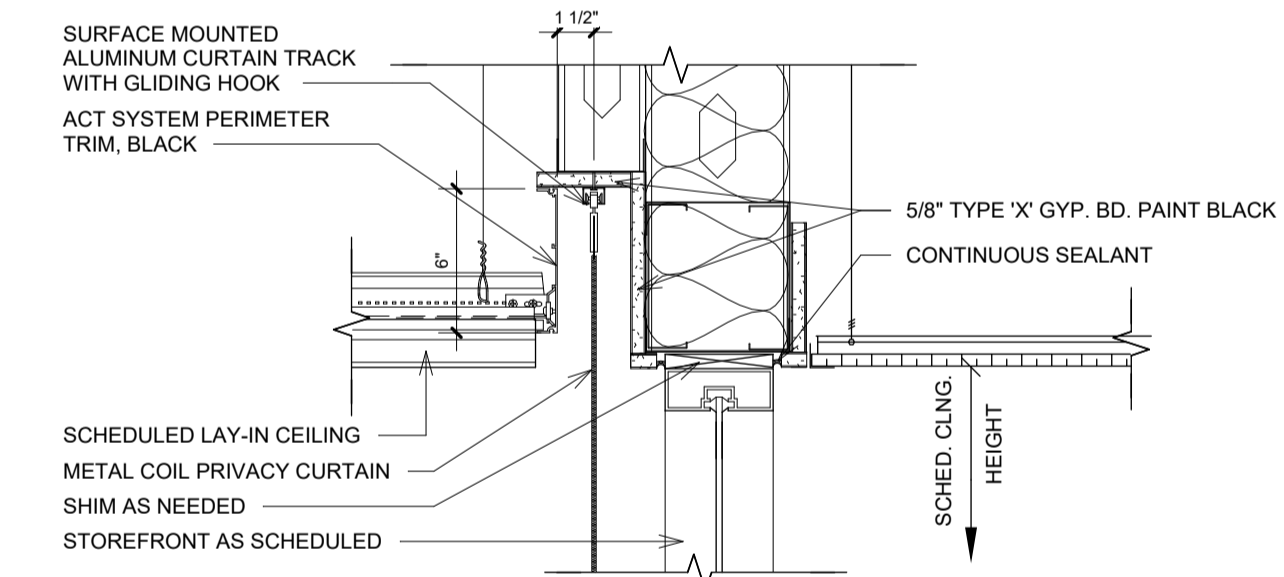


2 CONF. PRIVACY CURTAIN
A500 / 1 1/2" = 1'-0"


BID ALTERNATE 2

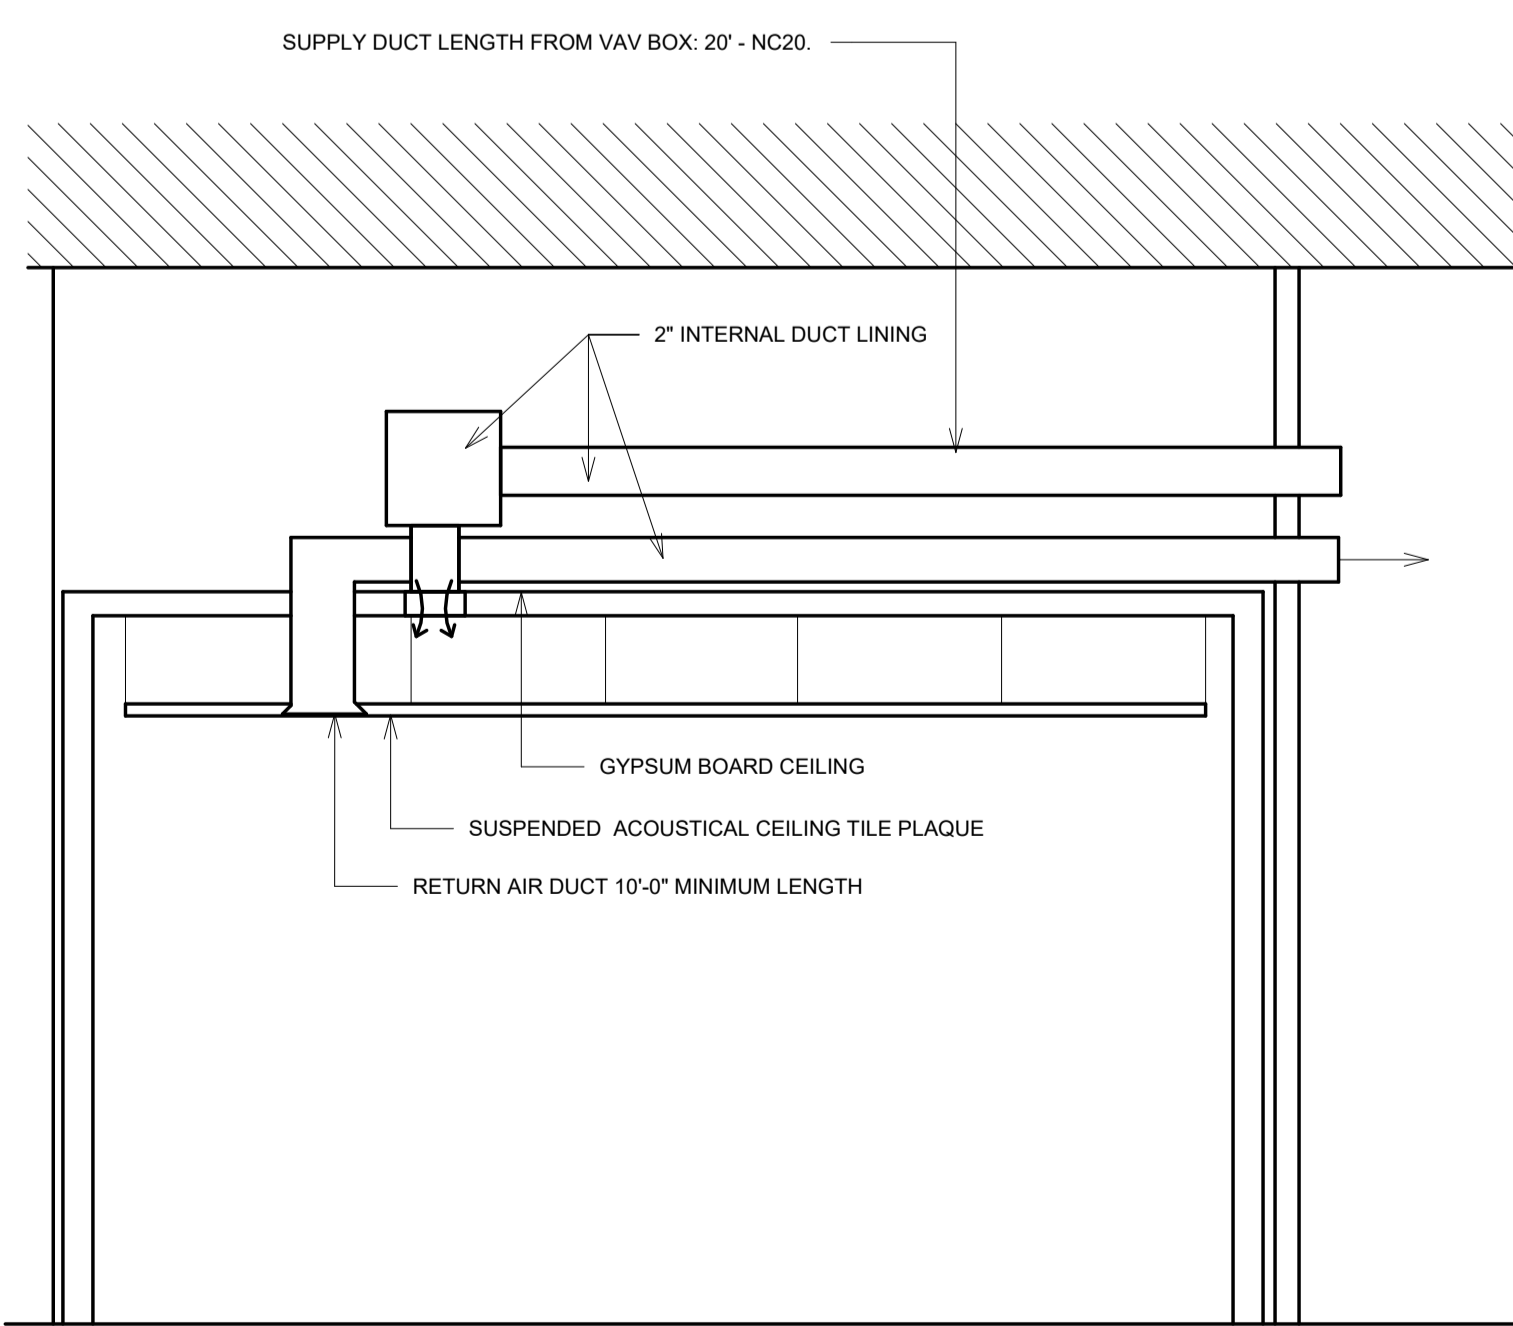


15 SUPPLY AIR PLAQUE AT LIDDED CONSTRUCTION
A500 / 3" = 1'-0"

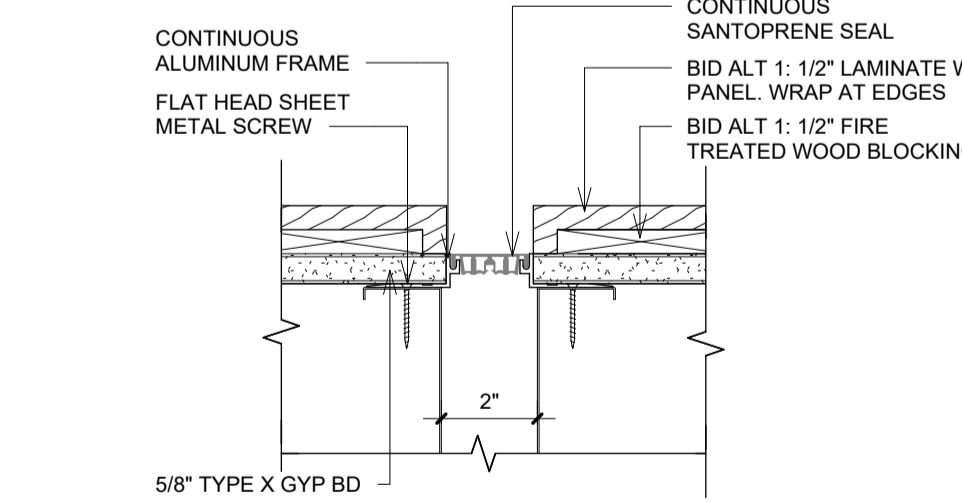

11 LAMINATE EXPANSION JOINT
A500 / 3" = 1'-0"

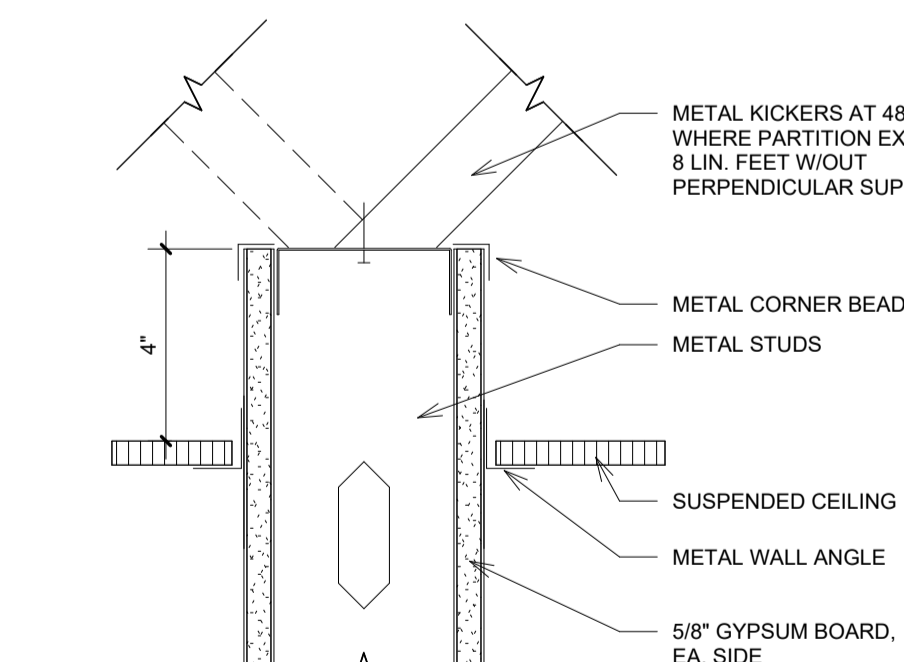

6 TYPICAL TOP OF WALL
A500 / 3" = 1'-0"

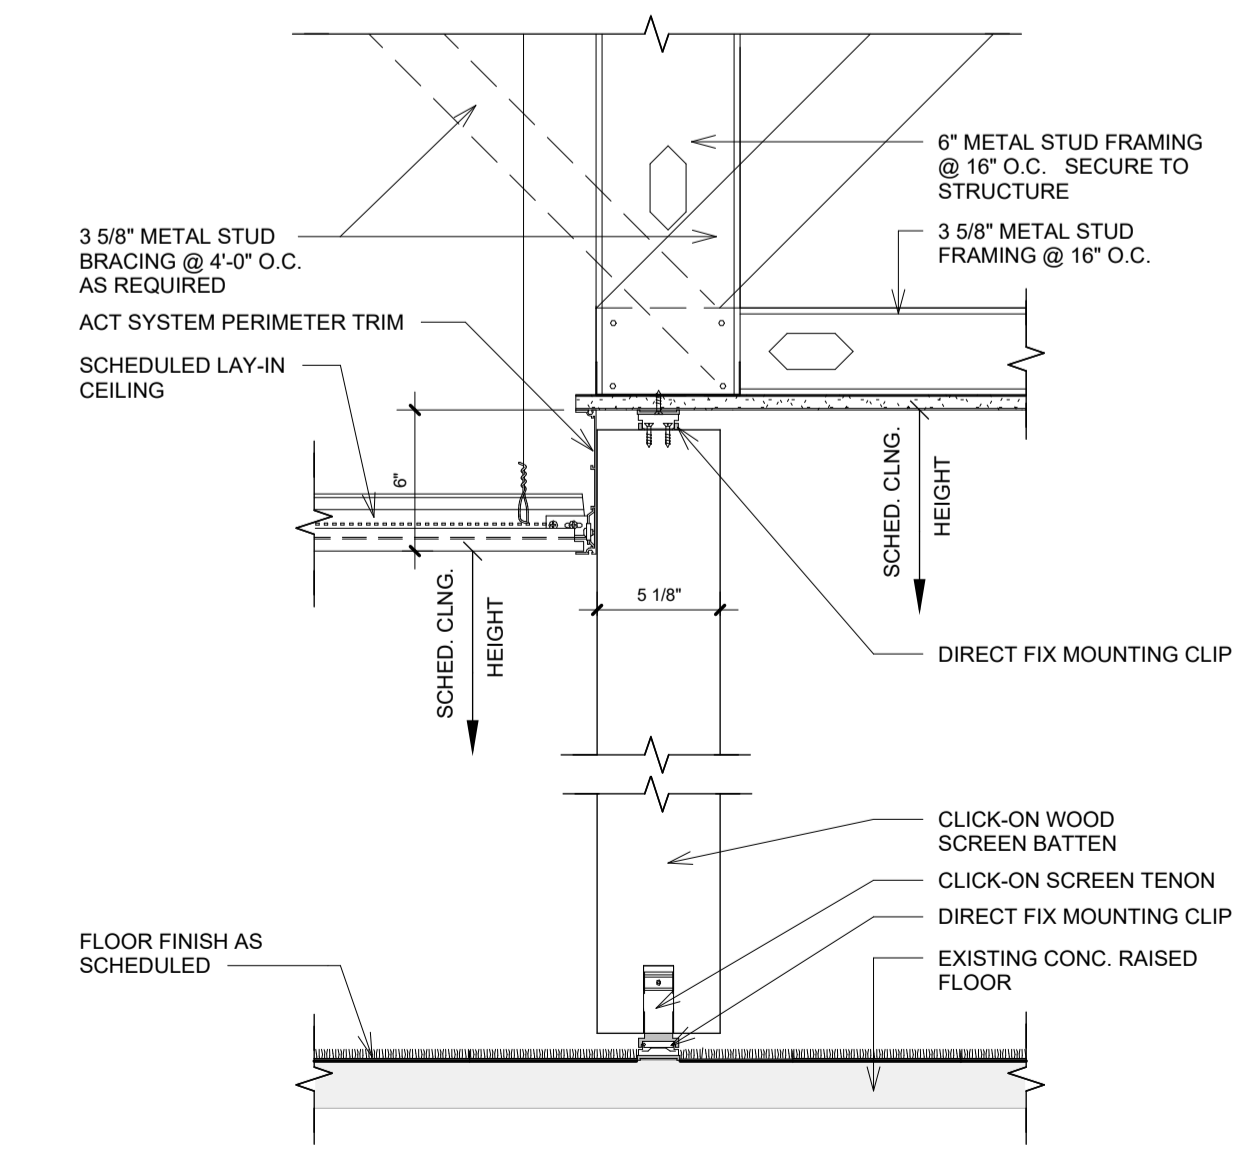

1 WOOD SCREEN DETAIL
A500 / 1 1/2" = 1'-0"

DCFM SEAL

No	Description	Date
1	ADDENDUM 1	12/20/2024



GSCLC
295 CHIPETA WAY
SALT LAKE CITY, UT 84108

22812
10.30.2024


DETAILS

A500
Scale As indicated


**GENETIC SCIENCE
LEARNING CENTER**

CONSTRUCTION DOCUMENTS


19 DUCT PENETRATION AT SOUND WALL
A500 / 3" = 1'-0"

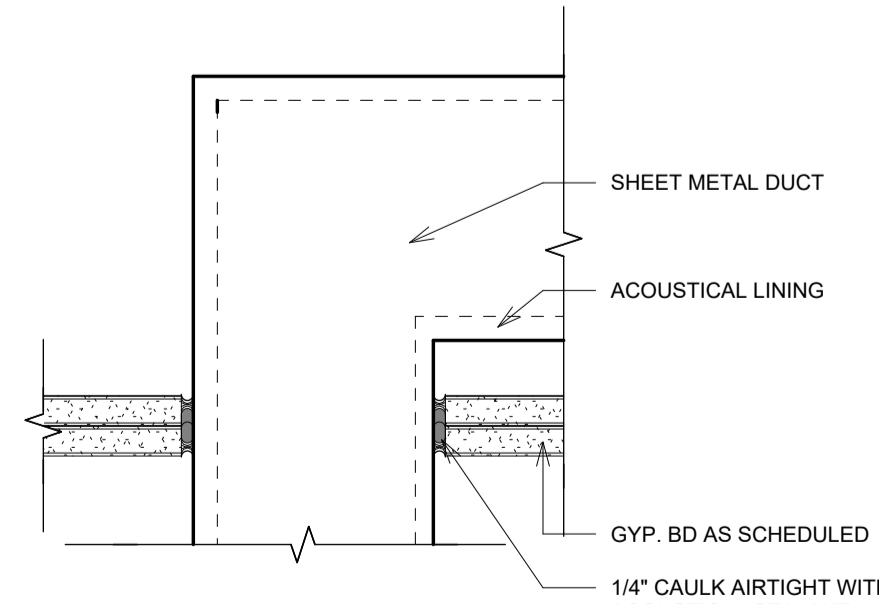


NOTES:
1. FOR CEILING TYPE, SEE PLANS
2. DUCTS WITHIN TEN FEET OF THE CEILING PENETRATION SHALL BE INTERNALLY LINED SHEET METAL

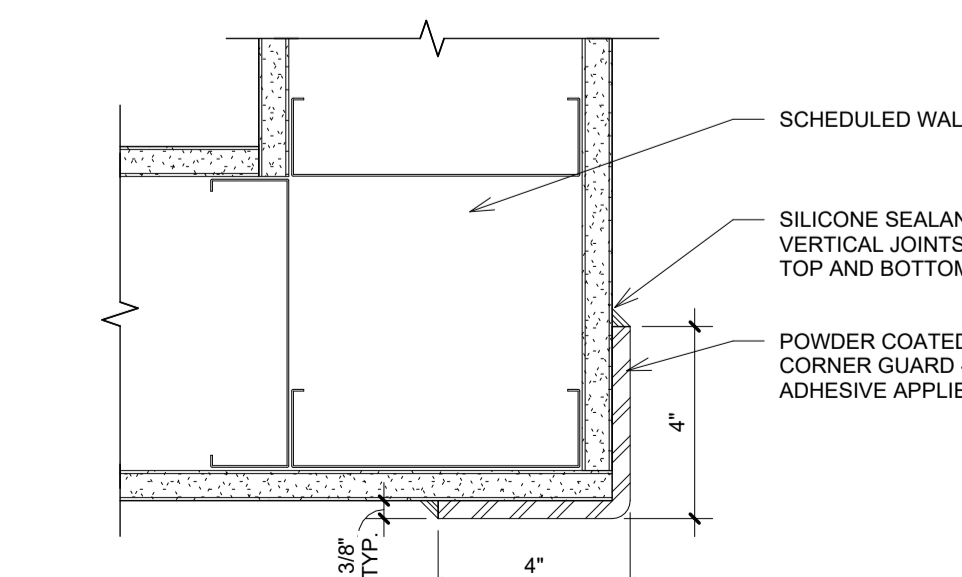


10 STANDARD-CORNER GUARD DETL
A500 / 3" = 1'-0"

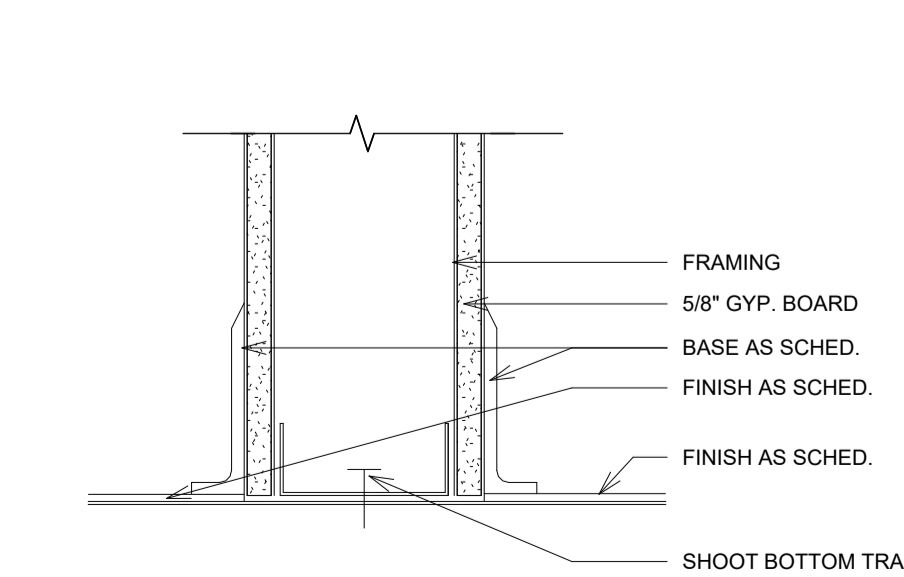


5 TYP. BOTTOM OF WALL
A500 / 3" = 1'-0"

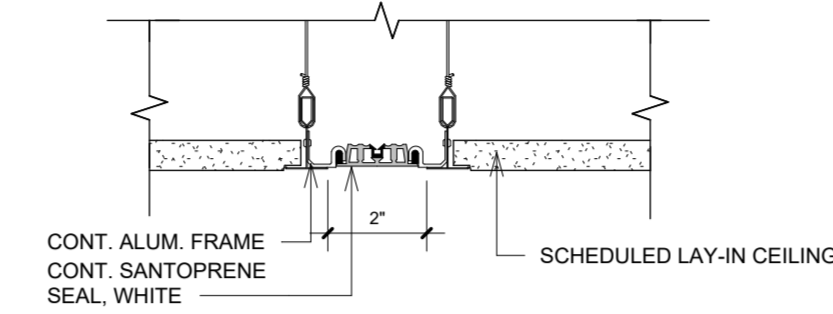


13 ACT CEILING EXPANSION JOINT (GJ1)
A501 3' x 1'-0"

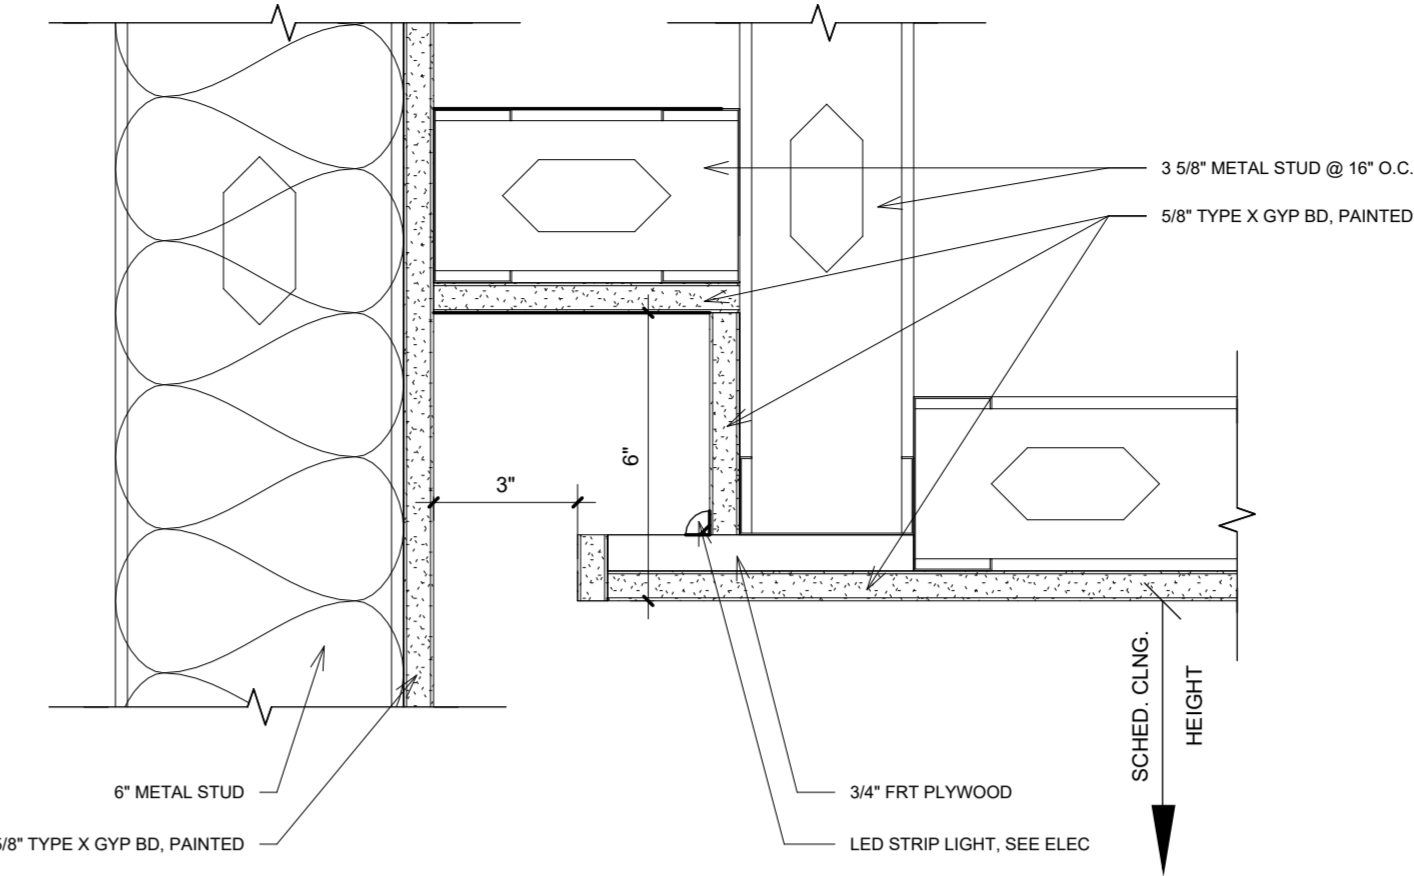


8 MEDIA REVIEW LIGHT COVE
A501 3' x 1'-0"

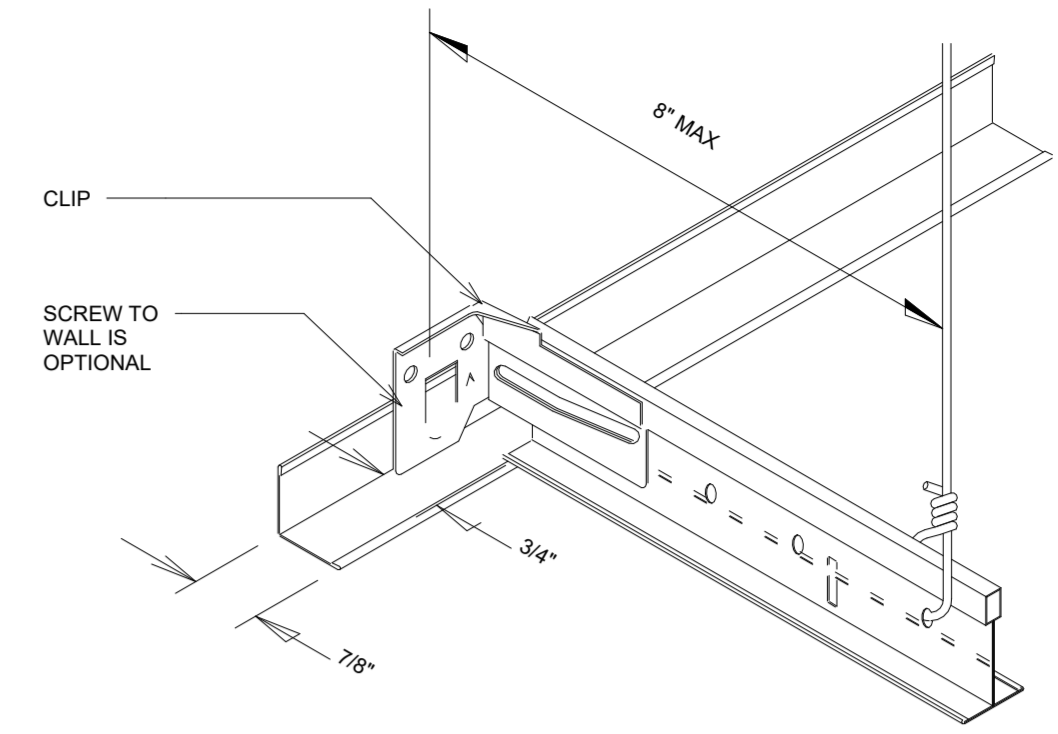


3 SEISMIC CLIP DETAIL
A501 12\" x 1'-0"

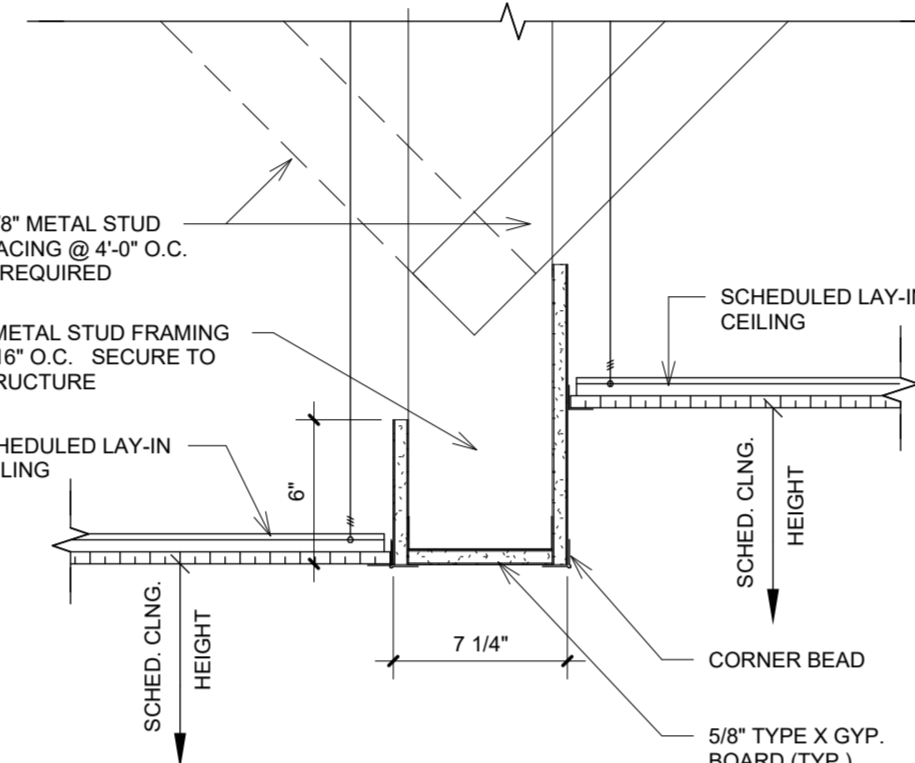

12 SOFFIT DETAIL - ACT / ACT
A501 1 1/2\" x 1'-0"

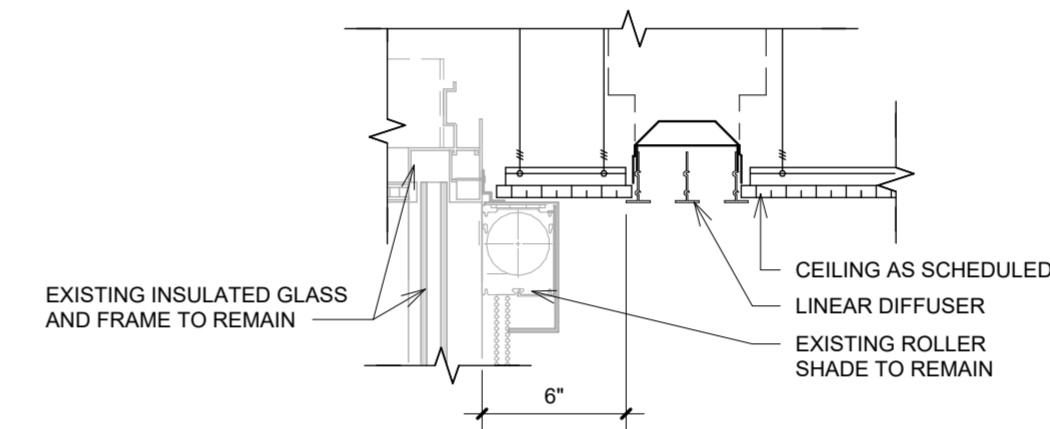


7 LINEAR DIFFUSER AT EXTERIOR STOREFRONT
A501 1 1/2\" x 1'-0"

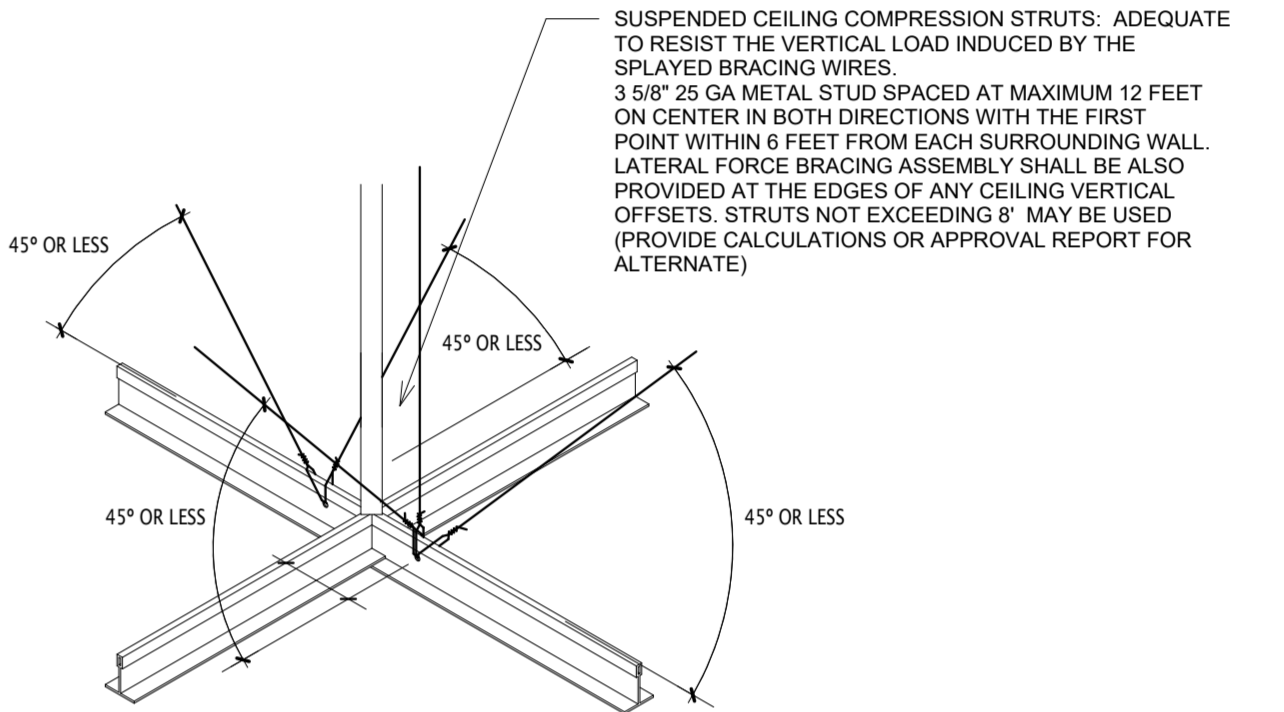


SEISMIC CEILING BRACING NOTES:

1. ALL SPLAY WIRES TO BE IN LINE WITH ATTACHED COMPONENT.
2. ALL SPLAY WIRES TO BE TAUT AND TIED BOTH ENDS WITH MINIMUM OF THREE TURNS IN 1\" OF RUN.
3. COMPLY WITH IBC 2018 - 2506.2.1, CISCA 3-4, ASCE 7 13.5.6 & ASTM C618.
4. SPLAY WIRES SHALL ATTACH TO STRUCTURAL GIRDER OR JOIST ONLY, DO NOT ATTACH TO ROOF DECK.
5. METAL STRUT FASTENED TO THE MAIN RUNNER SHALL BE EXTENDED TO AND FASTENED TO THE STRUCTURAL MEMBERS SUPPORTING THE ROOF OR FLOOR ABOVE. THE STRUT SHALL BE ADEQUATE TO RESIST THE VERTICAL COMPONENT INDUCED BY THE BRACING WIRES.
6. ALL LIGHT FIXTURES SHALL BE POSITIVELY ATTACHED TO THE SUSPENDED CEILING SYSTEM WHEN HEAVY SYSTEMS ARE USED. ATTACH NO. 12 GAGE HANGERS TO THE GRID MEMBERS WITHIN 3\" OF EACH CORNER OF EACH FIXTURE. LIGHT FIXTURES WEIGHING LESS THAN 50 LBS. SHALL HAVE TWO NO. 12 GAGE HANGERS CONNECTED FROM THE FIXTURE HOUSING TO THE STRUCTURE ABOVE. COMPLY WITH IBC STANDARDS.
7. ALL LIGHT FIXTURES SHALL BE POSITIVELY ATTACHED TO THE SUSPENDED CEILING SYSTEM WHEN HEAVY SYSTEMS ARE USED. ATTACH NO. 12 GAGE HANGERS TO THE GRID MEMBERS WITHIN 3\" OF EACH CORNER OF EACH FIXTURE. LIGHT FIXTURES WEIGHING LESS THAN 50 LBS. SHALL HAVE TWO NO. 12 GAGE HANGERS CONNECTED FROM THE FIXTURE HOUSING TO THE STRUCTURE ABOVE. COMPLY WITH IBC STANDARDS.
8. CEILING MOUNTED AIR TERMINALS WEIGHING LESS THAN 20 LBS. SHALL BE POSITIVELY ATTACHED TO THE CEILING. SUSPENSION MAIN RUNNERS, TERMINALS OR SERVICES WEIGHING 20 LBS. BUT NOT MORE THAN 50 LBS. SHALL IN ADDITION HAVE TWO NO. 12 GAGE HANGERS CONNECTED TO THE CEILING SYSTEM HANGERS OR TO THE STRUCTURE ABOVE. TERMINALS OR SERVICES WEIGHING MORE THAN 50 LBS. SHALL BE SUPPORTED DIRECTLY FROM THE STRUCTURE ABOVE BY APPROVED HANGERS. COMPLY WITH IBC STANDARDS.

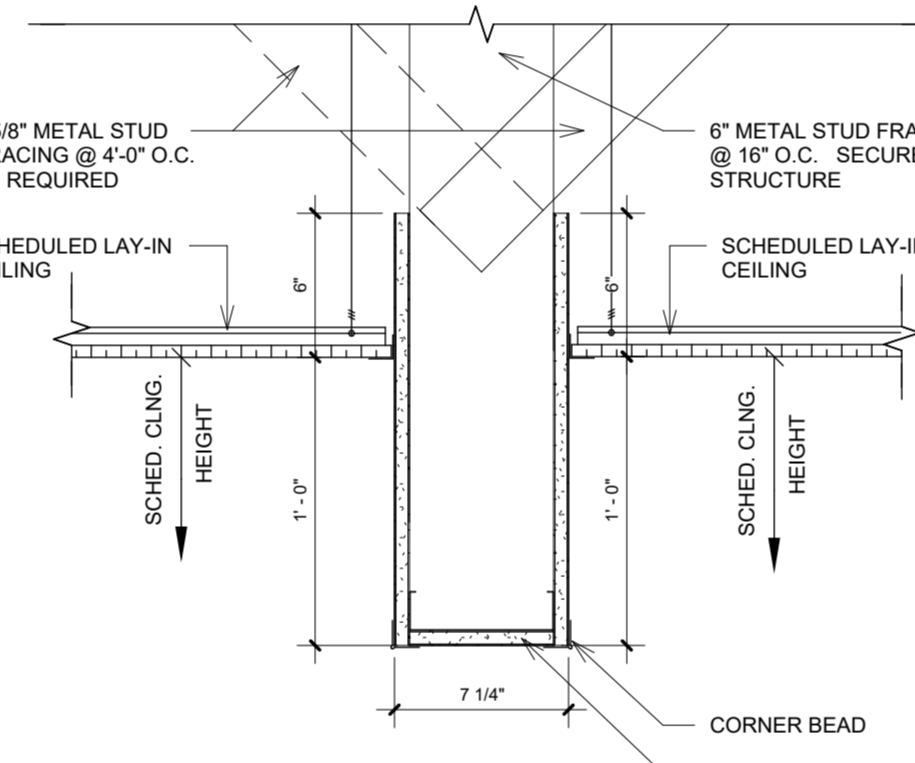


11 SOFFIT DETAIL - ACT / ACT
A501 1 1/2\" x 1'-0"

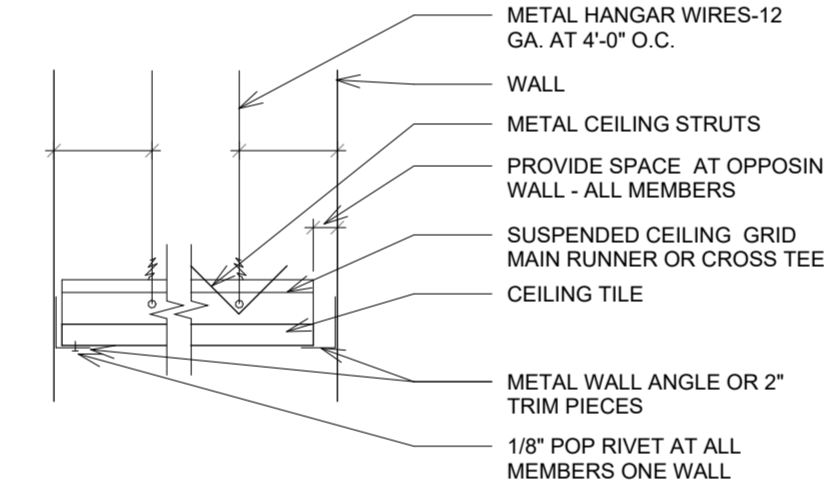


6 SEISMIC BRACING DETAIL
A501 3' x 1'-0"


2 SEISMIC CEILING BRACING
A501 1 1/2\" x 1'-0"

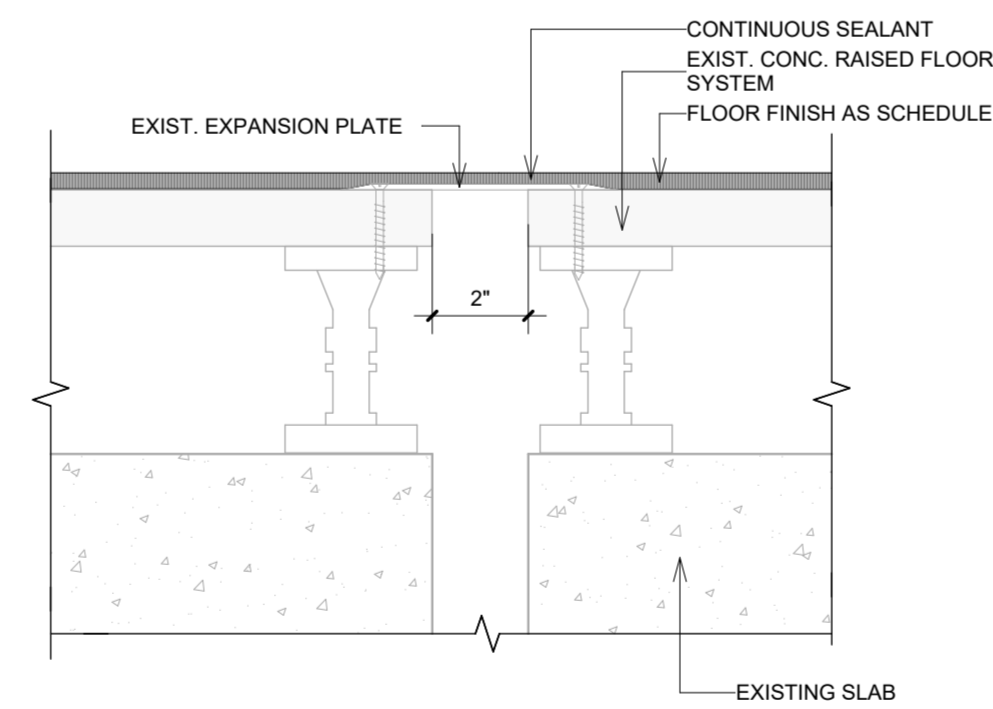


10 FLOOR EXPANSION JOINT (FJ1)
A501 3' x 1'-0"

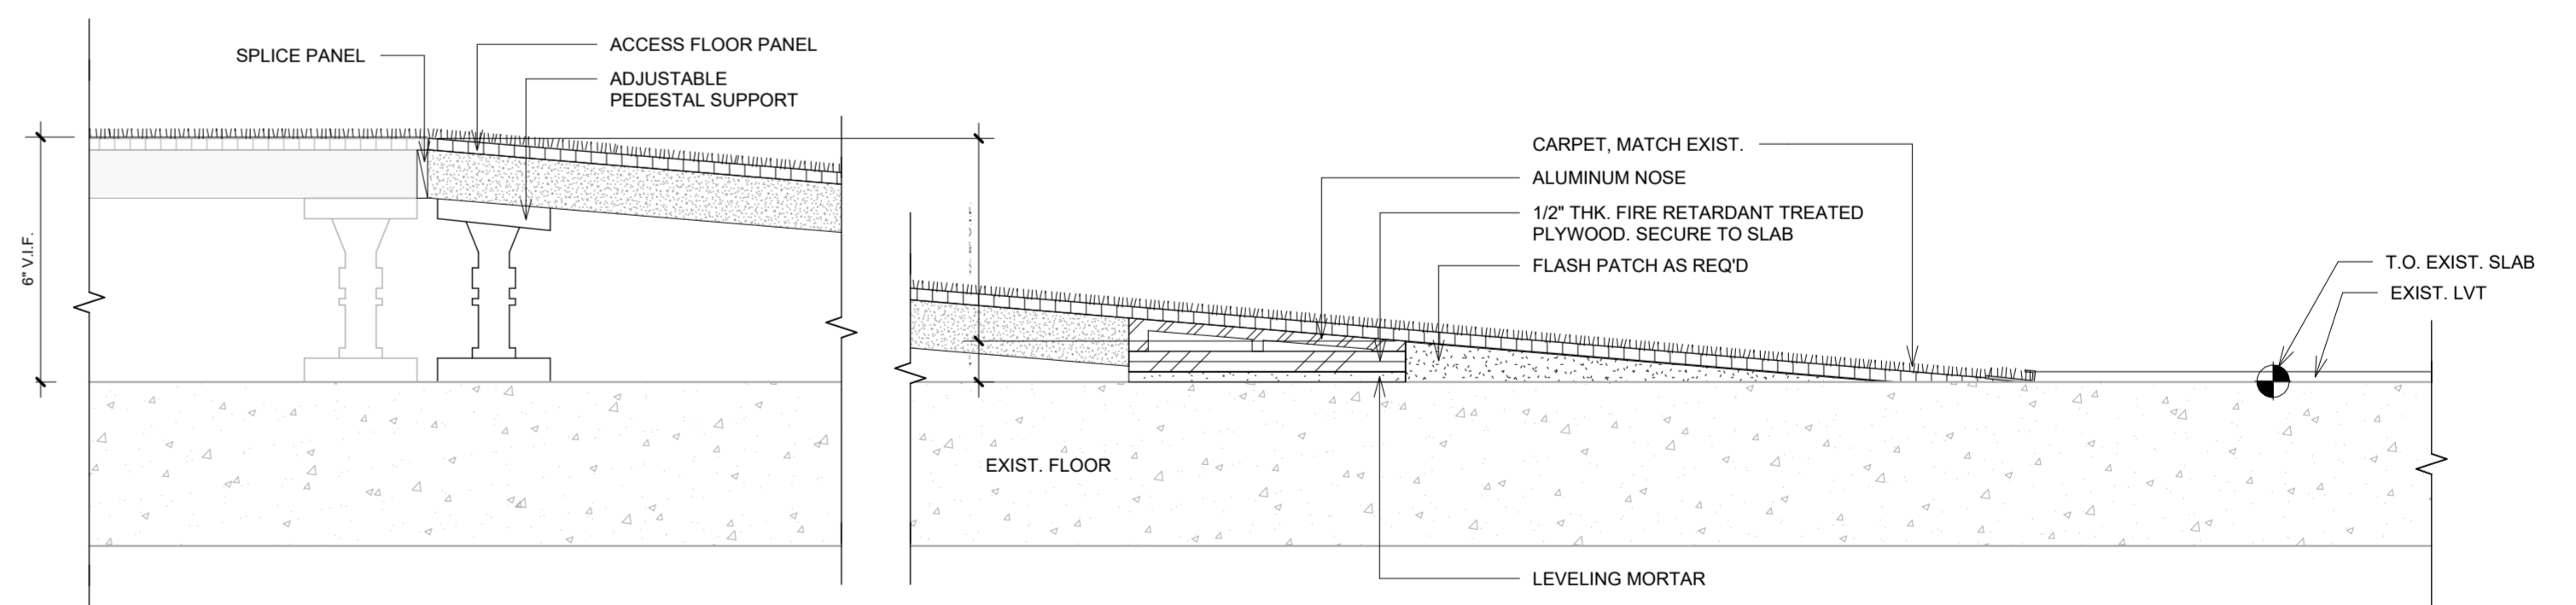


5 RAMP DETAIL
A501 3' x 1'-0"

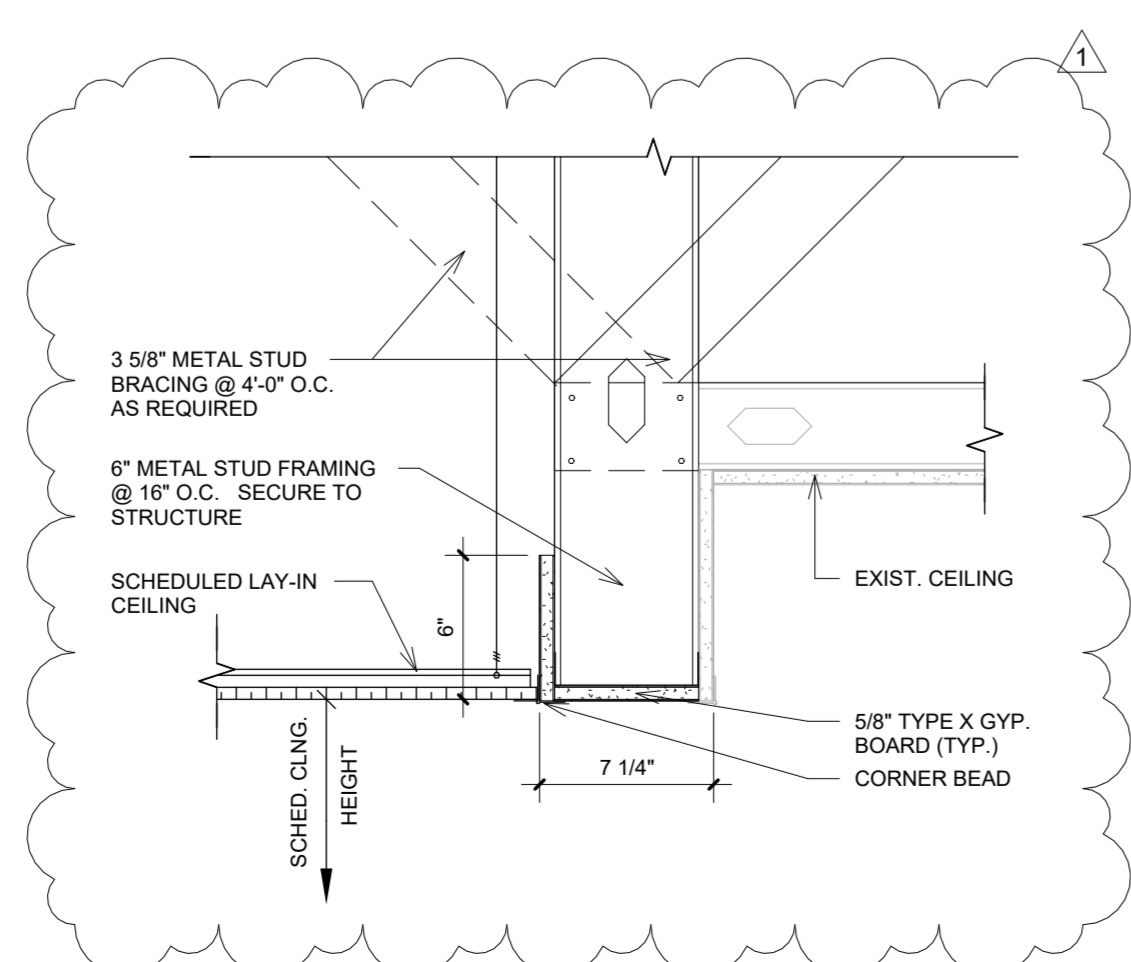


14 SOFFIT DETAIL - ACT / GYP
A501 1 1/2\" x 1'-0"

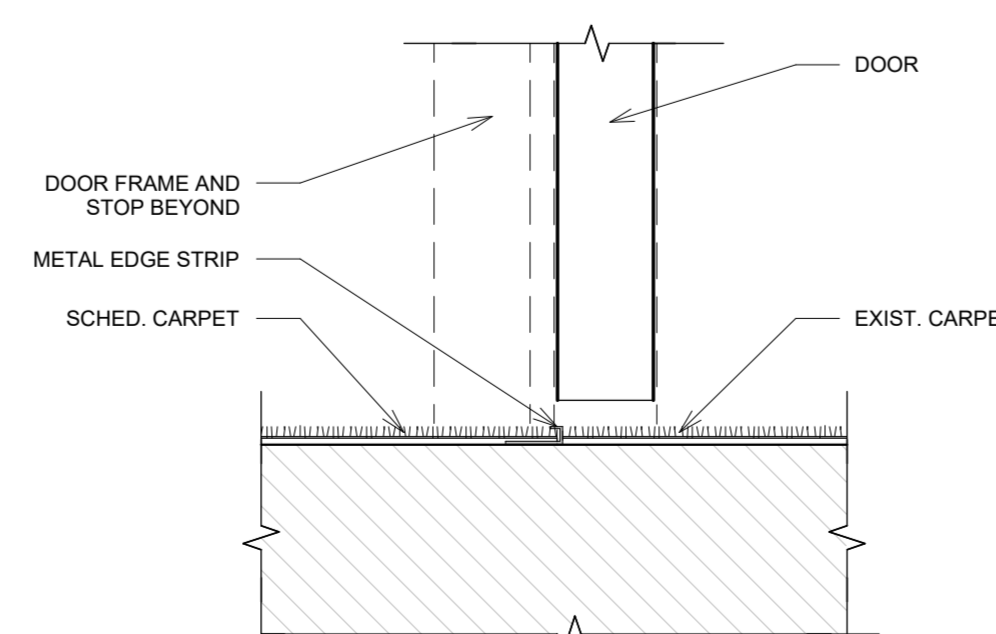

9 CARPET - EXISTING CARPET @ DOOR
A501 3' x 1'-0"

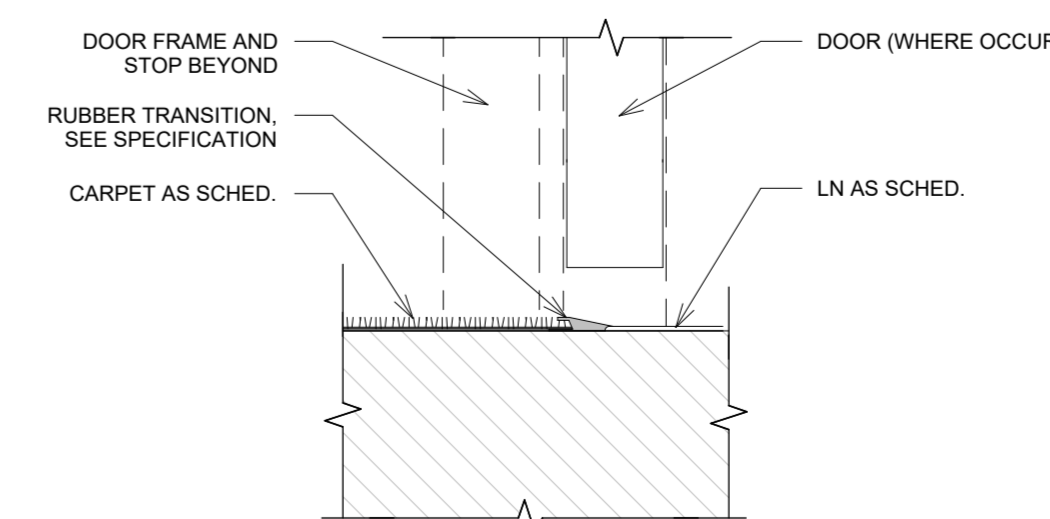

4 CARPET - LN @ DOOR
A501 3' x 1'-0"

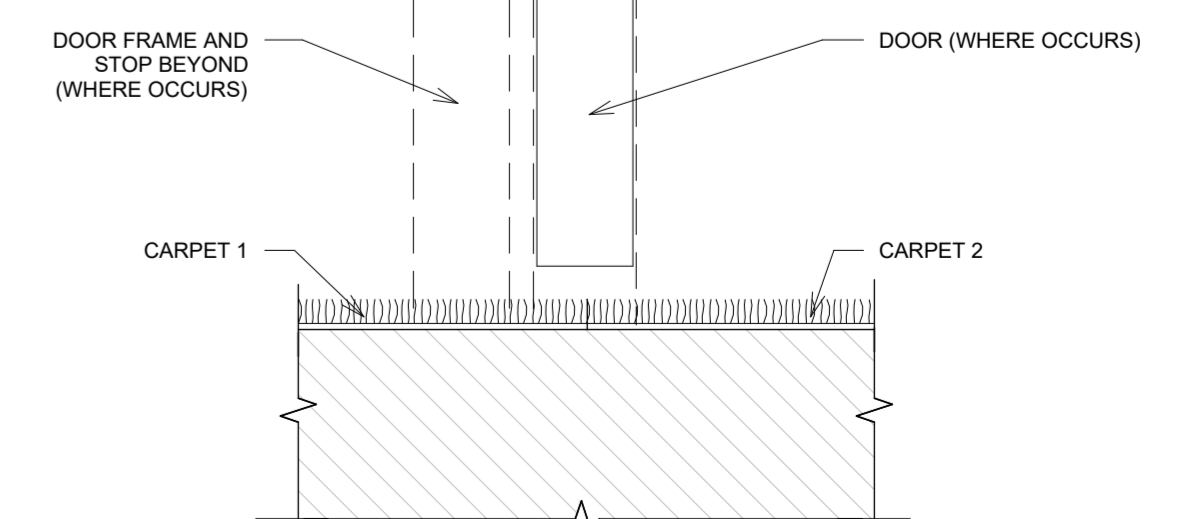

1 CARPET - CARPET @ DOOR
A501 3' x 1'-0"

No	Description	Date
1	ADDENDUM 1	12/20/2024



CONSTRUCTION DOCUMENTS

295 CHIPETA WAY
SALT LAKE CITY, UT 84108

22735
10.30.2024

FLOOR + CEILING DETAILS


A501

Scale As indicated

ELEV. LEGEND

- P1 = PAINT, COLOR: 7568 WESTHIGHLAND WHITE
- P2 = PAINT, COLOR: 6484 LAKESHORE
- F1 = FELT, COLOR: GREEN
- F2 = FELT, COLOR: PINK
- F3 = FELT, COLOR: PURPLE
- F4 = FELT, COLOR: ORANGE
- RP1 = RESIN PANEL, COLOR: KILT + WHITE OUT
- L1 = LAMINATE, COLOR: AGED ASH
- L2 = LAMINATE, COLOR: HUNTER GREEN
- TL1 = LAMINATE TEXTURED PANEL, FINISH: FILA, SALINAS OAK
- TF1 = FELT TEXTURED PANEL, FINISH: BOLLA, MIDNIGHT
- WS1 = WOOD SCREEN, SPECIES/FINISH: AMERICAN OAK / NATURAL
- SS1 = SOLID SURFACE COUNTERTOP, COLOR: FROSTY WHITE MIRAGE
- UP1 = UPHOLSTERY, COLOR: NICO 016 POSH
- RB1 = RUBBER BASE, COLOR: TQ2 SHARK FIN
- RB2 = RUBBER BASE, COLOR: GREY WG
- GW1 = GLASS WALL, SEE SPEC.
- GW2 = GLASS WALL, SEE SPEC.
- MB1 = MARKER BOARD 47X6, SEE SPEC.
- TD = TOWEL DISPENSER BY OWNER, PROVIDE BLOCKING IN WALLS
- SD = SOAP DISPENSER BY OWNER, PROVIDE BLOCKING IN WALLS

331 S RIO GRANDE ST
SUITE 307
S.L.C. UT 84101
PH: 8017395569
BAYLEE@STUDIOARCH.COM

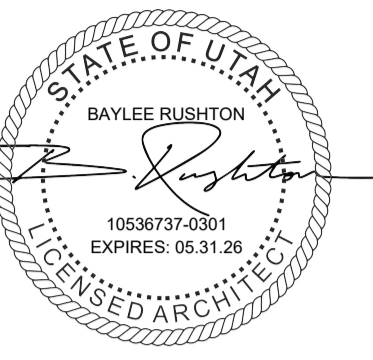

**GENETIC SCIENCE
LEARNING CENTER**

CONSTRUCTION DOCUMENTS

DFCM SEAL

No	Description	Date
1	ADDENDUM 1	12/20/2024







GSCLC
296 CHIPETA WAY
SALT LAKE CITY, UT 84108

22812
10.30.2024


MILLWORK

A515


Scale As indicated

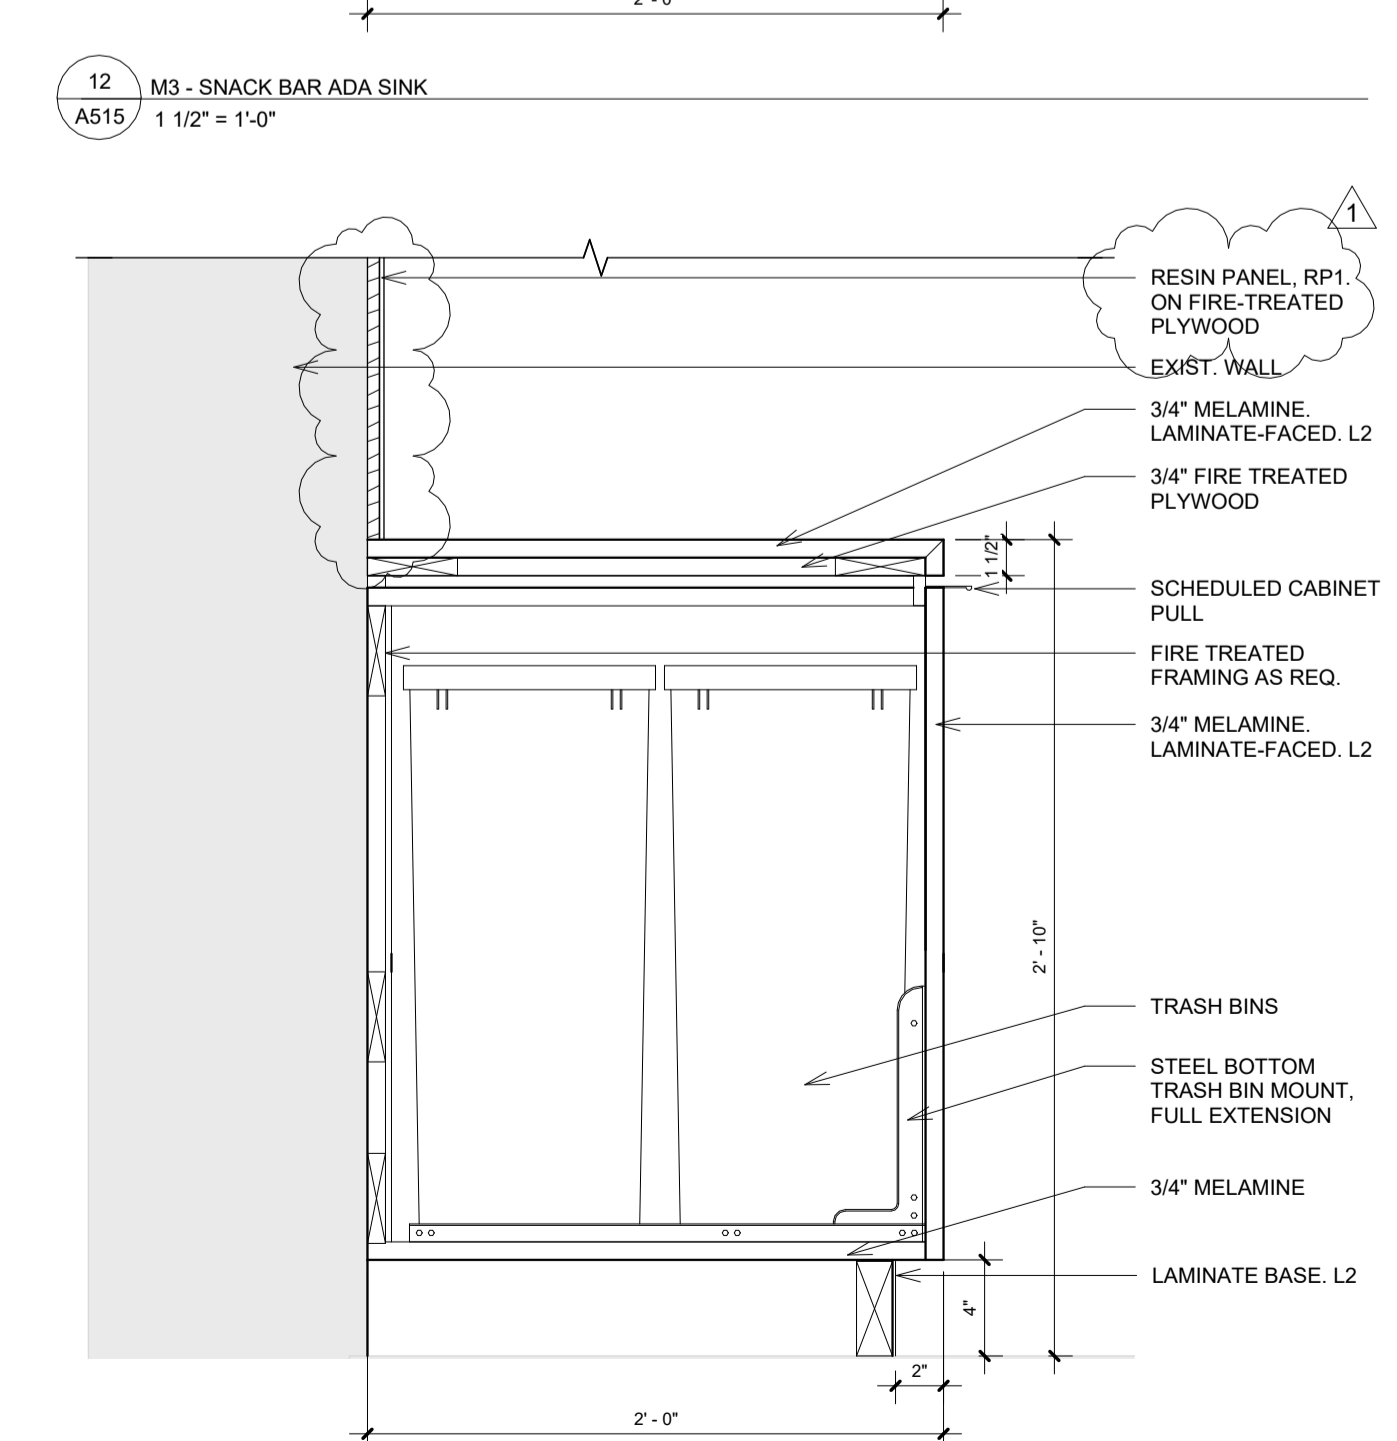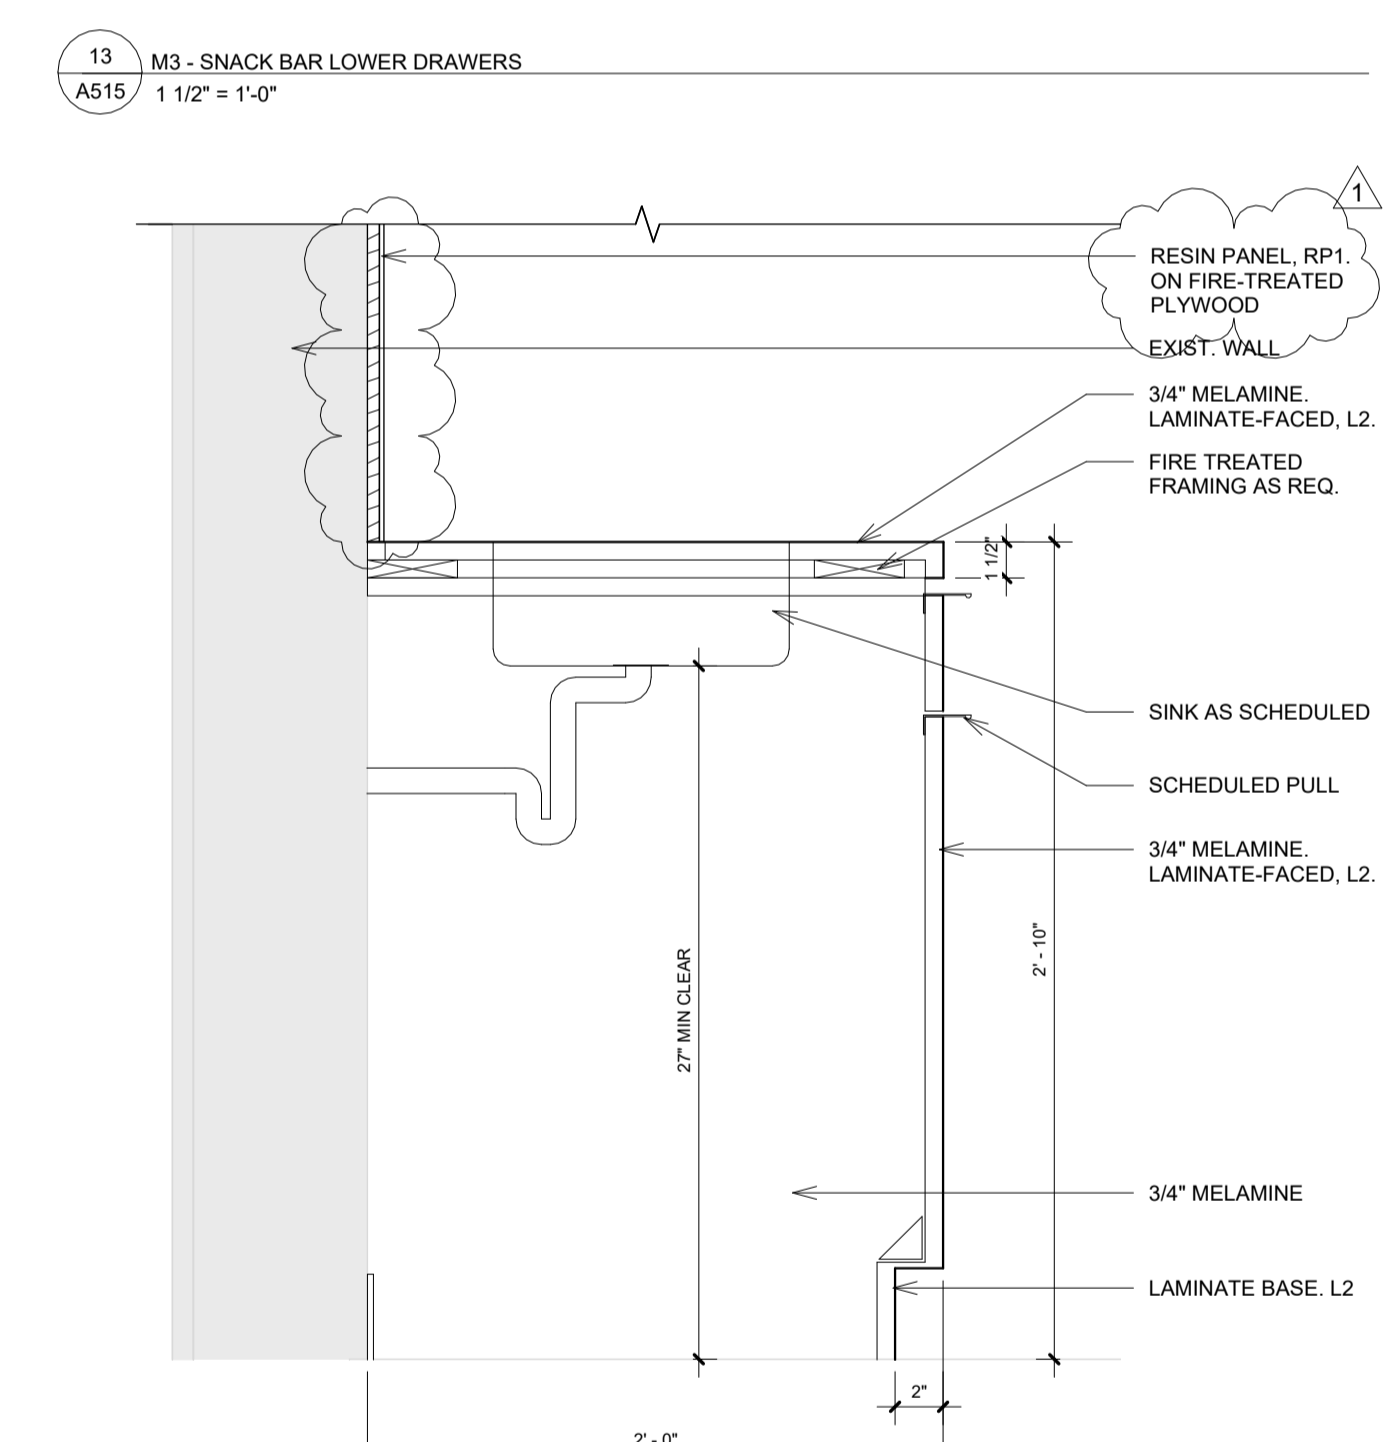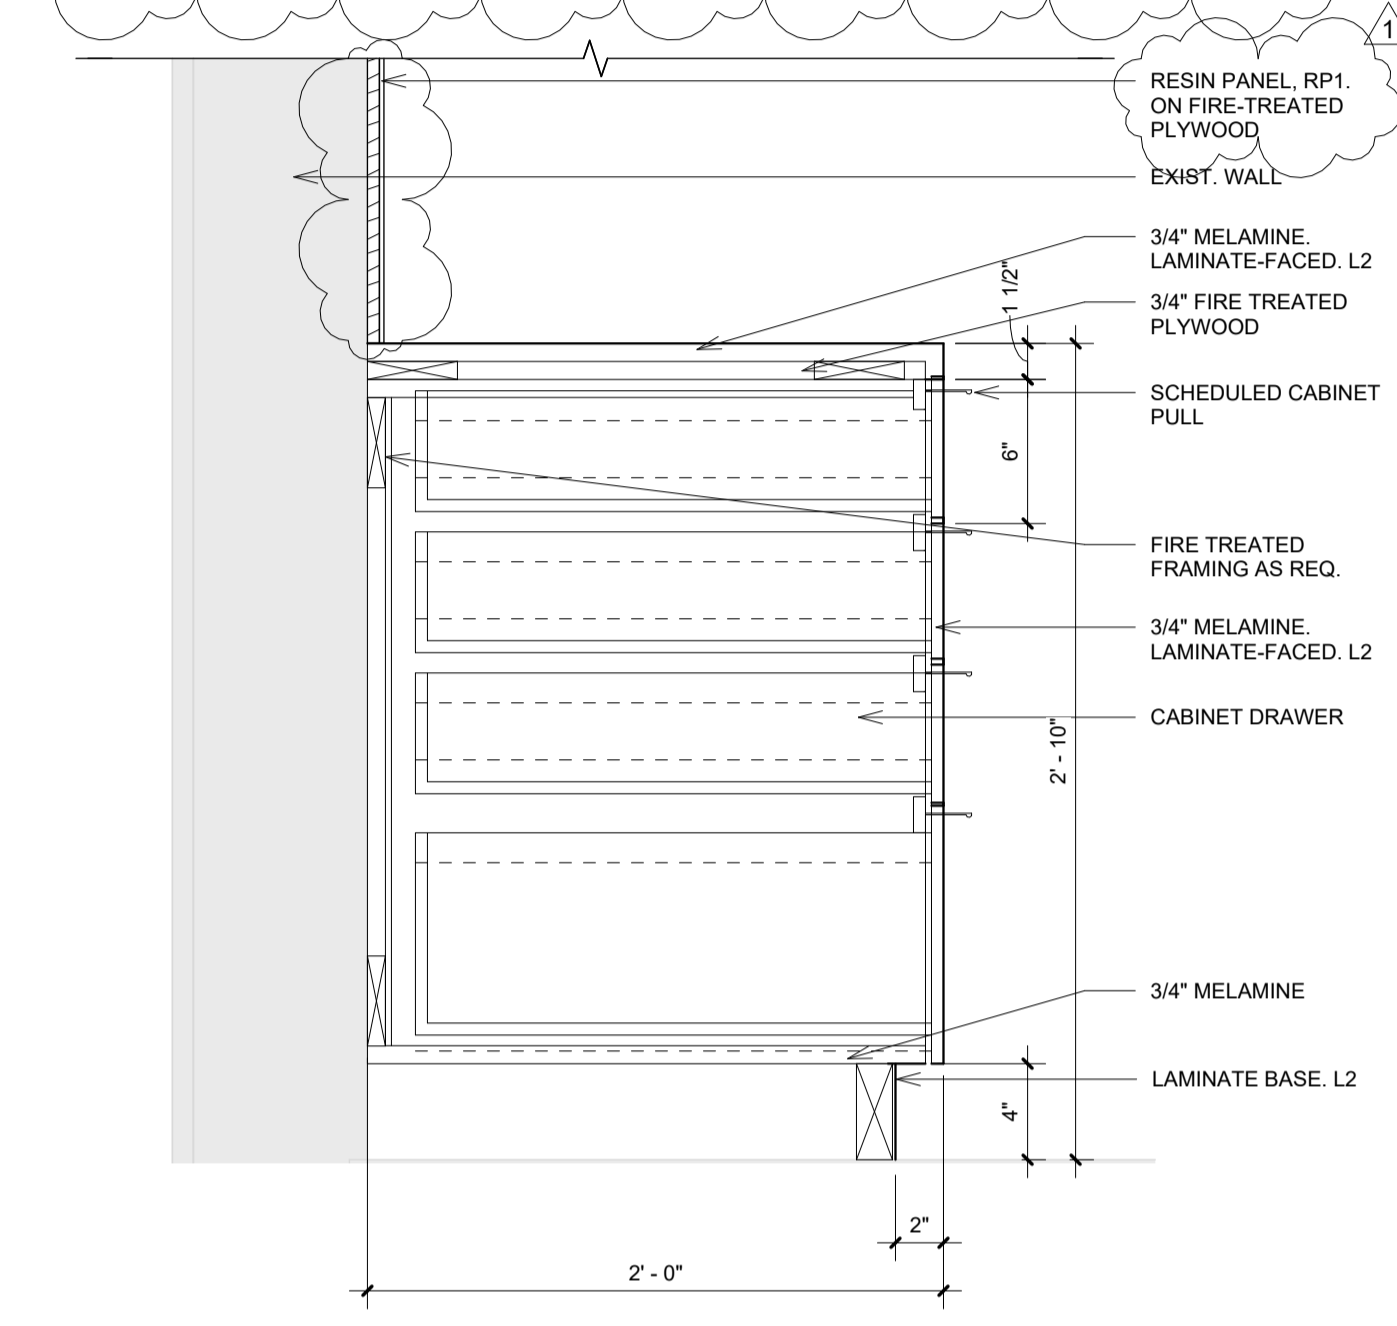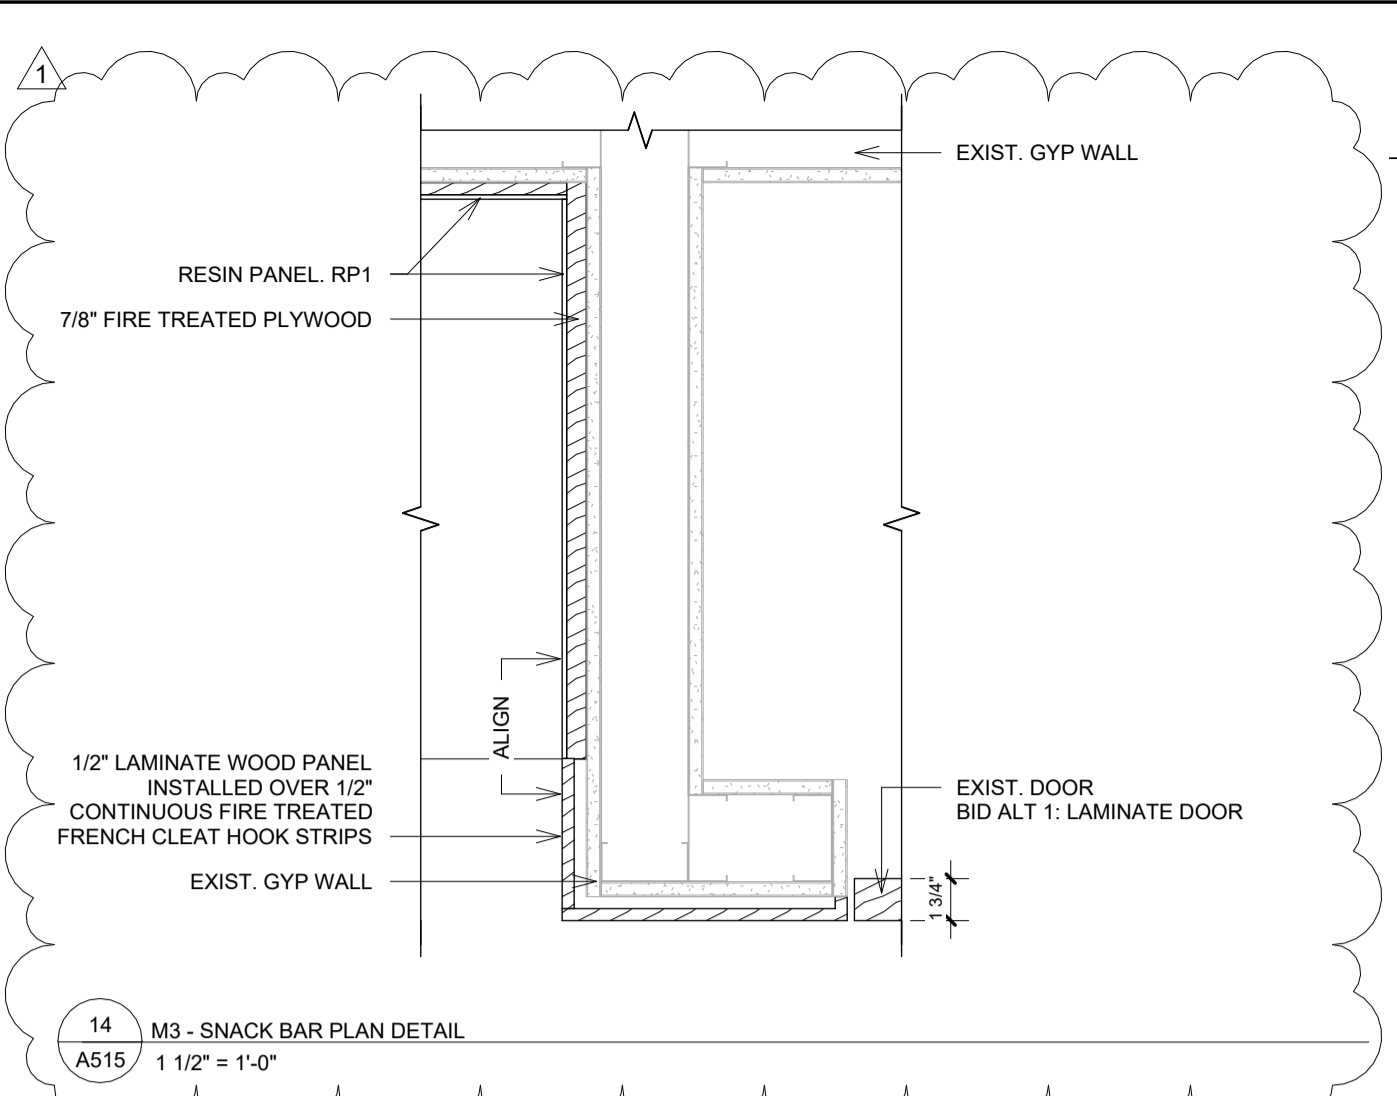


11 M3 - SNACK BAR TRASH DRAWER
A515 1/2" = 1'-0"

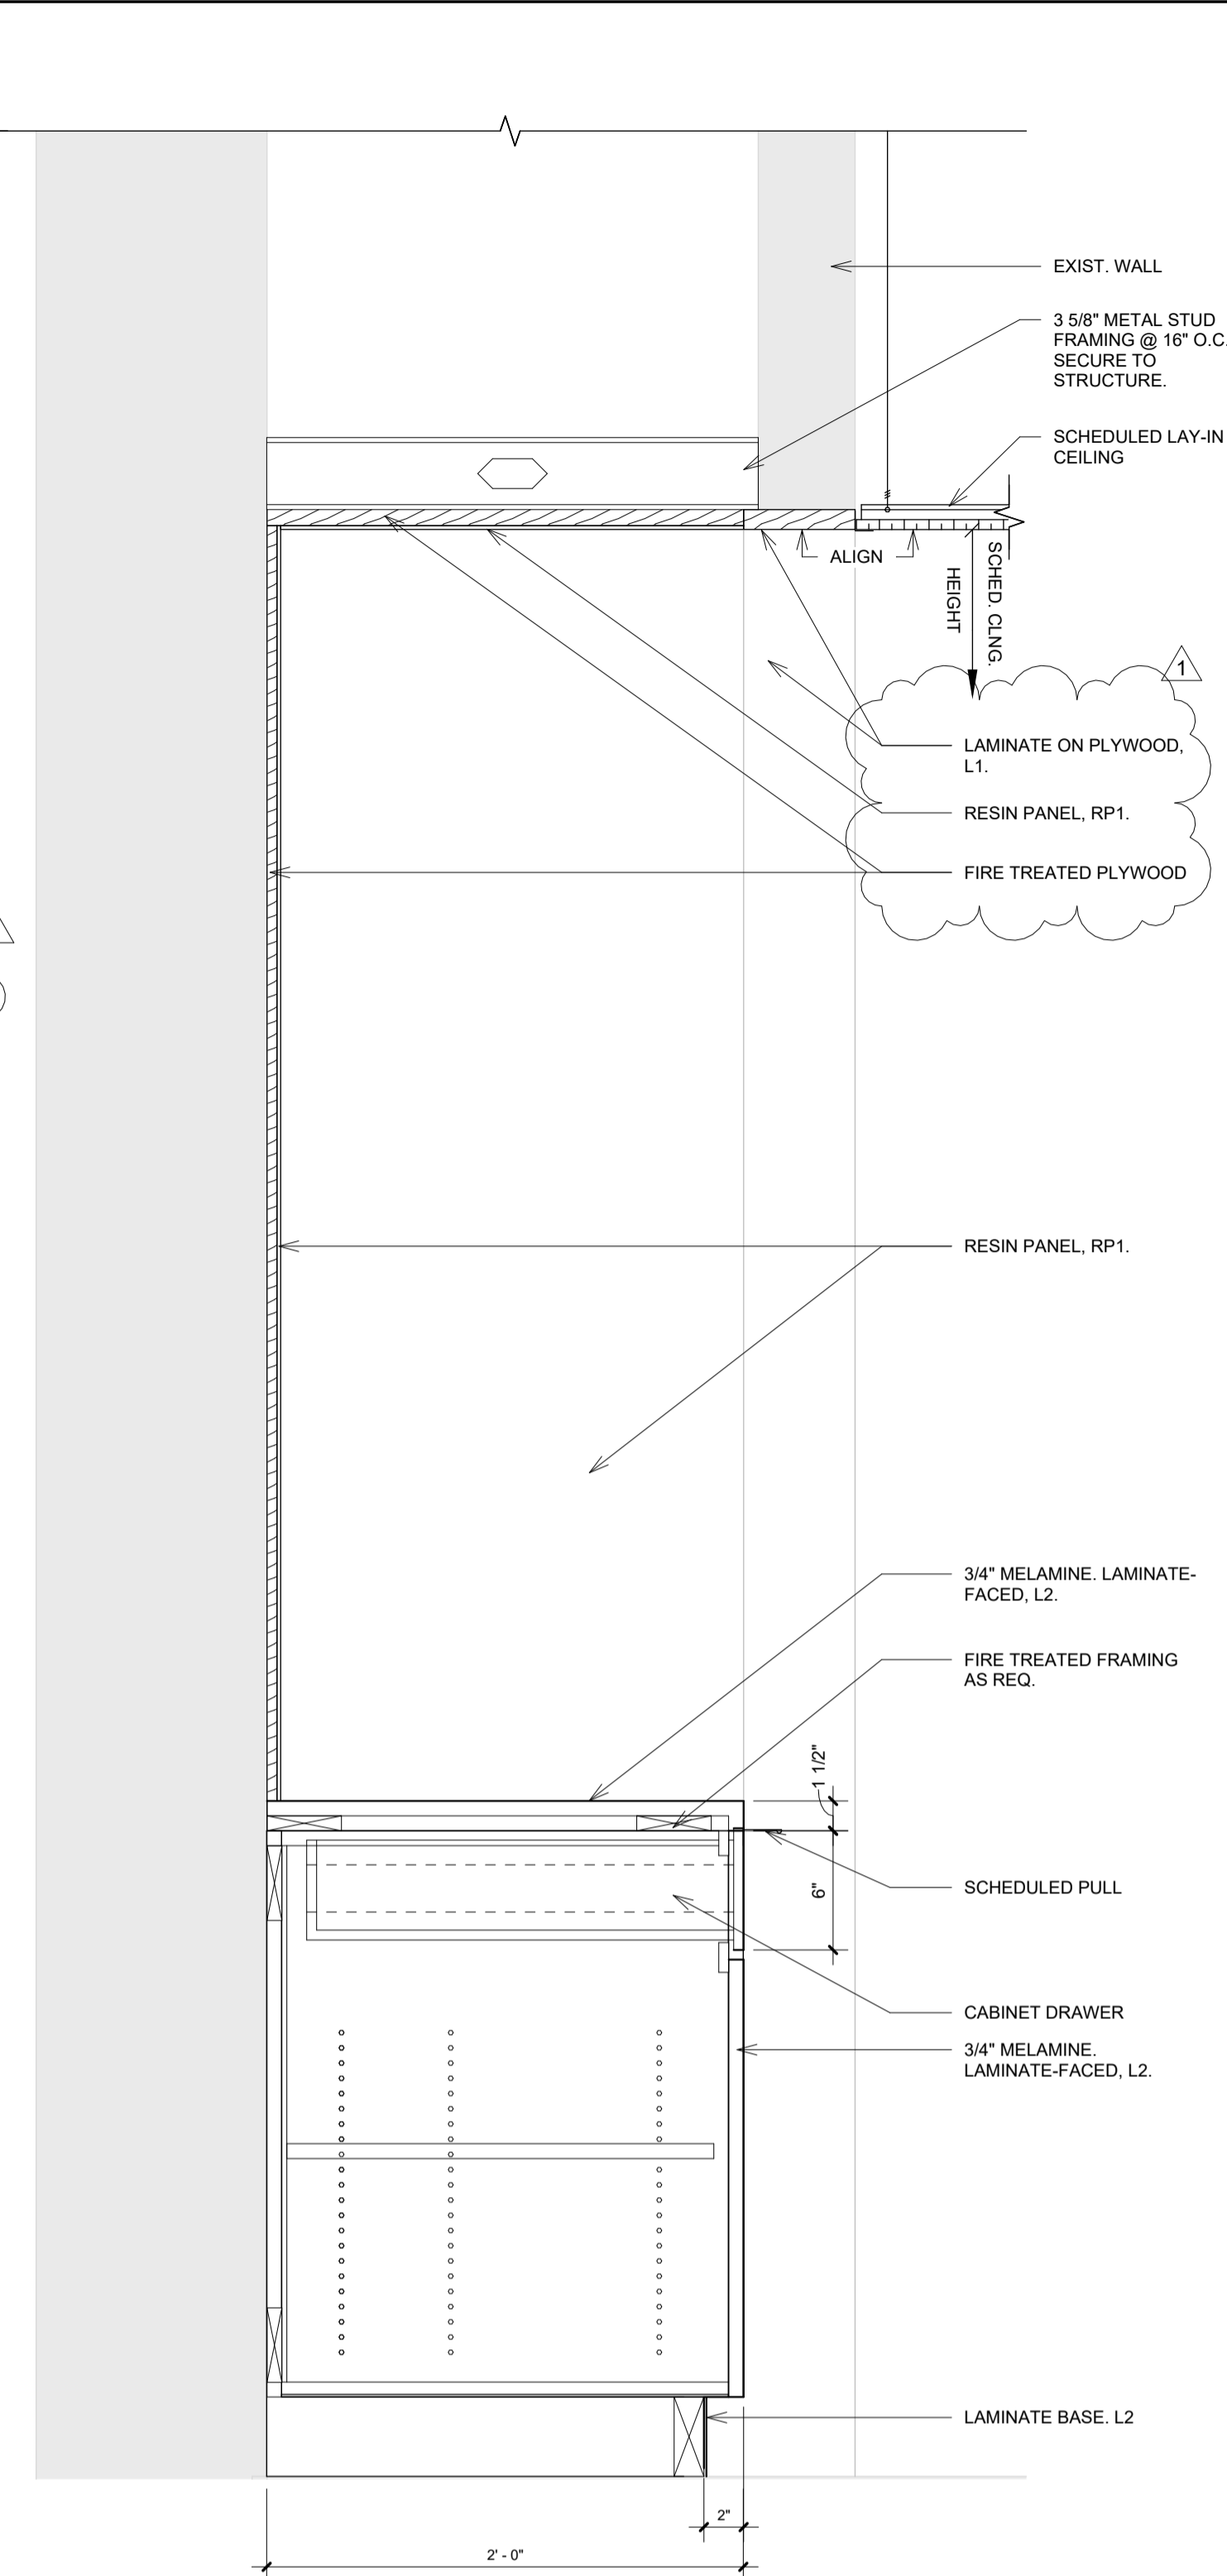


8 M3 - SNACK BAR CABINET AND CEILING DETAIL
A515 1/2" = 1'-0"

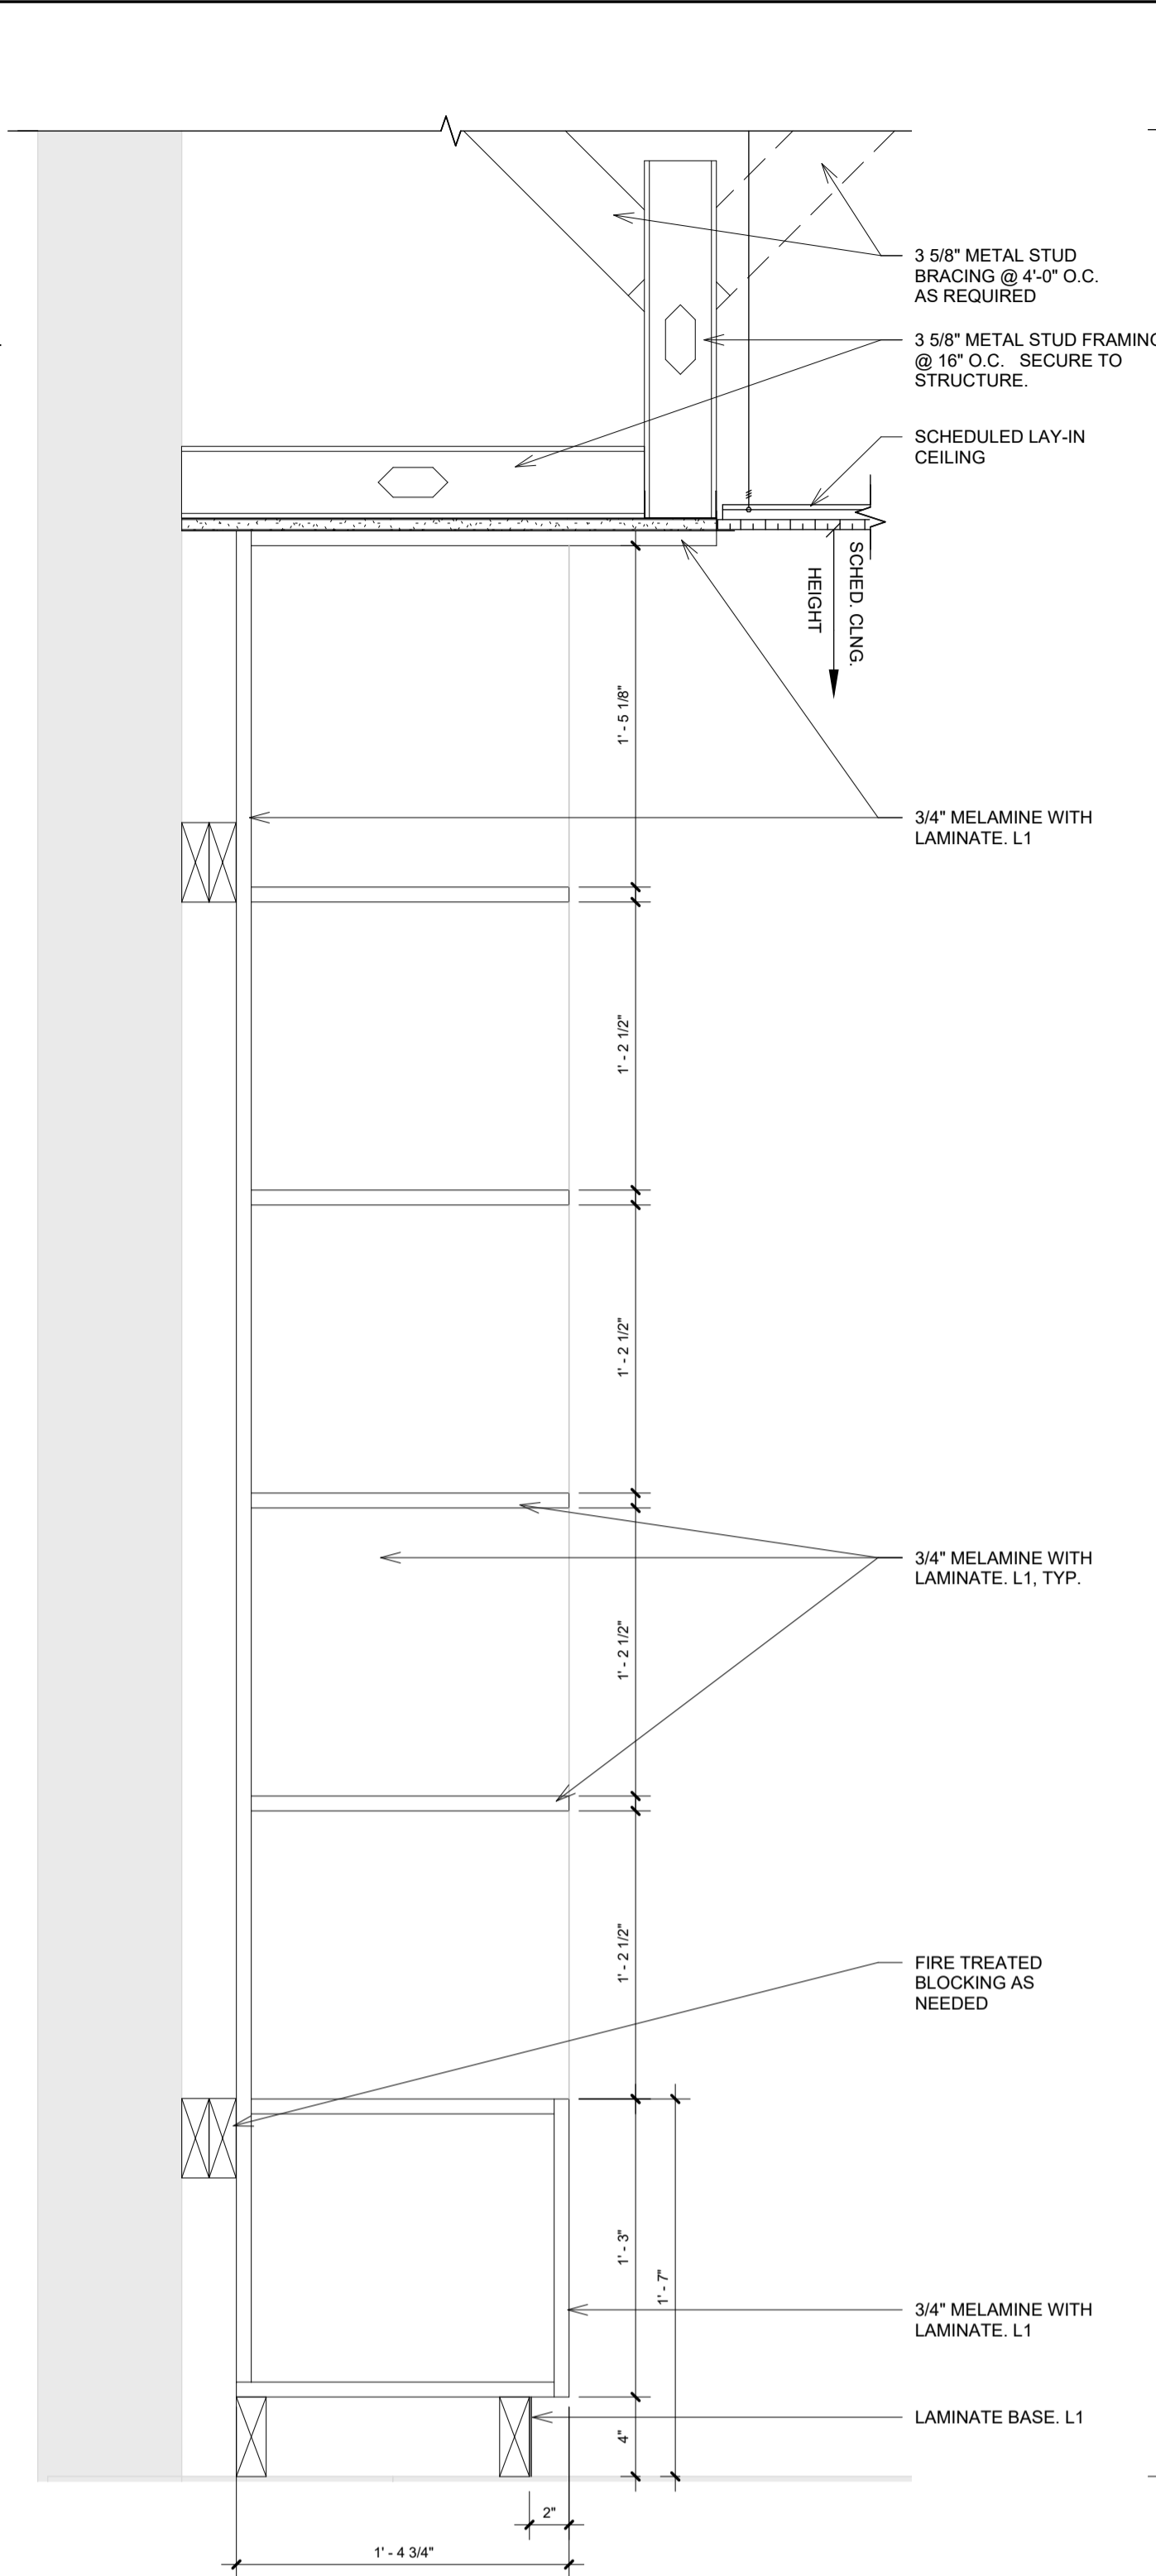


7 M2 - ENTRY SHELVES
A515 1/2" = 1'-0"

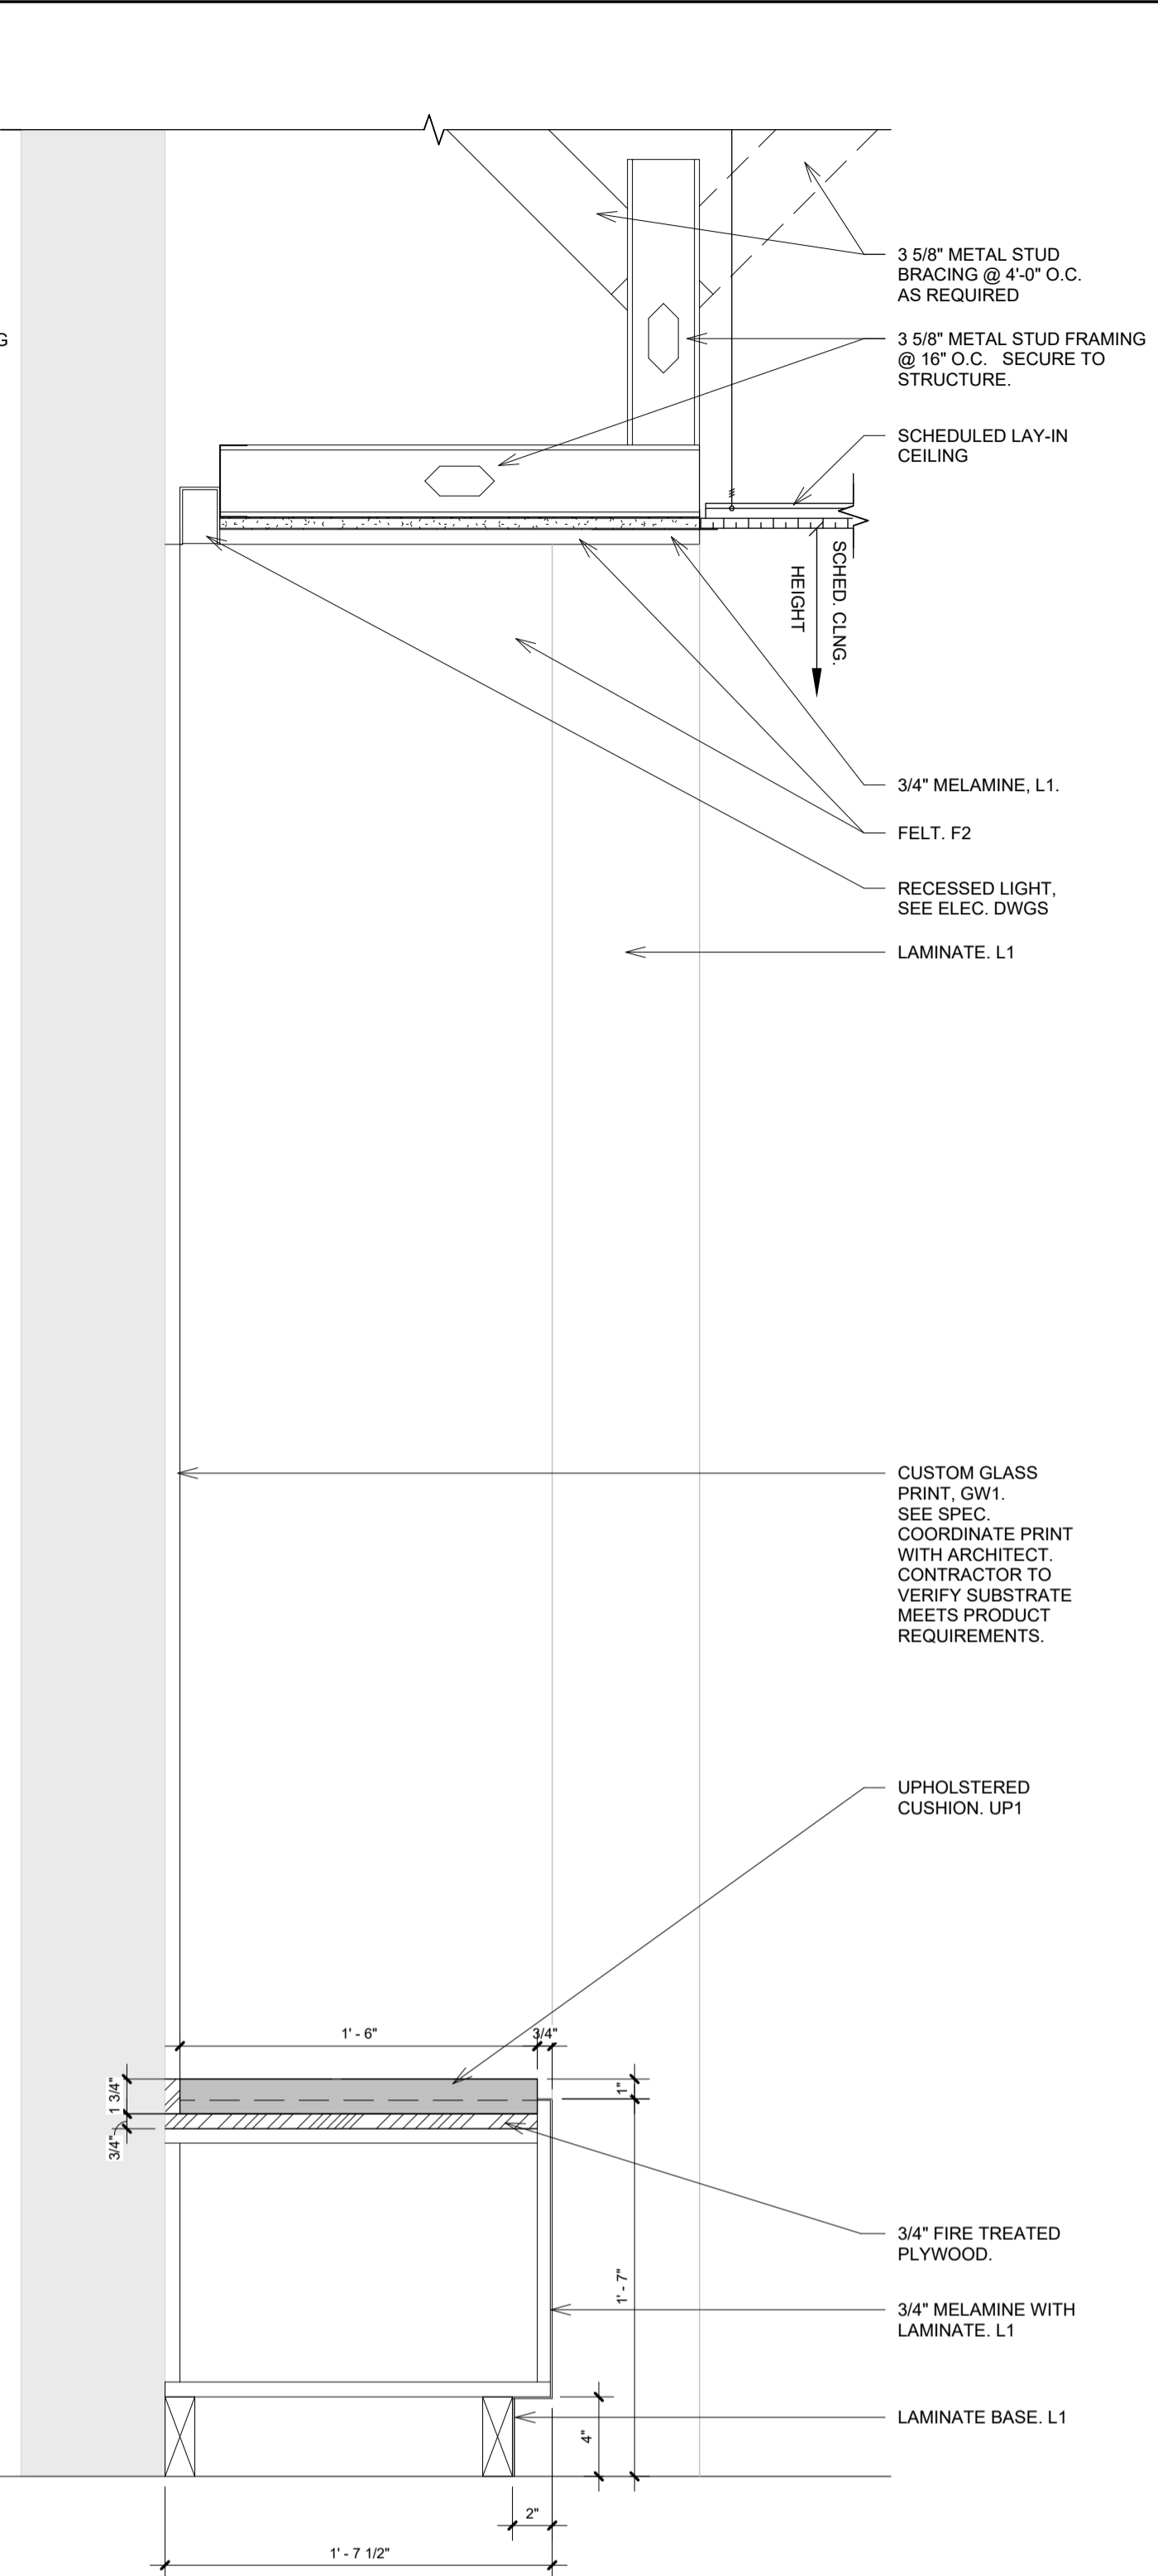


6 M2 - ENTRY BENCH
A515 1/2" = 1'-0"

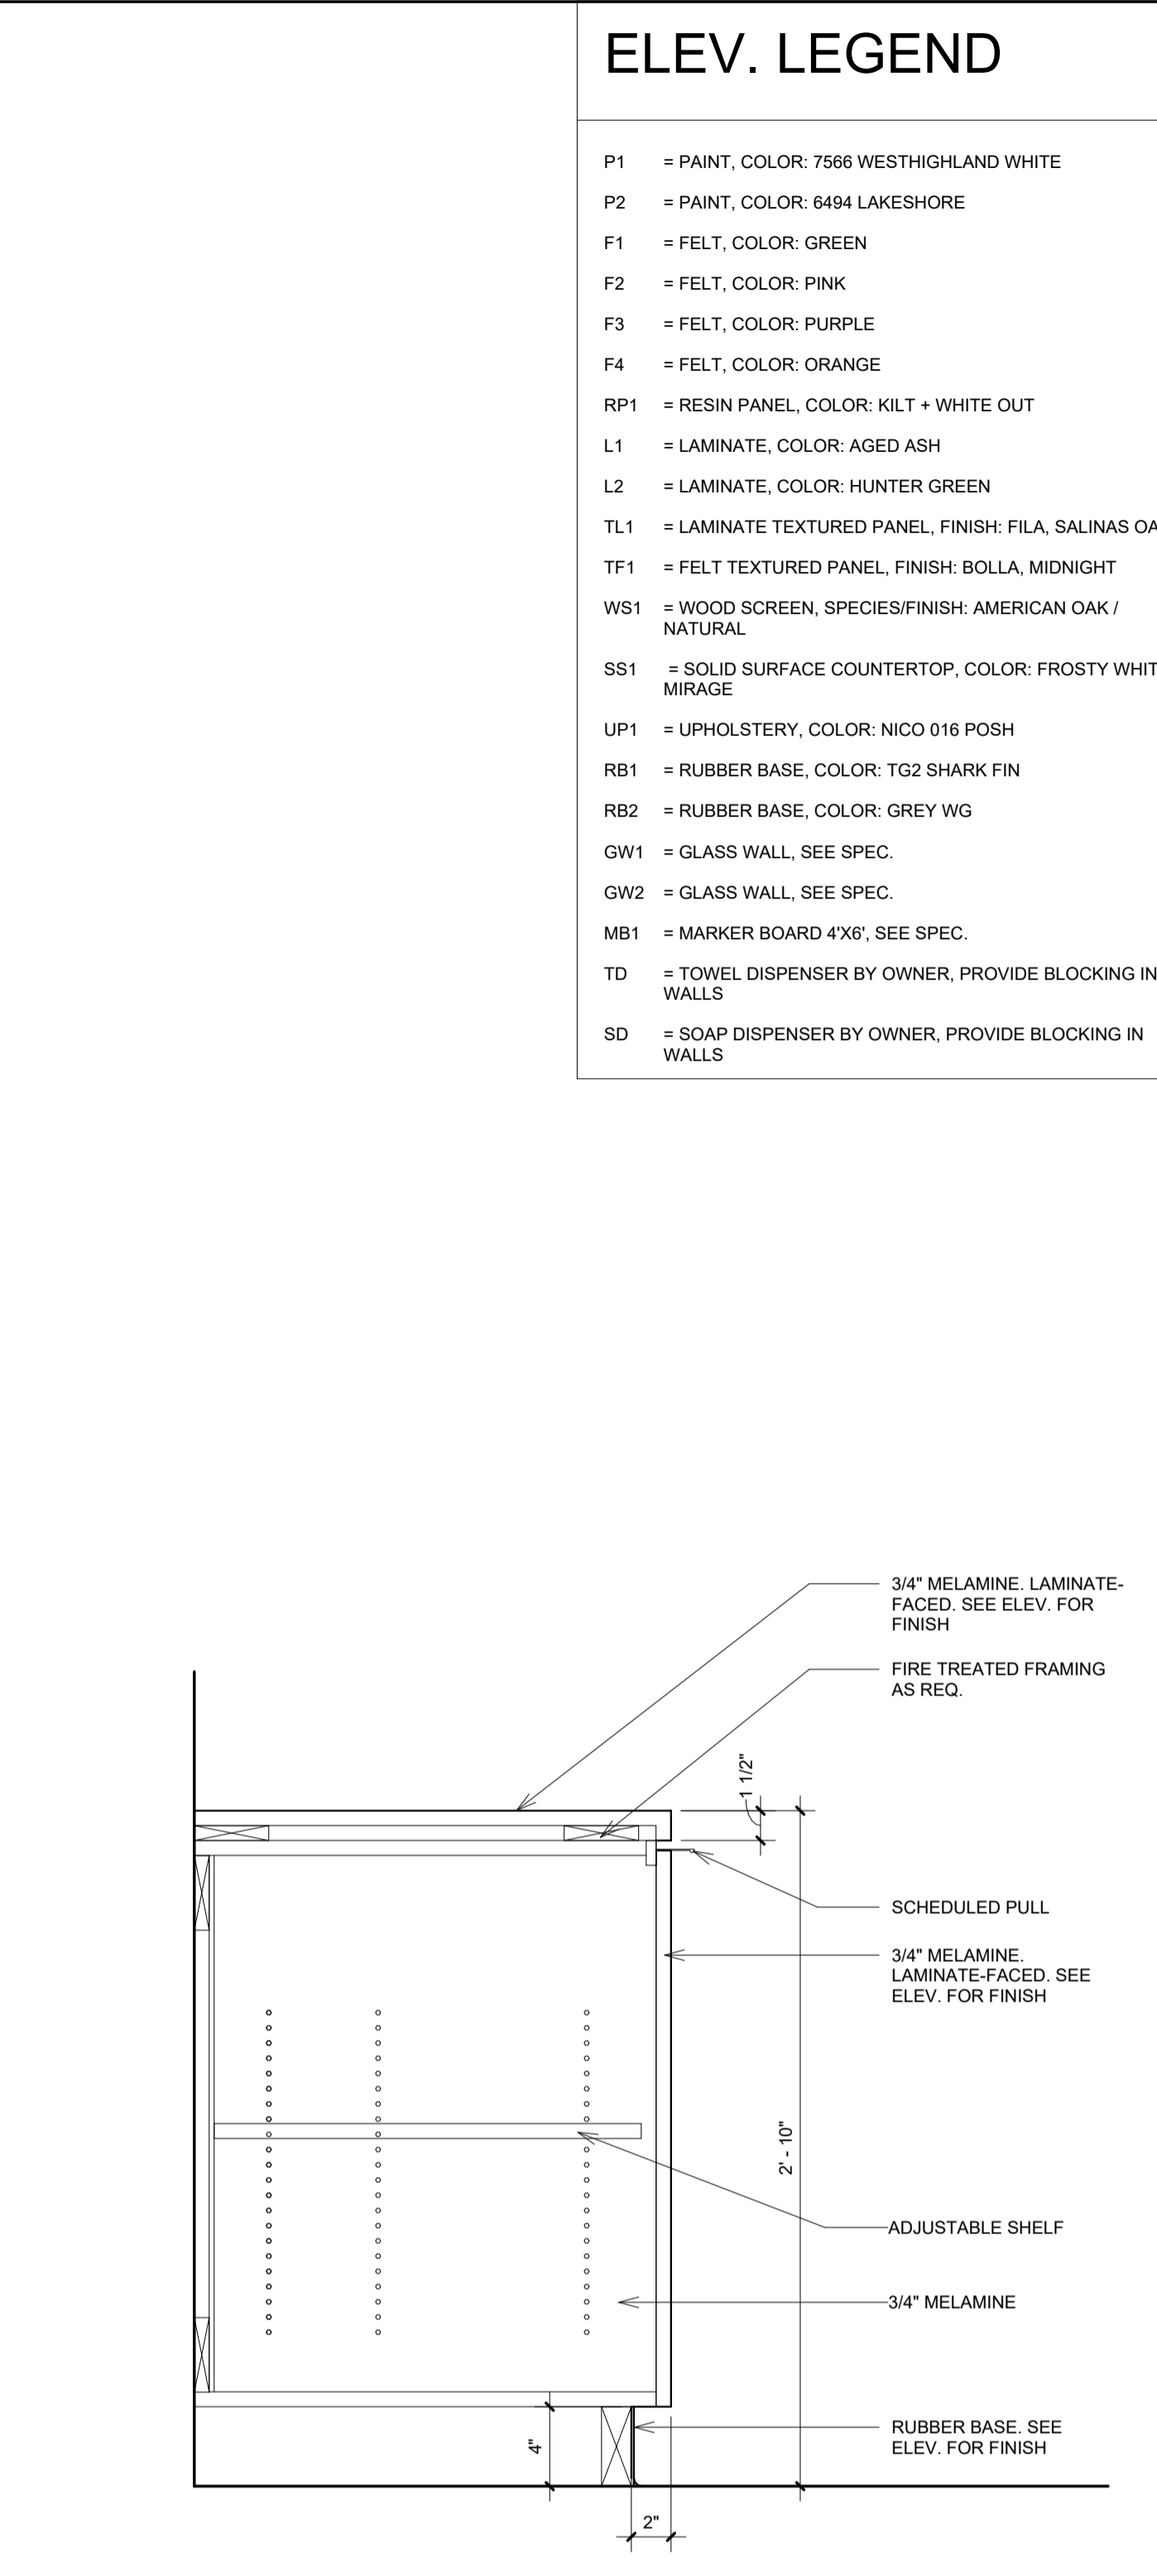


3 LOWER CABINET WIDRAWER
A515 1/2" = 1'-0"

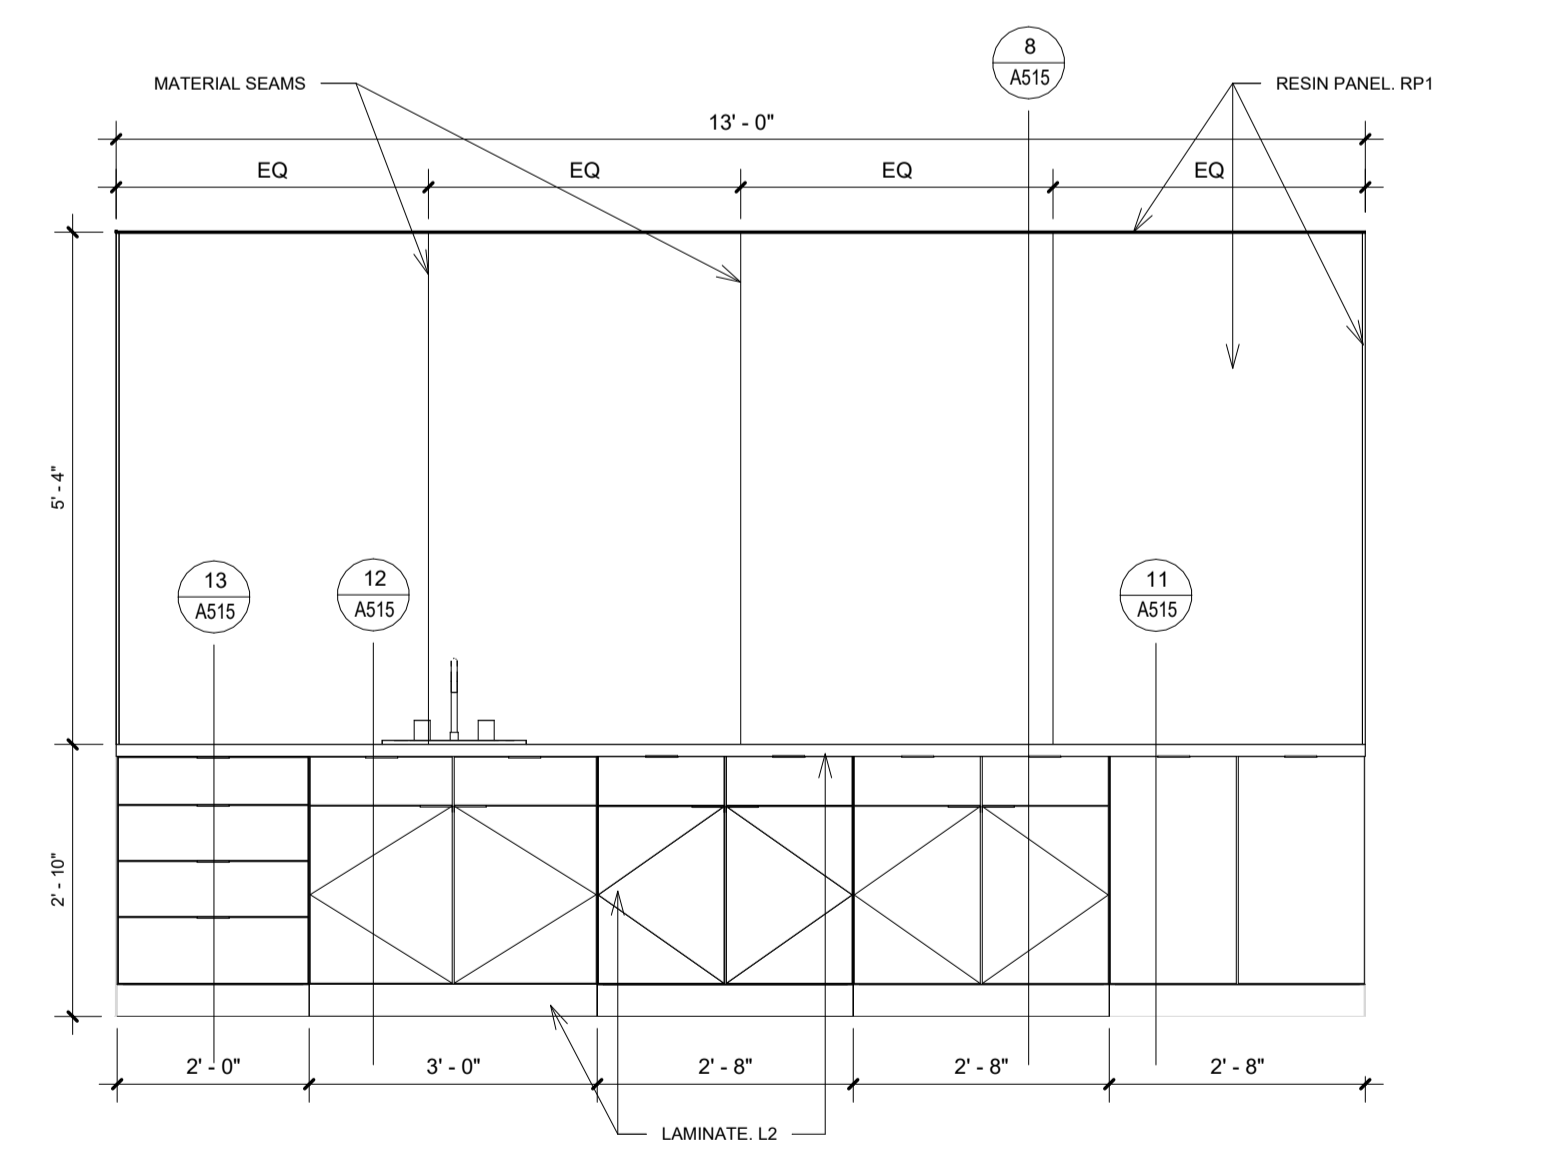


10 M3 - SNACK BAR ELEV.
A515 1/2" = 1'-0"

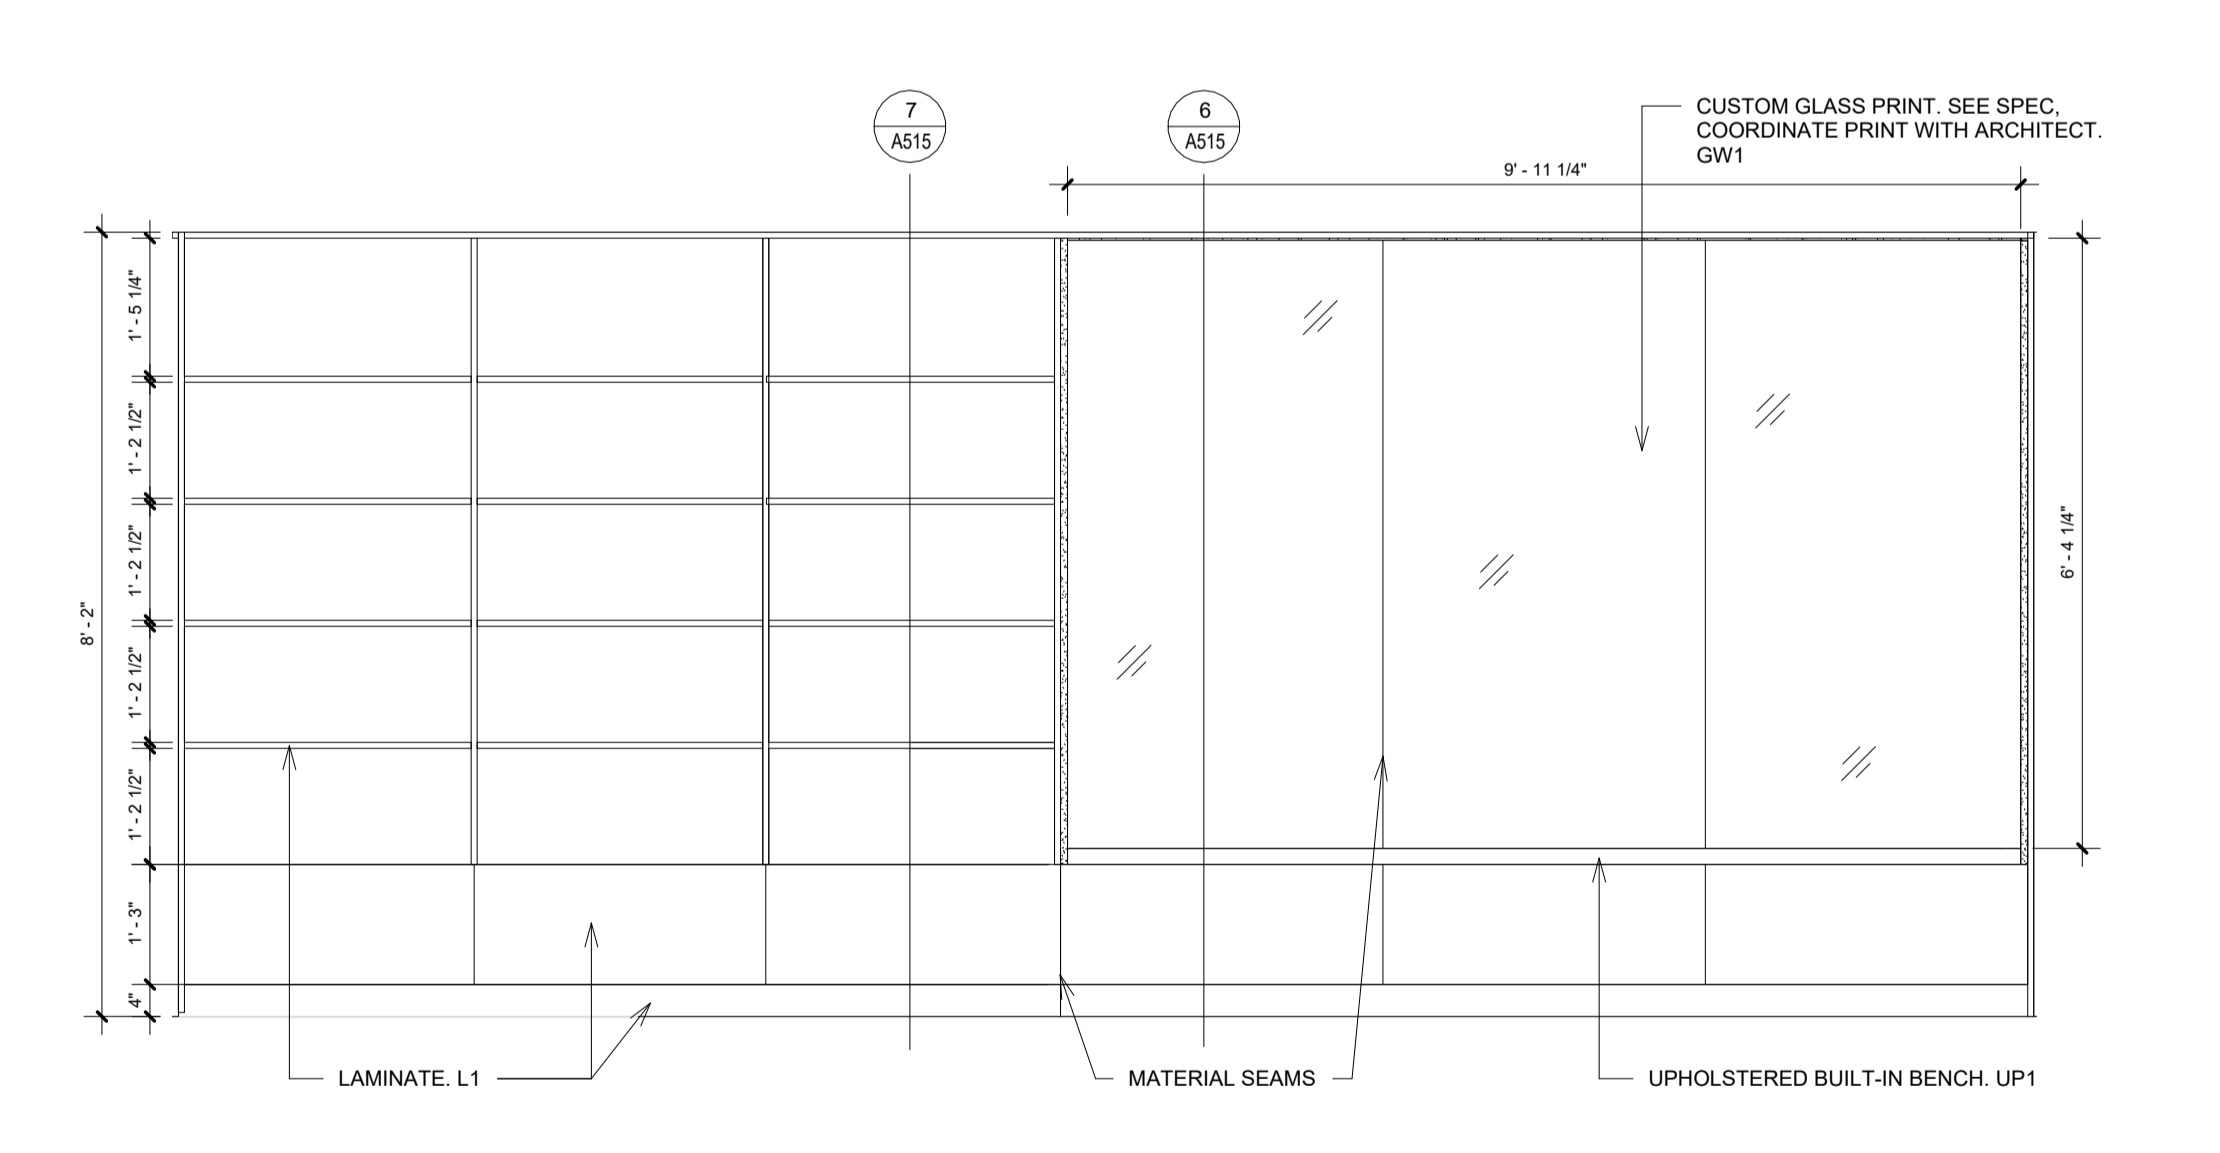


5 M2 - ENTRY BENCH & SHELVES ELEV.
A515 1/2" = 1'-0"

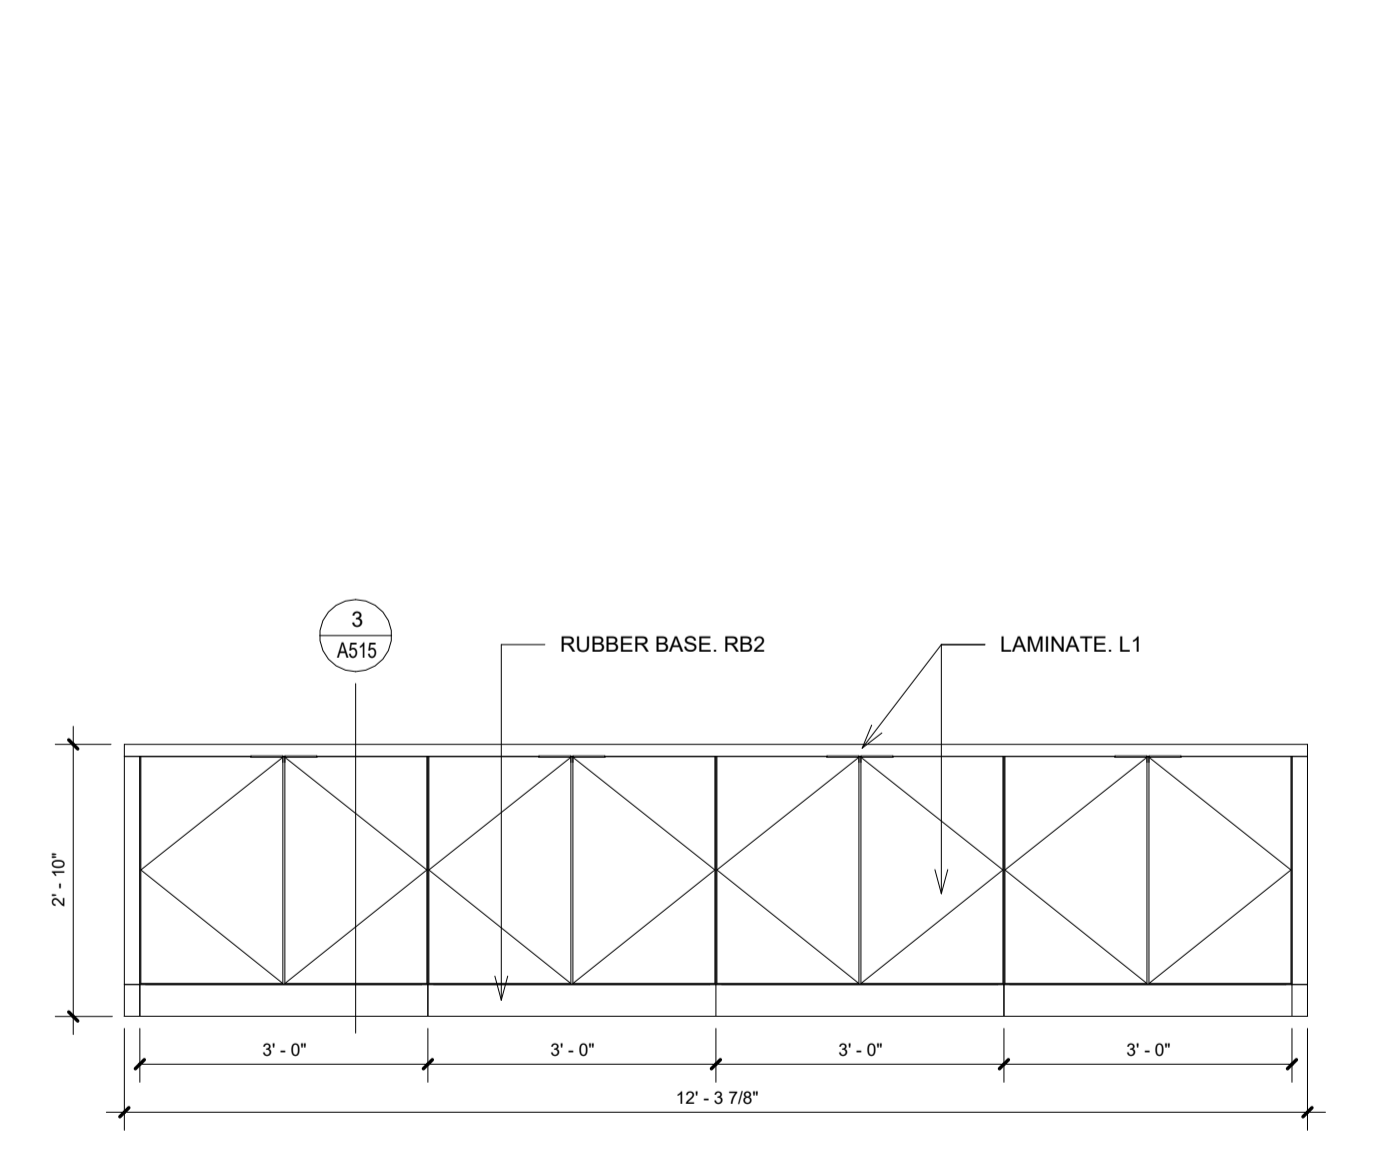


2 M1 - CONFERENCE ROOM MILLWORK ELEV.
A515 1/2" = 1'-0"

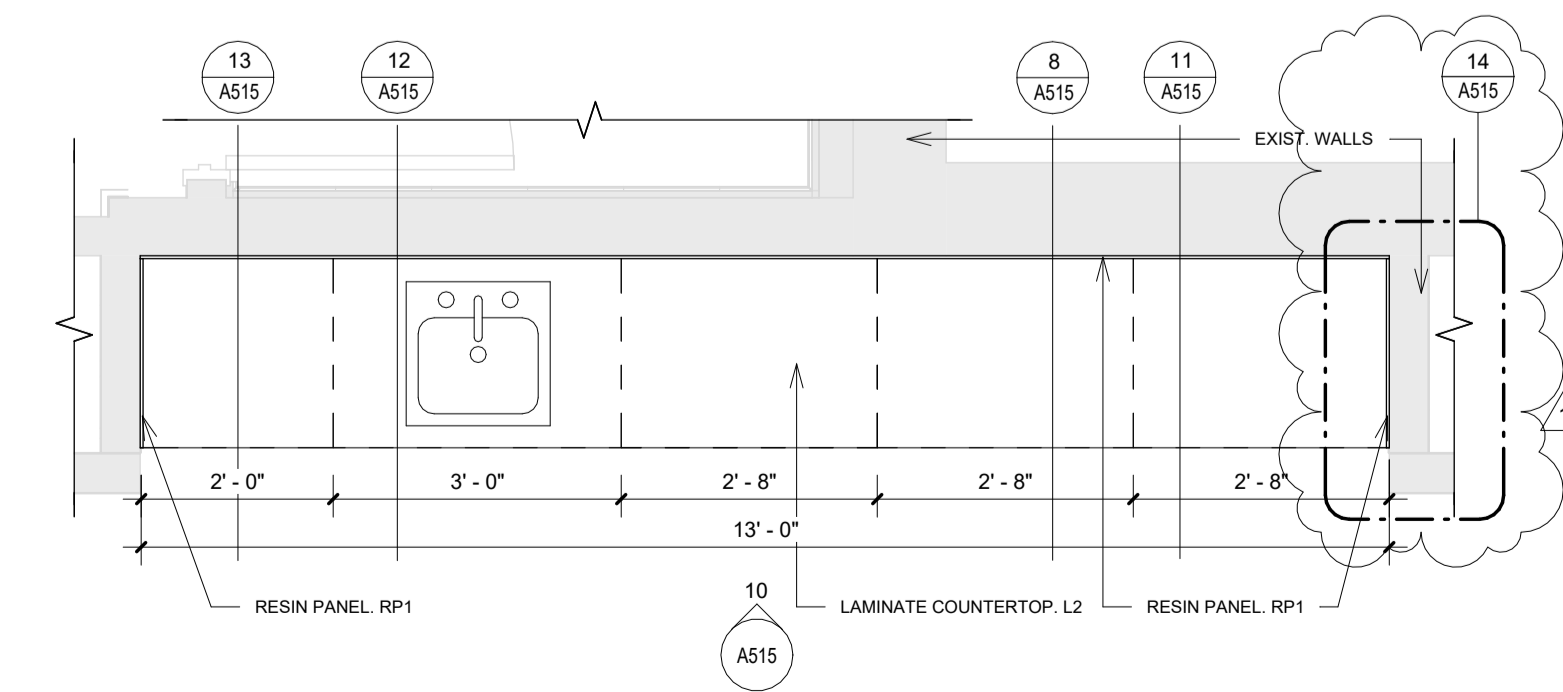


9 M3 - SNACK BAR PLAN
A515 1/2" = 1'-0"

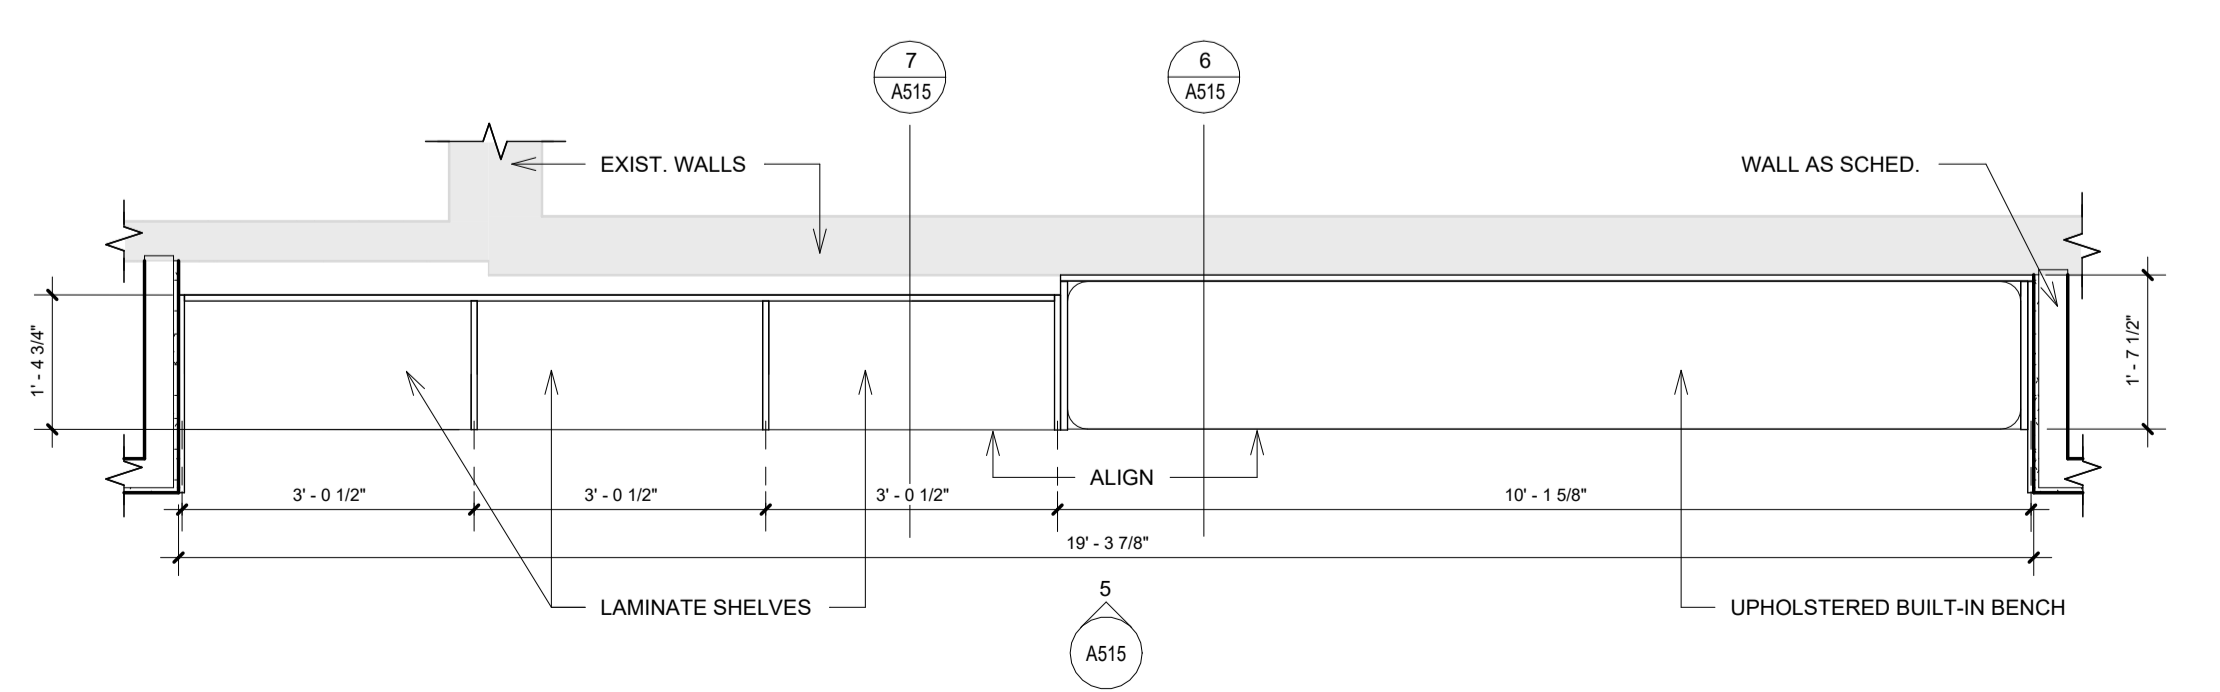

4 M2 - ENTRY BENCH & SHELVES PLAN
A515 1/2" = 1'-0"

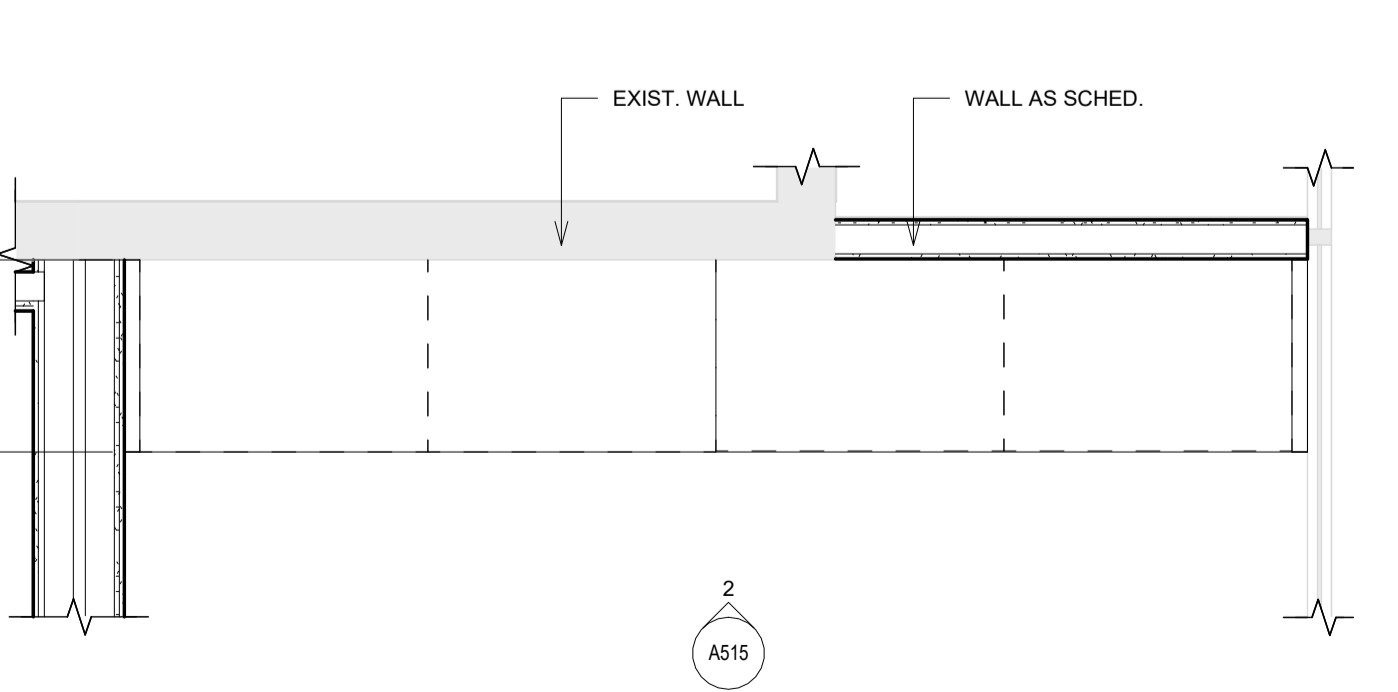


1 M1 - CONFERENCE ROOM MILLWORK PLAN
A515 1/2" = 1'-0"

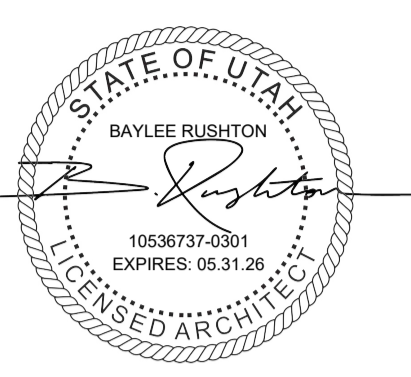


ELEV. LEGEND


- P1 = PAINT, COLOR: 7566 WESTHIGHLAND WHITE
- P2 = PAINT, COLOR: 8484 LAKESHORE
- F1 = FELT, COLOR: GREEN
- F2 = FELT, COLOR: PINK
- F3 = FELT, COLOR: PURPLE
- F4 = FELT, COLOR: ORANGE
- RP1 = RESIN PANEL, COLOR: KILT + WHITE OUT
- L1 = LAMINATE, COLOR: AGED ASH
- L2 = LAMINATE, COLOR: HUNTER GREEN
- TL1 = LAMINATE TEXTURED PANEL FINISH: FILA, SALINAS OAK
- TF1 = FELT TEXTURED PANEL FINISH: BOLLA, MIDNIGHT
- WS1 = WOOD SCREEN, SPECIES/FINISH: AMERICAN OAK / NATURAL
- SS1 = SOLID SURFACE COUNTERTOP, COLOR: FROSTY WHITE MIRROR
- UP1 = UPHOLSTERY, COLOR: NICO 016 POSH
- RB1 = RUBBER BASE, COLOR: TIG2 SHARK FIN
- RB2 = RUBBER BASE, COLOR: GREY WG
- GW1 = GLASS WALL, SEE SPEC.
- GW2 = GLASS WALL, SEE SPEC.
- MB1 = MARKER BOARD 47X5, SEE SPEC.
- TD = TOWEL DISPENSER BY OWNER, PROVIDE BLOCKING IN WALLS
- SD = SOAP DISPENSER BY OWNER, PROVIDE BLOCKING IN WALLS

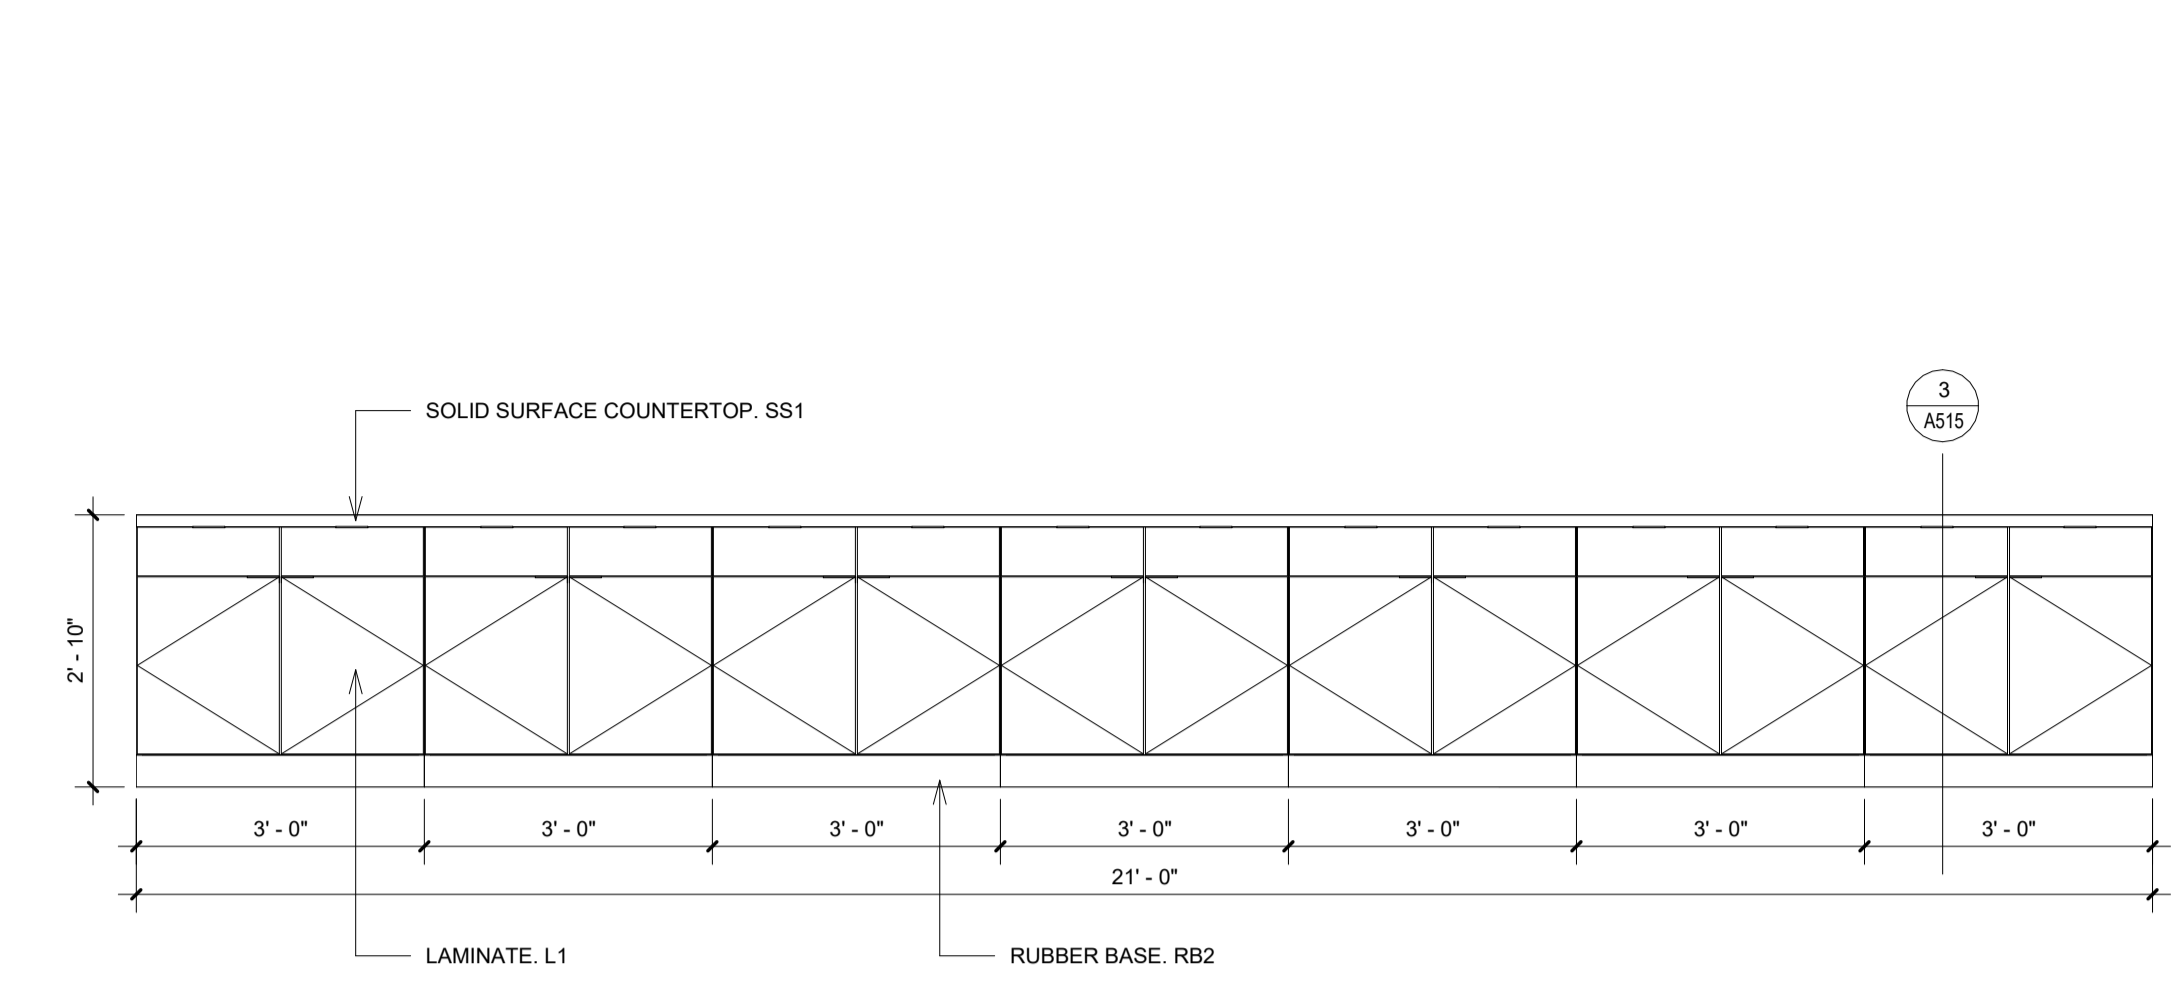


13 M7 - SOUTH PRINT MEDIA CABINETS ELEV.
A516 / 1/2" = 1'-0"

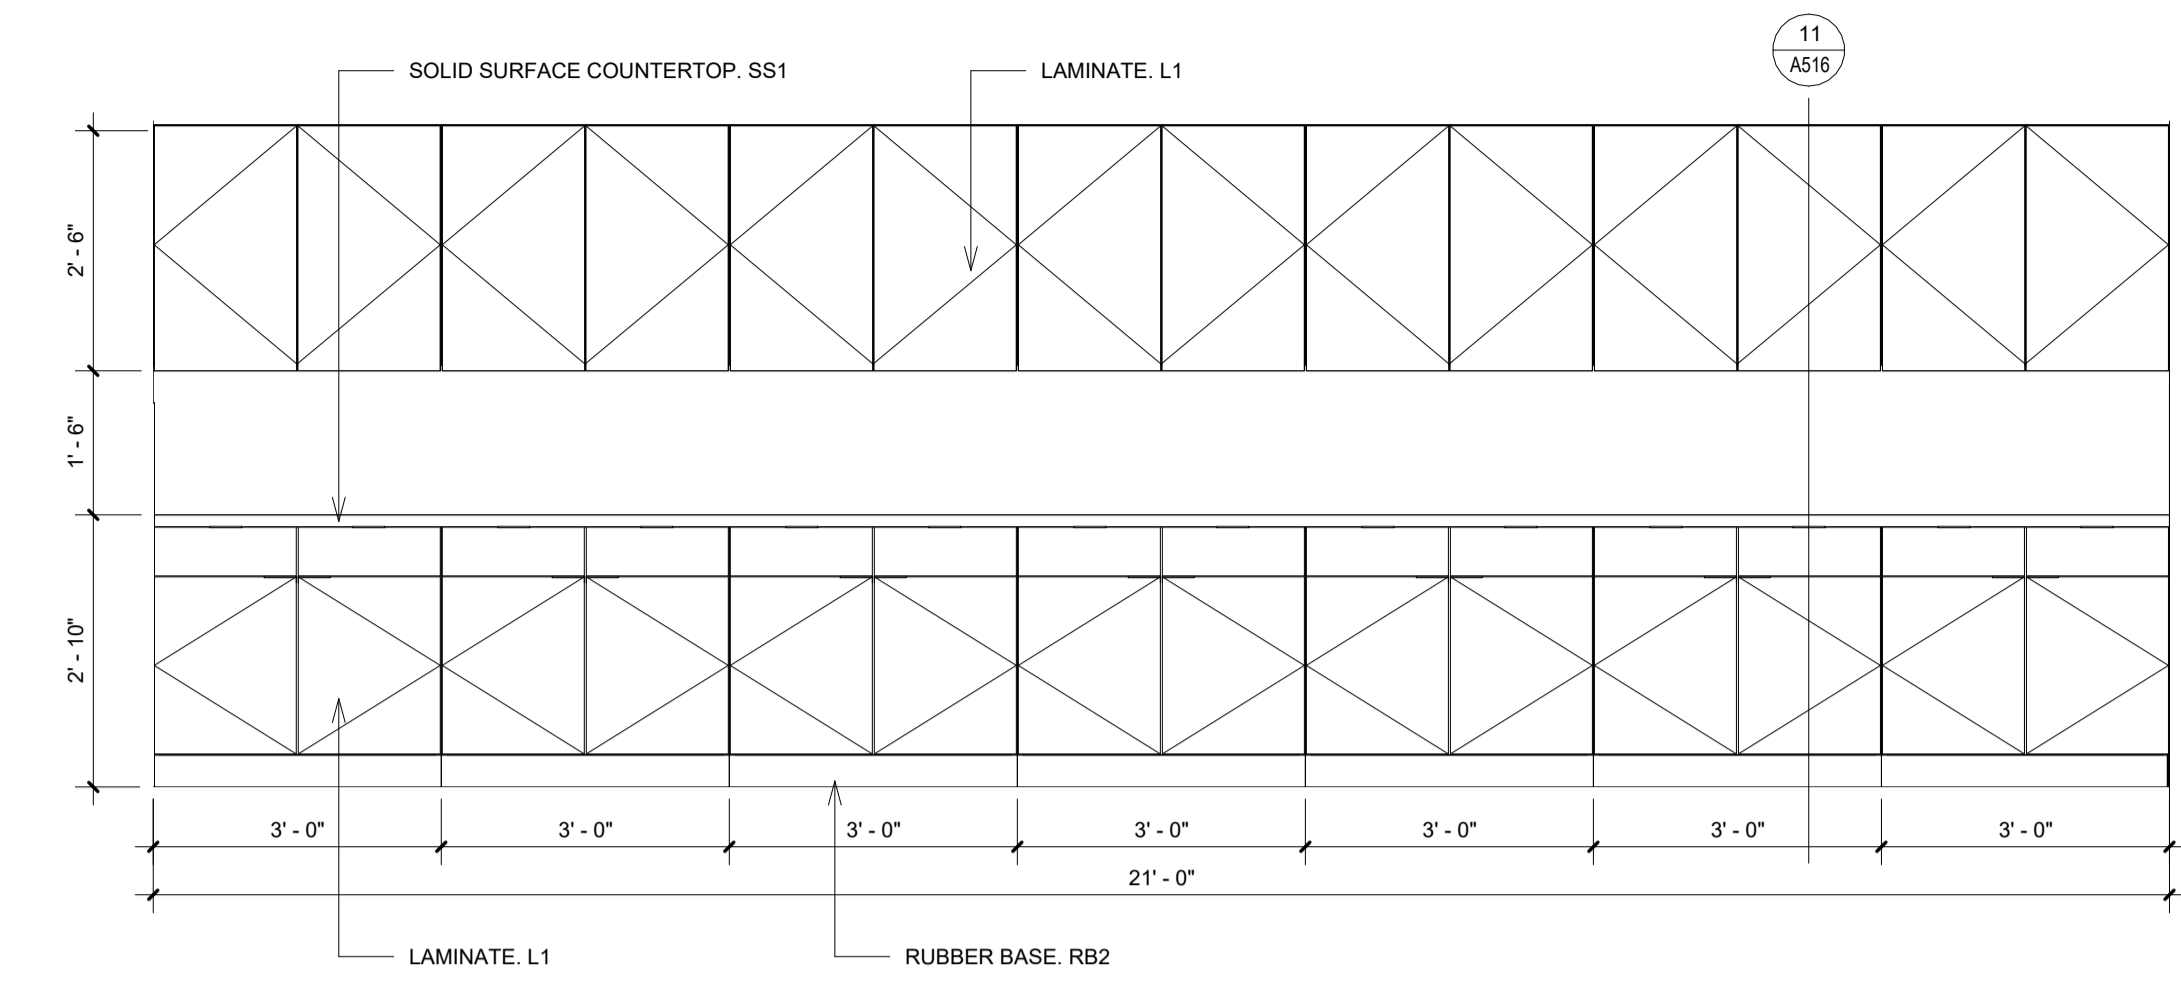


9 M6 - NORTH PRINT MEDIA CABINETS ELEV.
A516 / 1/2" = 1'-0"

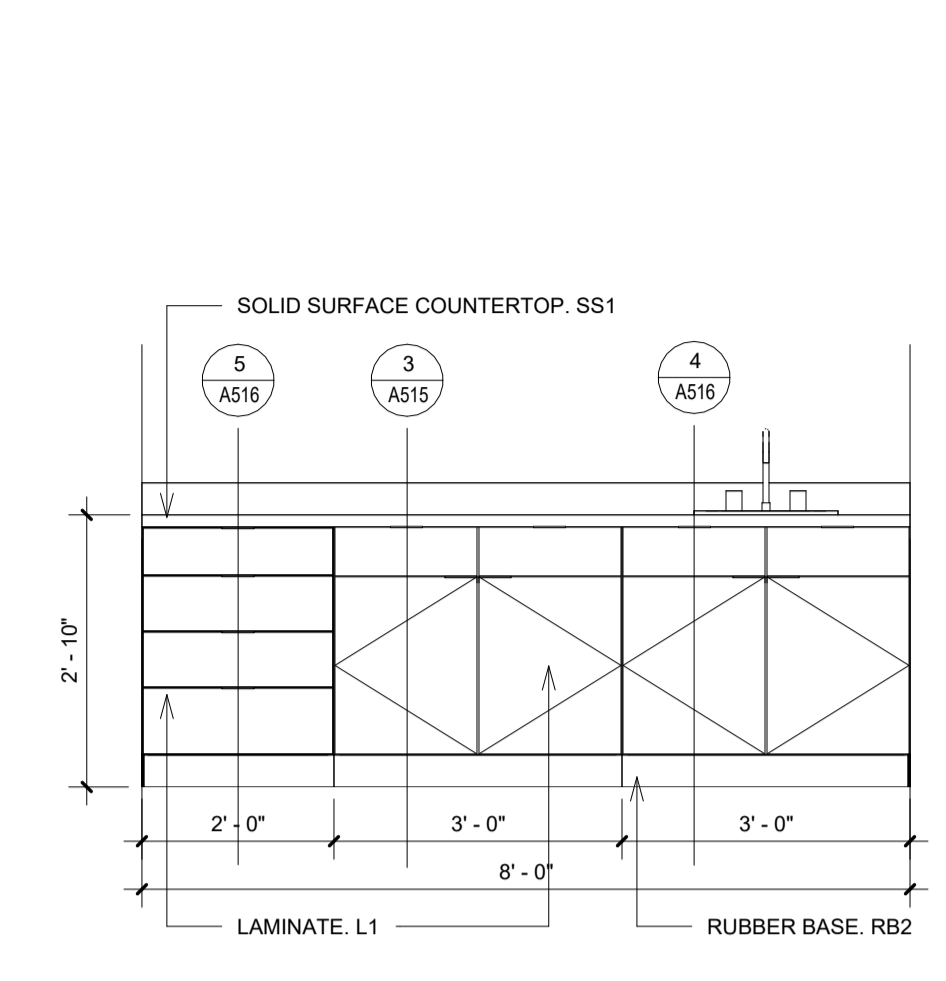


7 M5 - LACTATION CABINETS ELEV.
A516 / 1/2" = 1'-0"

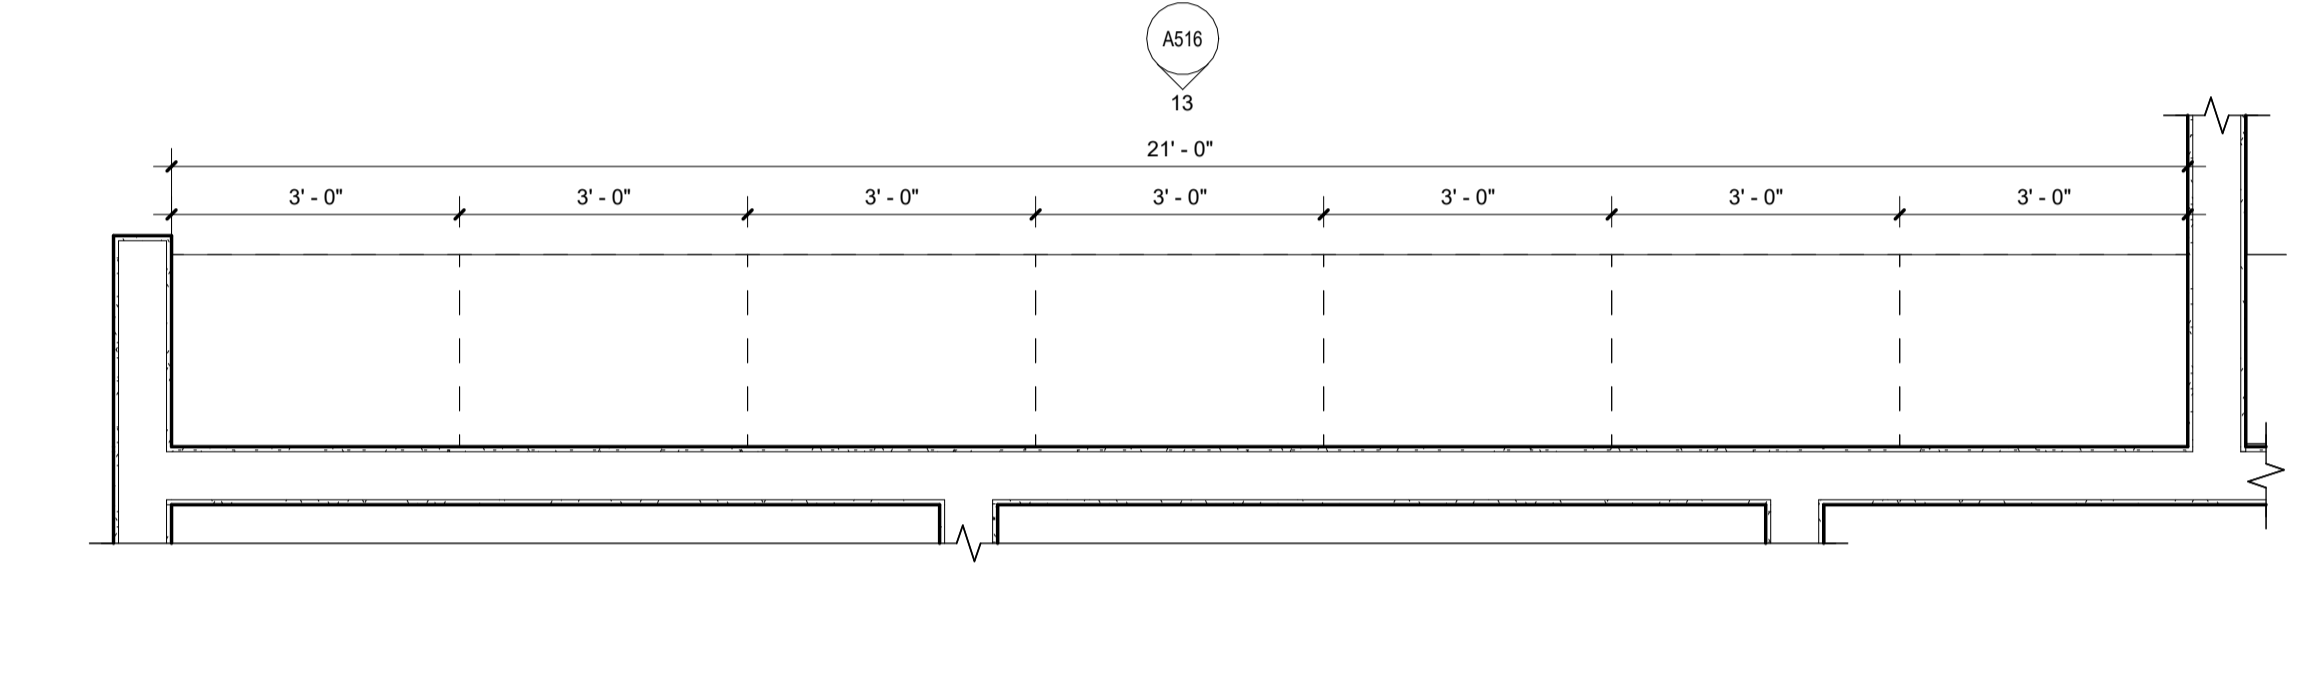


12 M7 - SOUTH PRINT MEDIA CABINETS PLAN
A516 / 1/2" = 1'-0"

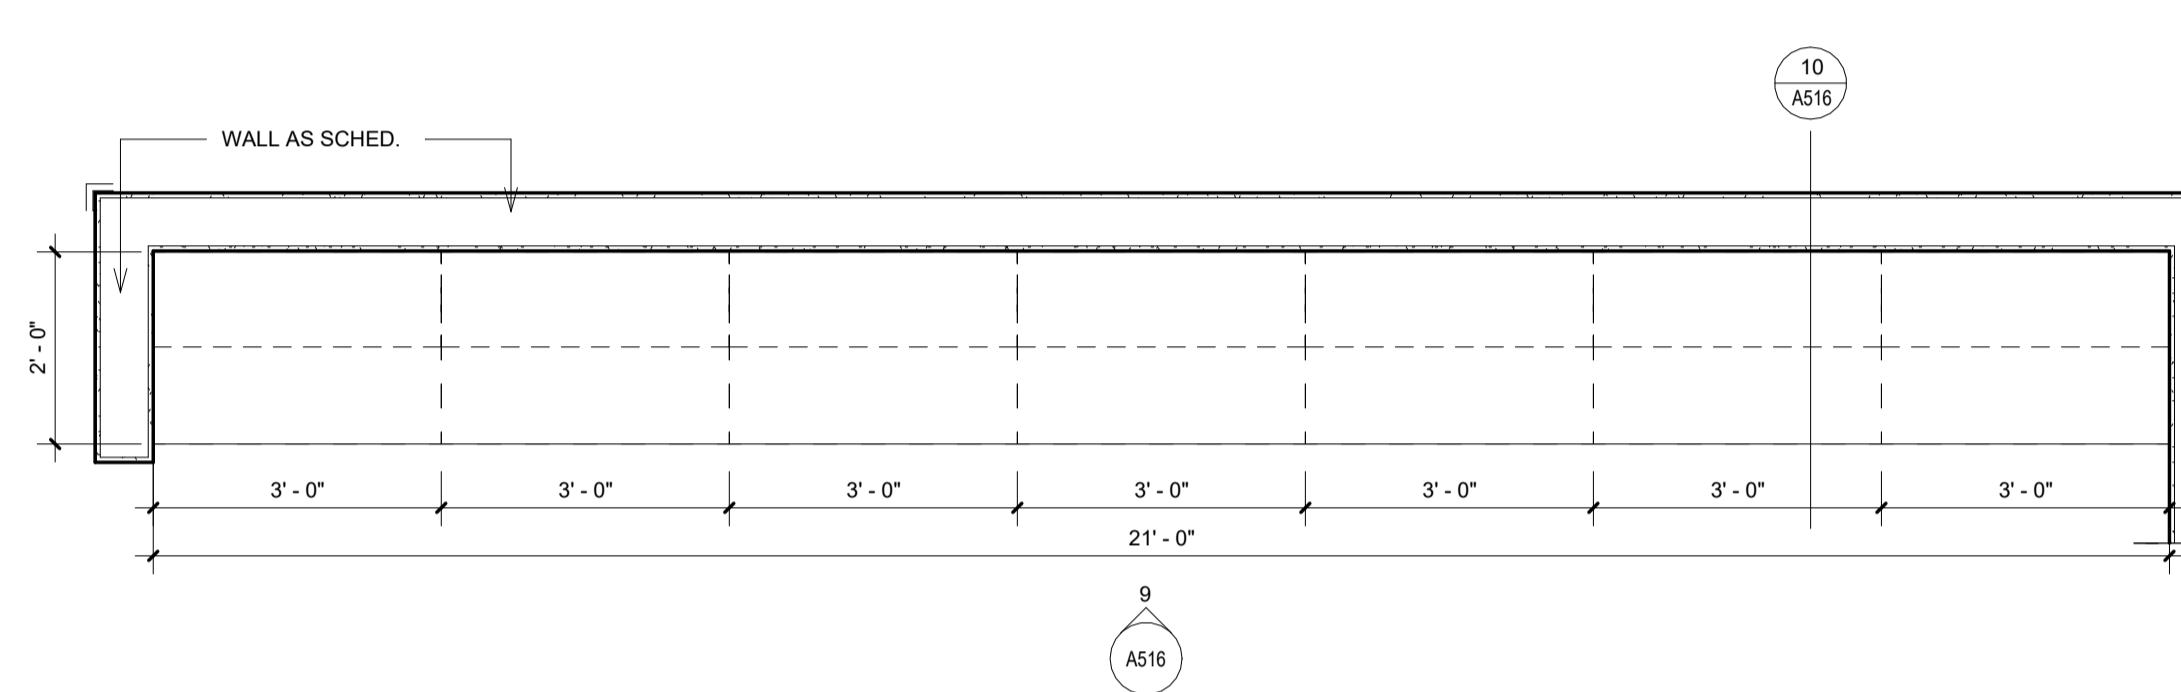


8 M6 - NORTH PRINT MEDIA CABINETS PLAN
A516 / 1/2" = 1'-0"

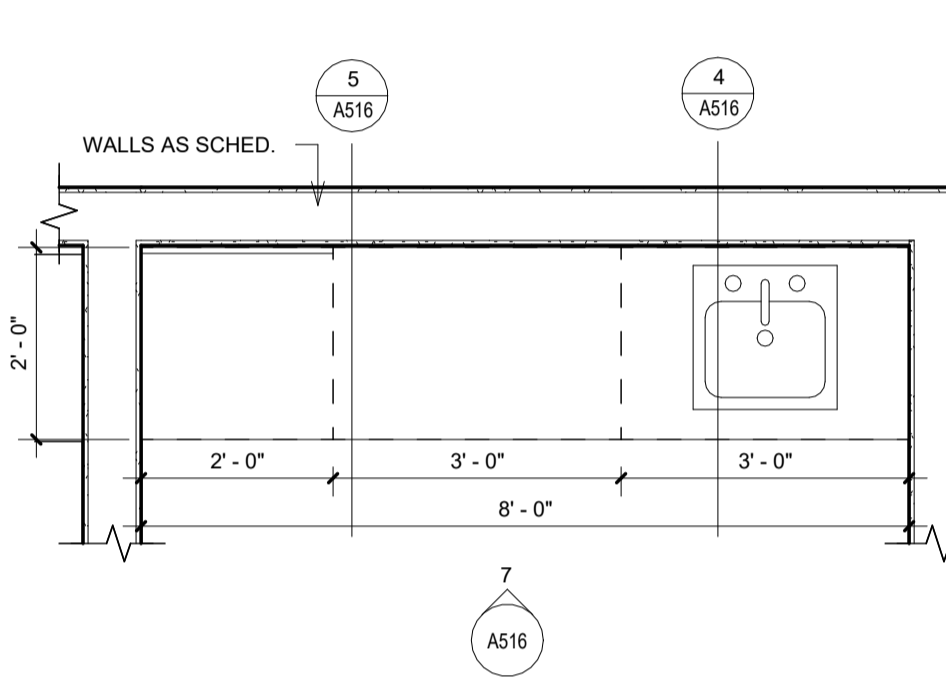


6 M5 - LACTATION CABINETS PLAN
A516 / 1/2" = 1'-0"

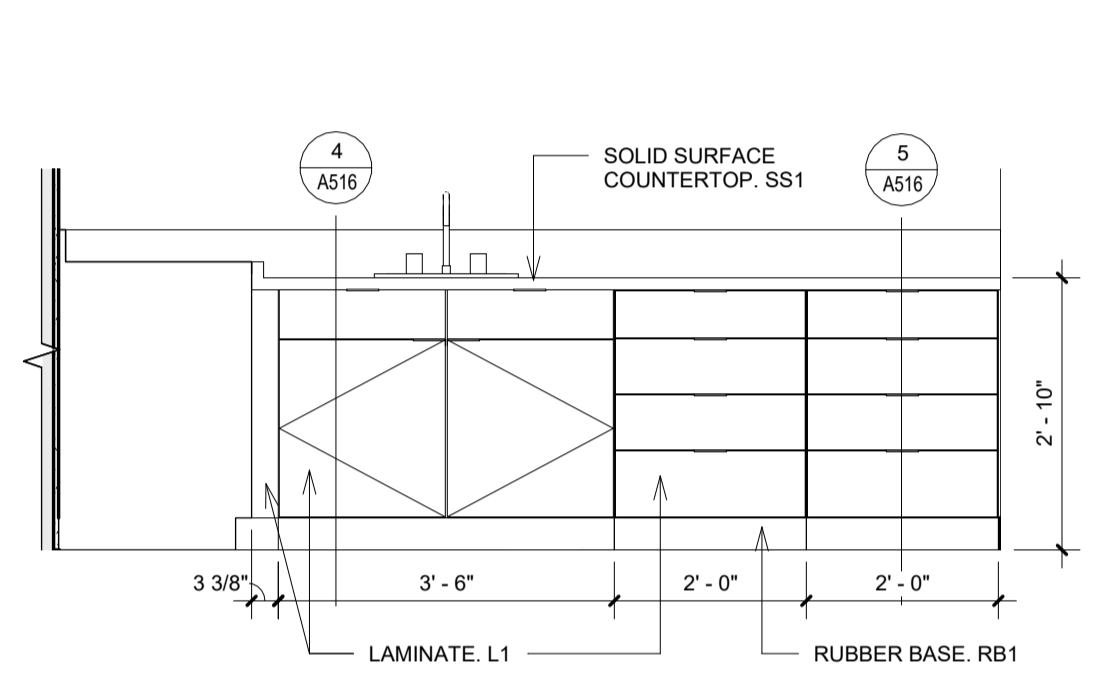


2 M4 - SUPPLIES CABINETS NORTH ELEV.
A516 / 1/2" = 1'-0"

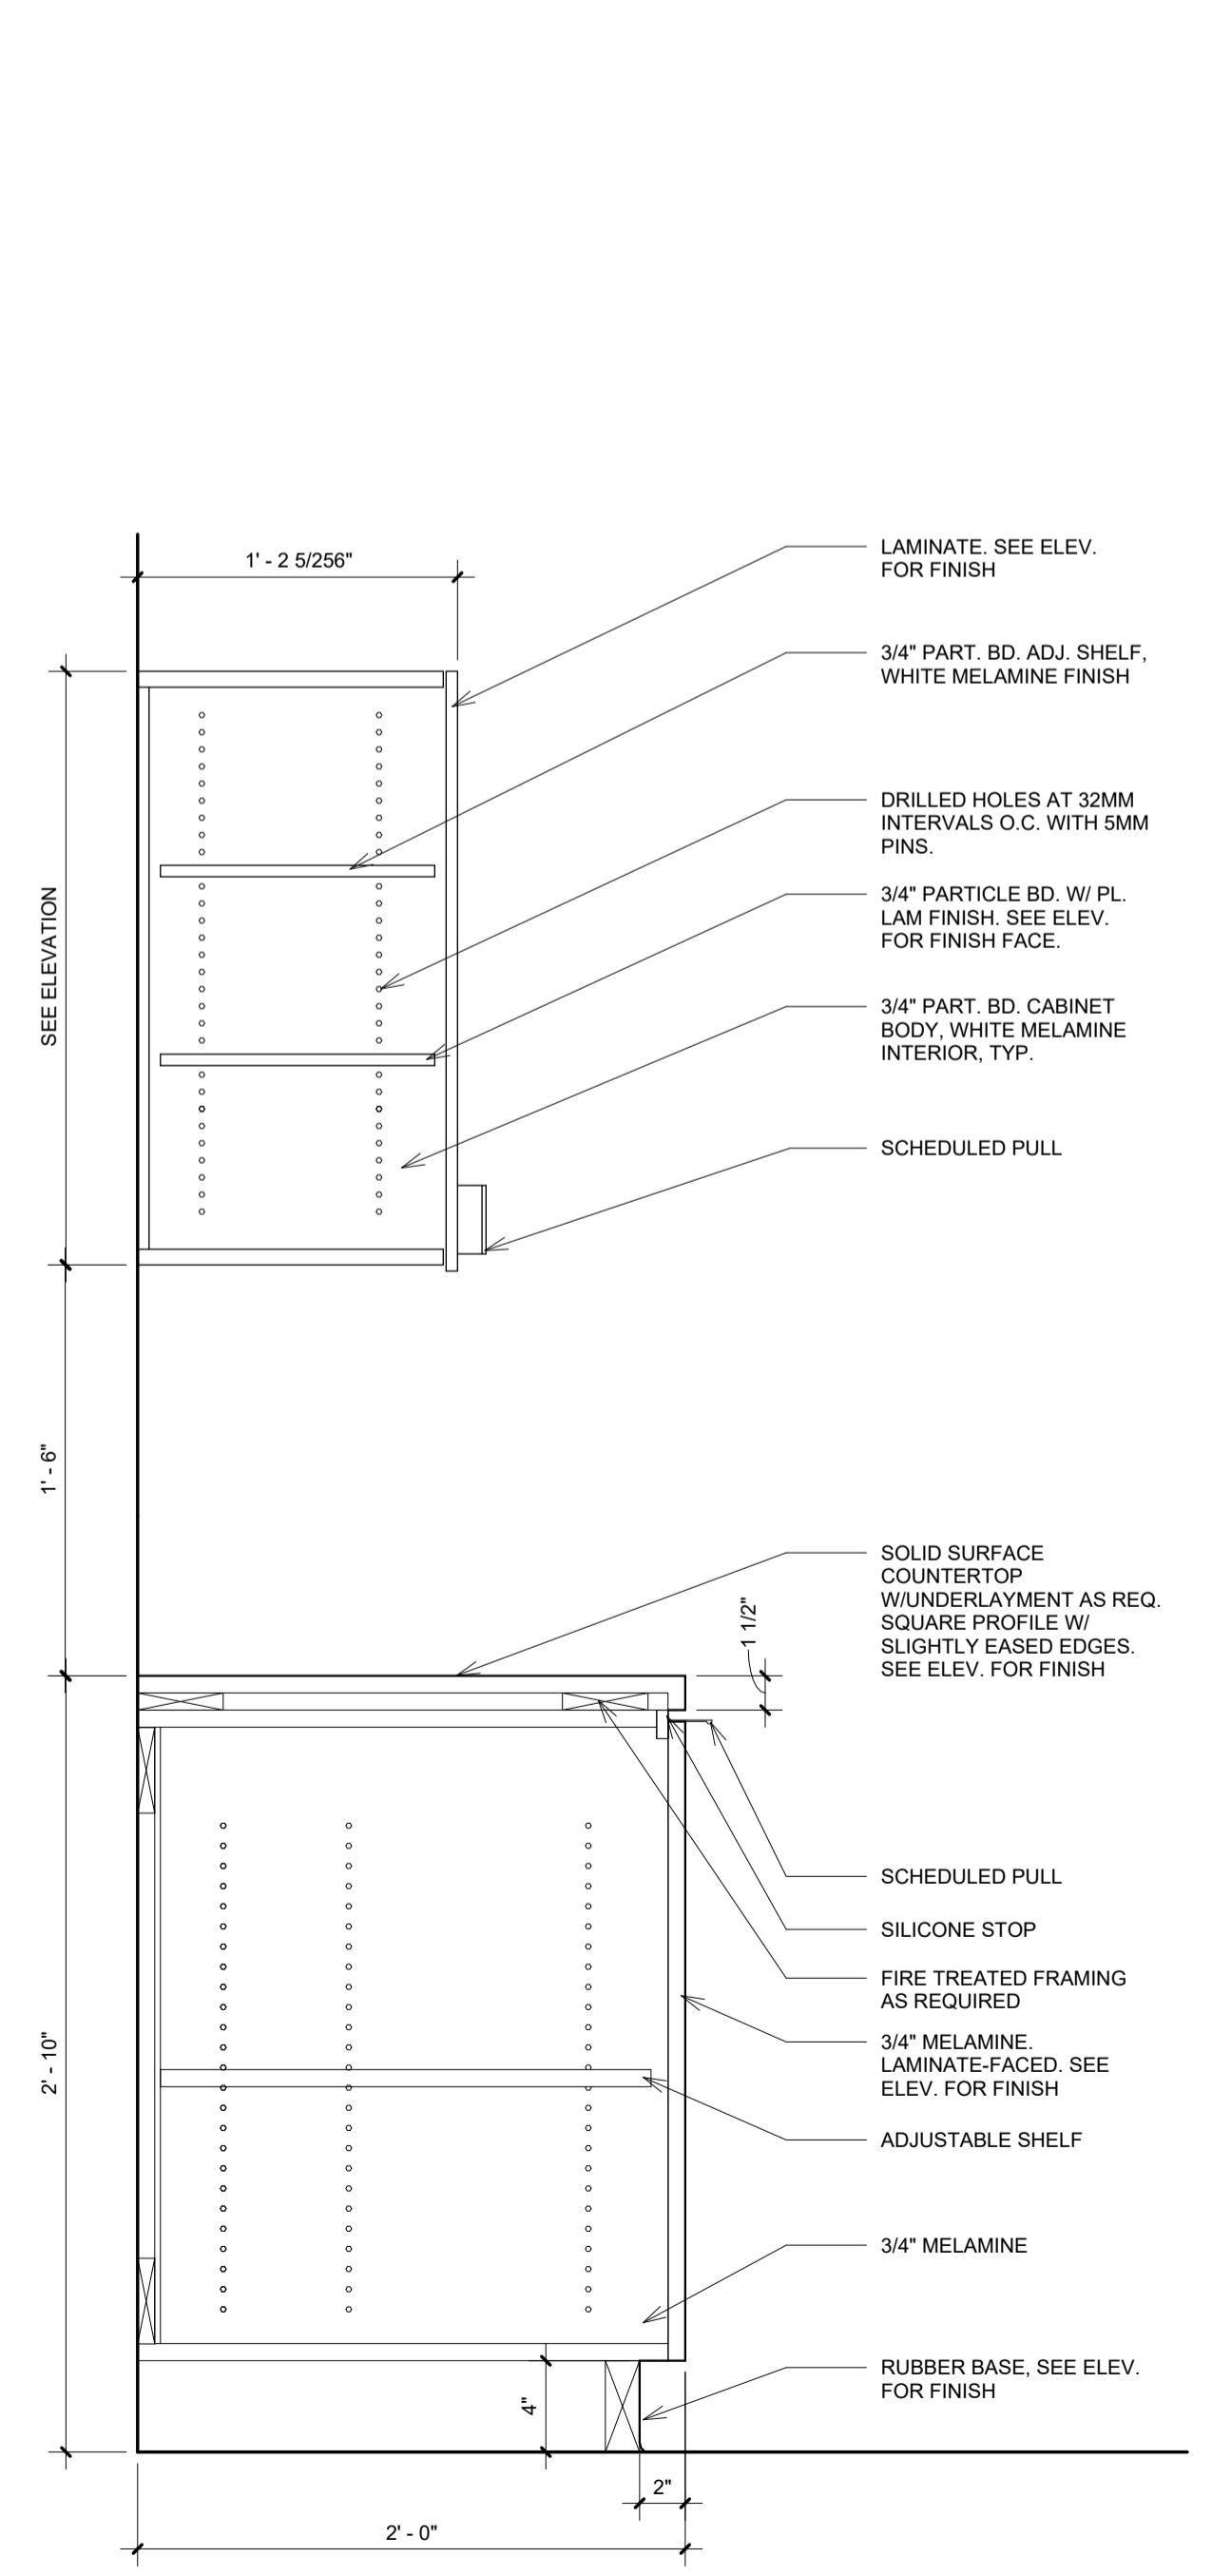


11 PRINT MEDIA UPPER & LOWER CABINETS
A516 / 1 1/2" = 1'-0"

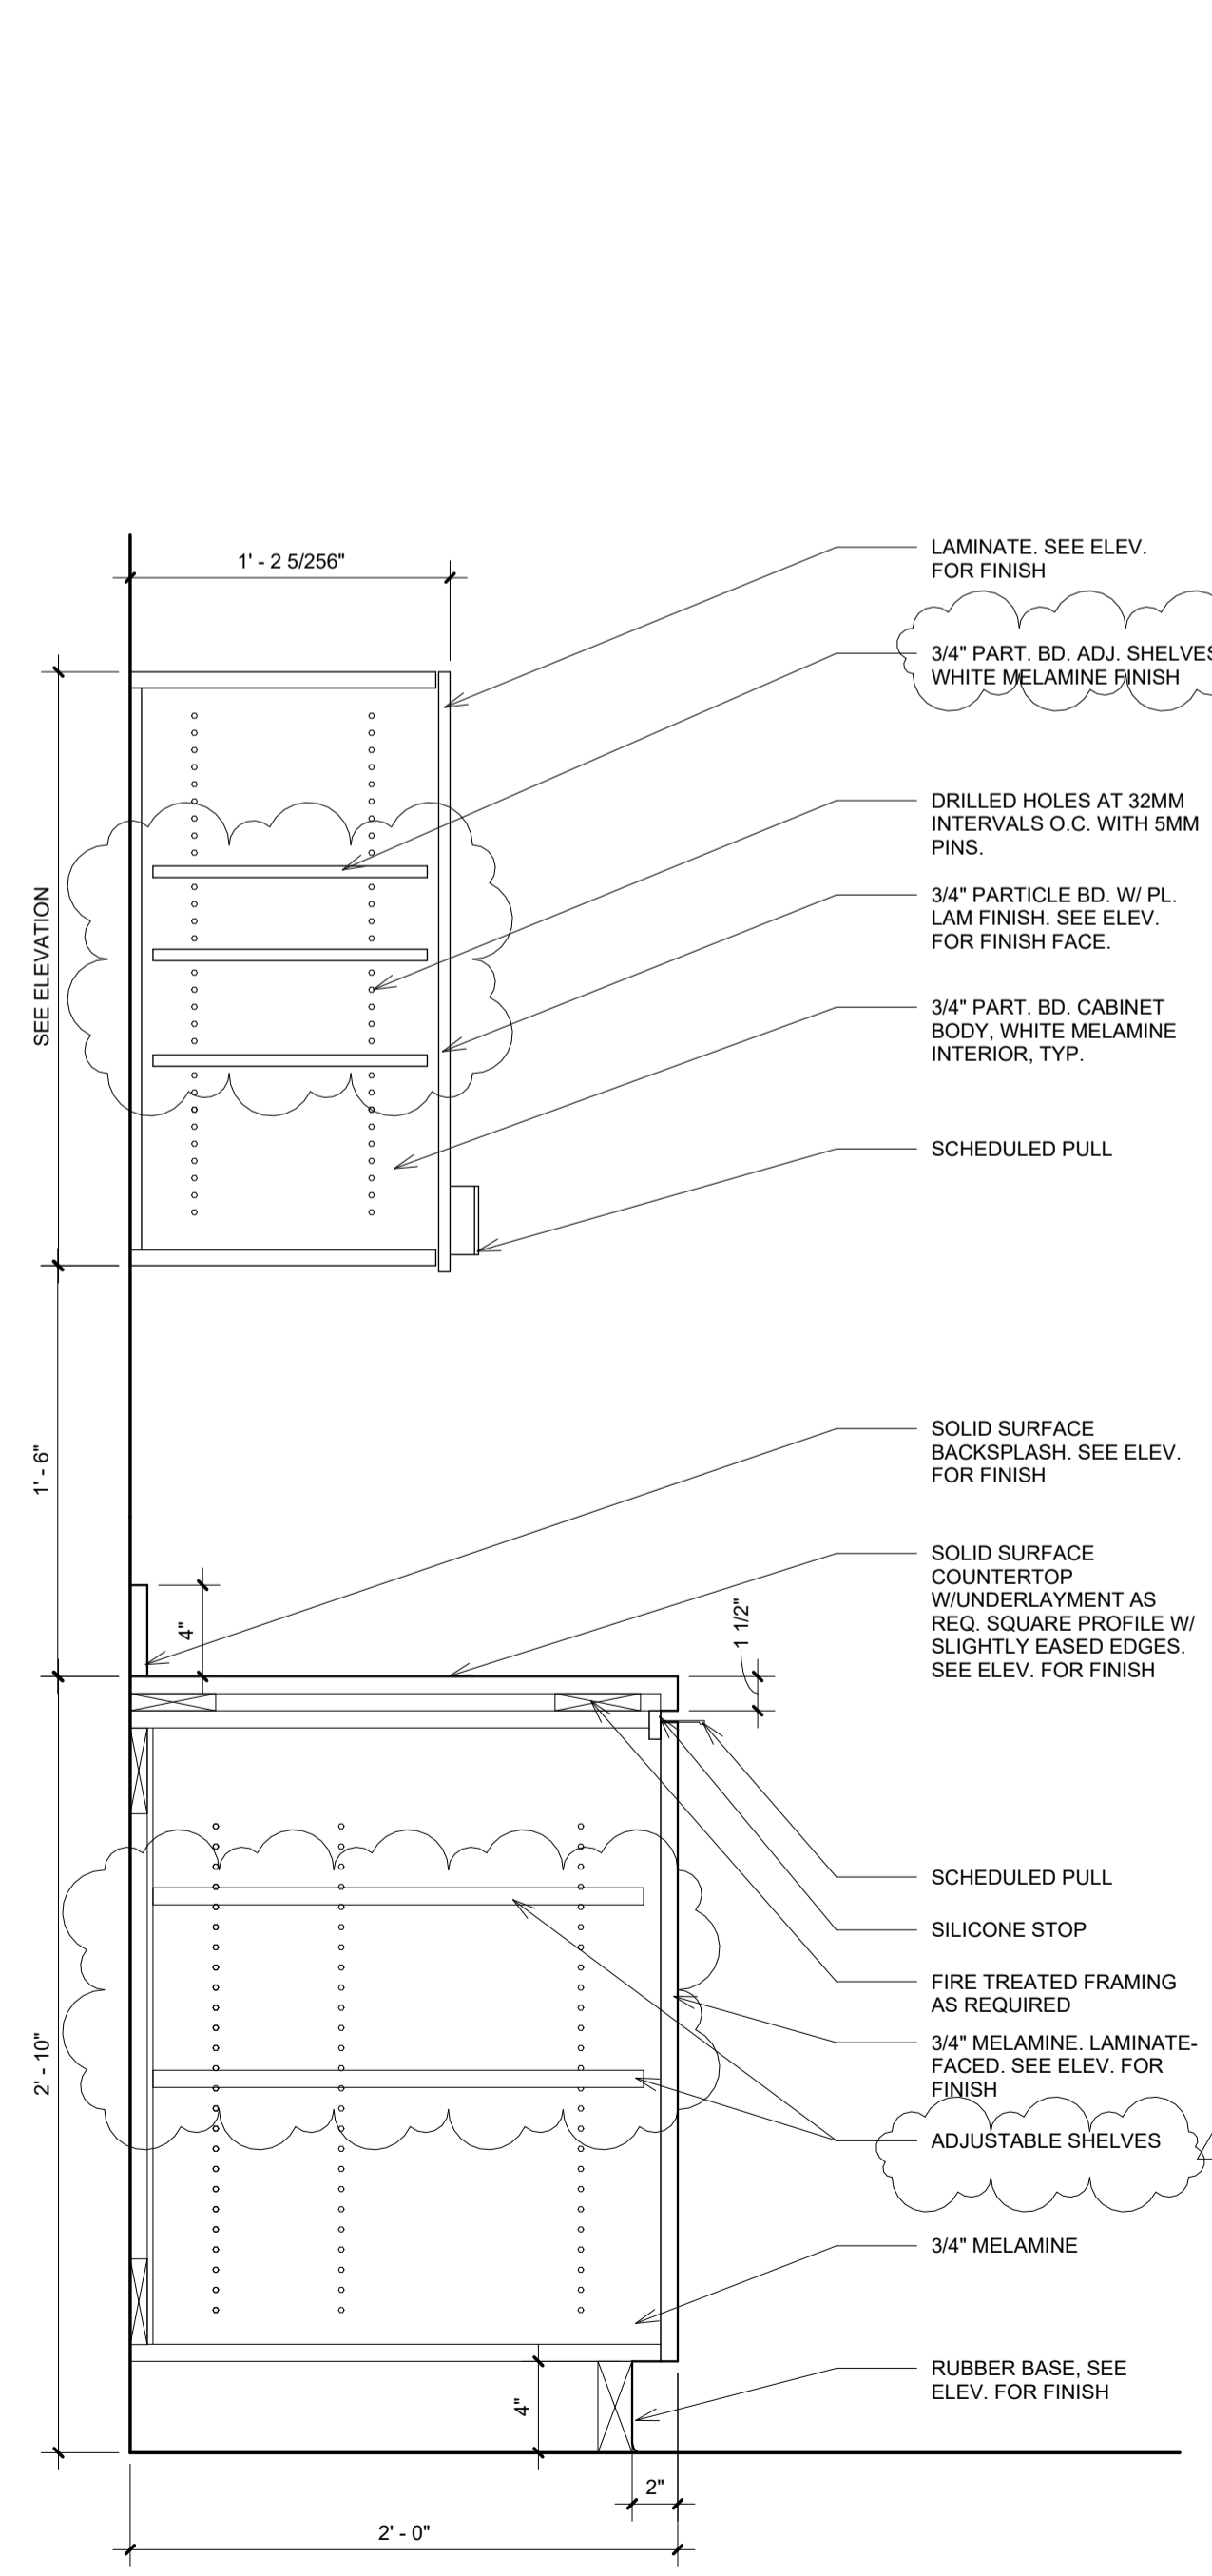


10 SUPPLIES UPPER & LOWER CABINETS
A516 / 1 1/2" = 1'-0"

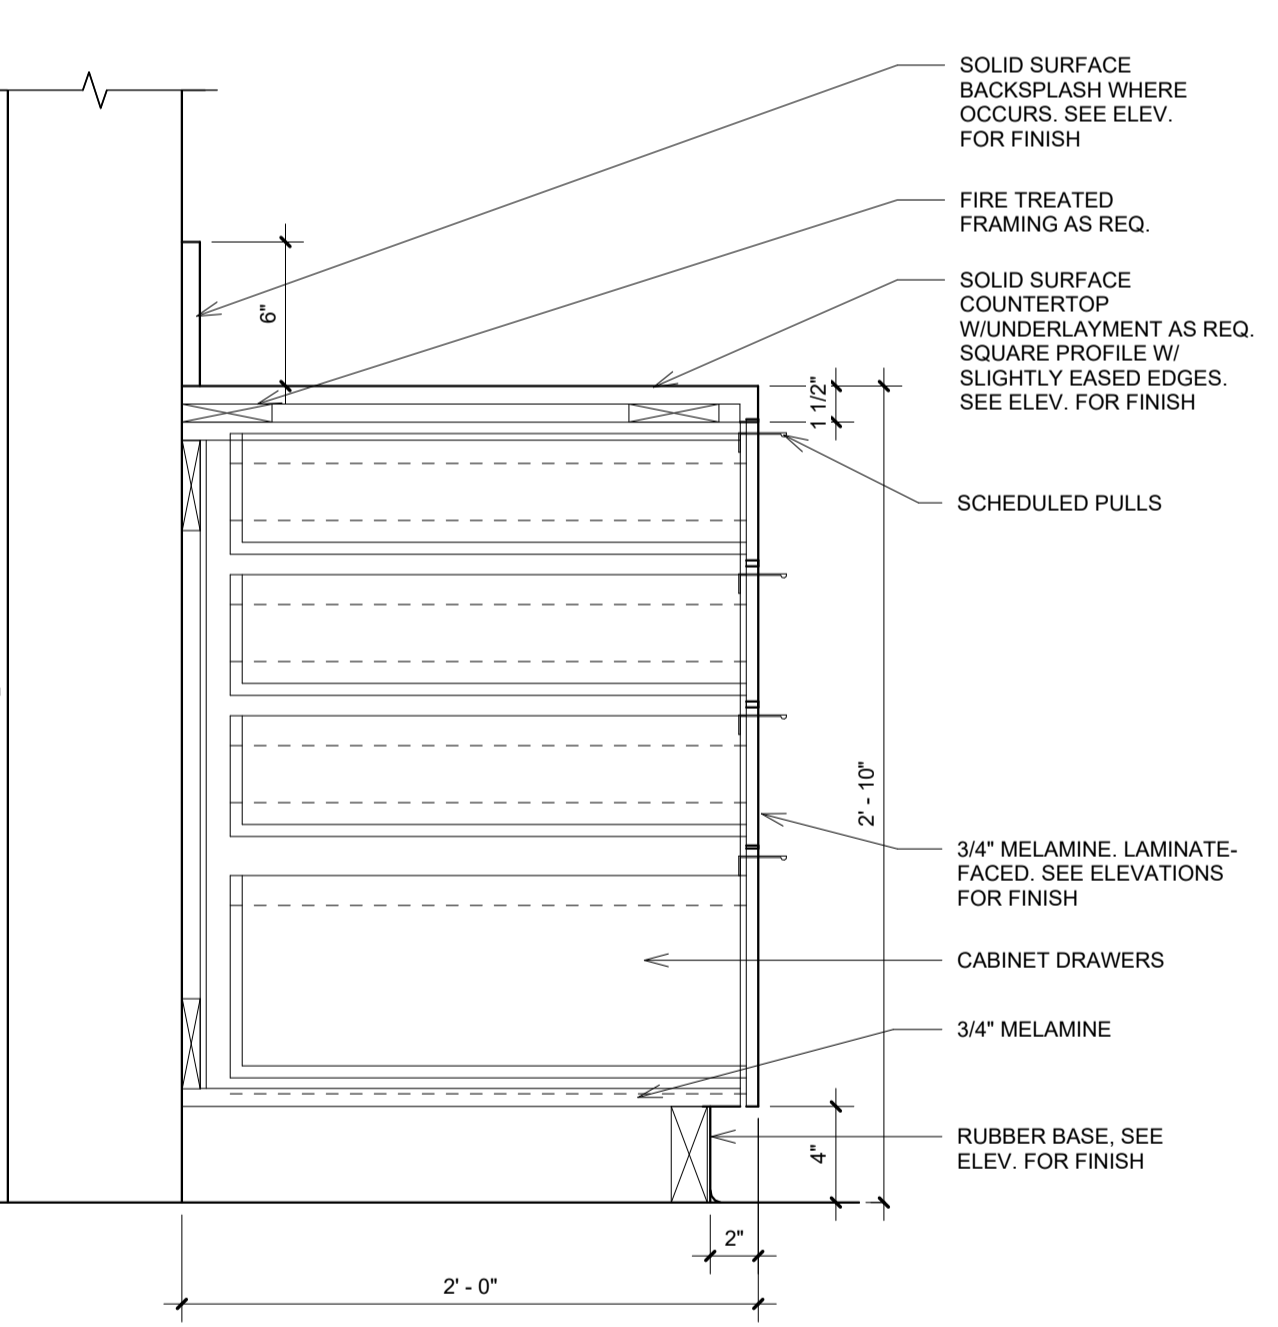


5 LOWER DRAWERS
A516 / 1 1/2" = 1'-0"

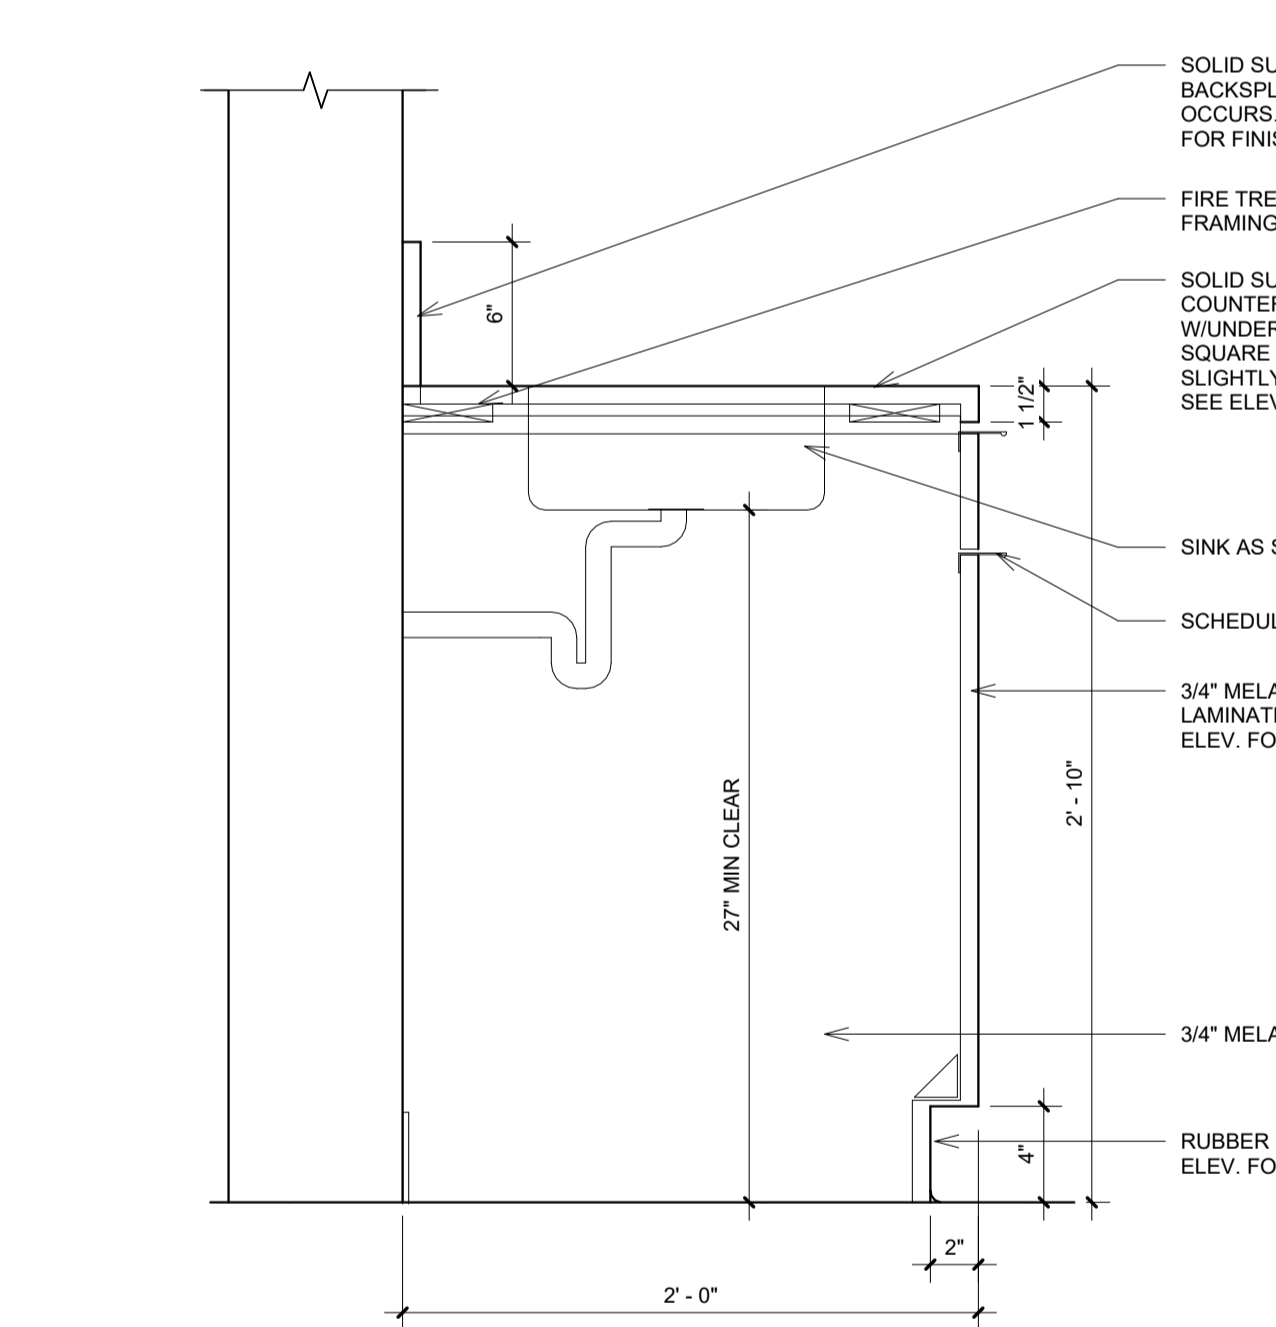

4 ADA SINK CABINET
A516 / 1 1/2" = 1'-0"

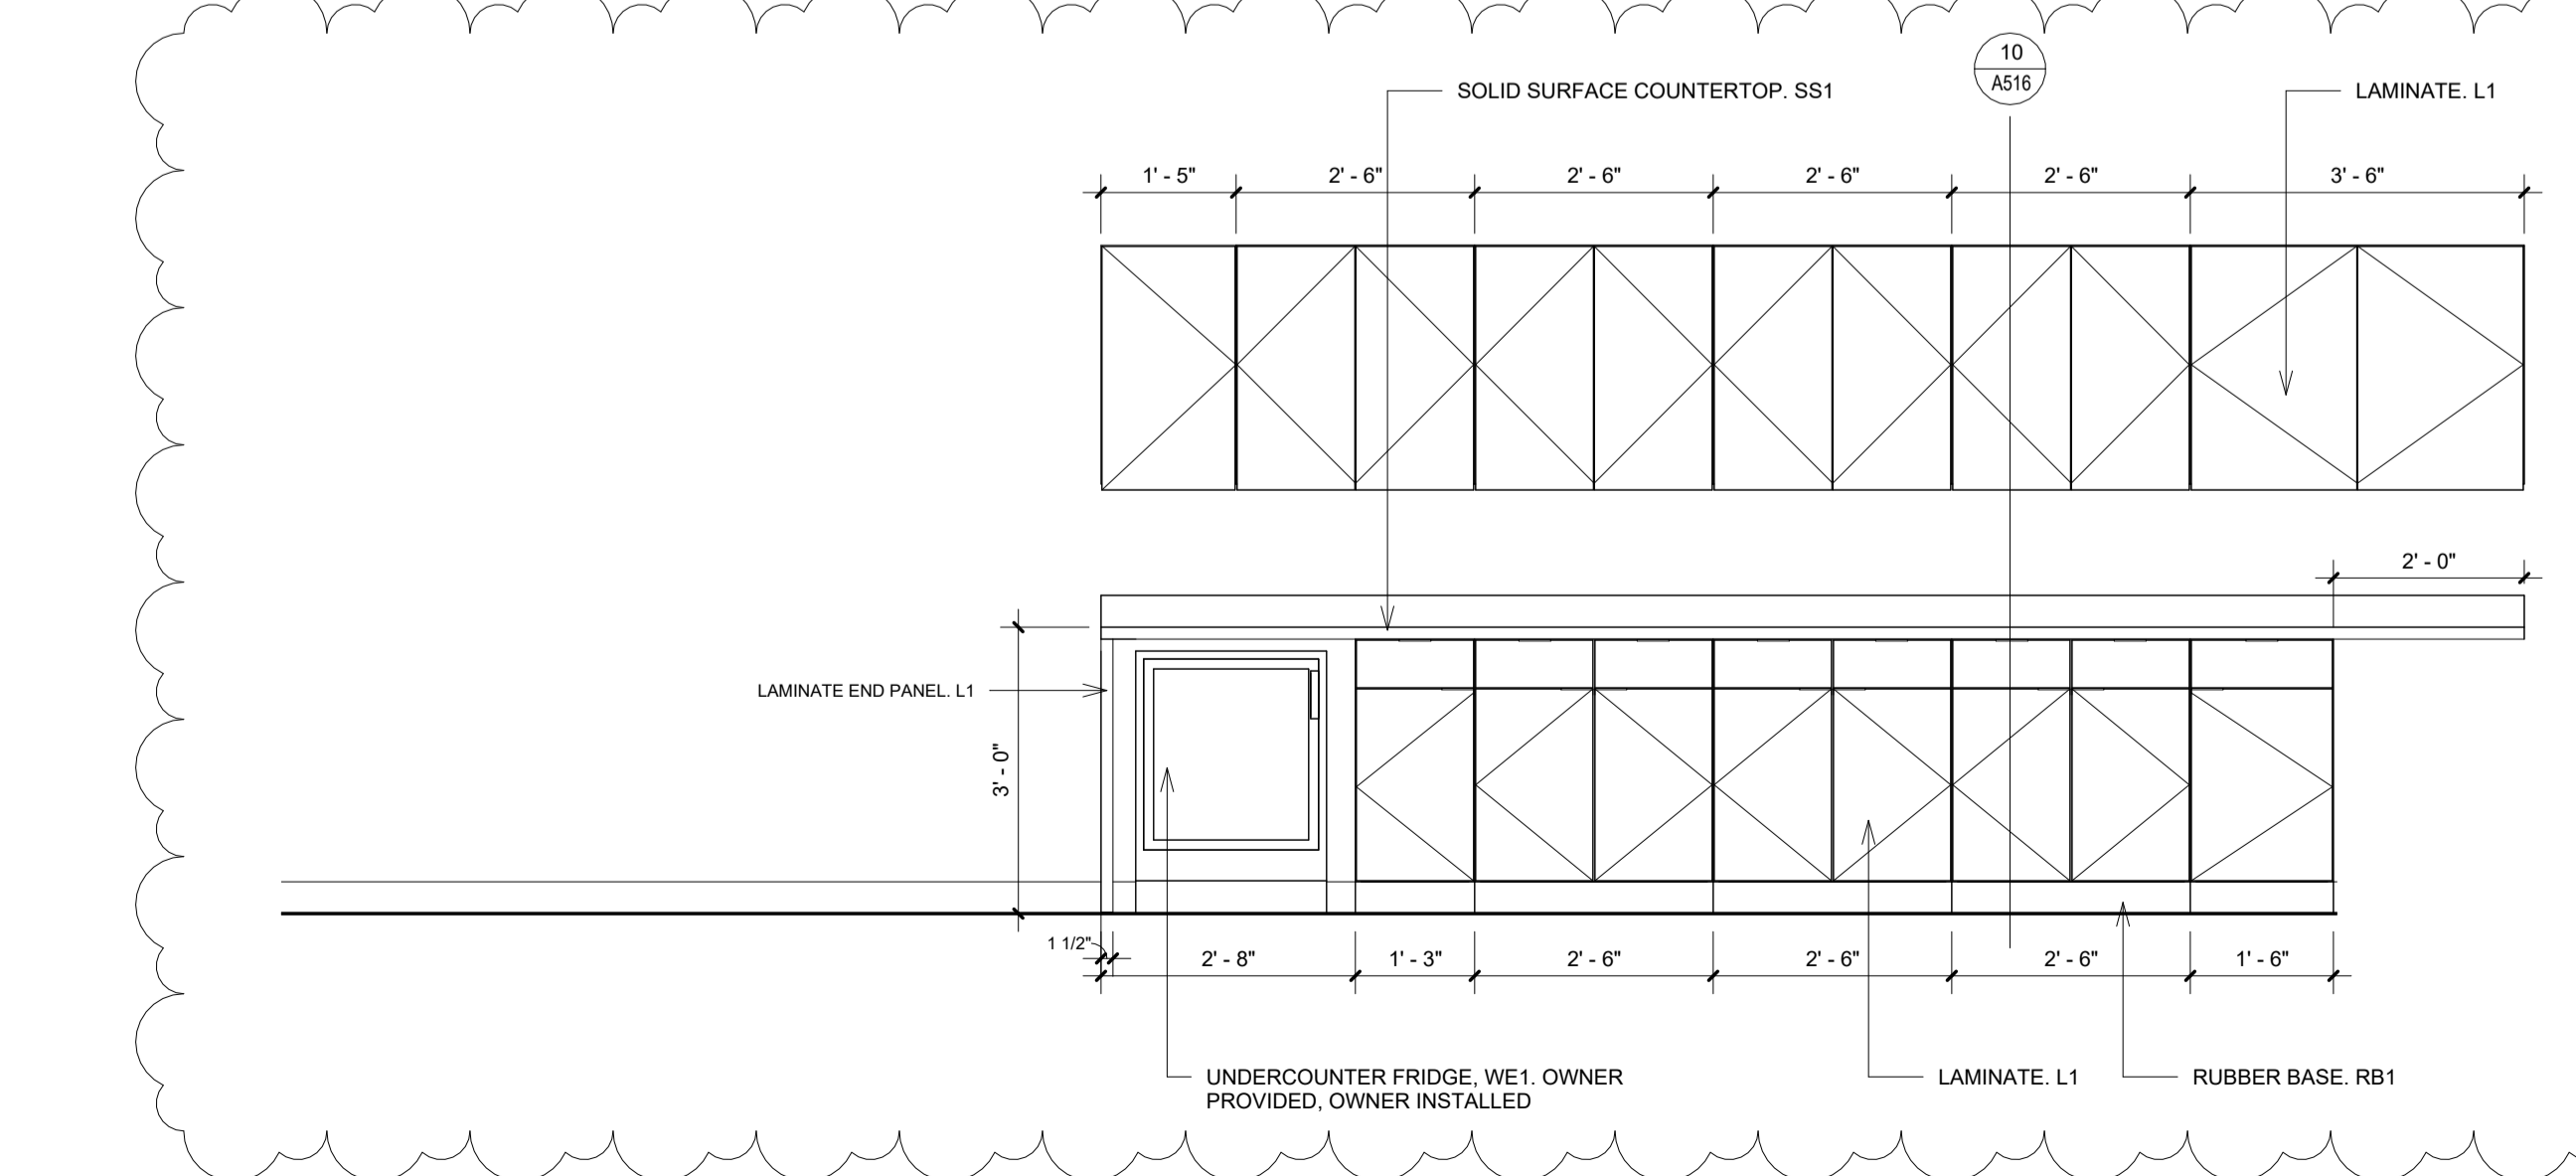

3 M4 - SUPPLIES CABINETS WEST ELEV.
A516 / 1/2" = 1'-0"

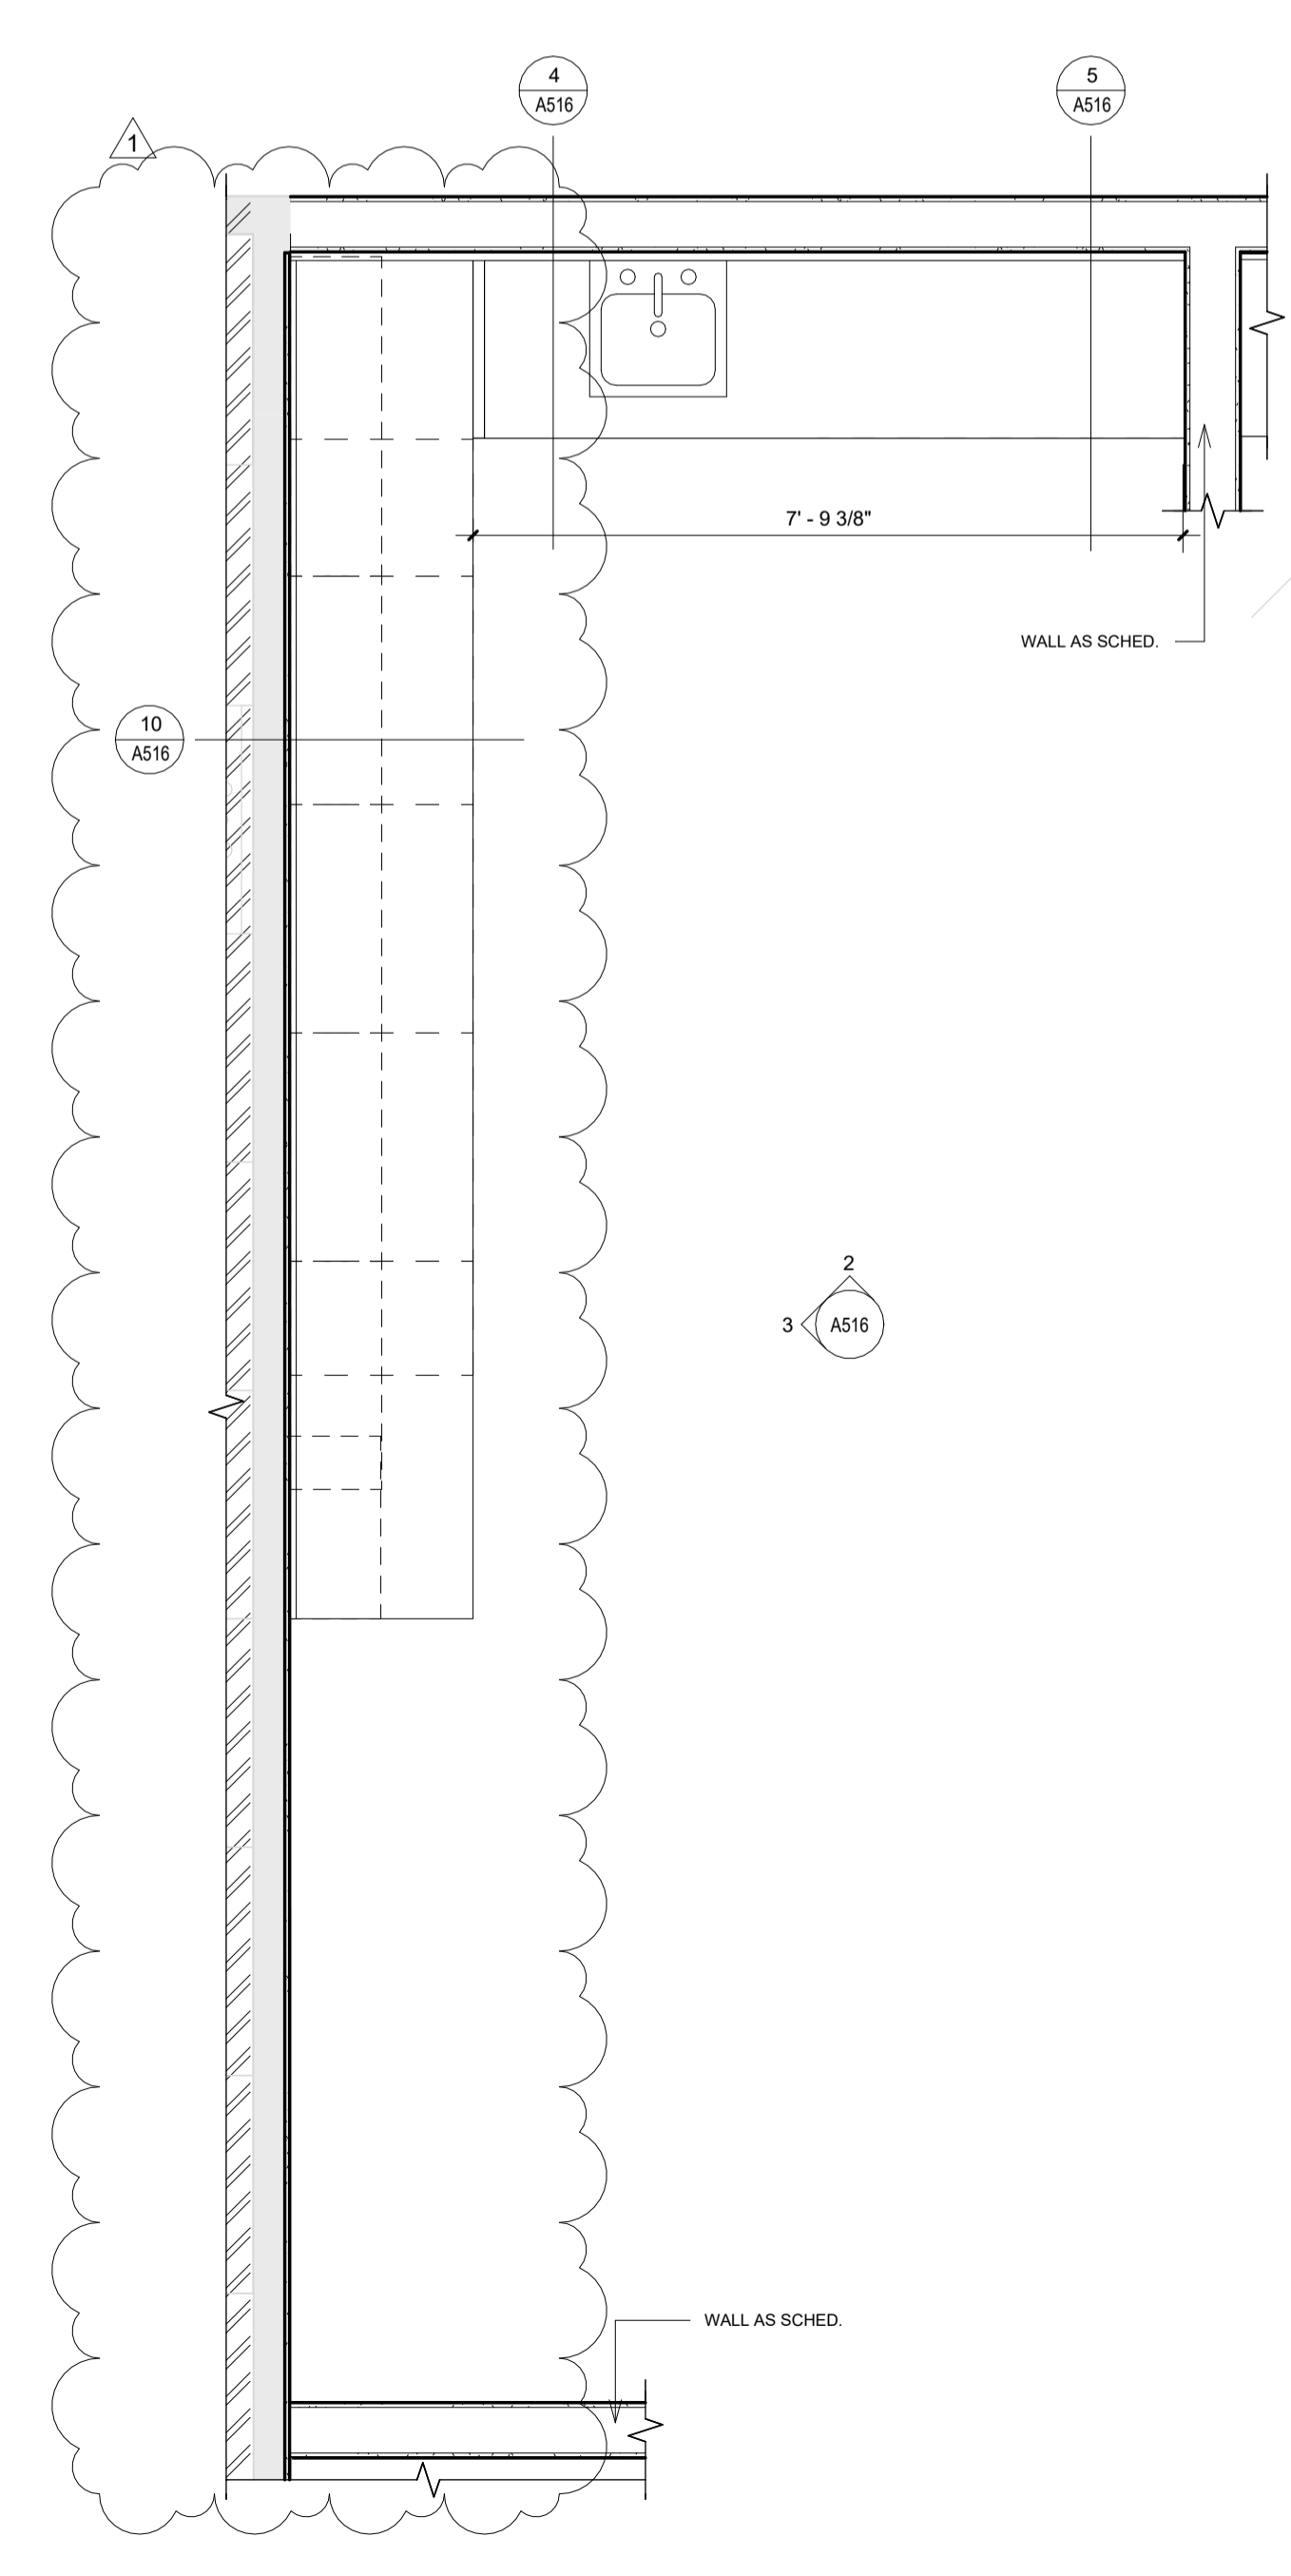

1 M4 - SUPPLIES CABINETS PLAN
A516 / 1/2" = 1'-0"

**GENETIC SCIENCE
LEARNING CENTER**

CONSTRUCTION DOCUMENTS

DFCM SEAL

No	Description	Date
1	ADDENDUM 1	12/20/2024



GSCLC
296 CHIPETA WAY
SALT LAKE CITY, UT 84108


22812
10.30.2024
MILLWORK

A516
Scale As indicated

ELEV. LEGEND

- P1 = PAINT, COLOR: 7566 WESTHIGHLAND WHITE
- P2 = PAINT, COLOR: 8484 LAKESHORE
- F1 = FELT, COLOR: GREEN
- F2 = FELT, COLOR: PINK
- F3 = FELT, COLOR: PURPLE
- F4 = FELT, COLOR: ORANGE
- RP1 = RESIN PANEL, COLOR: KILT + WHITE OUT
- L1 = LAMINATE, COLOR: AGED ASH
- L2 = LAMINATE, COLOR: HUNTER GREEN
- TL1 = LAMINATE TEXTURED PANEL, FINISH: FILA, SALINAS OAK
- TF1 = FELT TEXTURED PANEL, FINISH: BOLLA, MIDNIGHT
- WS1 = WOOD SCREEN, SPECIES/FINISH: AMERICAN OAK / NATURAL
- SS1 = SOLID SURFACE COUNTERTOP, COLOR: FROSTY WHITE MIRAGE
- UP1 = UPHOLSTERY, COLOR: NICO 016 POSH
- RB1 = RUBBER BASE, COLOR: TG2 SHARK FIN
- RB2 = RUBBER BASE, COLOR: GREY WG
- GW1 = GLASS WALL, SEE SPEC.
- GW2 = GLASS WALL, SEE SPEC.
- MB1 = MARKER BOARD 4'x6', SEE SPEC.
- TD = TOWEL DISPENSER BY OWNER, PROVIDE BLOCKING IN WALLS
- SD = SOAP DISPENSER BY OWNER, PROVIDE BLOCKING IN WALLS

331 S RIO GRANDE ST
SUITE 307
SLC, UT 84101
PH: 8017395569
BAYLEE@STUDIOARCH.COM

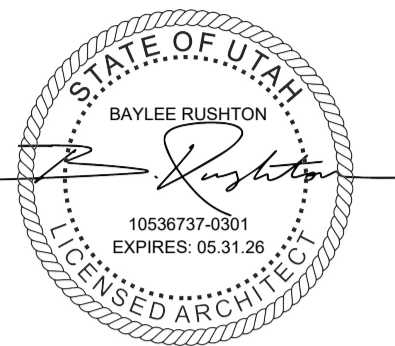

**GENETIC SCIENCE
LEARNING CENTER**

CONSTRUCTION DOCUMENTS

DFCM SEAL

No	Description	Date
1	ADDENDUM 1	12/20/2024




GSCLC
296 CHIPETA WAY
SALT LAKE CITY, UT 84108


22812
10.30.2024

MILLWORK


A517
Scale As indicated

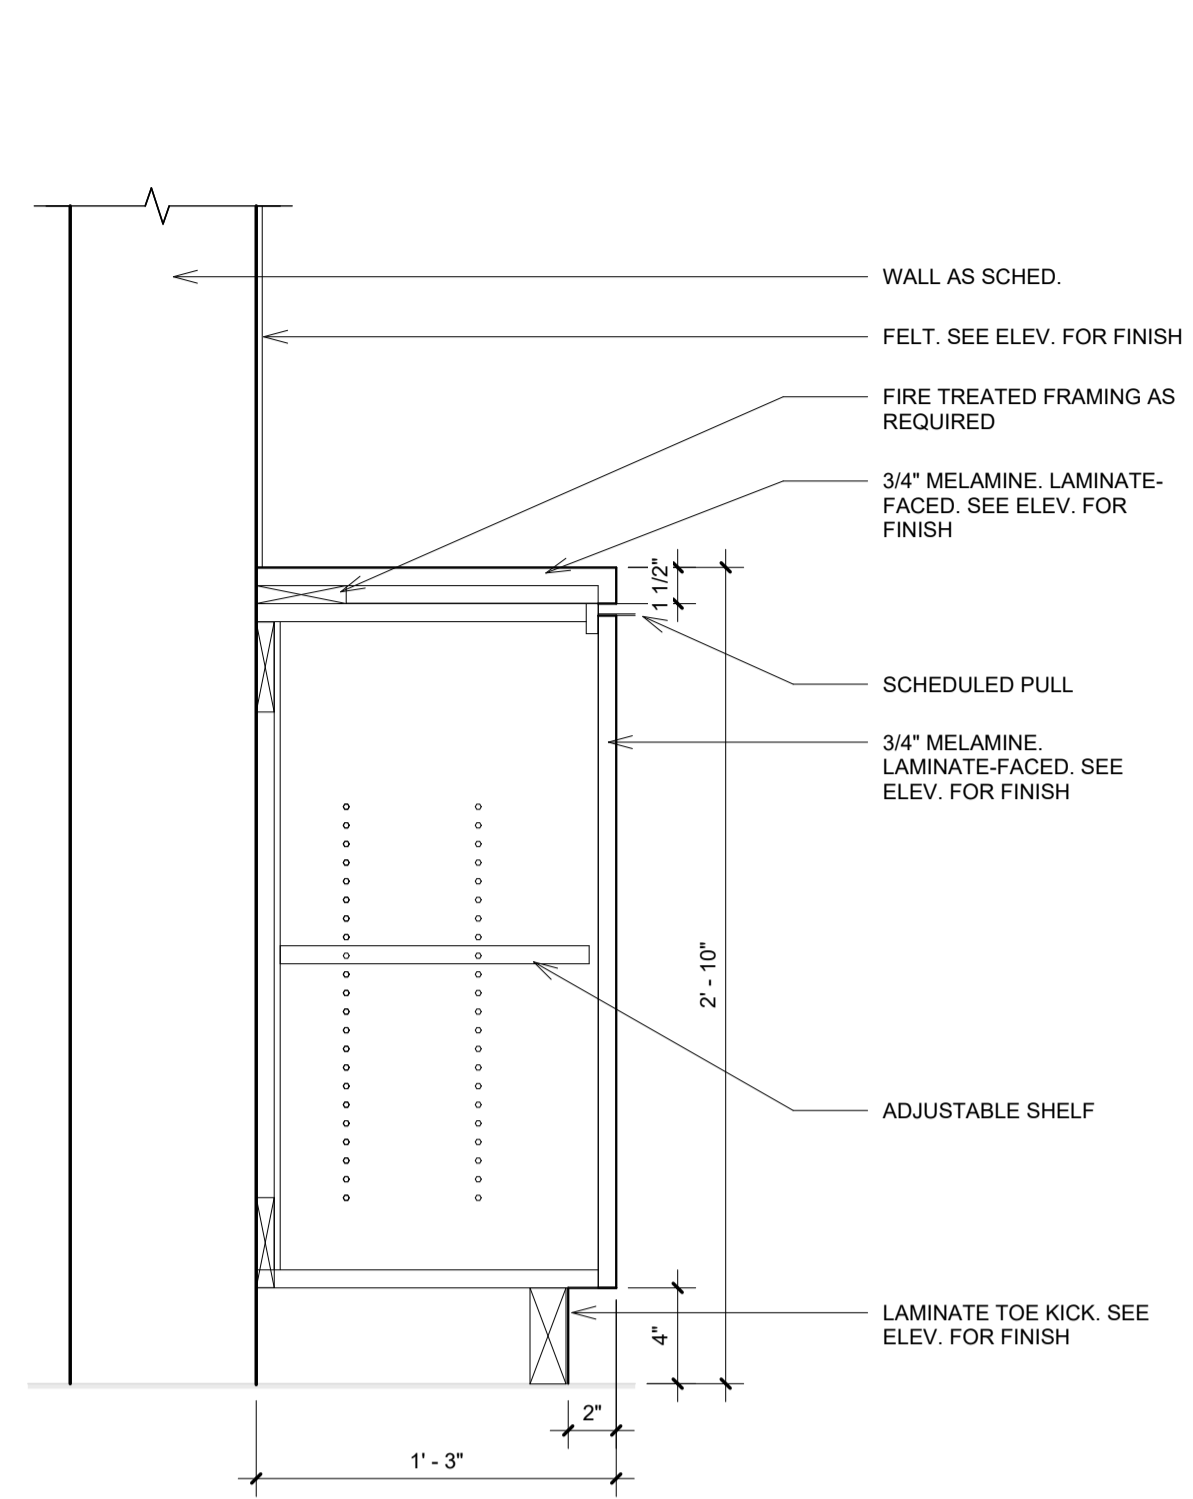


12 M11 - TOUCHDOWN CABINETS DETAIL
AS17 1/2" = 1'-0"

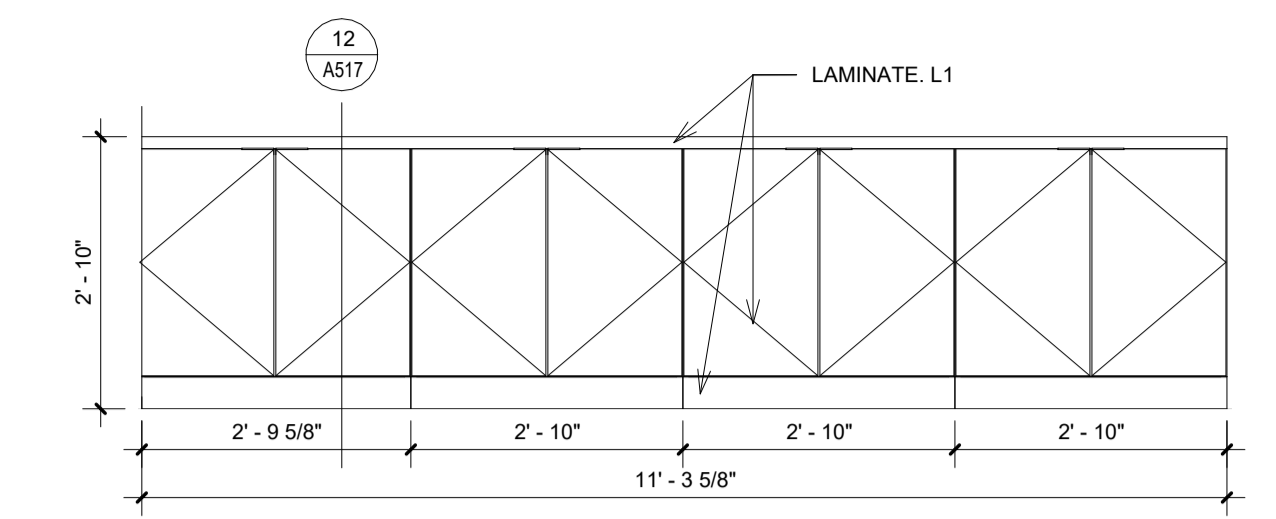


9 M11 - TOUCHDOWN CABINETS ELEV.
AS17 1/2" = 1'-0"

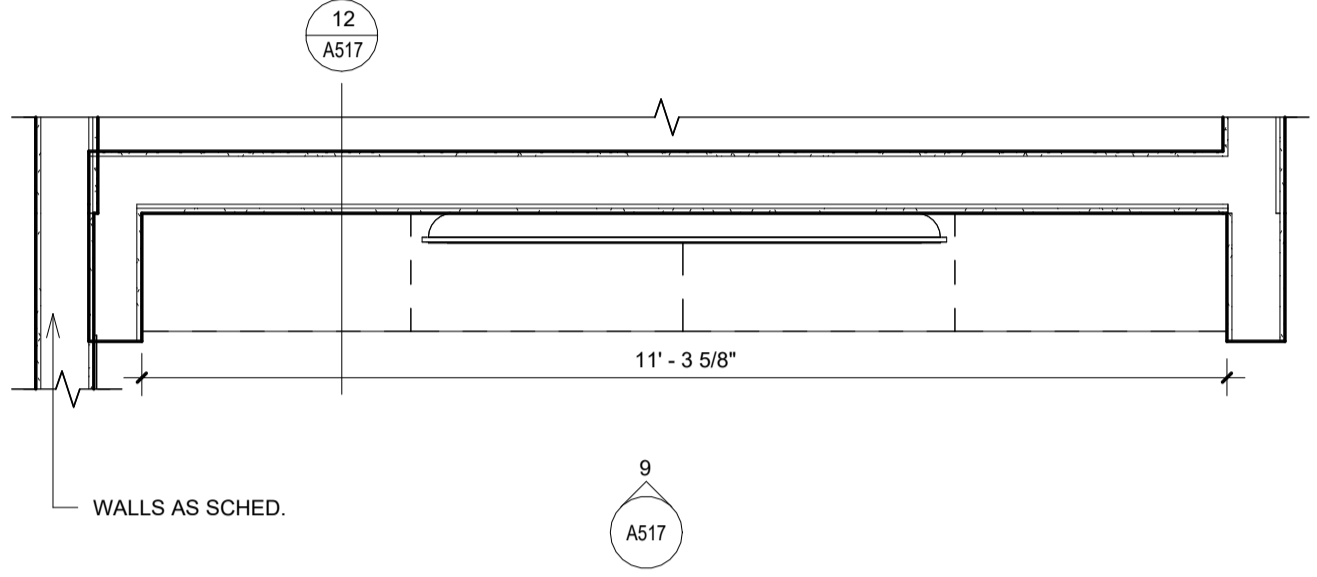


8 M11 - TOUCHDOWN CABINETS PLAN
AS17 1/2" = 1'-0"

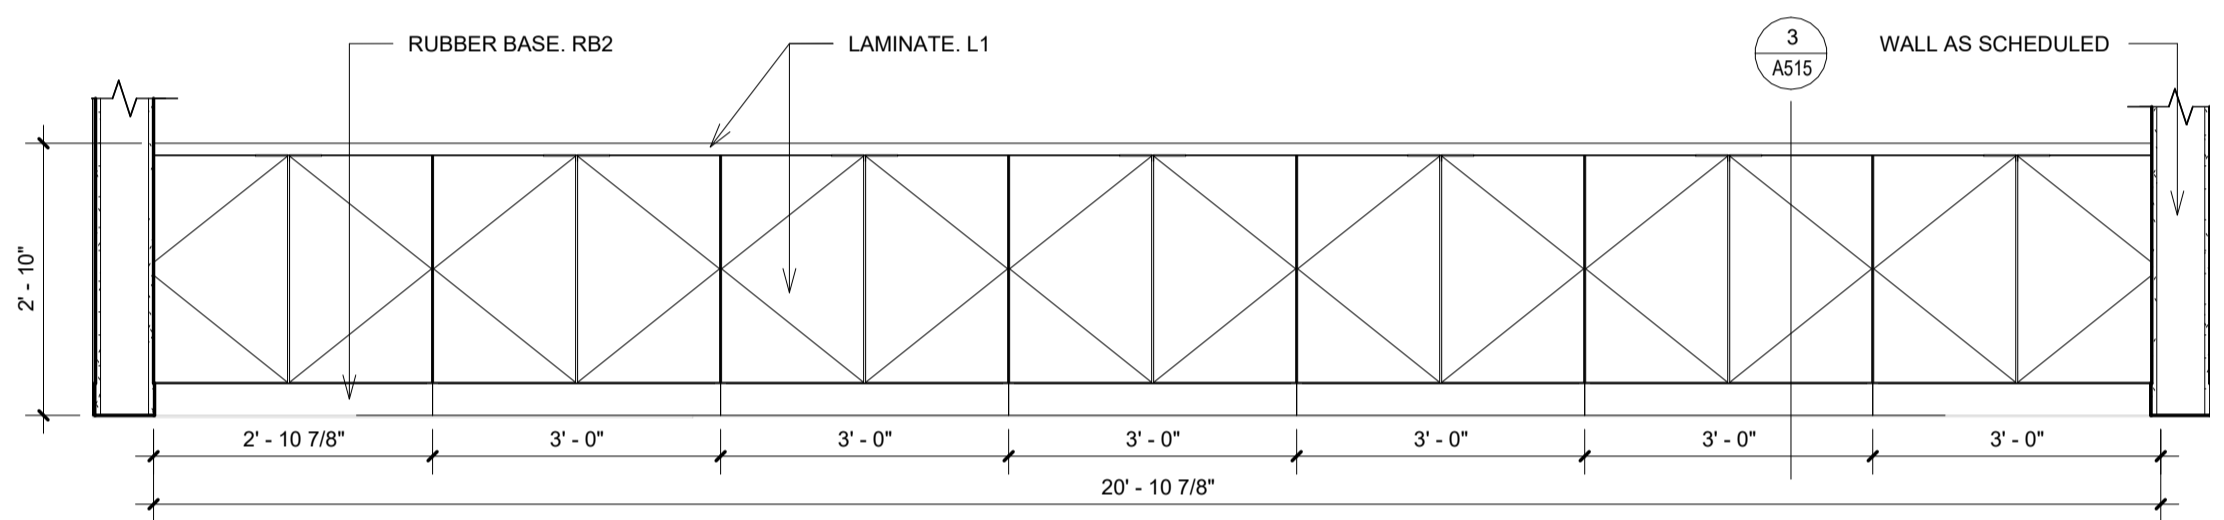


7 M9 - MEDIA REVIEW CABINETS ELEV.
AS17 1/2" = 1'-0"

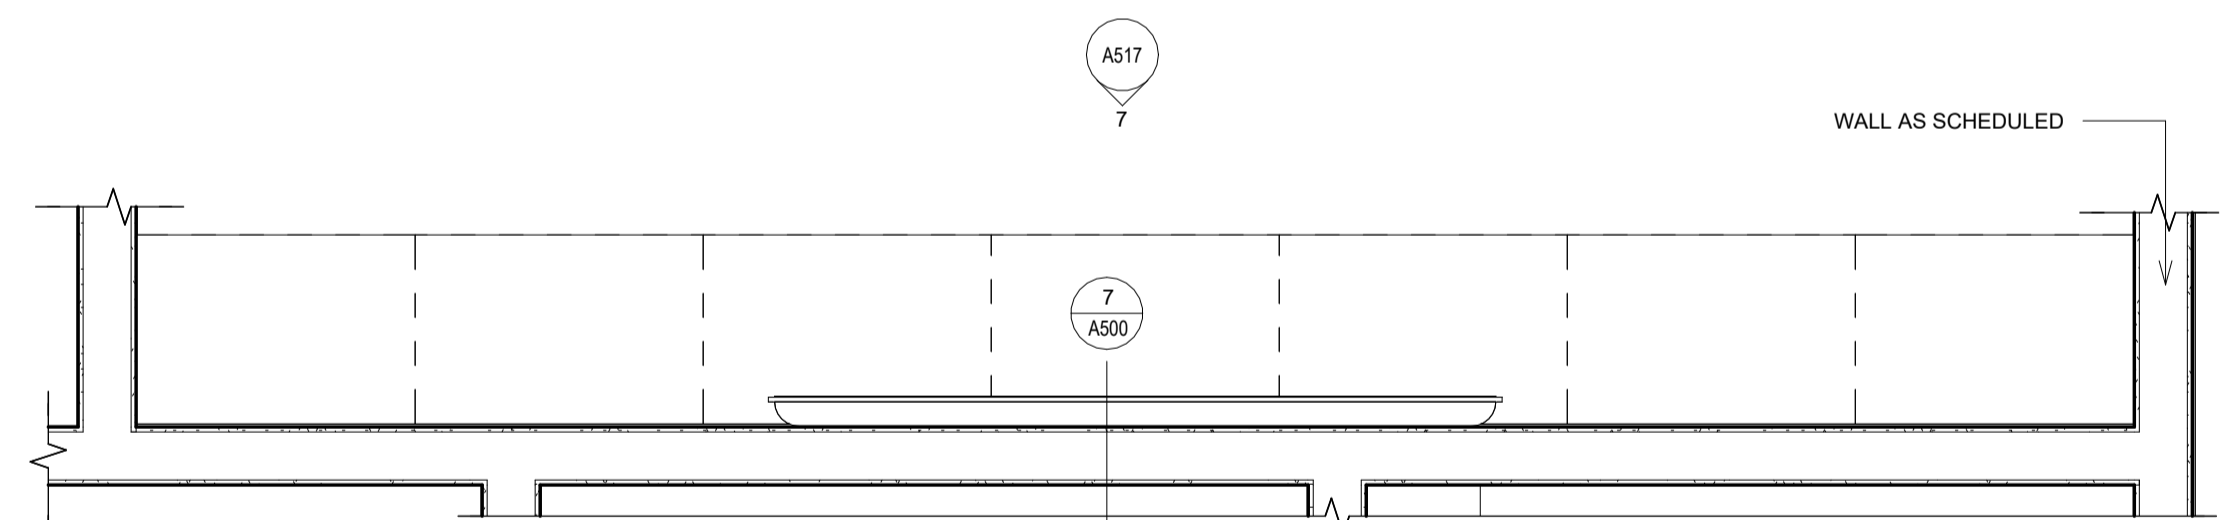


6 M9 - MEDIA REVIEW CABINETS PLAN
AS17 1/2" = 1'-0"

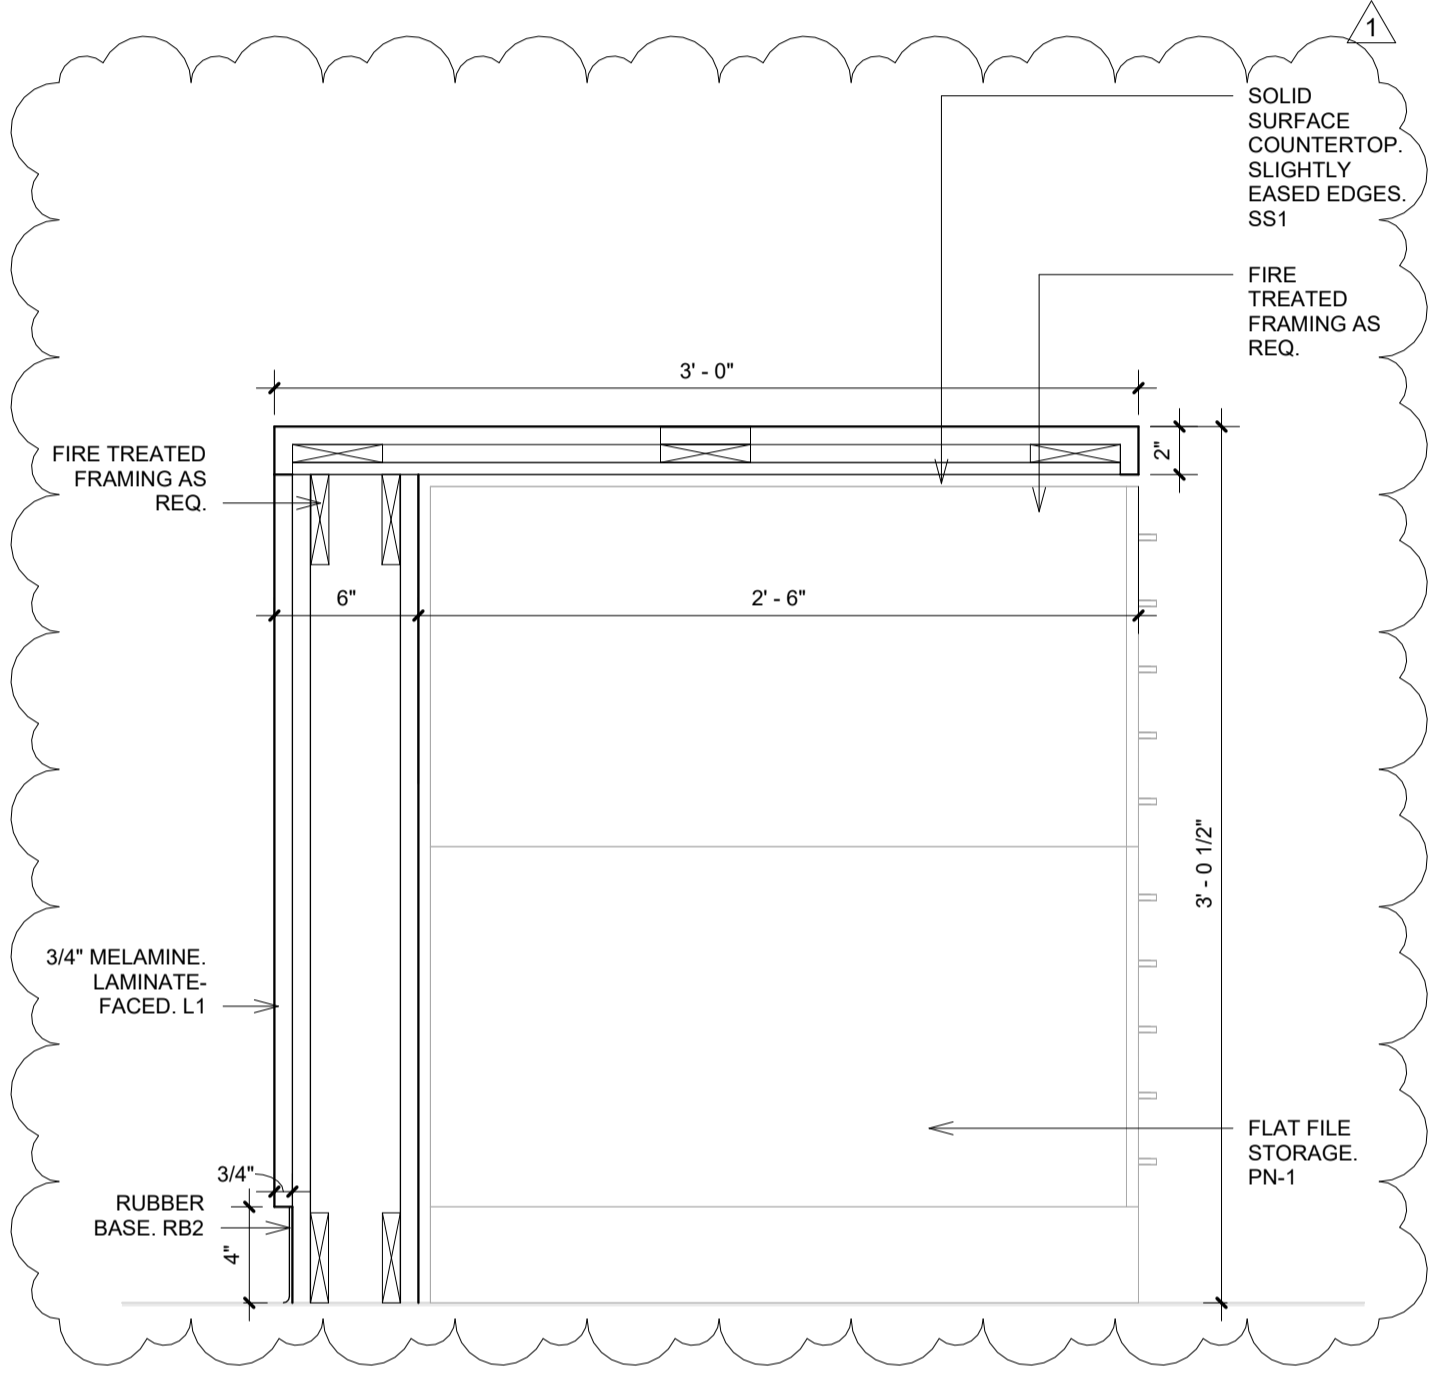


4 M8 - PRINT MEDIA ISLAND DETAIL 1
AS17 1 1/2" = 1'-0"

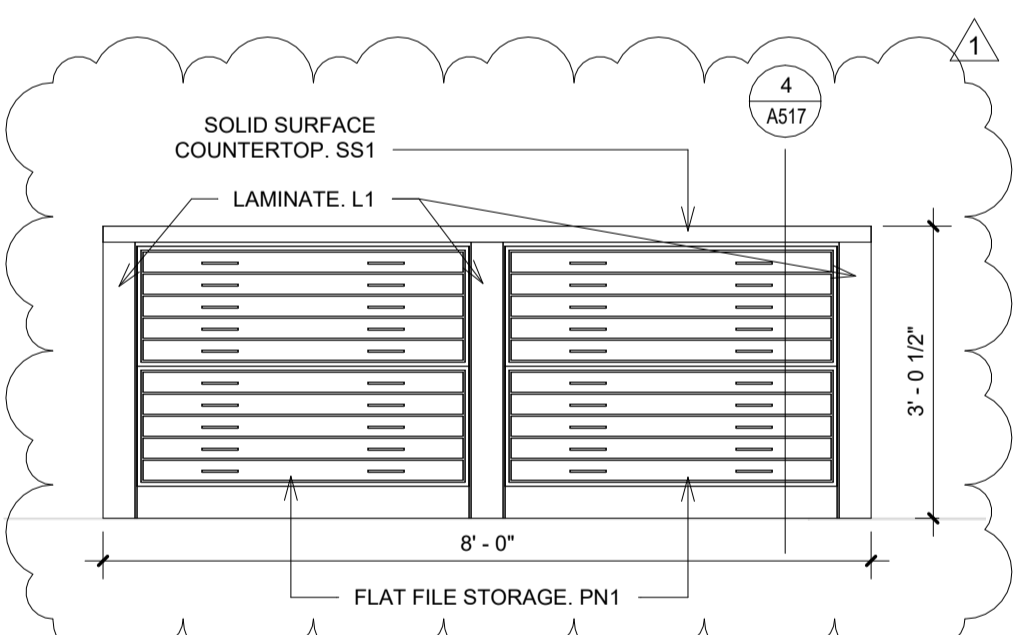


3 M8 - MEDIA ISLAND SOUTH ELEV.
AS17 1/2" = 1'-0"

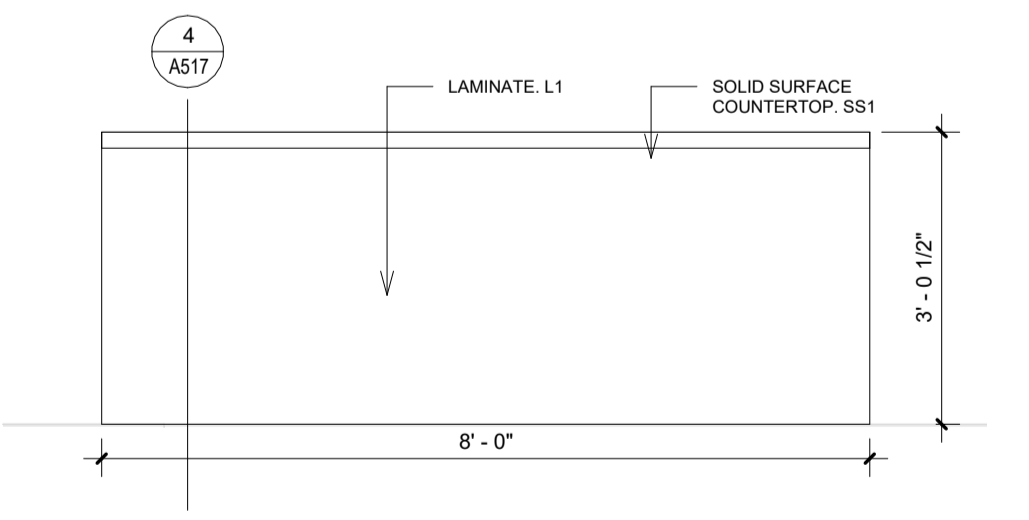


2 M8 - PRINT MEDIA ISLAND NORTH ELEV.
AS17 1/2" = 1'-0"

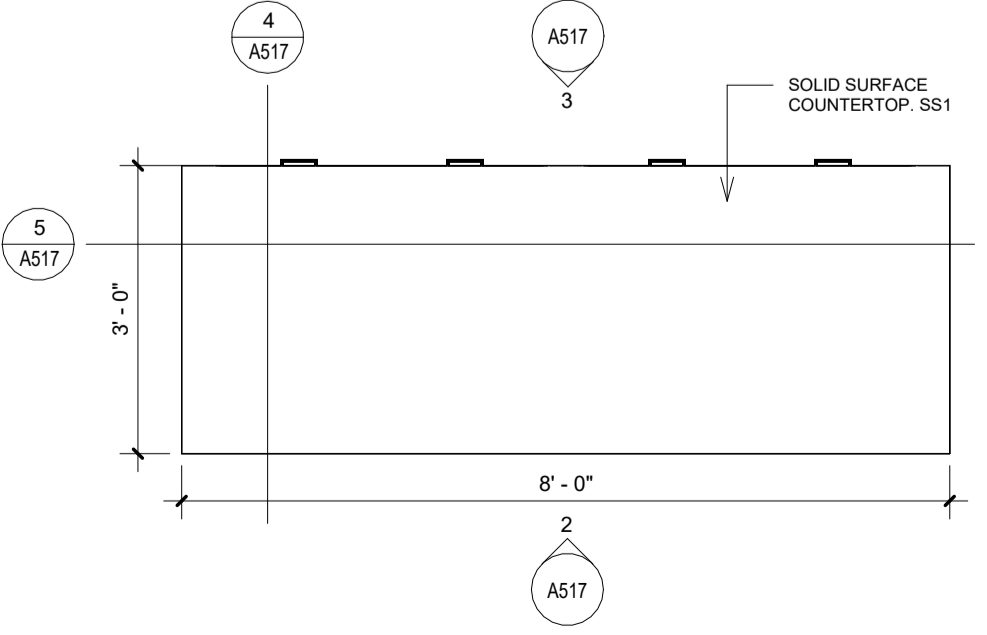


1 M8 - PRINT MEDIA ISLAND PLAN
AS17 1/2" = 1'-0"

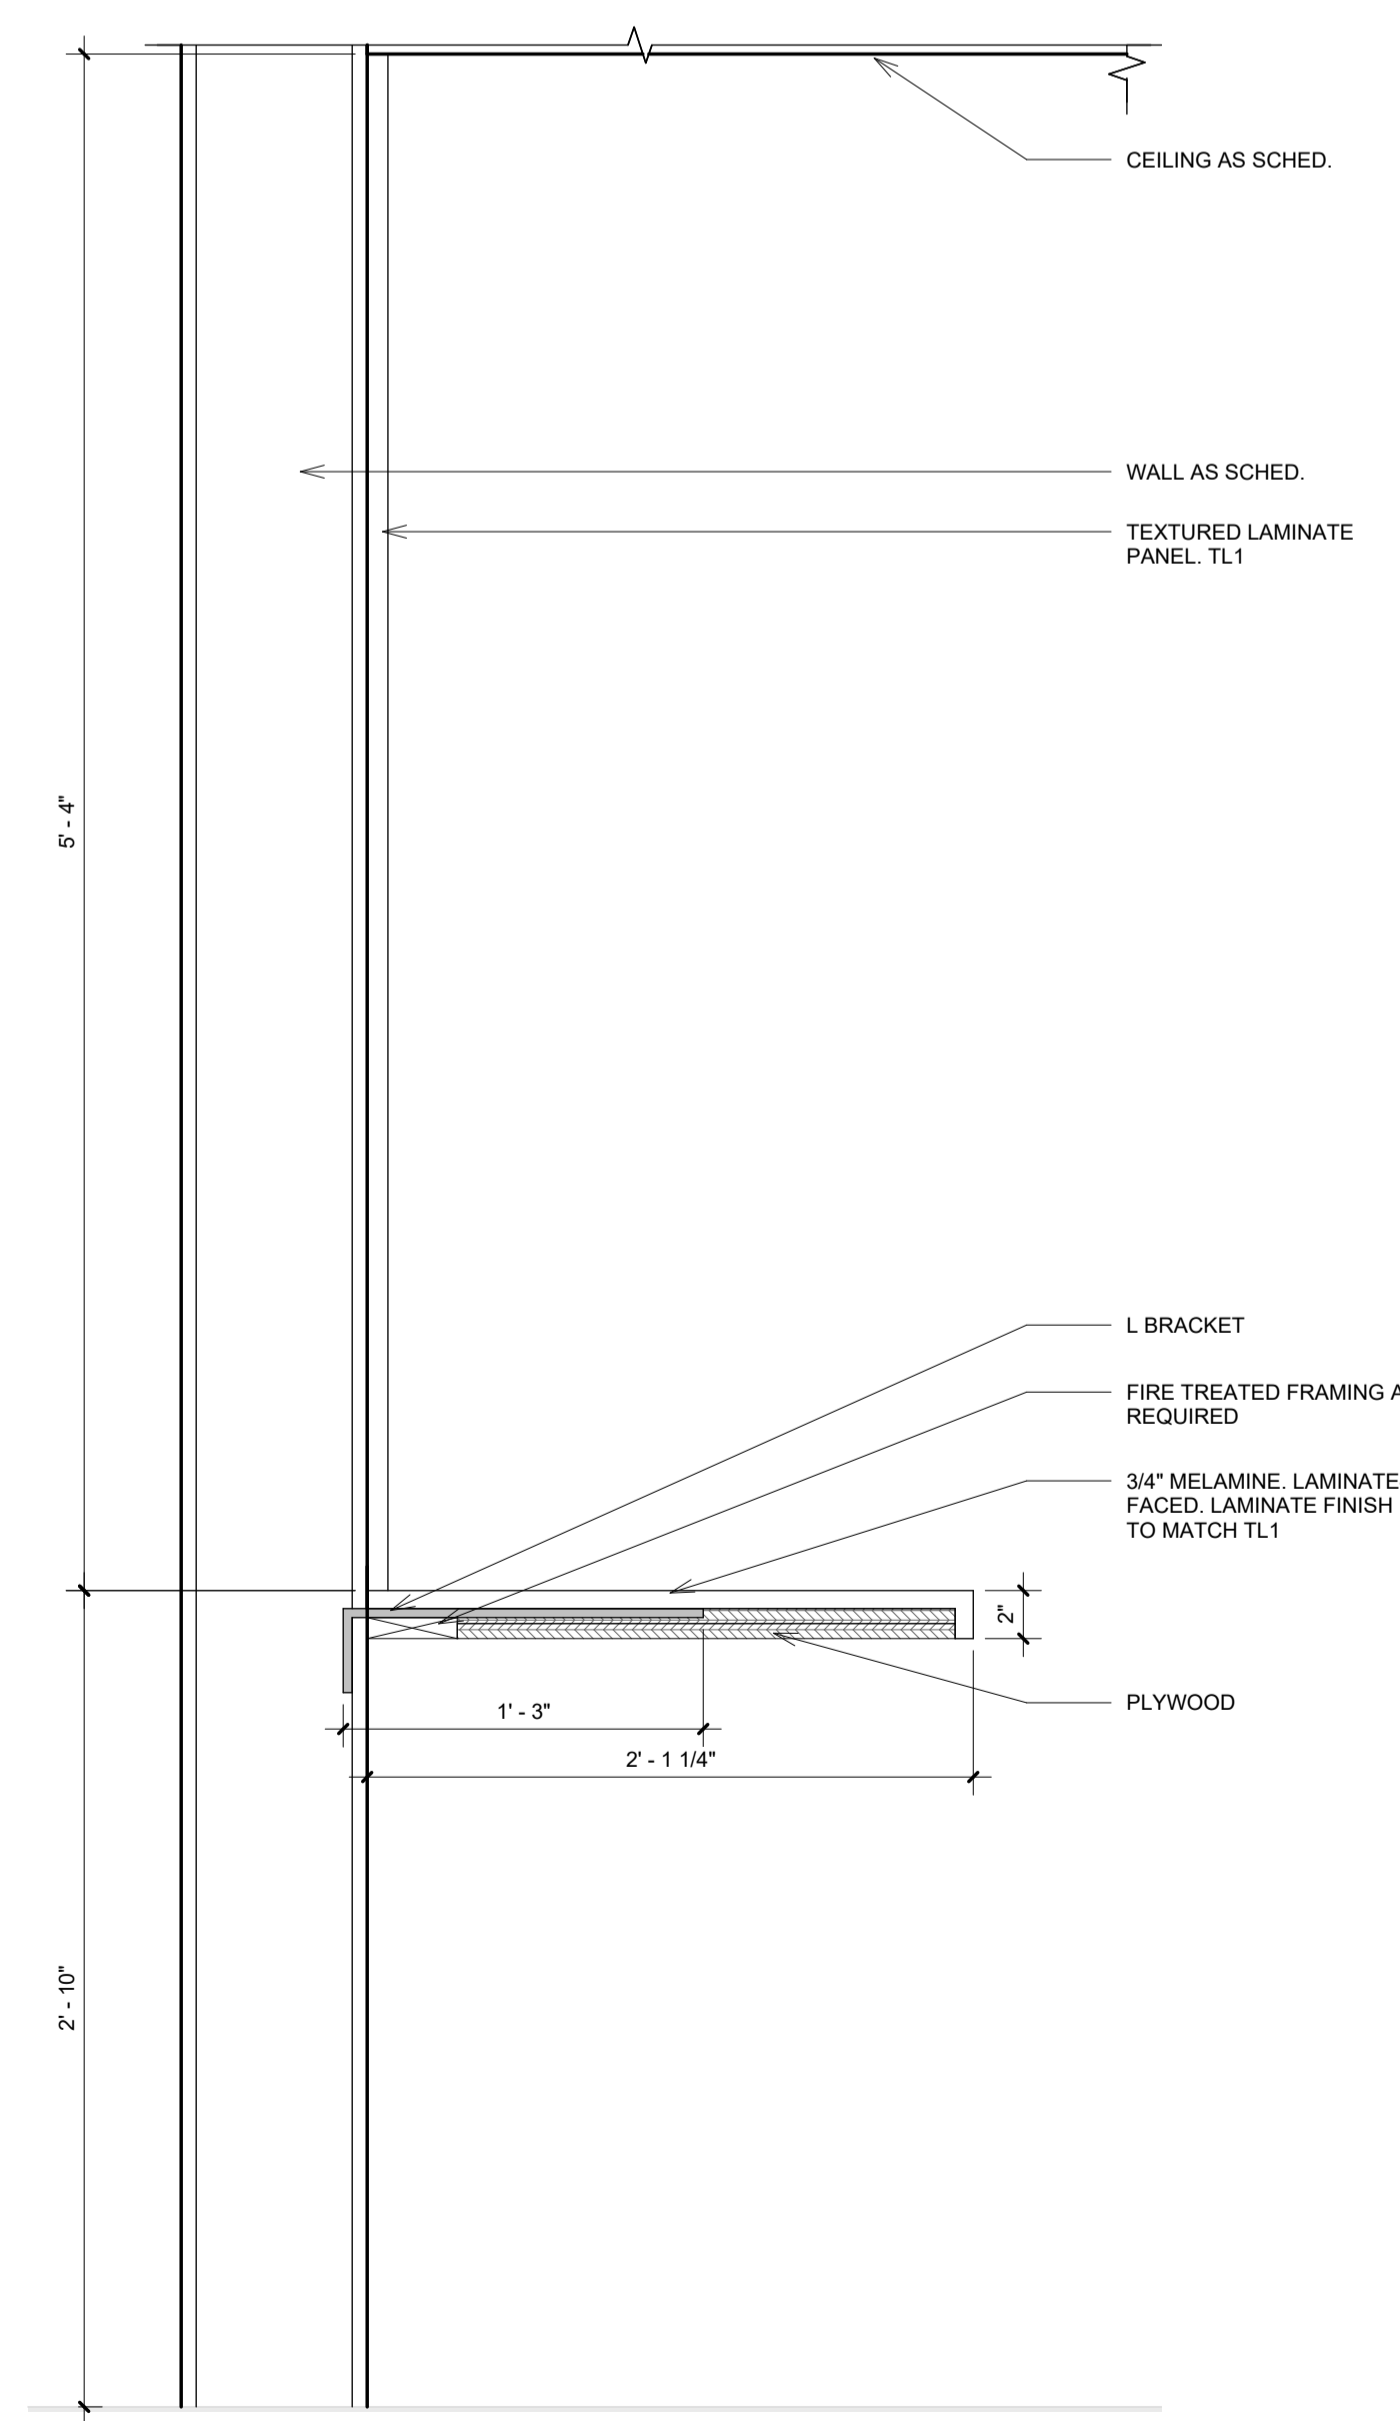


13 M10 - PHONE BOOTH DESK DETAIL
AS17 1 1/2" = 1'-0"

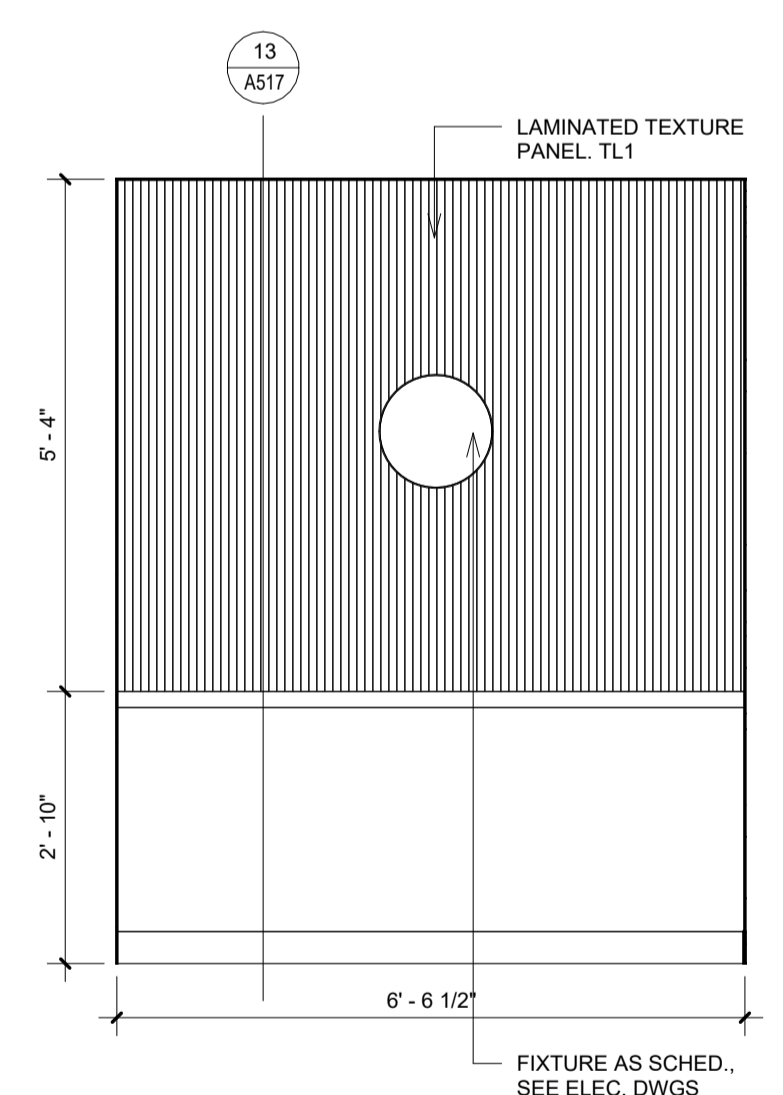


11 M10 - PHONE BOOTH DESK ELEV.
AS17 1/2" = 1'-0"

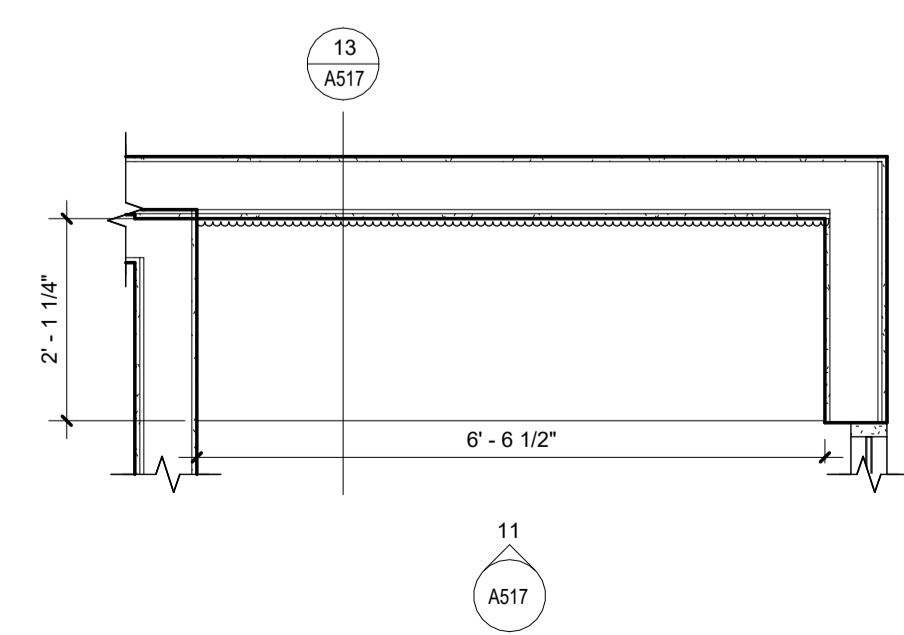

10 M10 - PHONE BOOTH DESK PLAN
AS17 1/2" = 1'-0"

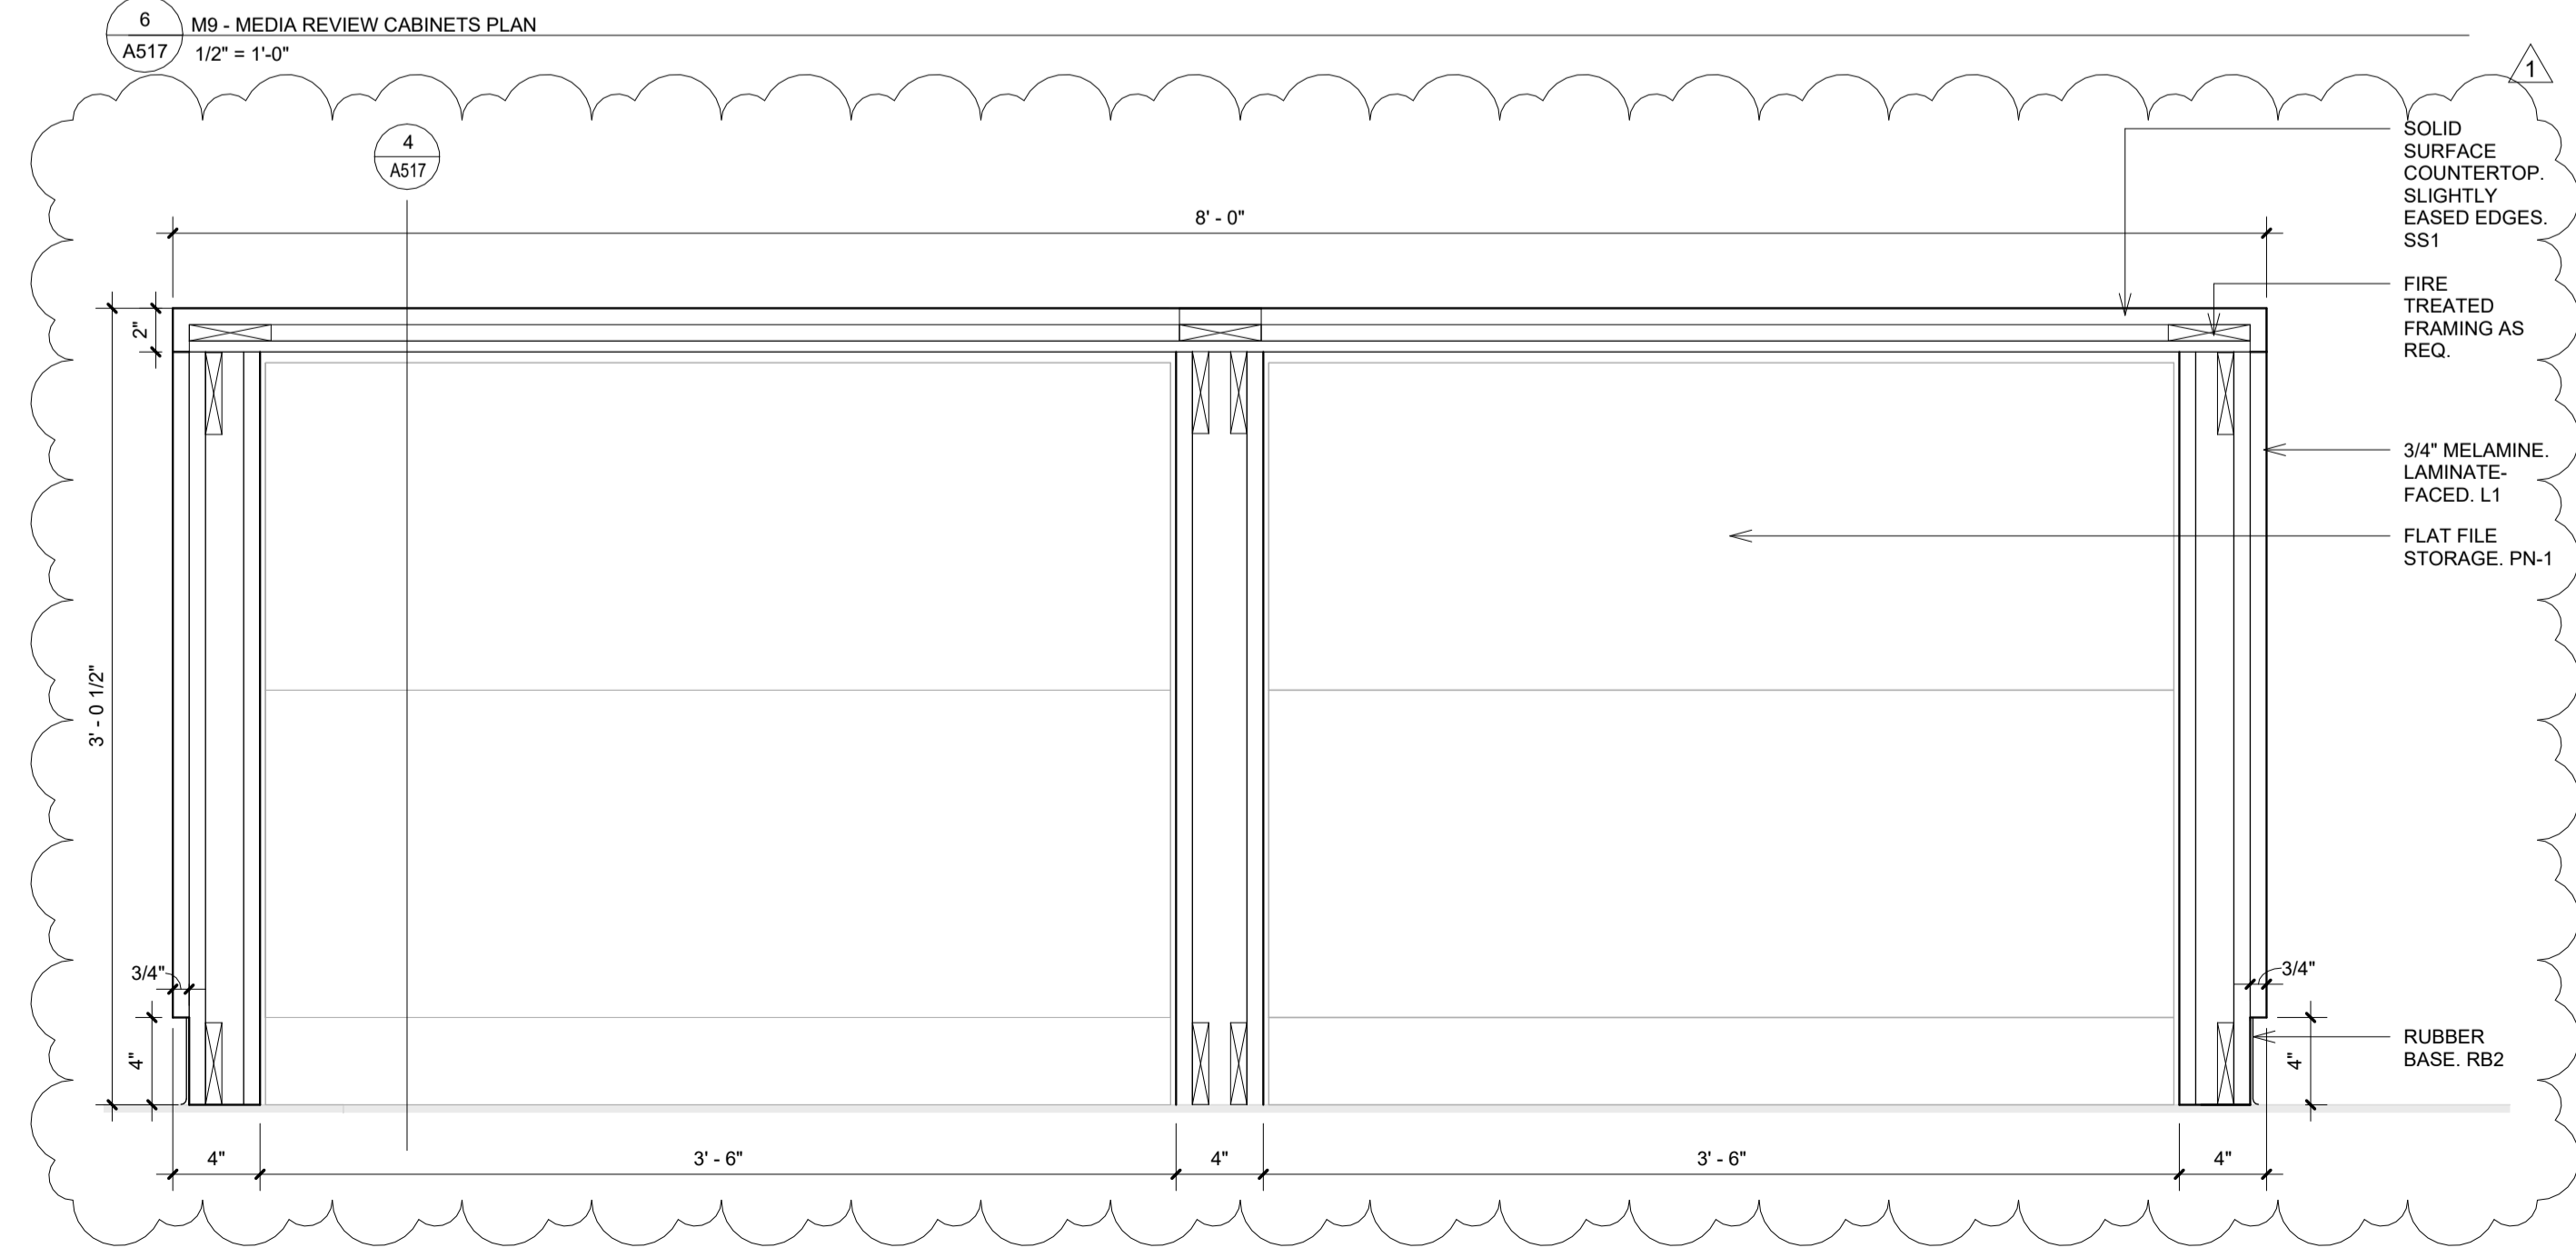

5 M8 - PRINT MEDIA ISLAND DETAIL 2
AS17 1 1/2" = 1'-0"

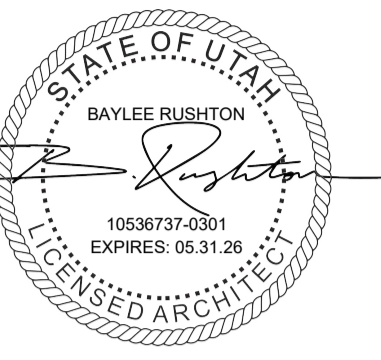

**GENETIC SCIENCE
LEARNING CENTER**

CONSTRUCTION DOCUMENTS

DFCM SEAL

No	Description	Date
1	ADDENDUM 1	12/20/2024




GLSC
295 CHIPETA WAY
SALT LAKE CITY, UT 84108

22812
10.30.2024


DOOR + WINDOW
DETAILS

A601


Scale As indicated

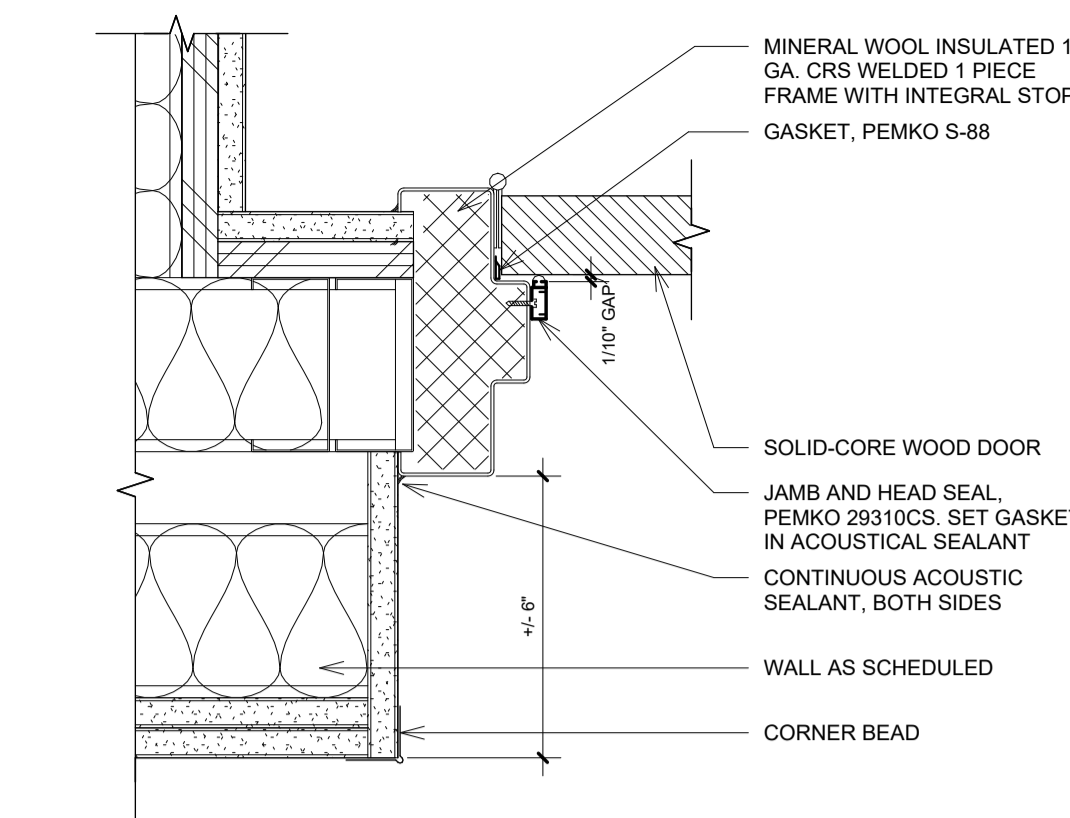


12 DOOR FRAME AT ACOUSTICAL DOOR
A601 3' = 1'-0"

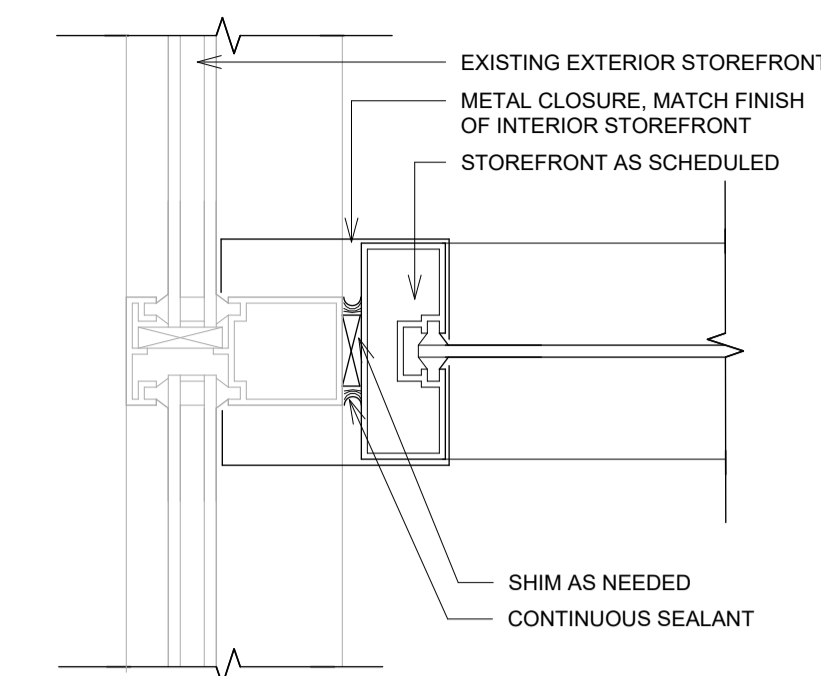


6 STOREFRONT JAMB @ EXTERIOR STOREFRONT
A601 3' = 1'-0" BID ALTERNATE 2

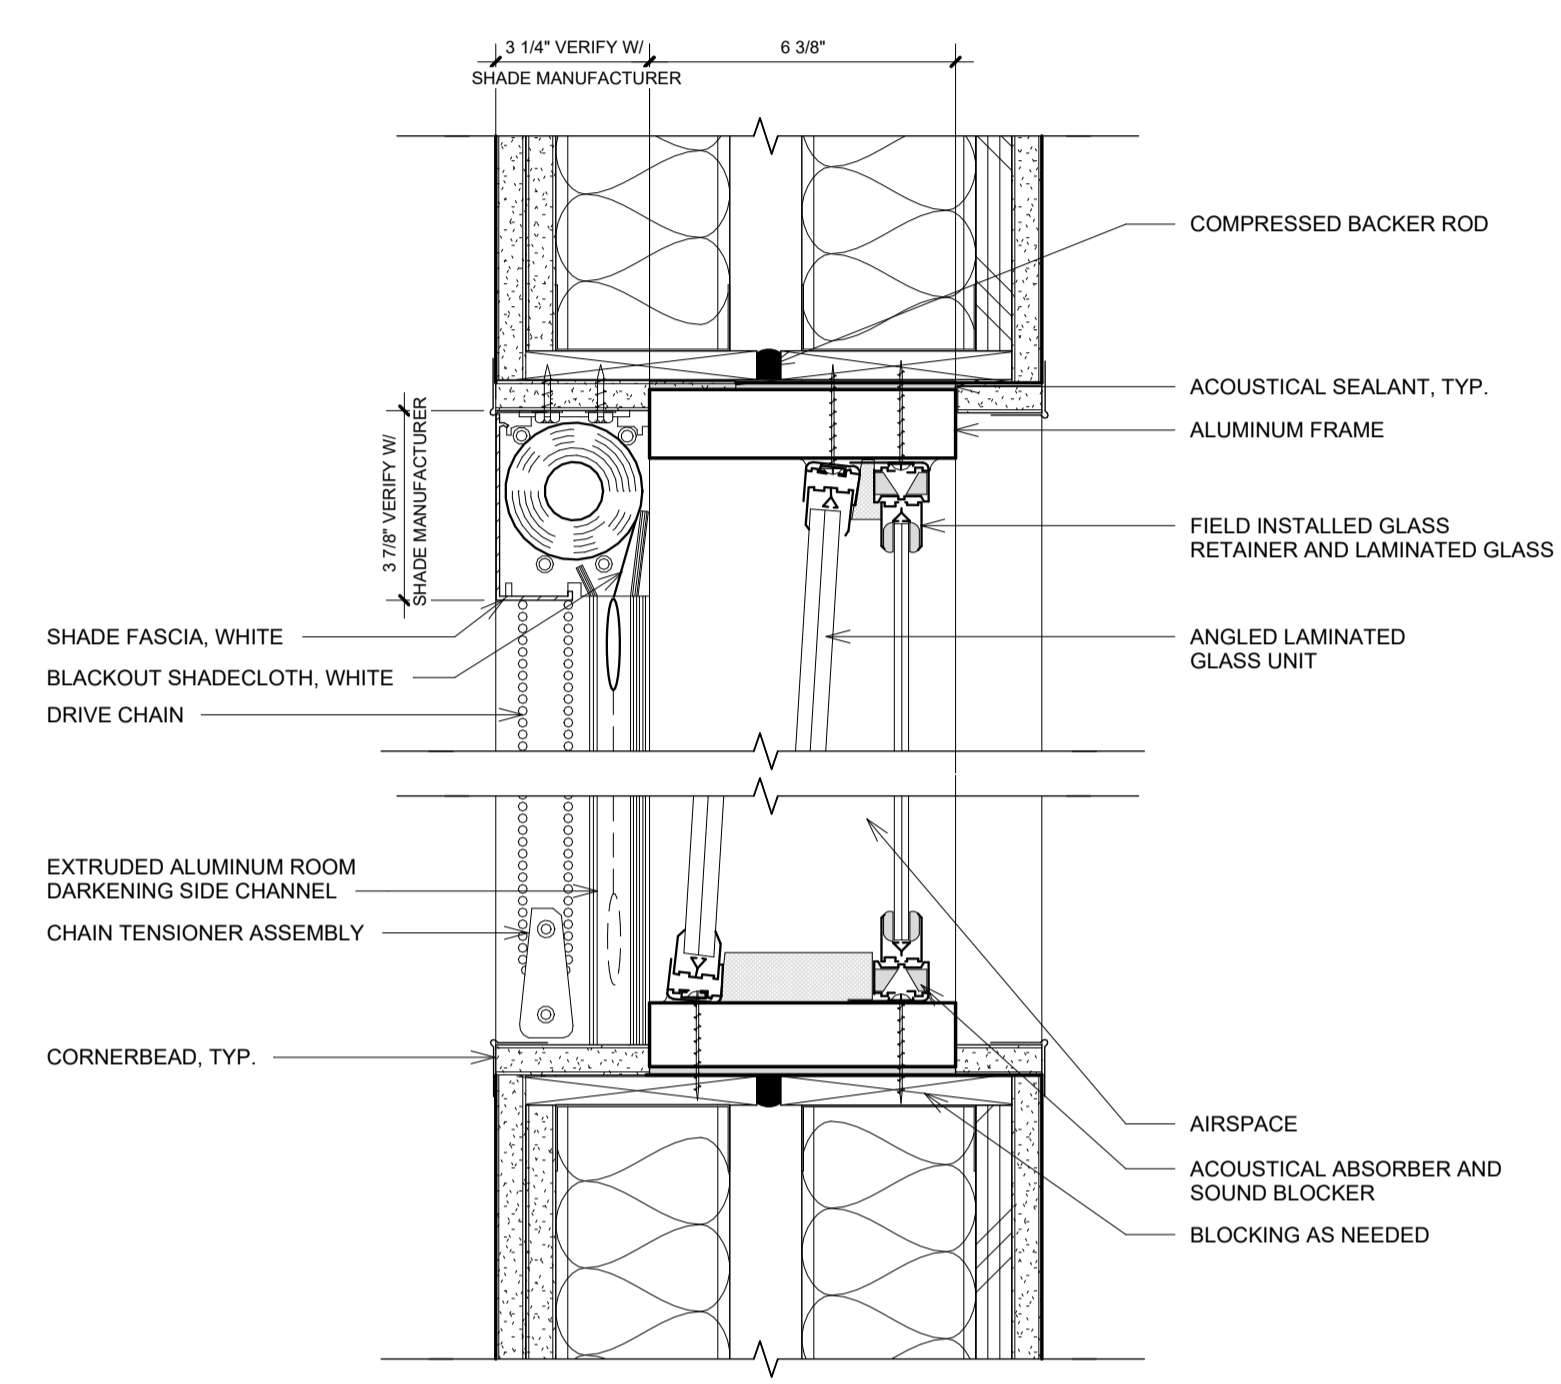


14 ACOUSTIC WINDOW
A601 3' = 1'-0" STC 55

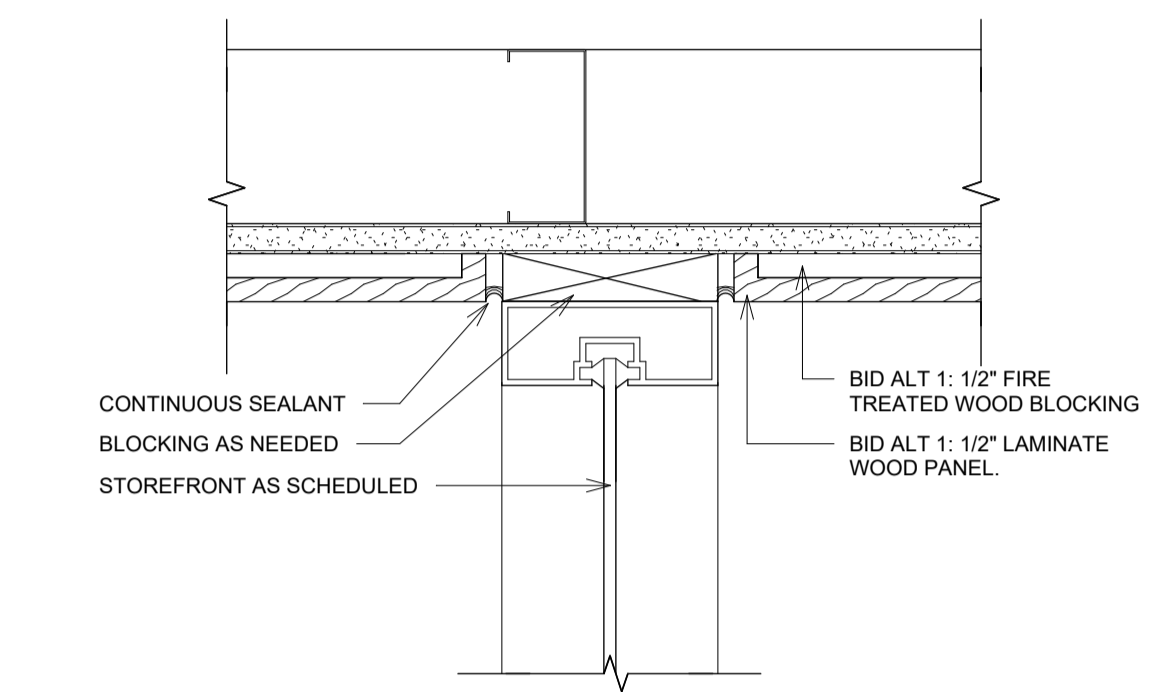


11 STOREFRONT JAMB AT LAMINATE
A601 3' = 1'-0" BID ALTERNATE 1

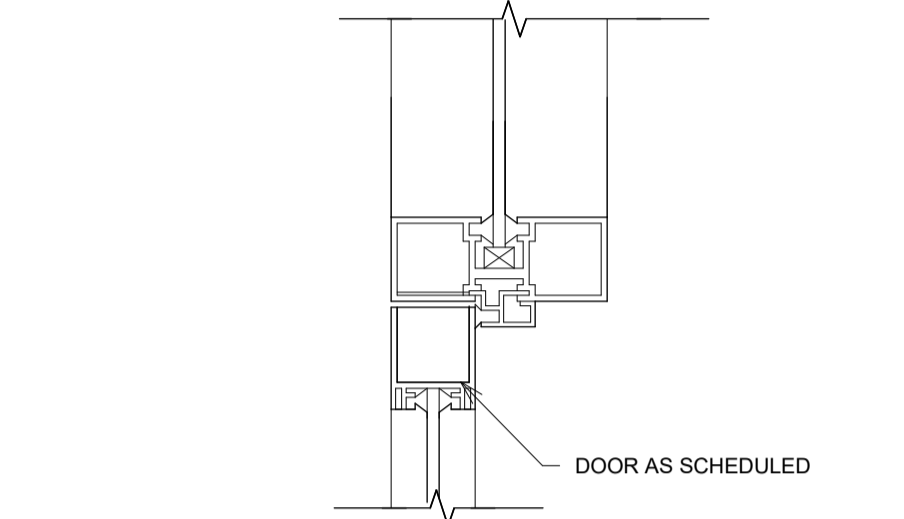


5 STOREFRONT DOOR HEAD
A601 3' = 1'-0"

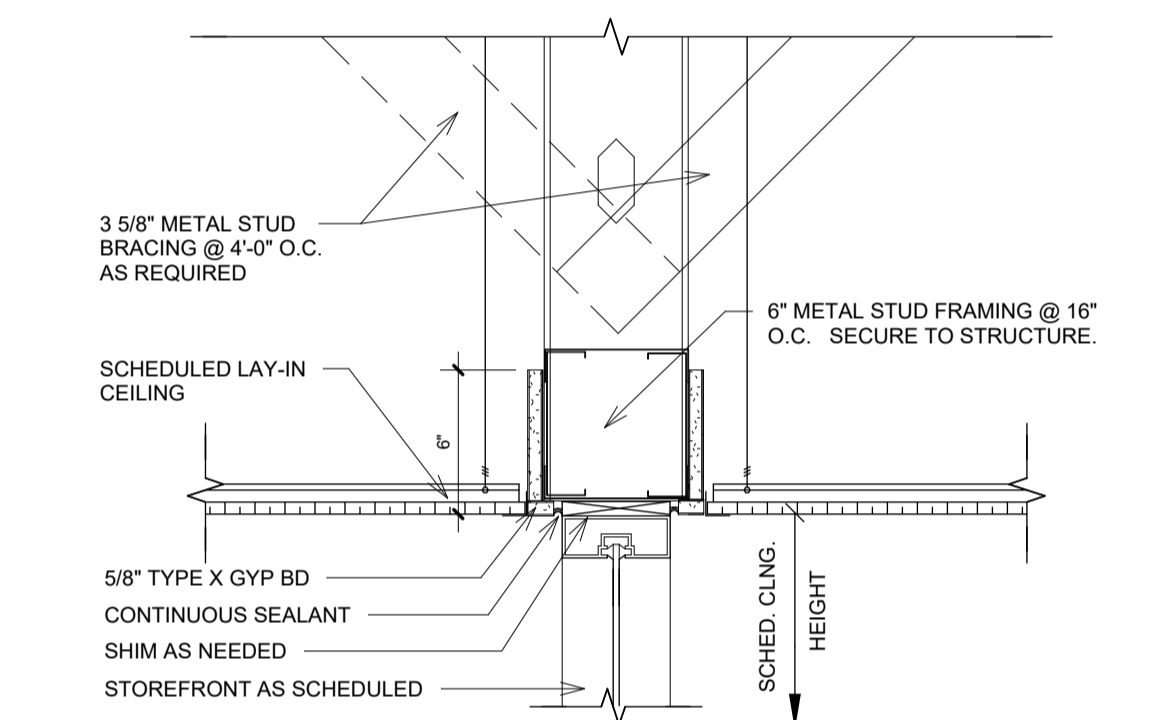


10 STOREFRONT @ ACT
A601 1 1/2" = 1'-0"

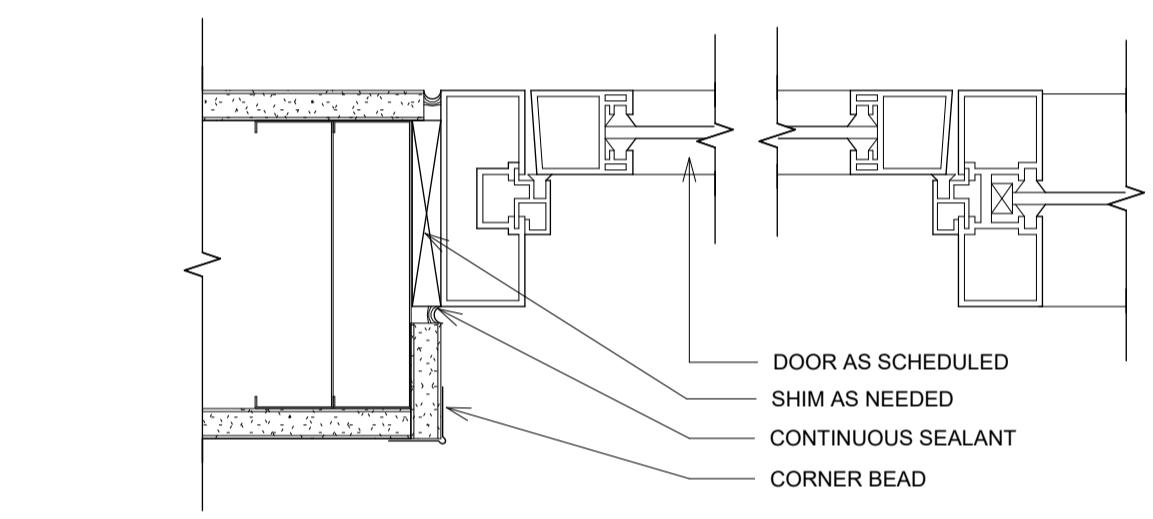


4 STOREFRONT DOOR JAMB
A601 3' = 1'-0"

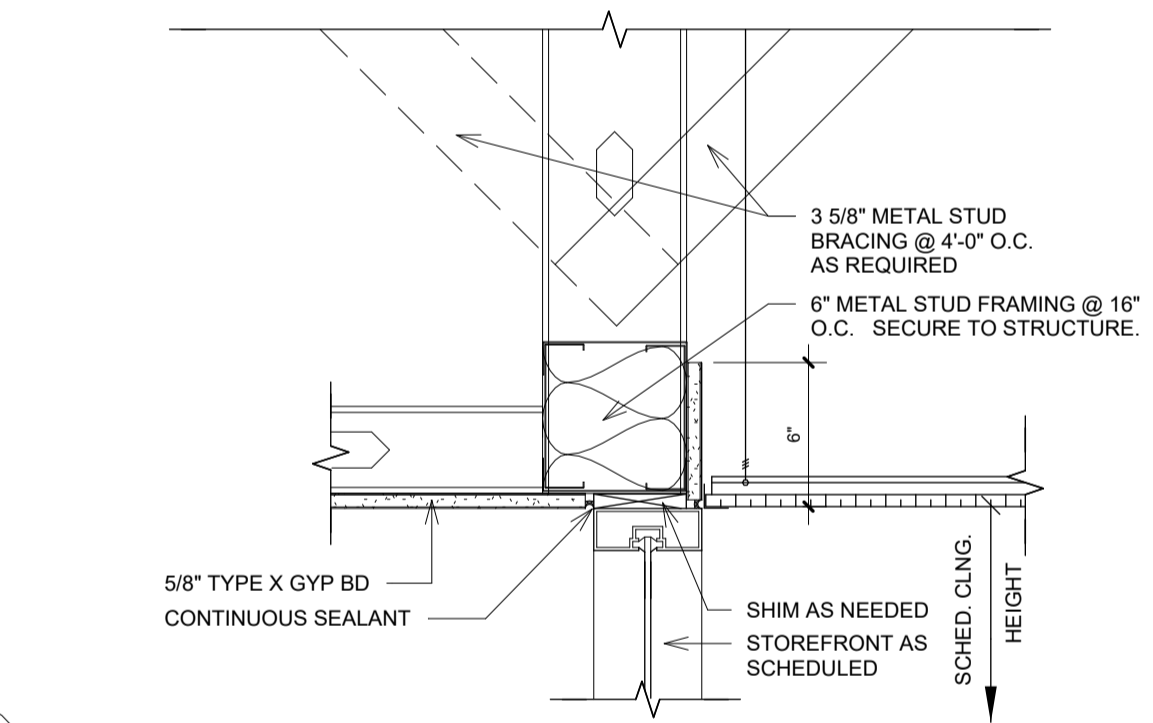


9 STOREFRONT @ ACT & GYP
A601 1 1/2" = 1'-0"

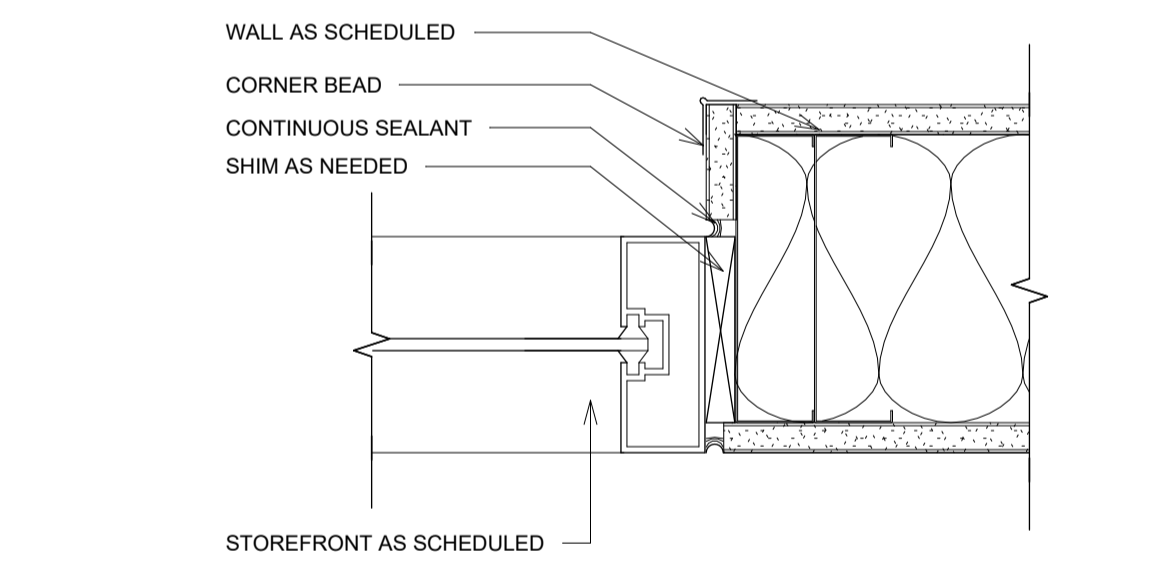


3 TYPICAL STOREFRONT JAMB
A601 3' = 1'-0"

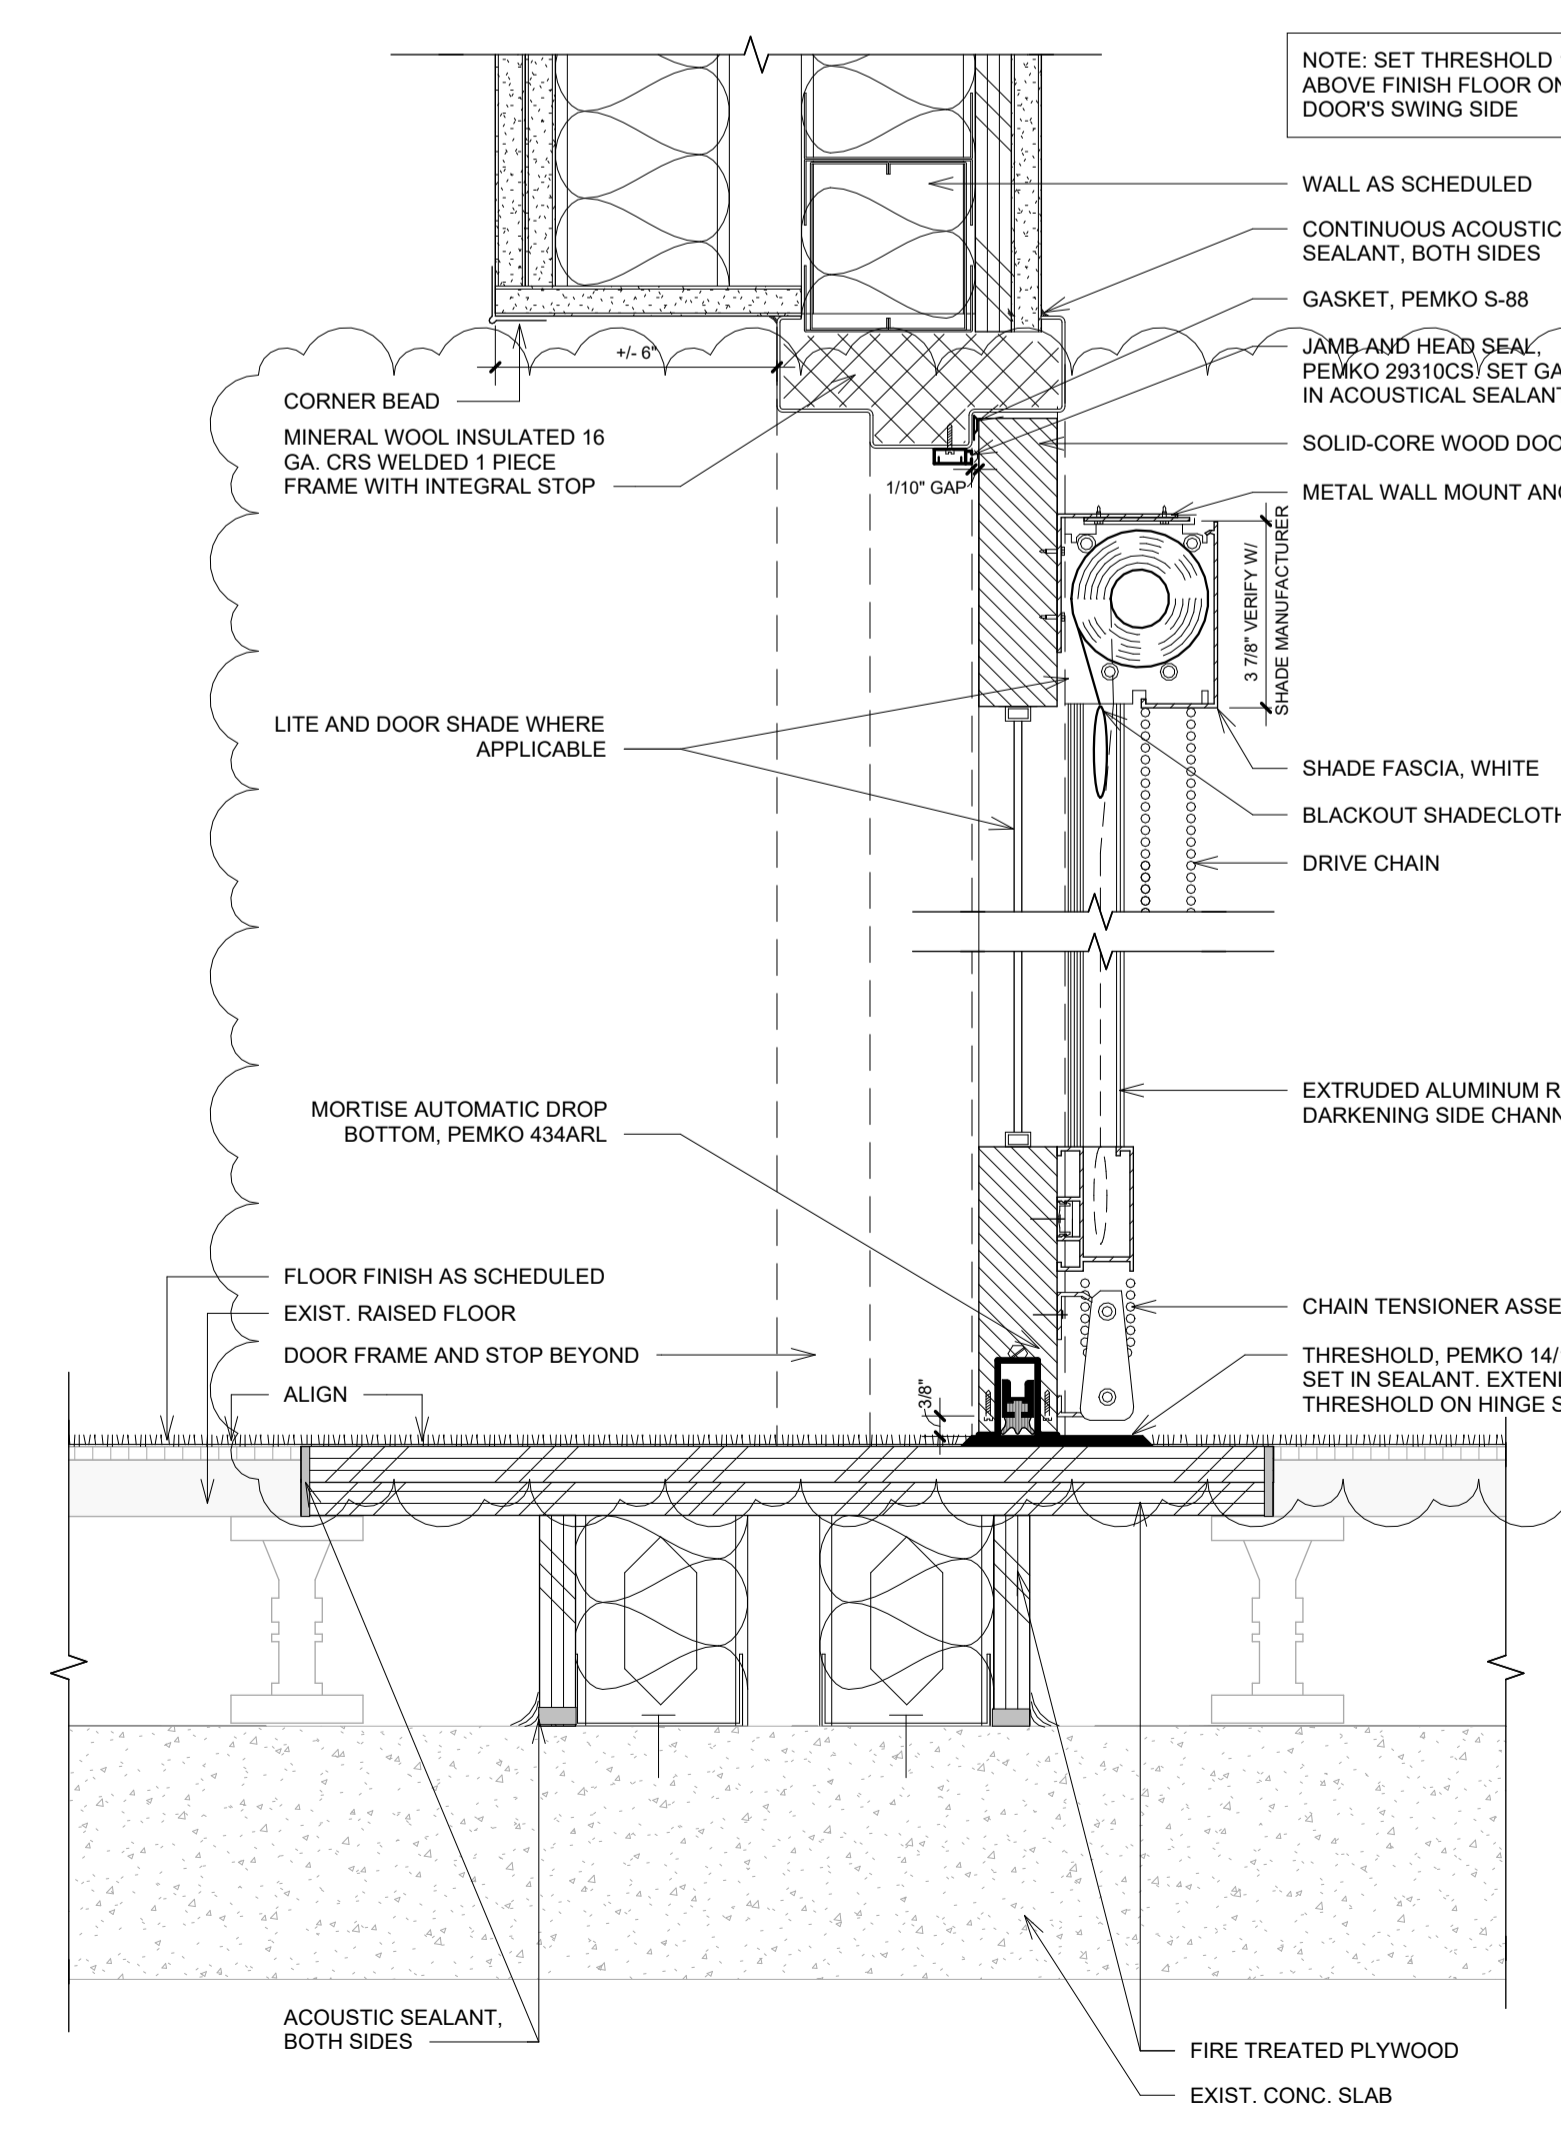


13 ACOUSTIC DOOR HEAD/THRESHOLD
A601 3' = 1'-0"

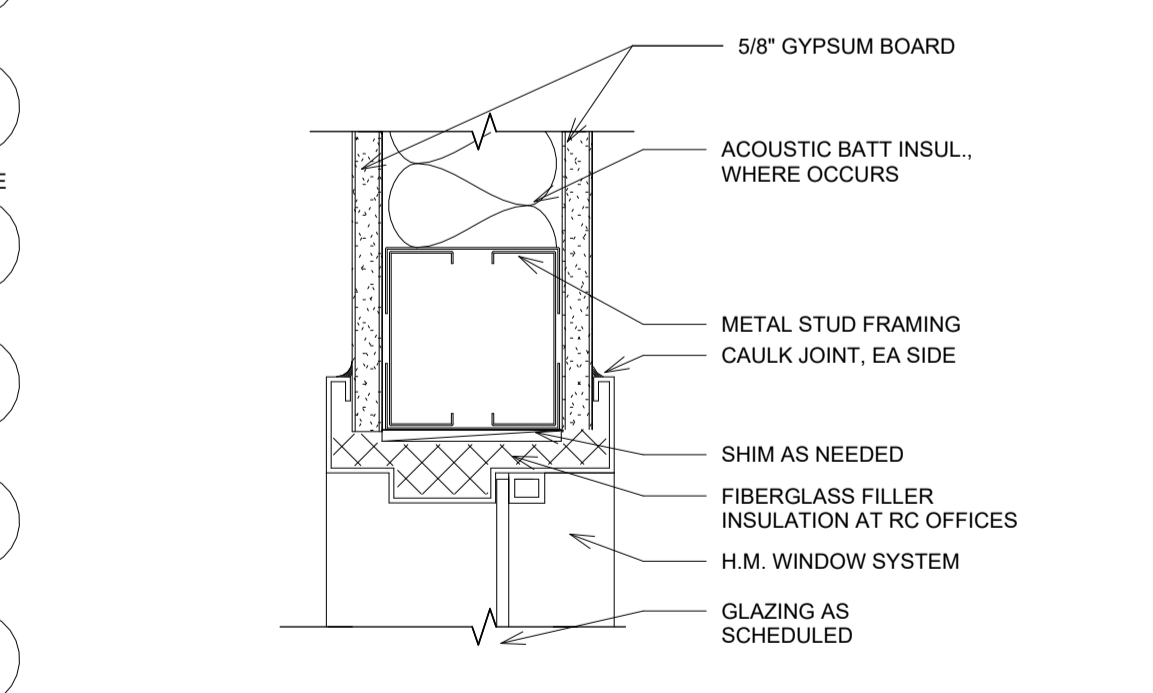


8 H.M. WINDOW HEAD @ GYP. BD.
A601 3' = 1'-0"

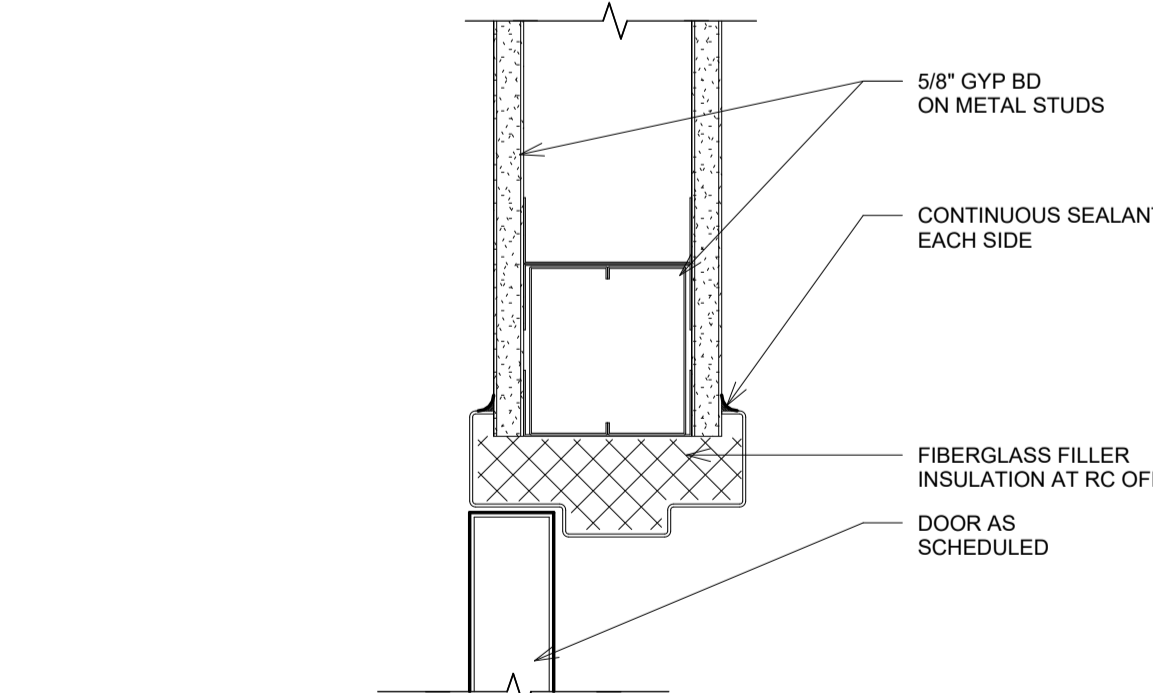

2 H.M. HEAD @ GYP. BD.
A601 3' = 1'-0"

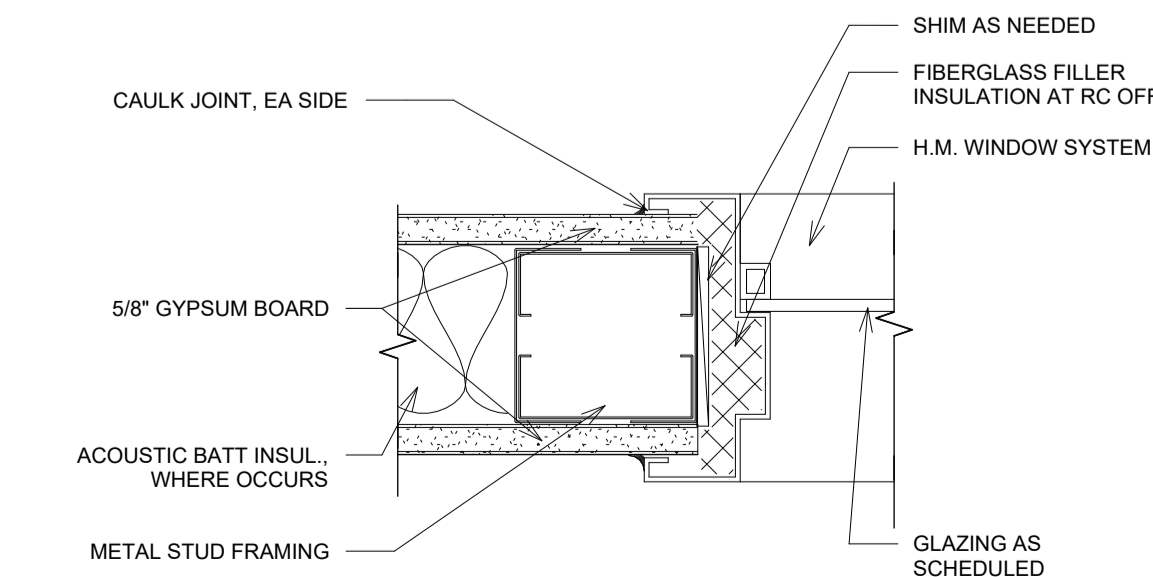

7 H.M. WINDOW JAMB @ GYP. BD.
A601 3' = 1'-0"

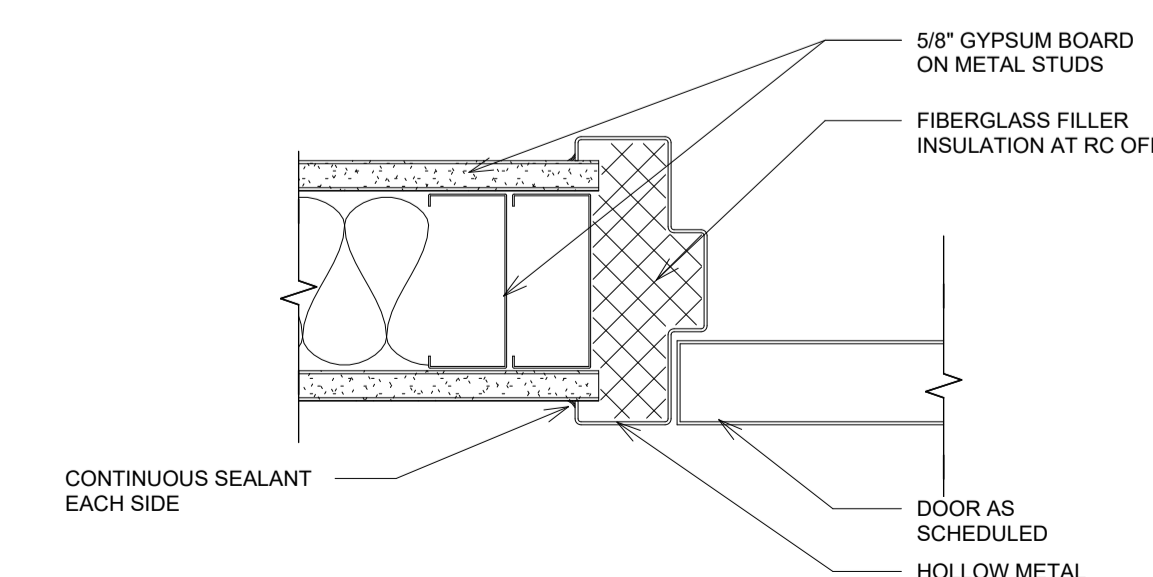

1 H.M. DOOR JAMB @ GYP. BD.
A601 3' = 1'-0"



ENTRY



ENTRY



TOUCHDOWN SPACE




ART GALLERY HALLWAY



OPEN WORKSTATIONS



OPEN WORKSTATIONS

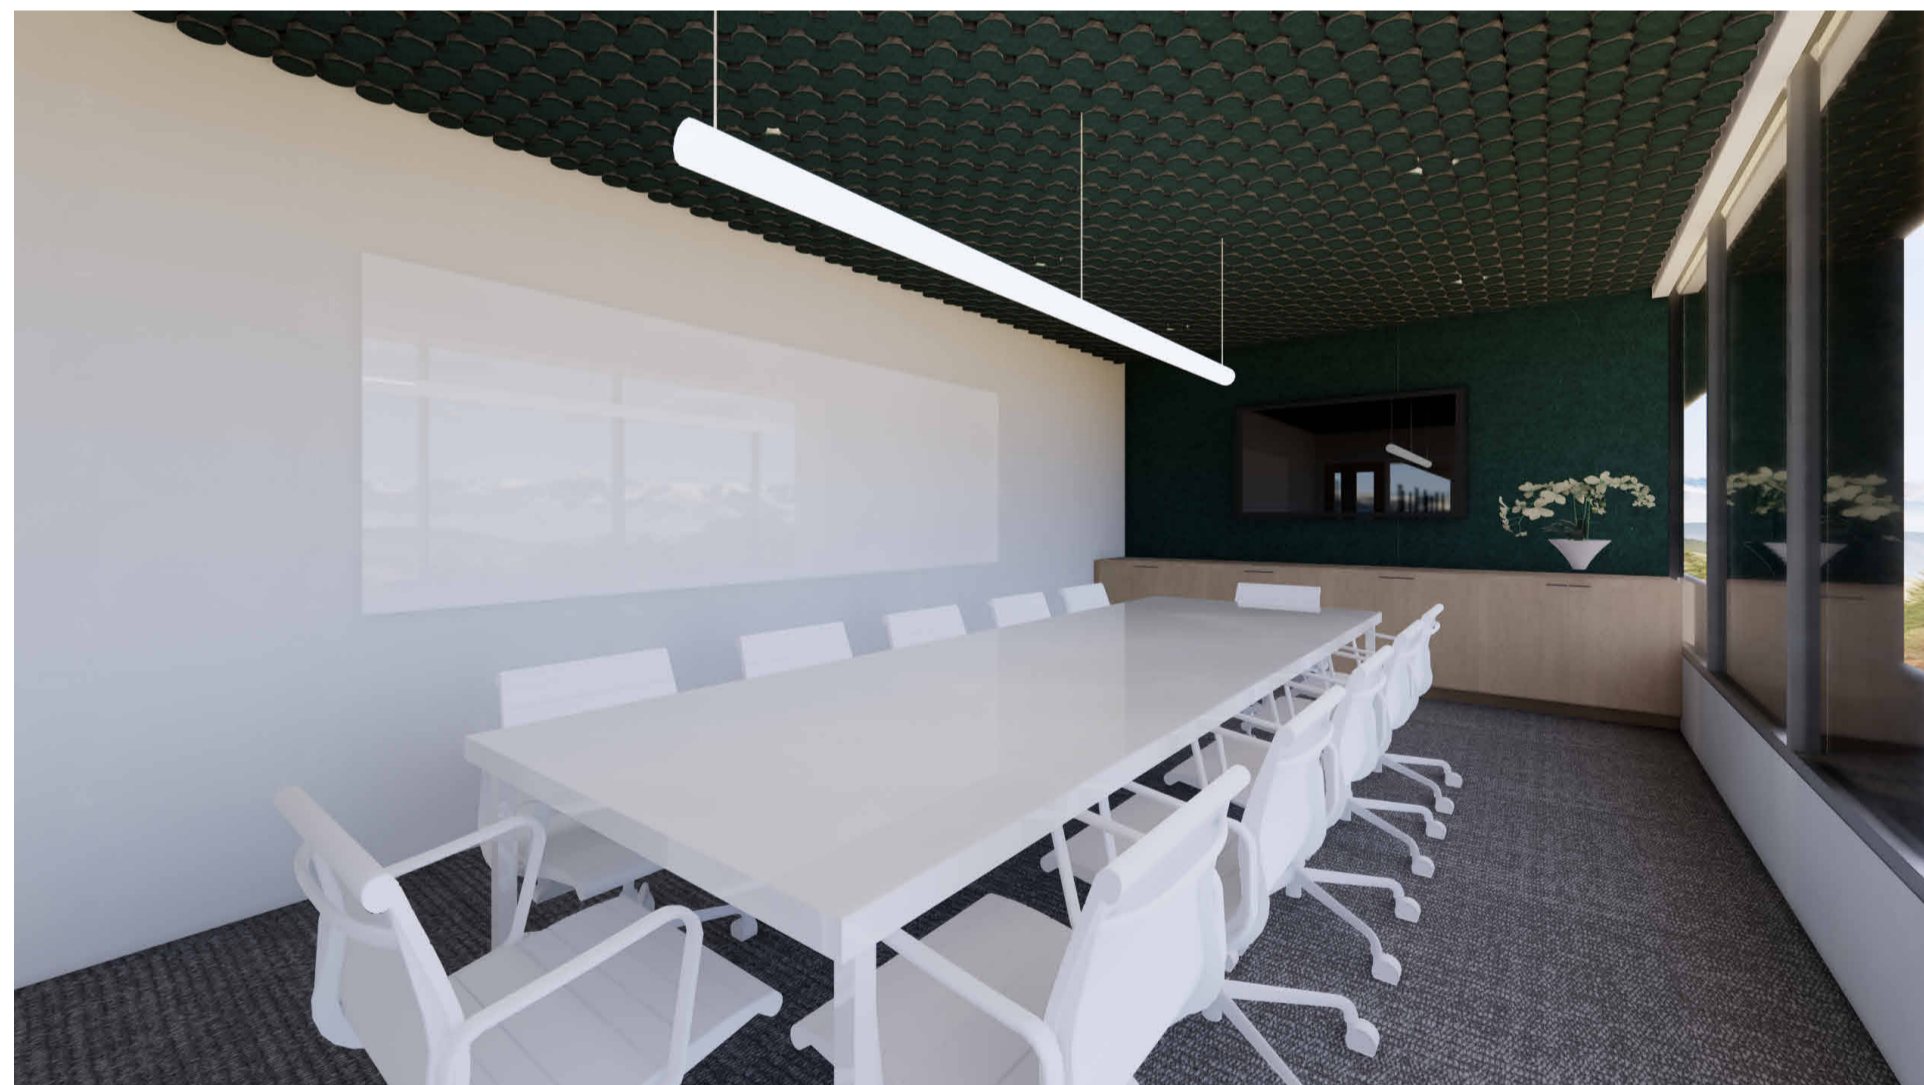

CONFERENCE ROOM




VIDEO PRODUCTION STUDIO



MEDIA REVIEW ROOM




SNACK BAR

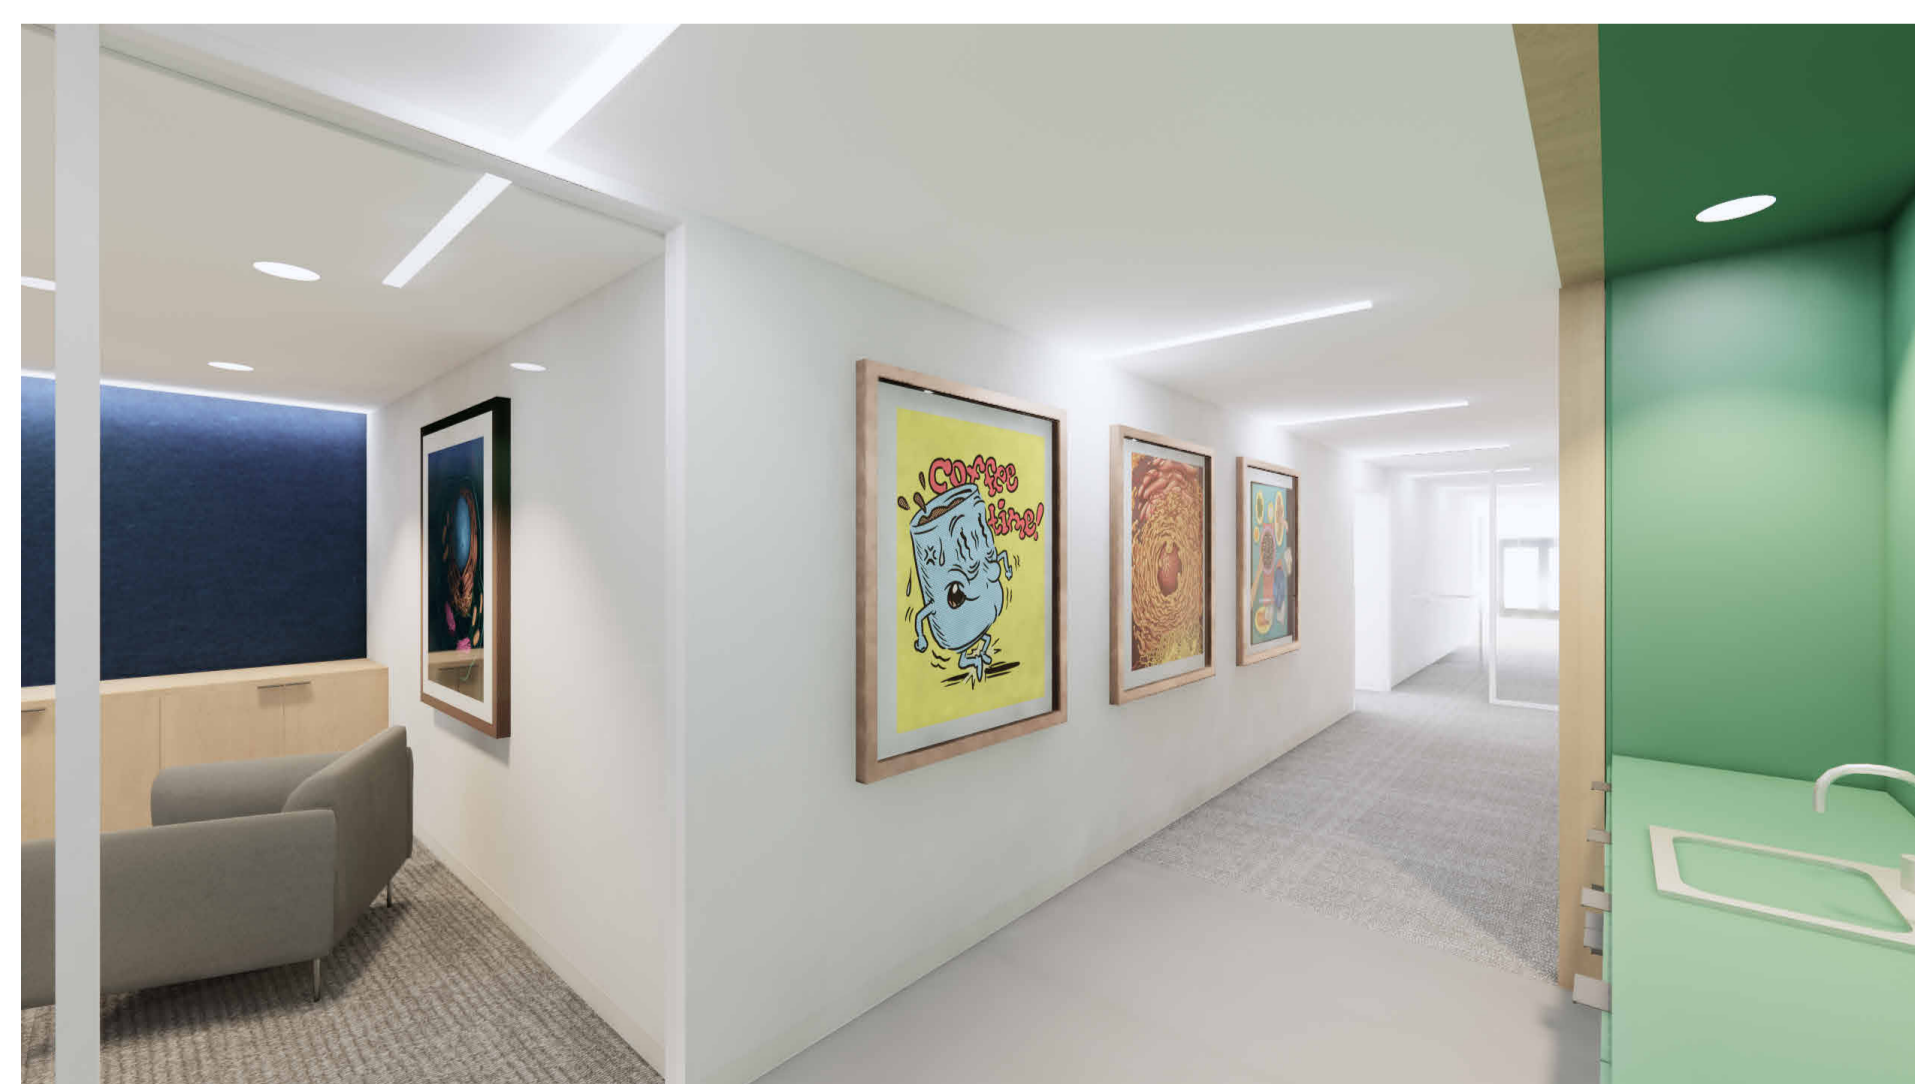

ART GALLERY HALLWAY



PHONE BOOTH

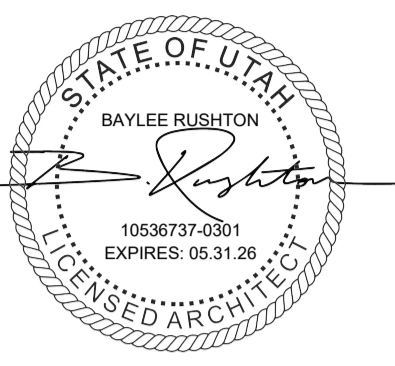

GENETIC SCIENCE
LEARNING CENTER

CONSTRUCTION DOCUMENTS

DFCM SEAL

No	Description	Date
1	ADDENDUM 1	12/20/2024



GSLC
296 CHIPETA WAY
SALT LAKE CITY, UT 84108

22812
10.30.2024

INTERIOR
RENDERINGS

A900

Scale




SHEET KEYNOTES

- 1 CONTRACTOR TO PROVIDE FLOOR BOX COVER FRS FL-500P-PLP-BLK-C OR EQUAL. ARCHITECT TO SELECT FINISH AND FLANGING DEPTH. CONTRACTOR TO COORDINATE WITH ARCHITECT AND FURNITURE PRIOR TO INSTALLING FLOOR BOX COVER.
- 2 CONTRACTOR TO PROVIDE EZ-PATH SERIES 33 FIRE-RATED PATHWAY. CATALOG NUMBER EZDP33PWS WITH EXTENSION CATALOG NUMBER EZD33E OR EQUAL. +18" ABOVE RAISED FLOOR.
- 3 CONTRACTOR TO INSTALL HUBBELL HBL260 OR EQUAL TO SLAB UNDER RAISED FLOOR UNDER FLOOR BOX COVER. CONTRACTOR TO COORDINATE WITH ARCHITECT AND FURNITURE PRIOR TO INSTALLING JUNCTION BOX. JUNCTION BOX IS FOR AV CONNECTION TO TV. REFER TO CALLOUT DETAIL.
- 4 CONTRACTOR TO UPDATE PANEL SCHEDULES.
- 5 JUNCTION BOX FOR AV CONNECTION TO TV. REFER TO CALLOUT DETAIL.

GENERAL SHEET NOTES

- 1 UNLESS NOTED OTHERWISE, ELECTRICAL ITEMS SHOWN IN DARK AND SOLID LINES ARE NEW AND THE CONTRACTOR SHALL PROVIDE THEM. ITEMS SHOWN IN SOLID LIGHT LINES ARE TO REMAIN.
- 2 CONTRACTOR SHALL UPDATE ALL NEW AND EXISTING PANEL SCHEDULES WITH NEW CIRCUIT DATA. SCHEDULE SHALL BE ON A CARD STOCK TYPE OF MATERIAL AND TYPED WITH THE UPDATED INFORMATION.
- 3 PROVIDE BLANK FACEPLATES AT ALL LOCATIONS WHERE DEVICES WERE DEMOLISHED BUT RACEWAY WAS LEFT TO REMAIN AND NO NEW DEVICES ARE BEING INSTALLED AT THAT LOCATION.
- 4 CONTRACTOR SHALL PROVIDE DEMOLITION AND PATCH AND REPAIR OF ANY WALLS, CEILINGS, FLOORS, ETC TO ROUTE RACEWAYS AND EQUIPEMNT.

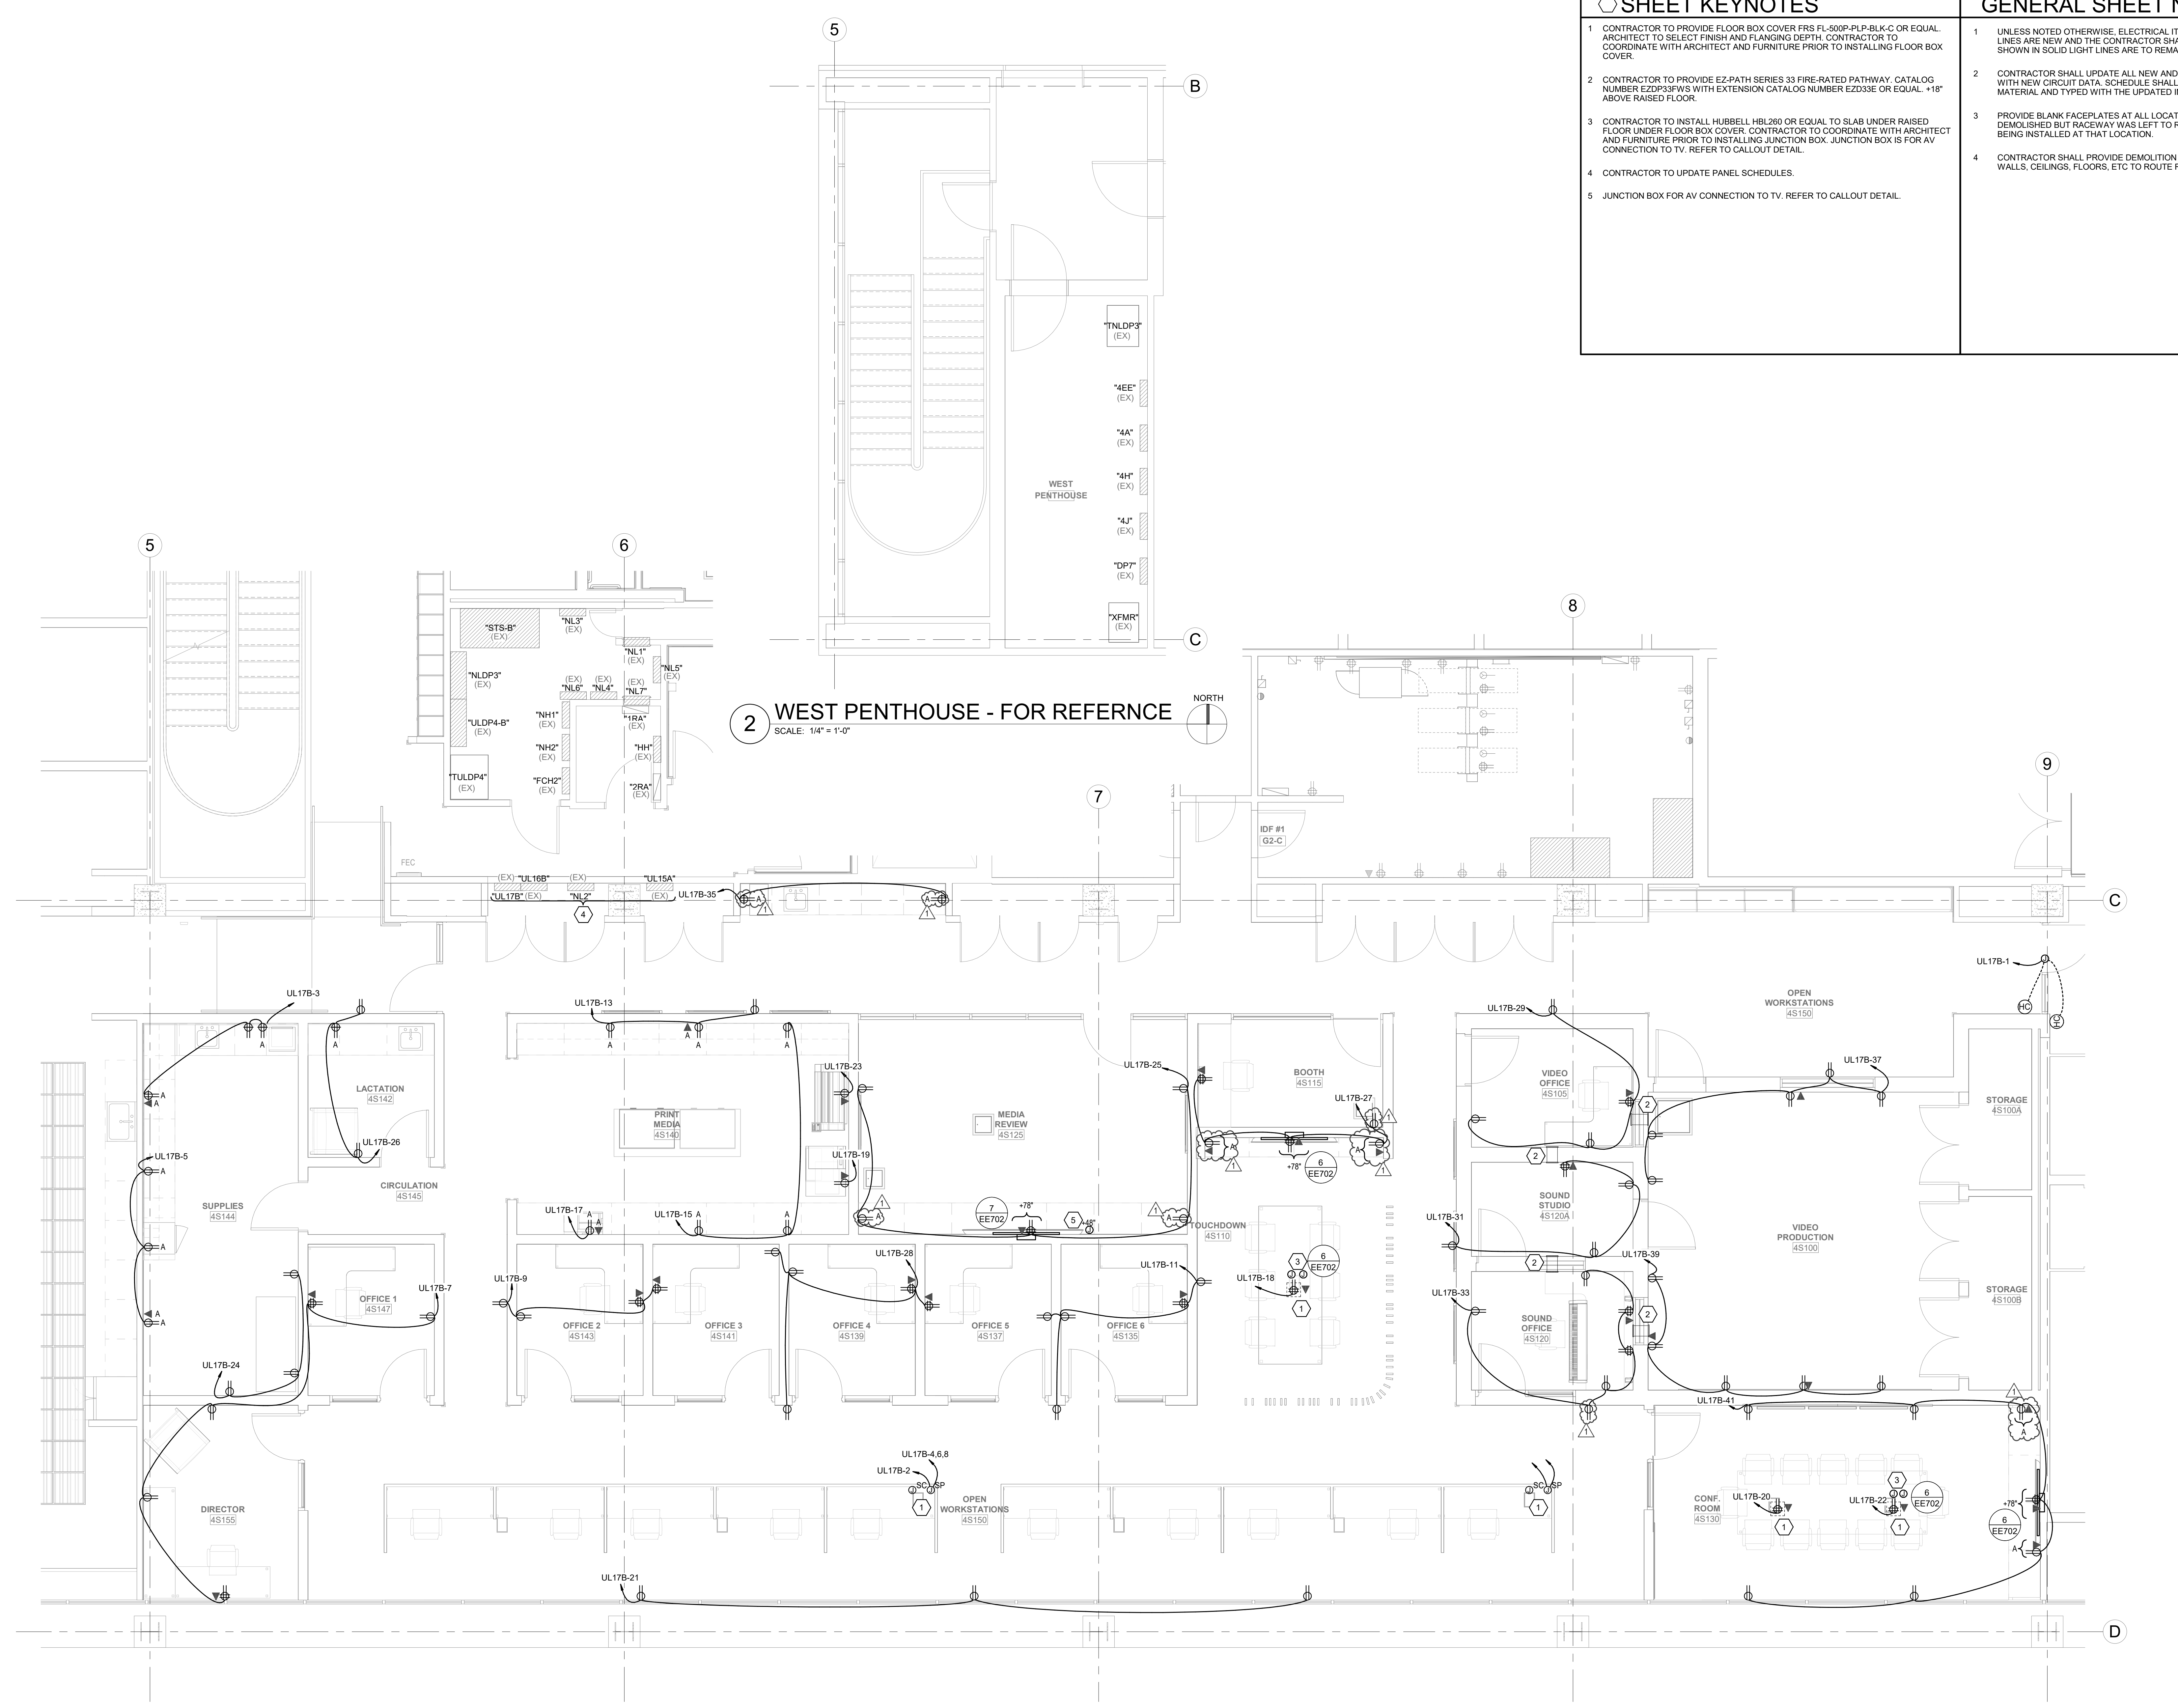

2 WEST PENTHOUSE - FOR REFERENCE
SCALE: 1/4" = 1'-0"

1 FOURTH FLOOR POWER PLAN
SCALE: 1/4" = 1'-0"

**GENETIC SCIENCE
LEARNING CENTER**

CONSTRUCTION DOCUMENTS

No	Description	Date
1	Addendum 1	12/20/2024



GLSC
295 CHIPETA WAY
SALT LAKE CITY, UT 84108

22812
10.30.2024

FOURTH FLOOR
POWER PLAN

EP101
Scale 1/4" = 1'-0"

Autodesk Docs://UU - Genetic Science Learning Center Remodel /240335-Elec Central.rvt
12/19/2024 2:36:21 PM

(EX) PANEL: "UL17B"
VOLTS/PHASE/WIRE: 120/208V, 3 PH 4 WIRE
PANEL SIZE & TYPE: 22" W x 6" D, BOLT-ON
MAIN SIZE AND TYPE: 250 AMPERE MAIN LUGS
FED FROM: CABINET: SURFACE
LOCATION: NOTES:
ACCESSORIES: PANEL DIRECTORY, IDENTIFICATION, GROUNDING BAR
AIC RATING: 22,000
Table with columns for OCP, LOAD (kVA), PHASE LOAD, DESCRIPTION, CO, PWR, LTG, BKR, POLE, AMP, NO.

NEC DIVERSIFIED LOAD CALCULATIONS
LIGHTING & CONTINUOUS LOADS:
RECEPTACLES: 19.1 kVA @ 76% = 14.5 kVA
MOTOR TOTALS INCLUDED IN ALL OTHER LOADS WITH LARGEST MOTOR CALCULATED @ 125% PER NEC
ALL OTHER LOADS @ 100%: 1.7 kVA
DIVERSIFIED TOTAL kVA = 16
AVERAGE AMPS PER PHASE = 45

BKR=GF+GFICI, GF3=30mA GFICI CAPABLE OF BEING LOCKED OUT IN OPEN POSITION, IG=ISOLATED GROUND, AF=AFICI, ST=SHUNT TRIP, RED=PROVIDE RED COLORED BREAKER, AF=ARC FAULT CURRENT INTERRUPTER, GA=COMBINATION OF GROUND FAULT AND ARC FAULT CIRCUIT INTERRUPTER, GS=COMBINATION OF SHUNT TRIP WITH GFICI, EB=EXISTING BREAKER, NB=NEW BREAKER

(EX) PANEL: "NH2"
VOLTS/PHASE/WIRE: 480/277 V, 3 PH 4 WIRE
PANEL SIZE & TYPE: 22" W x 6" D, BOLT-ON
MAIN SIZE AND TYPE: 125 AMPERE MAIN LUGS
FED FROM: CABINET: SURFACE
LOCATION: NOTES:
ACCESSORIES: PANEL DIRECTORY, IDENTIFICATION, GROUNDING BAR
AIC RATING: 22,000
Table with columns for OCP, LOAD (kVA), PHASE LOAD, DESCRIPTION, CO, PWR, LTG, BKR, POLE, AMP, NO.

NEC DIVERSIFIED LOAD CALCULATIONS
LIGHTING & CONTINUOUS LOADS: 3.0 kVA @ 125% = 3.8 kVA
RECEPTACLES:
MOTOR TOTALS INCLUDED IN ALL OTHER LOADS WITH LARGEST MOTOR CALCULATED @ 125% PER NEC
ALL OTHER LOADS @ 100%: 0.0 kVA
DIVERSIFIED TOTAL kVA = 4
AVERAGE AMPS PER PHASE = 6

BKR=GF+GFICI, GF3=30mA GFICI CAPABLE OF BEING LOCKED OUT IN OPEN POSITION, IG=ISOLATED GROUND, AF=AFICI, ST=SHUNT TRIP, RED=PROVIDE RED COLORED BREAKER, AF=ARC FAULT CURRENT INTERRUPTER, GA=COMBINATION OF GROUND FAULT AND ARC FAULT CIRCUIT INTERRUPTER, GS=COMBINATION OF SHUNT TRIP WITH GFICI, EB=EXISTING BREAKER, NB=NEW BREAKER

(EX) PANEL: "4EE"
VOLTS/PHASE/WIRE: 480/277 V, 3 PH 4 WIRE
PANEL SIZE & TYPE: 22" W x 6" D, BOLT-ON
MAIN SIZE AND TYPE: 100 AMPERE MAIN LUGS
FED FROM: CABINET: SURFACE
LOCATION: NOTES:
ACCESSORIES: PANEL DIRECTORY, IDENTIFICATION, GROUNDING BAR
AIC RATING: 10,000
Table with columns for OCP, LOAD (kVA), PHASE LOAD, DESCRIPTION, CO, PWR, LTG, BKR, POLE, AMP, NO.

NEC DIVERSIFIED LOAD CALCULATIONS
LIGHTING & CONTINUOUS LOADS: 0.6 kVA @ 125% = 0.7 kVA
RECEPTACLES:
MOTOR TOTALS INCLUDED IN ALL OTHER LOADS WITH LARGEST MOTOR CALCULATED @ 125% PER NEC
ALL OTHER LOADS @ 100%: 0.0 kVA
DIVERSIFIED TOTAL kVA = 1
AVERAGE AMPS PER PHASE = 1

BKR=GF+GFICI, GF3=30mA GFICI CAPABLE OF BEING LOCKED OUT IN OPEN POSITION, IG=ISOLATED GROUND, AF=AFICI, ST=SHUNT TRIP, RED=PROVIDE RED COLORED BREAKER, AF=ARC FAULT CURRENT INTERRUPTER, GA=COMBINATION OF GROUND FAULT AND ARC FAULT CIRCUIT INTERRUPTER, GS=COMBINATION OF SHUNT TRIP WITH GFICI, NB=NEW BREAKER


GENERAL SHEET NOTES

- 1. PROVIDE NEMA 3R ENCLOSURES FOR EQUIPMENT LOCATED OUTDOORS. REFER TO PLANS FOR EQUIPMENT LOCATIONS.
2. REFER TO PLANS FOR CONSTRAINTS ON PHYSICAL DIMENSIONS AND CLEARANCE REQUIREMENTS OF EQUIPMENT. PROVIDE EQUIPMENT DIMENSIONS THAT FALL WITHIN THE CONSTRAINTS OF EACH SPECIFIC LOCATION.
3. ALL EQUIPMENT SHALL BE CONSTRUCTED AND BRACED FOR THE SEISMIC CONDITIONS OF THE PROJECT. REFER TO ELECTRICAL SPECIFICATIONS FOR REQUIREMENTS.
4. PROVIDE PERFORMANCE TESTING FOR GROUND-FAULT PROTECTION SYSTEMS ON SITE WITH A WRITTEN RECORD OF THIS TEST SUBMITTED TO THE AUTHORITY HAVING JURISDICTION PER NEC 230.95(C).

SHEET KEYNOTES

- 1. PROTECT AND MAINTAIN EXISTING GEAR/EQUIPMENT.

STUDIO LP
331 S RIO GRANDE ST
SUITE 307
SLC, UT 84101
PH: 8013640503
ELECTRICAL ENGINEER
SPECTRUM
E. N. G. I. N. E. E. P. S.
324 S. State St., Suite 400
Salt Lake City, UT 84111
801-476-7077
801-328-6151
fax: 801-328-6155
www.spectrum-engineers.com

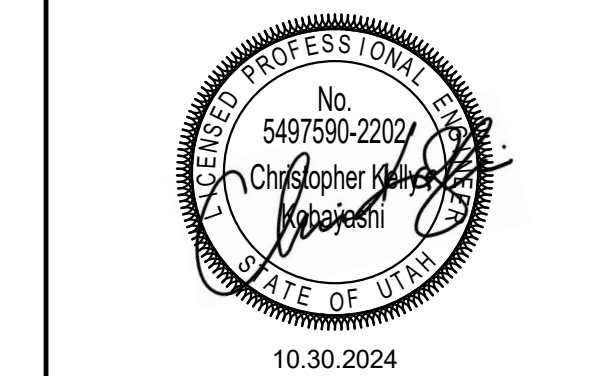


COPPER CONDUCTOR AND CONDUIT SCHEDULE

Table with columns: SYM, AMP, HH AMPS, CONDUIT SIZE, QTY, SIZE, IG, HH, SE, NOTES. Lists various conductor and conduit specifications for the project.


- CONDUCTOR AND CONDUIT SCHEDULE NOTES
1. CONDUCTORS SHOWN ARE SHOWN FOR EACH CONDUIT WITH MODIFICATIONS AS NOTED IN NOTE 5. ALL CONDUCTORS SHOWN ARE THWN UNLESS OTHERWISE NOTED.
2. PROVIDE EQUIPMENT GROUND CONDUCTORS PER TABLE 250-122 WHEN CIRCUIT BREAKERS ARE SIZED GREATER THAN AMPERE RATINGS SHOWN IN TABLE.
3. PROVIDE #10 NEUTRALS FOR MULTIWIRE BRANCH CIRCUITS SERVING COMPUTERS.
4. GROUND (G) CONDUCTOR MAY BE DELETED ON SERVICE ENTRANCE CONDUCTORS.
5. SYMBOL SUBSCRIPTS:
"2N": INCLUDE TWO NEUTRAL CONDUCTORS SIZED AS SCHEDULED FOR PHASE AND NEUTRAL CONDUCTORS WHERE THE CONDUCTOR IS #10 OR LARGER. INCLUDE A SINGLE 200% RATED CONDUCTOR THAT IS TWICE THE AMPACITY OF THE SCHEDULED PHASE AND NEUTRAL CONDUCTOR WHERE THE CONDUCTOR IS BELOW #10 IN SIZE.
"CI": PROVIDE CIRCUIT INTEGRITY CABLE; TYPE TWO-HOUR FIRE RESISTIVE CABLES IN CONDUIT OR PROVIDE FEEDER ENCASED IN CONCRETE.
"FG": FULL SIZE GROUND, SIZE EQUIPMENT GROUNDING CONDUCTOR TO BE SAME SIZE AS THE PHASE CONDUCTORS.
"HT": NEUTRAL CURRENTS EXIST DUE TO HIGH HARMONIC 'NONLINEAR' LOADS. CURRENT CARRYING CONDUCTORS DERATED ACCORDINGLY. PROVIDE THE IG/HH SIZE FOR THE EQUIPMENT GROUNDING CONDUCTOR.
"IG": INCLUDE IG (INSULATED/ISOLATED GROUND CONDUCTOR) SCHEDULED ALONG WITH THE GROUND OF EQUIPMENT GROUND CONDUCTOR.
"MC": PROVIDE FEEDER IN METAL-CLAD CABLE; TYPE MC IN PLACE OF SINGLE CONDUCTORS IN CONDUIT.
"SE": SUBSTITUTE "SE" CONDUCTOR FOR "G" CONDUCTOR SHOWN, WHICH IS SIZED FOR THE GROUNDING OF THE SECONDARY OF THE SEPARATELY DERIVED SYSTEM.
"SER": PROVIDE SERVICE-ENTRANCE CABLE; TYPE SE OR SER IN PLACE OF SINGLE CONDUCTORS IN CONDUIT.
6. RACEWAY ONLY. CONDUCTORS PROVIDED BY UTILITY.

GENETIC SCIENCE LEARNING CENTER

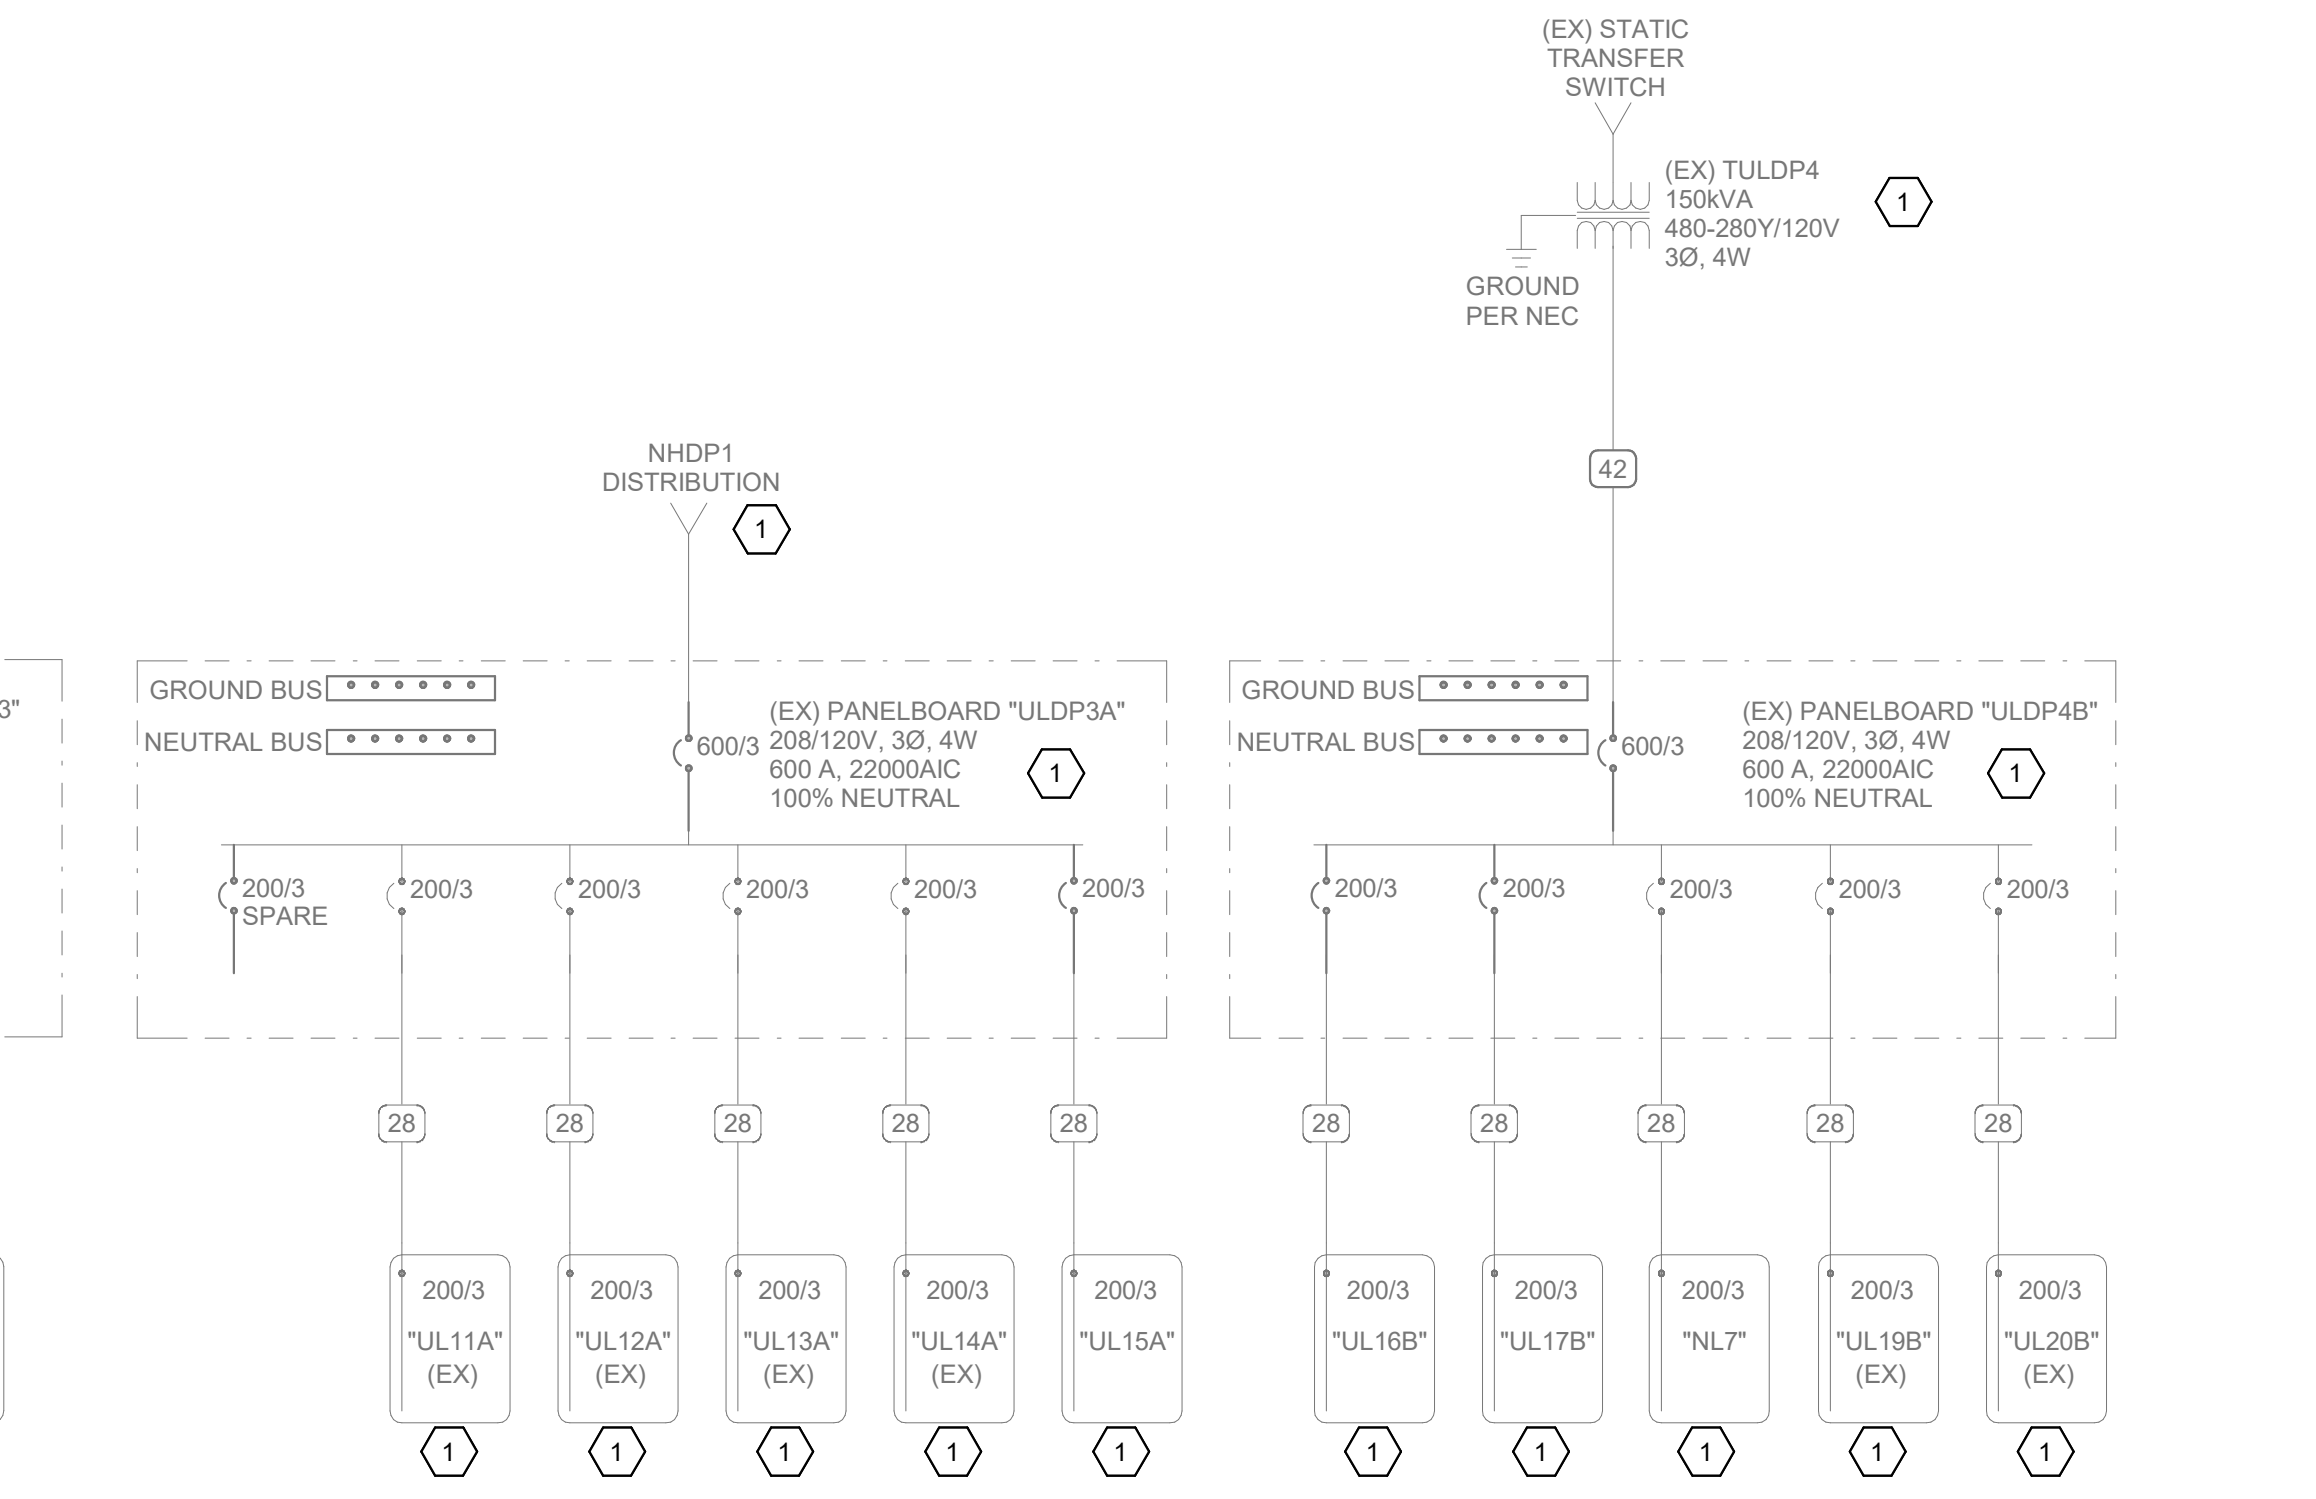

1 PARTIAL DEMOLITION ONE-LINE DIAGRAM
SCALE: NTS

CONSTRUCTION DOCUMENTS
The University of Utah
GSLC
295 CHIPETA WAY
SALT LAKE CITY, UT 84108
22812
10.30.2024
ONE-LINE DIAGRAM & SCHEDULES
EP601
Scale NTS

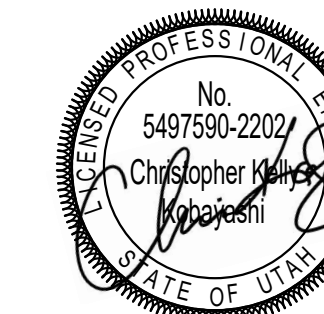

10.30.2024

**GENETIC SCIENCE
LEARNING CENTER**

CONSTRUCTION DOCUMENTS

No	Description	Date
1	Addendum 1	12/20/2024




GLSC
295 CHIPETA WAY
SALT LAKE CITY, UT 84108

22812
10.30.2024
FOURTH FLOOR
LIGHTING PLAN


EL101
Scale 1/4" = 1'-0"

- SHEET KEYNOTES**
- CONFIRM MOUNTING TYPE WITH ARCHITECT PRIOR TO ROUGH-IN.

- GENERAL SHEET NOTES**
- UNLESS NOTED OTHERWISE, ELECTRICAL ITEMS SHOWN IN DARK AND SOLID LINES ARE NEW AND THE CONTRACTOR SHALL PROVIDE THEM. ITEMS SHOWN IN SOLID LIGHT LINES ARE TO REMAIN.
 - COORDINATE LOCATIONS AND MOUNTING HEIGHTS OF ALL LIGHT FIXTURES ON THIS LEVEL WITH MECHANICAL EQUIPMENT, DUCT, PIPE, PLUMBING, ETC. PRIOR TO ROUGH-IN.
 - CONTRACTOR SHALL UPDATE PANEL SCHEDULES WITH NEW CIRCUIT DATA TYPED ON CARD STOCK TYPE MATERIAL.
 - ALL CEILING MOUNTED DEVICES LOCATED IN LAY-IN GRID CEILINGS SHALL BE INSTALLED CENTERED IN CEILING TILES AND/OR ALIGNED WITH OTHER FIXTURES WITHIN THE SAME PLANE AND CEILING SPACE.
 - LIGHTING CONTROL, DIMMING AND ROOM CONTROLLER SHALL BE LOCATED AS FOLLOWS WHERE POSSIBLE UNLESS NOTED OTHERWISE. LOCATE ABOVE ACCESSIBLE CEILING NEAR THE DOOR THAT CONTROLLER SERVES BUT OUT OF THE PATH OF EGRESS. REFER TO DETAIL FOR ADDITIONAL INFORMATION.
 - PROVIDE UNSWITCHED HOT CIRCUIT TO ALL LIGHT FIXTURES WITH EMERGENCY TRANSFERS TO ALLOW FOR POWER LOSS SENSING.
 - REFER TO EE701 FOR TYPICAL MOUNTING AND ALIGNMENT OF ELECTRICAL DEVICES.
 - CONTRACTOR SHALL BE REQUIRED TO PROVIDE ALL MOUNTING HARDWARE ALONG WITH REQUIRED SEISMIC BRACING FOR EACH FIXTURE.
 - ALL PATHWAYS FOR LOW VOLTAGE CABLING NOT REQUIRED TO BE IN CONDUITS SHALL BE ROUTED IN J-HOOK PATHWAYS, CONCEAL ALL PATHWAYS ABOVE ACCESSIBLE CEILING SPACES. DO NOT RUN CABLES IN EXPOSED AREAS. WHERE CONCEALMENT IS NOT POSSIBLE IN EXPOSED AREAS, CONTRACTOR SHALL PROVIDE CONDUIT TO ROUTE CABLING WHERE VISIBLE.

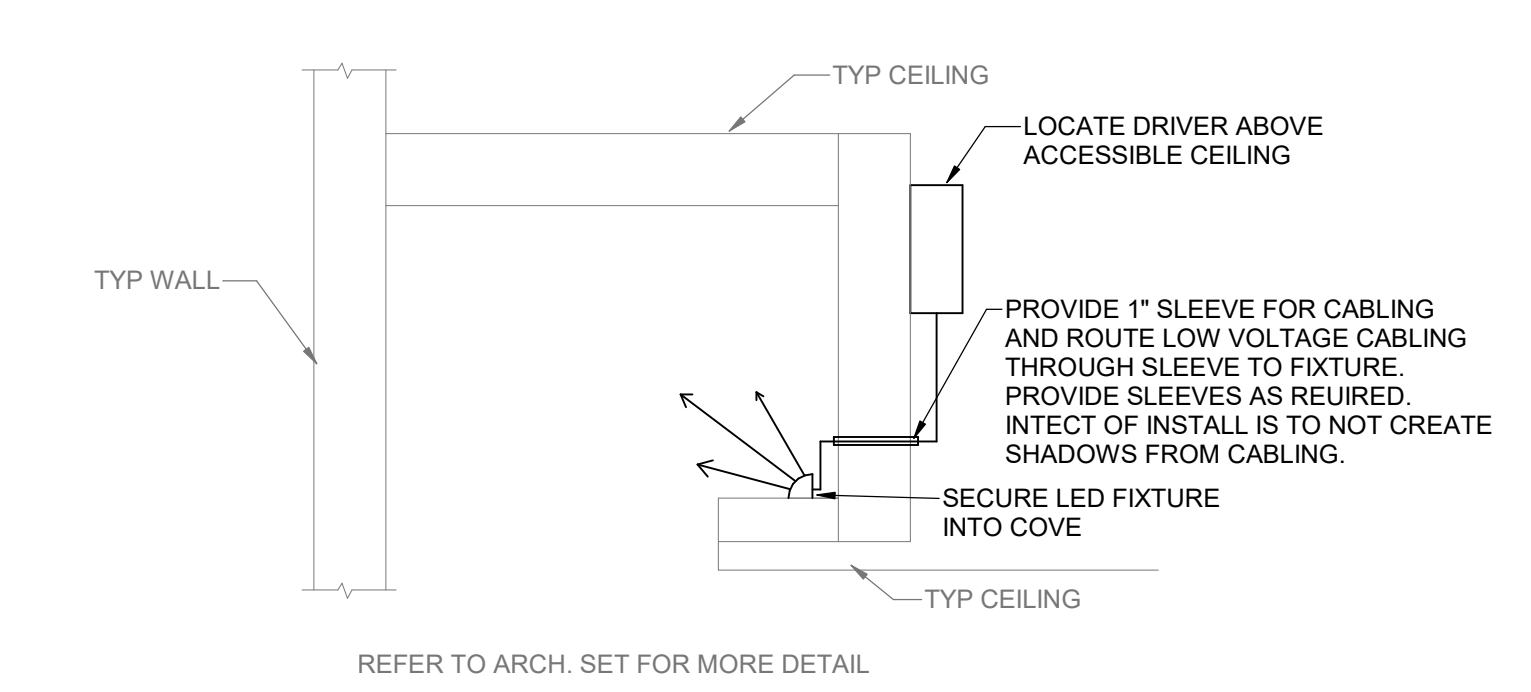

2 MEDIA REVIEW STRIP LIGHT
SCALE: NTS

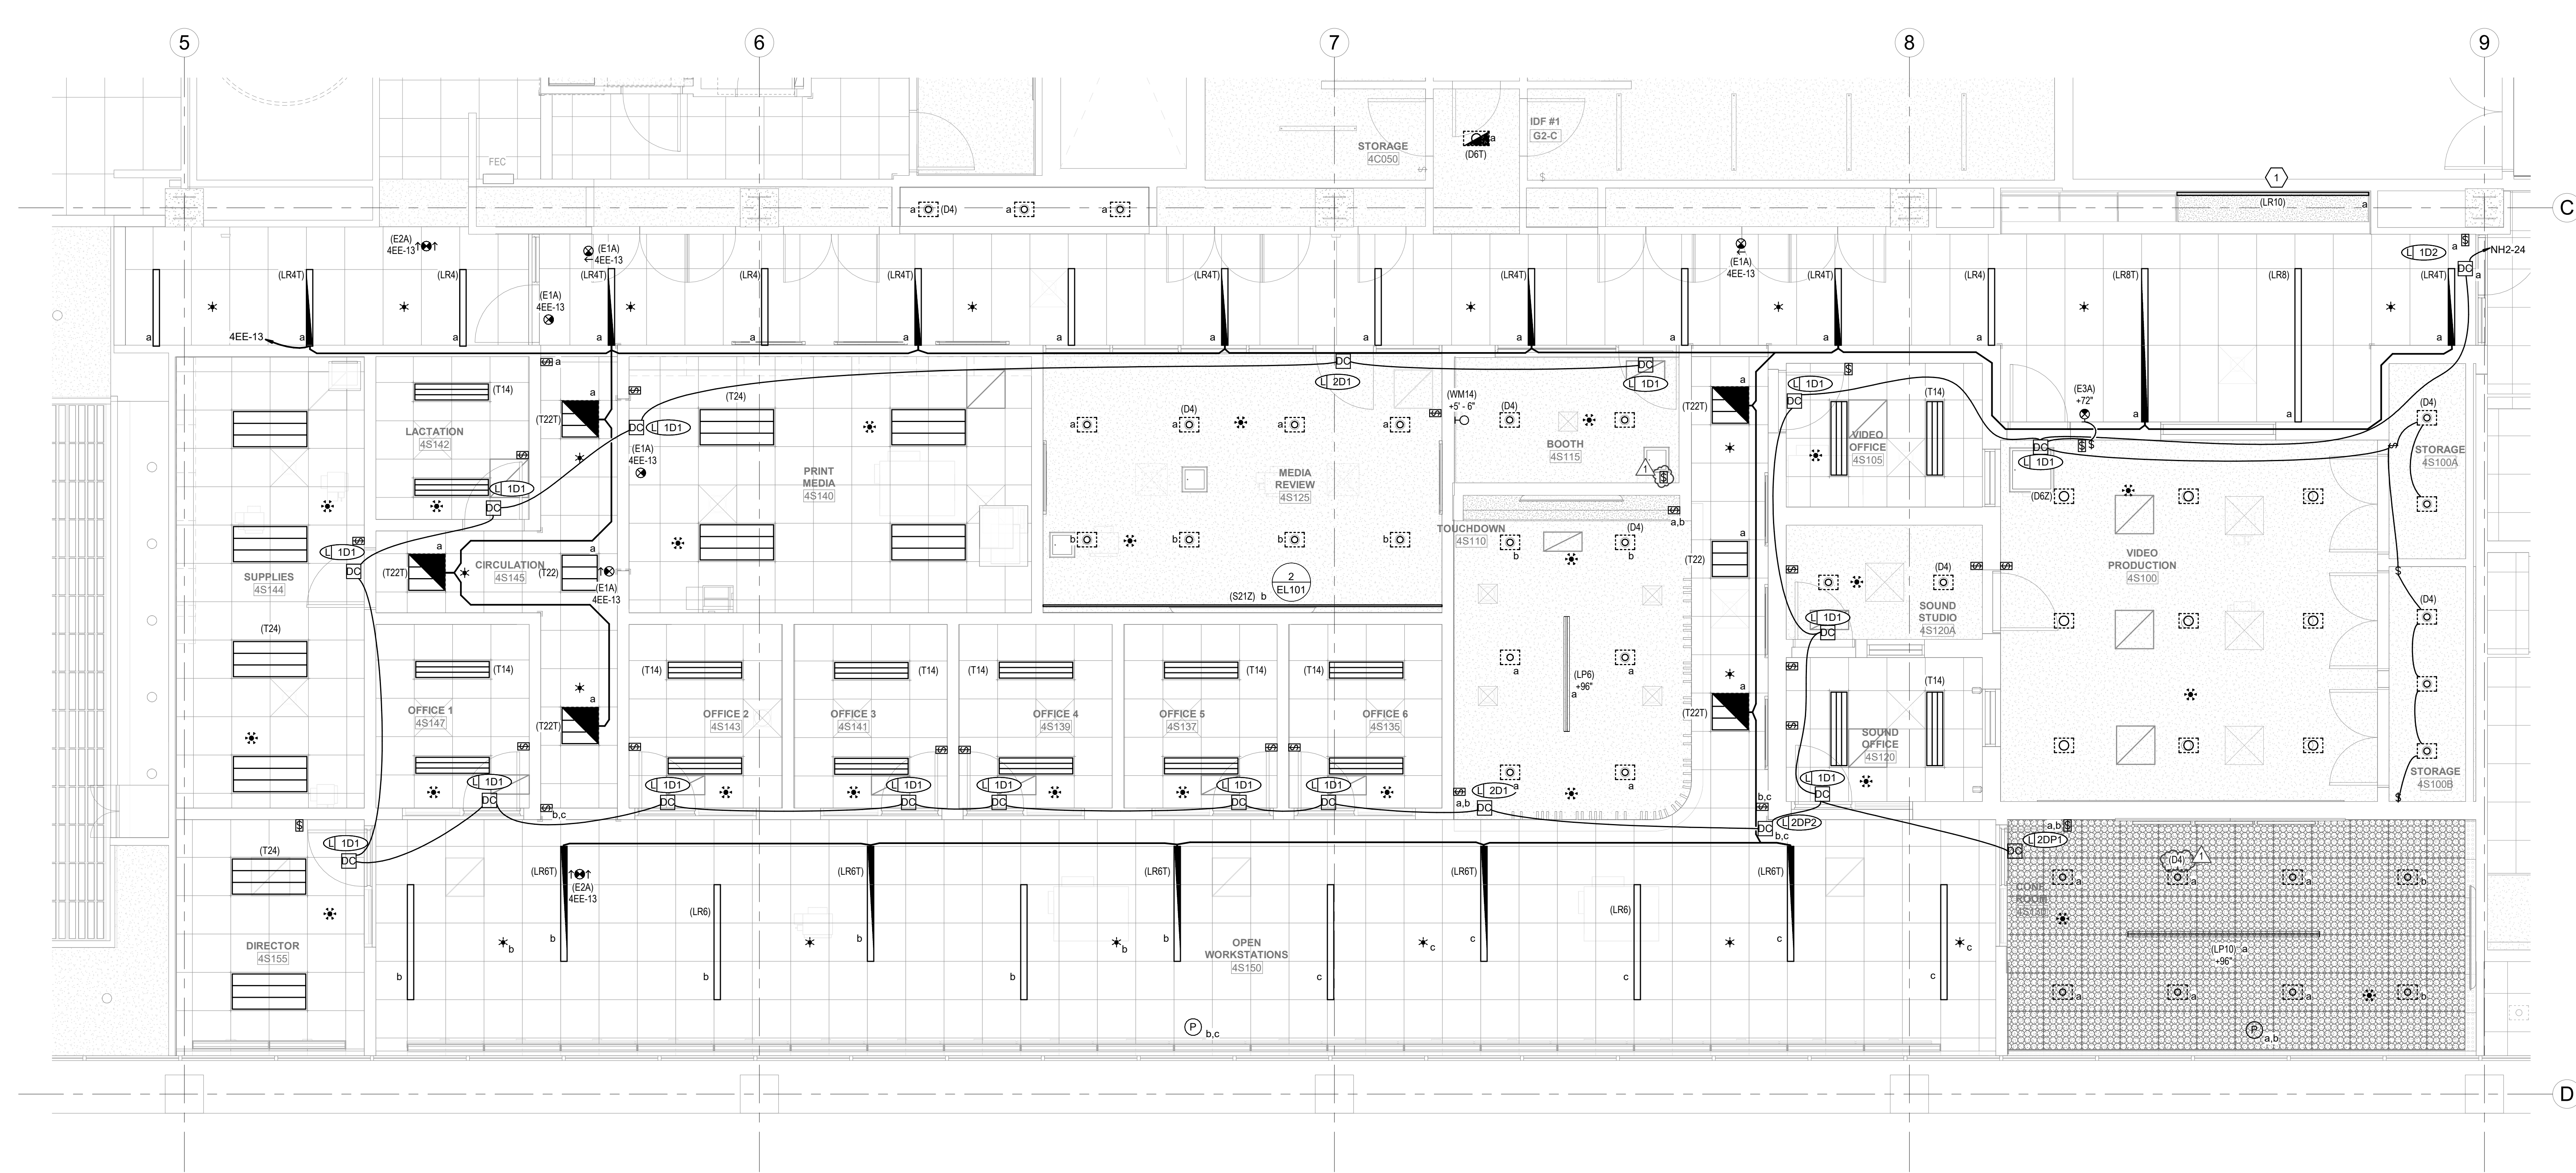

1 FOURTH FLOOR LIGHTING PLAN
SCALE: 1/4" = 1'-0"

Autodesk Docs://U - Genetic Science Learning Center Remodel /240335-Elec Central.rvt
12/19/2024 2:35:02 PM



**GENETIC SCIENCE
LEARNING CENTER**

CONSTRUCTION DOCUMENTS

DFCM SEAL

No	Description	Date
1	Addendum 1	12/20/2024



GLSC
295 CHIPETA WAY
SALT LAKE CITY, UT 84108

22812
10.30.2024

**LIGHTING
FIXTURE
SCHEDULE &
DETAILS**



EL602
Scale NTS

INTERIOR LIGHTING FIXTURE SCHEDULE

GENERAL NOTES

- SUBSTITUTIONS AND/OR EQUAL FIXTURES MUST RECEIVE APPROVAL PRIOR TO BIDDING. THEY MUST BE SUBMITTED TO THE ENGINEER NO LESS THAN 2 WEEKS PRIOR TO BID OPENING.
- SAMPLES MUST BE PROVIDED FOR ANY AND ALL FIXTURES UPON AVE REQUEST PRIOR TO RELEASING FIXTURES.
- ALL FIXTURES SHALL BE LISTED AND APPROVED FOR THEIR INTENDED USE AND LOCATION.
- VERIFY THE PROPER MOUNTING KITS OR ACCESSORIES TO FACILITATE INSTALLATION AS SHOWN AT EACH LOCATION ON THE DRAWINGS.
- COMPLY WITH THE "INTERIOR LIGHTING" SECTION OF THE SPECIFICATIONS.
- ALL LIGHT FIXTURES TO BE EITHER "DLC" OR "LIGHTING FACTS" LISTED OR TO BE APPROVED BY ARCHITECT/ENGINEER AND OWNER.
- CONTRACTOR ALLOWANCE PRICES ARE ACCURATE WHEN THIS JOB WAS SPECIFIED. CONTRACTOR AND ELECTRICAL DISTRIBUTOR SHALL VERIFY THIS ALLOWANCE AND REPORT ANY PROBLEMS TO THE ENGINEER BEFORE THE BID. ALLOWANCE PRICE MAY OR MAY NOT INCLUDE LAMP(S) OR FREIGHT AS NOTED, AND DO NOT INCLUDE ANY TAXES.

ID	DESCRIPTION	SIZE (NOMINAL)	LUMINAIRE		DRIVER				MANUFACTURER / CATALOG SERIES	
			DELIVERED DIRECT LUMENS	DELIVERED INDIRECT LUMENS	COLOR TEMP	CRI	TYPE	VOLTAGE		WATTS
(D4)	DESCRIPTION: 4" DOWNLIGHT MOUNTING: RECESSED, CEILING FINISH: SCBA OPTICS: 66° BEAM, CLEAR REFLECTOR, MATTE DIFFUSE EM: NONE	LENGTH: 12" WIDTH: 9" HEIGHT: 8" DIAMETER: 4"	1,500		4000K	80	LED (0-10V DIMMING) 1%	120/277V	15	GOTHAM (IC04) PORTFOLIO (LD4D) WILLIAMS (4DR-TL)
(D6T)	DESCRIPTION: 6" DOWNLIGHT MOUNTING: RECESSED, CEILING FINISH: SCBA OPTICS: 36° BEAM, CLEAR REFLECTOR, MATTE DIFFUSE OPTIONS: EM: EMERGENCY TRANSFER	LENGTH: 16" WIDTH: 11" HEIGHT: 9" DIAMETER: 6"	2,000		4000K	80	LED (0-10V DIMMING) 1%	120/277V	27	GOTHAM (IC06) PORTFOLIO (LD6D) WILLIAMS (6DR-TL)
(D6Z)	DESCRIPTION: 6" DOWNLIGHT MOUNTING: RECESSED, CEILING FINISH: SCBA OPTICS: MEDIUM, EZB DRIVER EM: NONE	LENGTH: 12" WIDTH: 9" HEIGHT: 8" DIAMETER: 4"	3,000		4000K	80	ELOD 0-10V LOGARITHMIC DIMMING <1%	120/277V	30	GOTHAM (EVO6) PORTFOLIO (LD6D) WILLIAMS (6DR-TL)
(E1A)	DESCRIPTION: EXIT SIGN, EDGE LIT, SINGLE SIDED MOUNTING: CEILING FINISH: SCBA OPTICS: OPTRONIX (EM, EMERGENCY TRANSFER)	LENGTH: 11" WIDTH: 3" HEIGHT: 10"			GREEN		LED	120/277V	5	ISOLITE (UEL) SURE-LITES (SCX) EXITRONIX (S900U)
(E2A)	DESCRIPTION: EXIT SIGN, EDGE LIT, DOUBLE SIDED MOUNTING: CEILING FINISH: SCBA OPTICS: OPTRONIX (EM, EMERGENCY TRANSFER)	LENGTH: 11" WIDTH: 3" HEIGHT: 10"			GREEN		LED	120/277V	5	ISOLITE (UEL) SURE-LITES (SCX) EXITRONIX (S900UM)
(E3A)	DESCRIPTION: EDGE LIT, SINGLE SIDED MOUNTING: WALL FINISH: SCBA OPTICS: USER/ARCHITECT TO CHOOSE CUSTOM WORDING ON SIGN EM: NONE	LENGTH: 13" WIDTH: 3" HEIGHT: 10"			SCBA		LED	120/277V	5	ISOLITE (TLG2) EVENLITE (SOVCGH) EXITRONIX (402EX)
(LP8)	DESCRIPTION: CYLINDRICAL PENDANT MOUNTING: PENDANT FINISH: SCBA OPTICS: EM: NONE	LENGTH: 72" DIAMETER: 3.5"	3,144		4000K	90	LED (0-10V DIMMING) 1%	120/277V	36	CORONET (FLRD) LUMINII (SCT-JOIN-HR) AYO (OPT)
(LP10)	DESCRIPTION: CYLINDRICAL PENDANT MOUNTING: PENDANT FINISH: SCBA OPTICS: EM: NONE	LENGTH: 120" DIAMETER: 3.5"	5,240		4000K	90	LED (0-10V DIMMING) 1%	120/277V	60	CORONET (FLRD) LUMINII (SCT-JOIN-HR) AYO (OPT)
(LR4)	DESCRIPTION: FLUSH LENS LINEAR MOUNTING: GRID CEILING, RECESSED FINISH: SCBA OPTICS: EM: NONE	LENGTH: 48" WIDTH: 3" HEIGHT: 4"	2,400		4000K	80	LED (0-10V DIMMING) 1%	120/277V	26	MARK (SL2L) NEORAY (S122DR) BETACALCO (BLKR)
(LR4T)	DESCRIPTION: FLUSH LENS LINEAR MOUNTING: GRID CEILING, RECESSED FINISH: SCBA OPTICS: EM: EMERGENCY TRANSFER	LENGTH: 48" WIDTH: 3" HEIGHT: 4"	2,400		4000K	80	LED (0-10V DIMMING) 1%	120/277V	26	MARK (SL2L) NEORAY (S122DR) BETACALCO (BLKR)
(LR6)	DESCRIPTION: FLUSH LENS LINEAR MOUNTING: GRID CEILING, RECESSED FINISH: SCBA OPTICS: EM: NONE	LENGTH: 72" WIDTH: 3" HEIGHT: 4"	3,600		4000K	80	LED (0-10V DIMMING) 1%	120/277V	40	MARK (SL2L) NEORAY (S122DR) BETACALCO (BLKR)
(LR6T)	DESCRIPTION: FLUSH LENS LINEAR MOUNTING: GRID CEILING, RECESSED FINISH: SCBA OPTICS: EM: EMERGENCY TRANSFER	LENGTH: 72" WIDTH: 3" HEIGHT: 4"	3,600		4000K	80	LED (0-10V DIMMING) 1%	120/277V	40	MARK (SL2L) NEORAY (S122DR) BETACALCO (BLKR)
(LR8)	DESCRIPTION: FLUSH LENS LINEAR MOUNTING: GRID CEILING, RECESSED FINISH: SCBA OPTICS: EM: NONE	LENGTH: 96" WIDTH: 3" HEIGHT: 4"	4,800		4000K	80	LED (0-10V DIMMING) 1%	120/277V	53	MARK (SL2L) NEORAY (S122DR) BETACALCO (BLKR)
(LR8T)	DESCRIPTION: FLUSH LENS LINEAR MOUNTING: GRID CEILING, RECESSED FINISH: SCBA OPTICS: EM: EMERGENCY TRANSFER	LENGTH: 96" WIDTH: 3" HEIGHT: 4"	4,800		4000K	80	LED (0-10V DIMMING) 1%	120/277V	53	MARK (SL2L) NEORAY (S122DR) BETACALCO (BLKR)
(LR10)	DESCRIPTION: FLUSH LENS LINEAR MOUNTING: RECESSED FINISH: SCBA OPTICS: EM: NONE	LENGTH: 120" WIDTH: 2" HEIGHT: 4"	4,630		4000K	80	LED (0-10V DIMMING) 1%	120/277V	50	PAL (MLR2) NEORAY (S122DR) BETACALCO (BLKR)
(S21Z)	DESCRIPTION: INDOOR WHITE LIGHT TAPE MOUNTING: MOUNTING CLIP WITH WHITE ROUND LENS FINISH: SCBA OPTICS: EM: NONE	LENGTH: 252" WIDTH: 5"	2,100		4000K	80	LED (0-10V DIMMING)	120/277V	96	KELVIX (LN1-WL) QT (SW-HE24/1.5) OMNILIGHT (GENESIS 2.0)
(T14)	DESCRIPTION: VOLUMETRIC TROFFER MOUNTING: GRID CEILING FINISH: SCBA OPTICS: EM: NONE	LENGTH: 48" WIDTH: 12" HEIGHT: 4"	4,000		4000K	80	LED (0-10V DIMMING) 1%	120/277V	39	LITHONIA (ALL4) CORELITE (D3X) DAY-BRITE (1CAX)
(T22)	DESCRIPTION: VOLUMETRIC TROFFER MOUNTING: GRID CEILING, RECESSED FINISH: SCBA OPTICS: EM: NONE	LENGTH: 24" WIDTH: 24" HEIGHT: 4"	2,000		4000K	80	LED (0-10V DIMMING) 1%	120/277V	17	LITHONIA (2ALL2) CORELITE (D3X) DAY-BRITE (CAX)
(T22T)	DESCRIPTION: VOLUMETRIC TROFFER MOUNTING: GRID CEILING, RECESSED FINISH: SCBA OPTICS: EM: EMERGENCY TRANSFER	LENGTH: 24" WIDTH: 24" HEIGHT: 4"	2,000		4000K	80	LED (0-10V DIMMING) 1%	120/277V	17	LITHONIA (2ALL2) CORELITE (D3X) DAY-BRITE (CAX)
(T24)	DESCRIPTION: VOLUMETRIC TROFFER MOUNTING: GRID CEILING, RECESSED FINISH: SCBA OPTICS: EM: NONE	LENGTH: 48" WIDTH: 24" HEIGHT: 4"	4,000		4000K	80	LED (0-10V DIMMING) 1%	120/277V	32	LITHONIA (2ALL4) CORELITE (D3X) DAY-BRITE (CAX)
(WM14)	DESCRIPTION: 14" CIRCLE MOUNTING: WALL FINISH: SCBA OPTICS: EM: NONE	HEIGHT: 3" DIAMETER: 14"	1,490		4000K	90	LED (0-10V DIMMING) 1%	120/277V	16	BROWNLEE (PENNY-ID) PRUDENTIAL LTG (GAZE-RDS) LIGHTNET (1B)

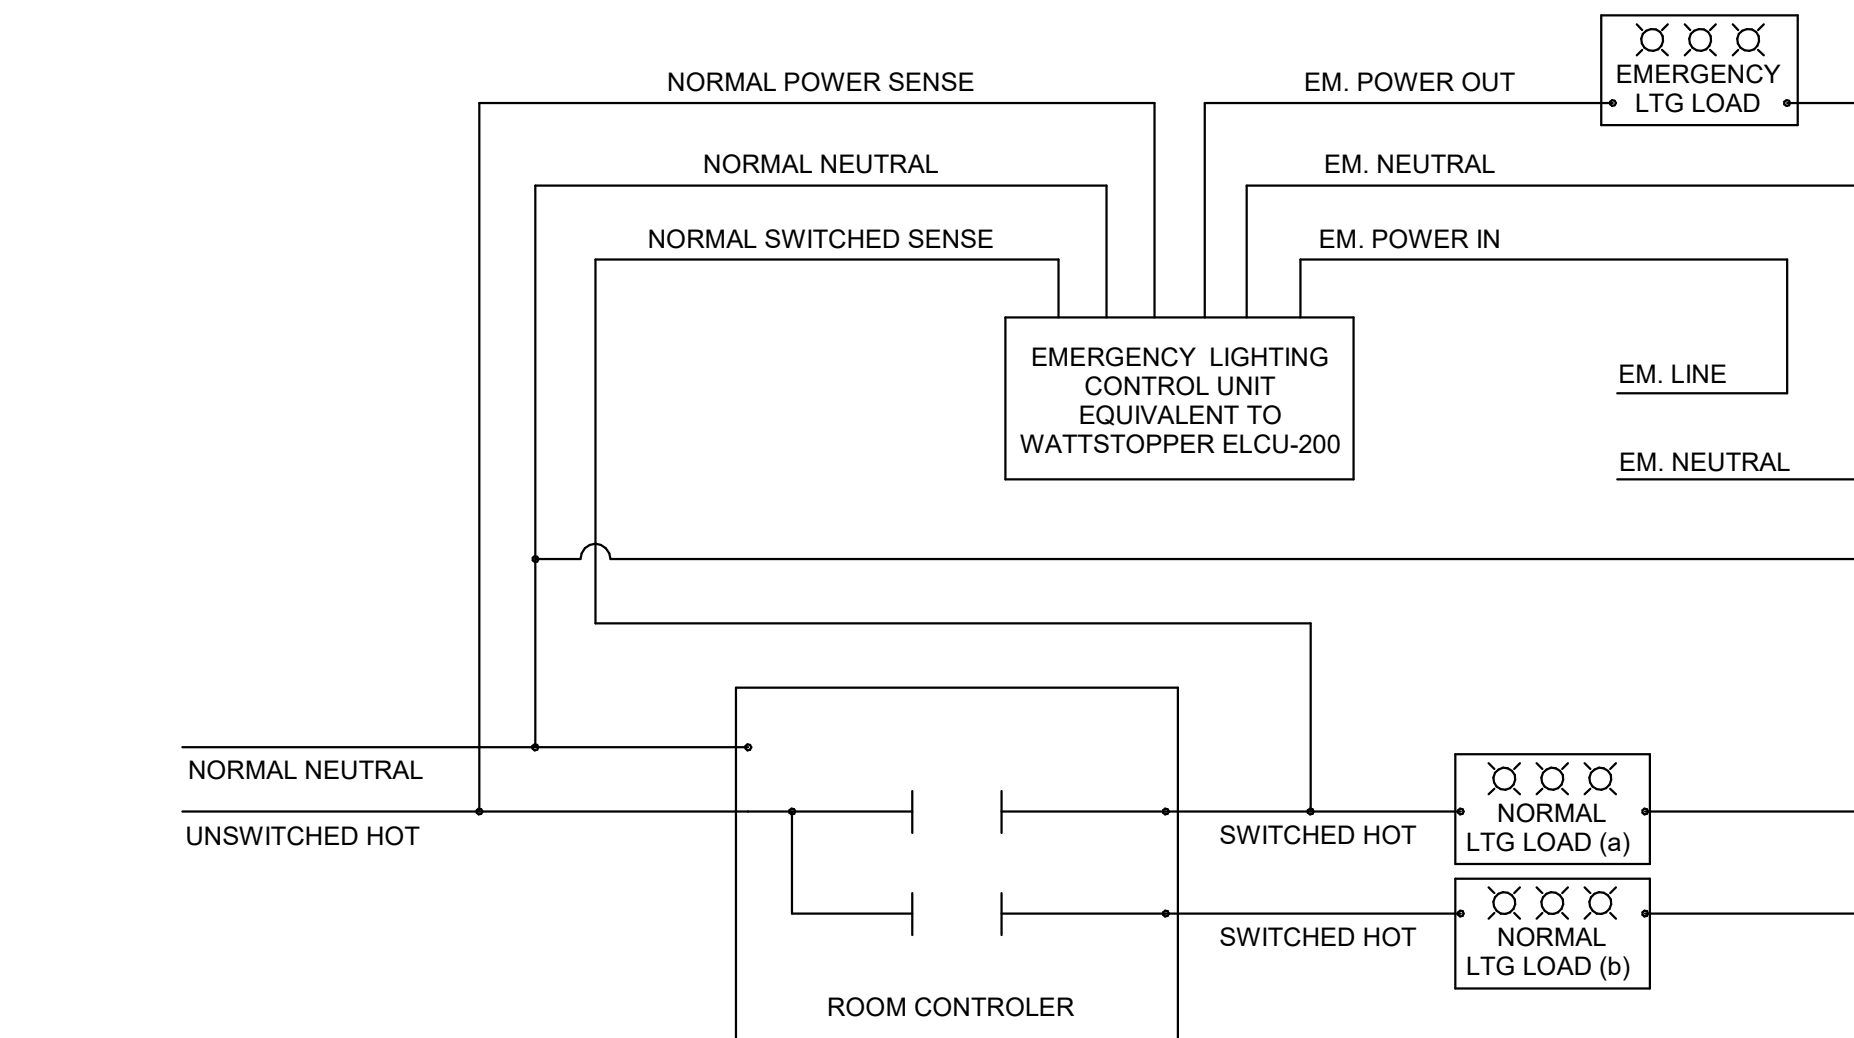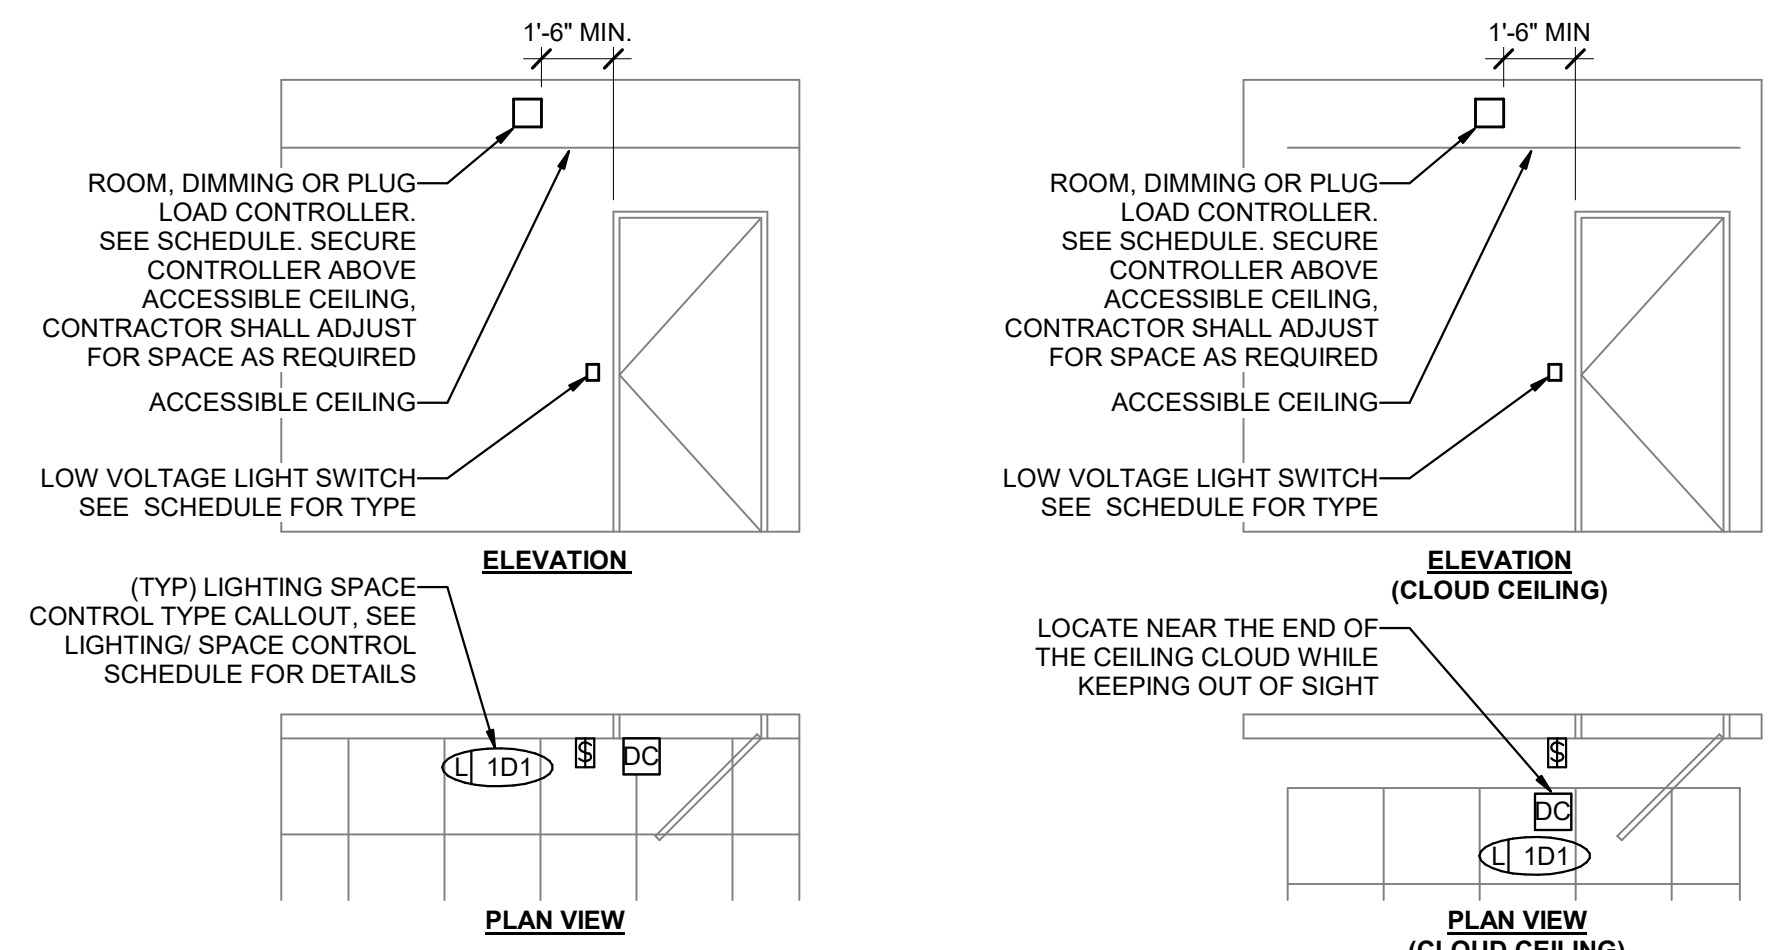

*BASIS OF DESIGN IS WATTSTOPPER
**CONTRACTOR IS RESPONSIBLE TO PROVIDE FULLY FUNCTIONAL EQUIVALENT SYSTEMS TO WHAT IS INDICATED HERE.

1 TYPICAL ROOM CONTROLLER MOUNTING DETAILS
SCALE: NTS

2 TYPICAL EMERGENCY LIGHTING TRANSFER DEVICE DETAIL
SCALE: NTS

GENERAL SHEET NOTES


- 1 FIRE ALARM NOTIFICATION DEVICES SHALL BE ADJUSTED AS REQUIRED TO PROVIDE PROPER COVERAGE AND SOUND LEVELS.
- 2 ALL FIRE ALARM DEVICES SHALL BE MOUNTED SUCH THAT THEY ARE VISIBLE FROM THE GROUND AND EASILY ACCESSIBLE FOR MAINTENANCE.
- 3 TYPICAL: CORRIDOR SMOKE DETECTOR SPACING SHALL NOT EXCEED 30FT ON CENTER.
- 4 ALL PATHWAYS FOR LOW VOLTAGE CABLING NOT REQUIRED TO BE IN CONDUITS SHALL BE ROUTED IN J-HOOK PATHWAYS. CONCEAL ALL PATHWAYS ABOVE ACCESSIBLE CEILING SPACES. DO NOT RUN CABLES IN EXPOSED AREAS. WHERE CONCEALMENT IS NOT POSSIBLE IN EXPOSED AREAS, CONTRACTOR SHALL PROVIDE CONDUIT TO ROUTE CABLING WHERE VISIBLE. ALL CONDUIT SHALL BE PAINTED TO MATCH CEILING AND PROVIDED WITH PROTECTIVE BUSHINGS.

331 S RIO GRANDE ST
SUITE 307
SLC, UT 84101
PH: 8013640503

SPECTRUM
ENGINEERS
324 S. State St., Suite 400
Salt Lake City, UT 84111
800-878-7077
801-328-5151
fax: 801-328-5155
www.spectrum-engineers.com



10.30.2024

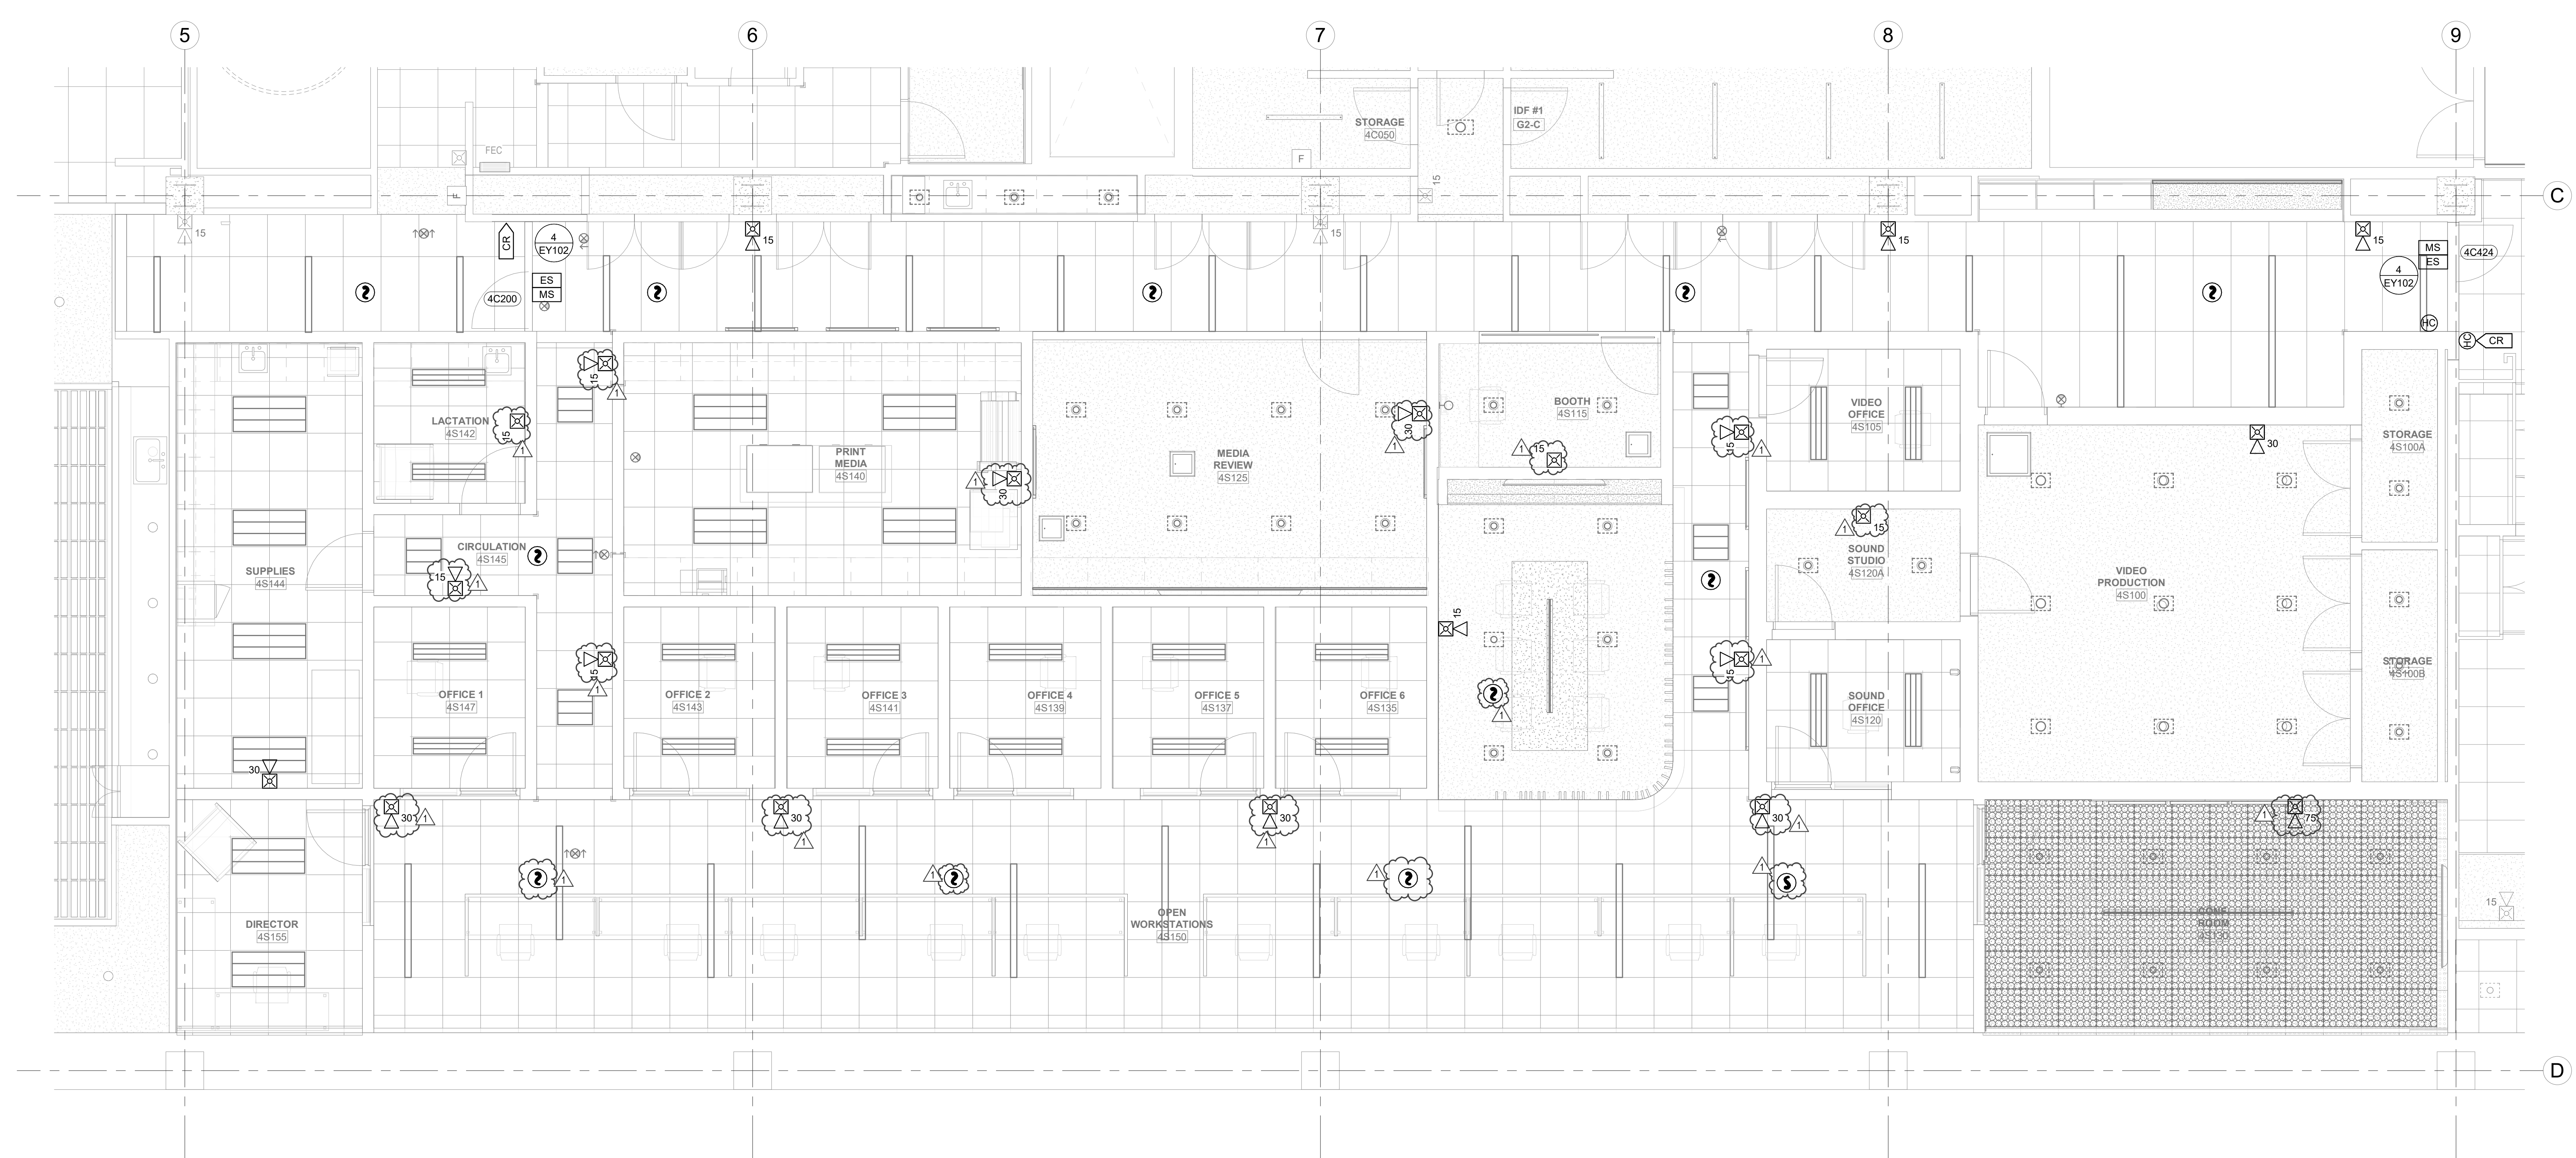

**GENETIC SCIENCE
LEARNING CENTER**

CONSTRUCTION DOCUMENTS

No.	Description	Date
1	Addendum 1	12/20/2024




GLSC
295 CHIPETA WAY
SALT LAKE CITY, UT 84108

22812
10.30.2024


FOURTH FLOOR
AUXILIARY PLAN

EY101
Scale 1/4" = 1'-0"


1 FOURTH FLOOR AUXILIARY PLAN
SCALE: 1/4" = 1'-0"

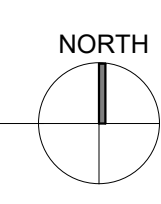

Autodesk Docs://UU - Genetic Science Learning Center Remodel /240335-Elec Central.rvt
12/19/2024 2:37:51 PM

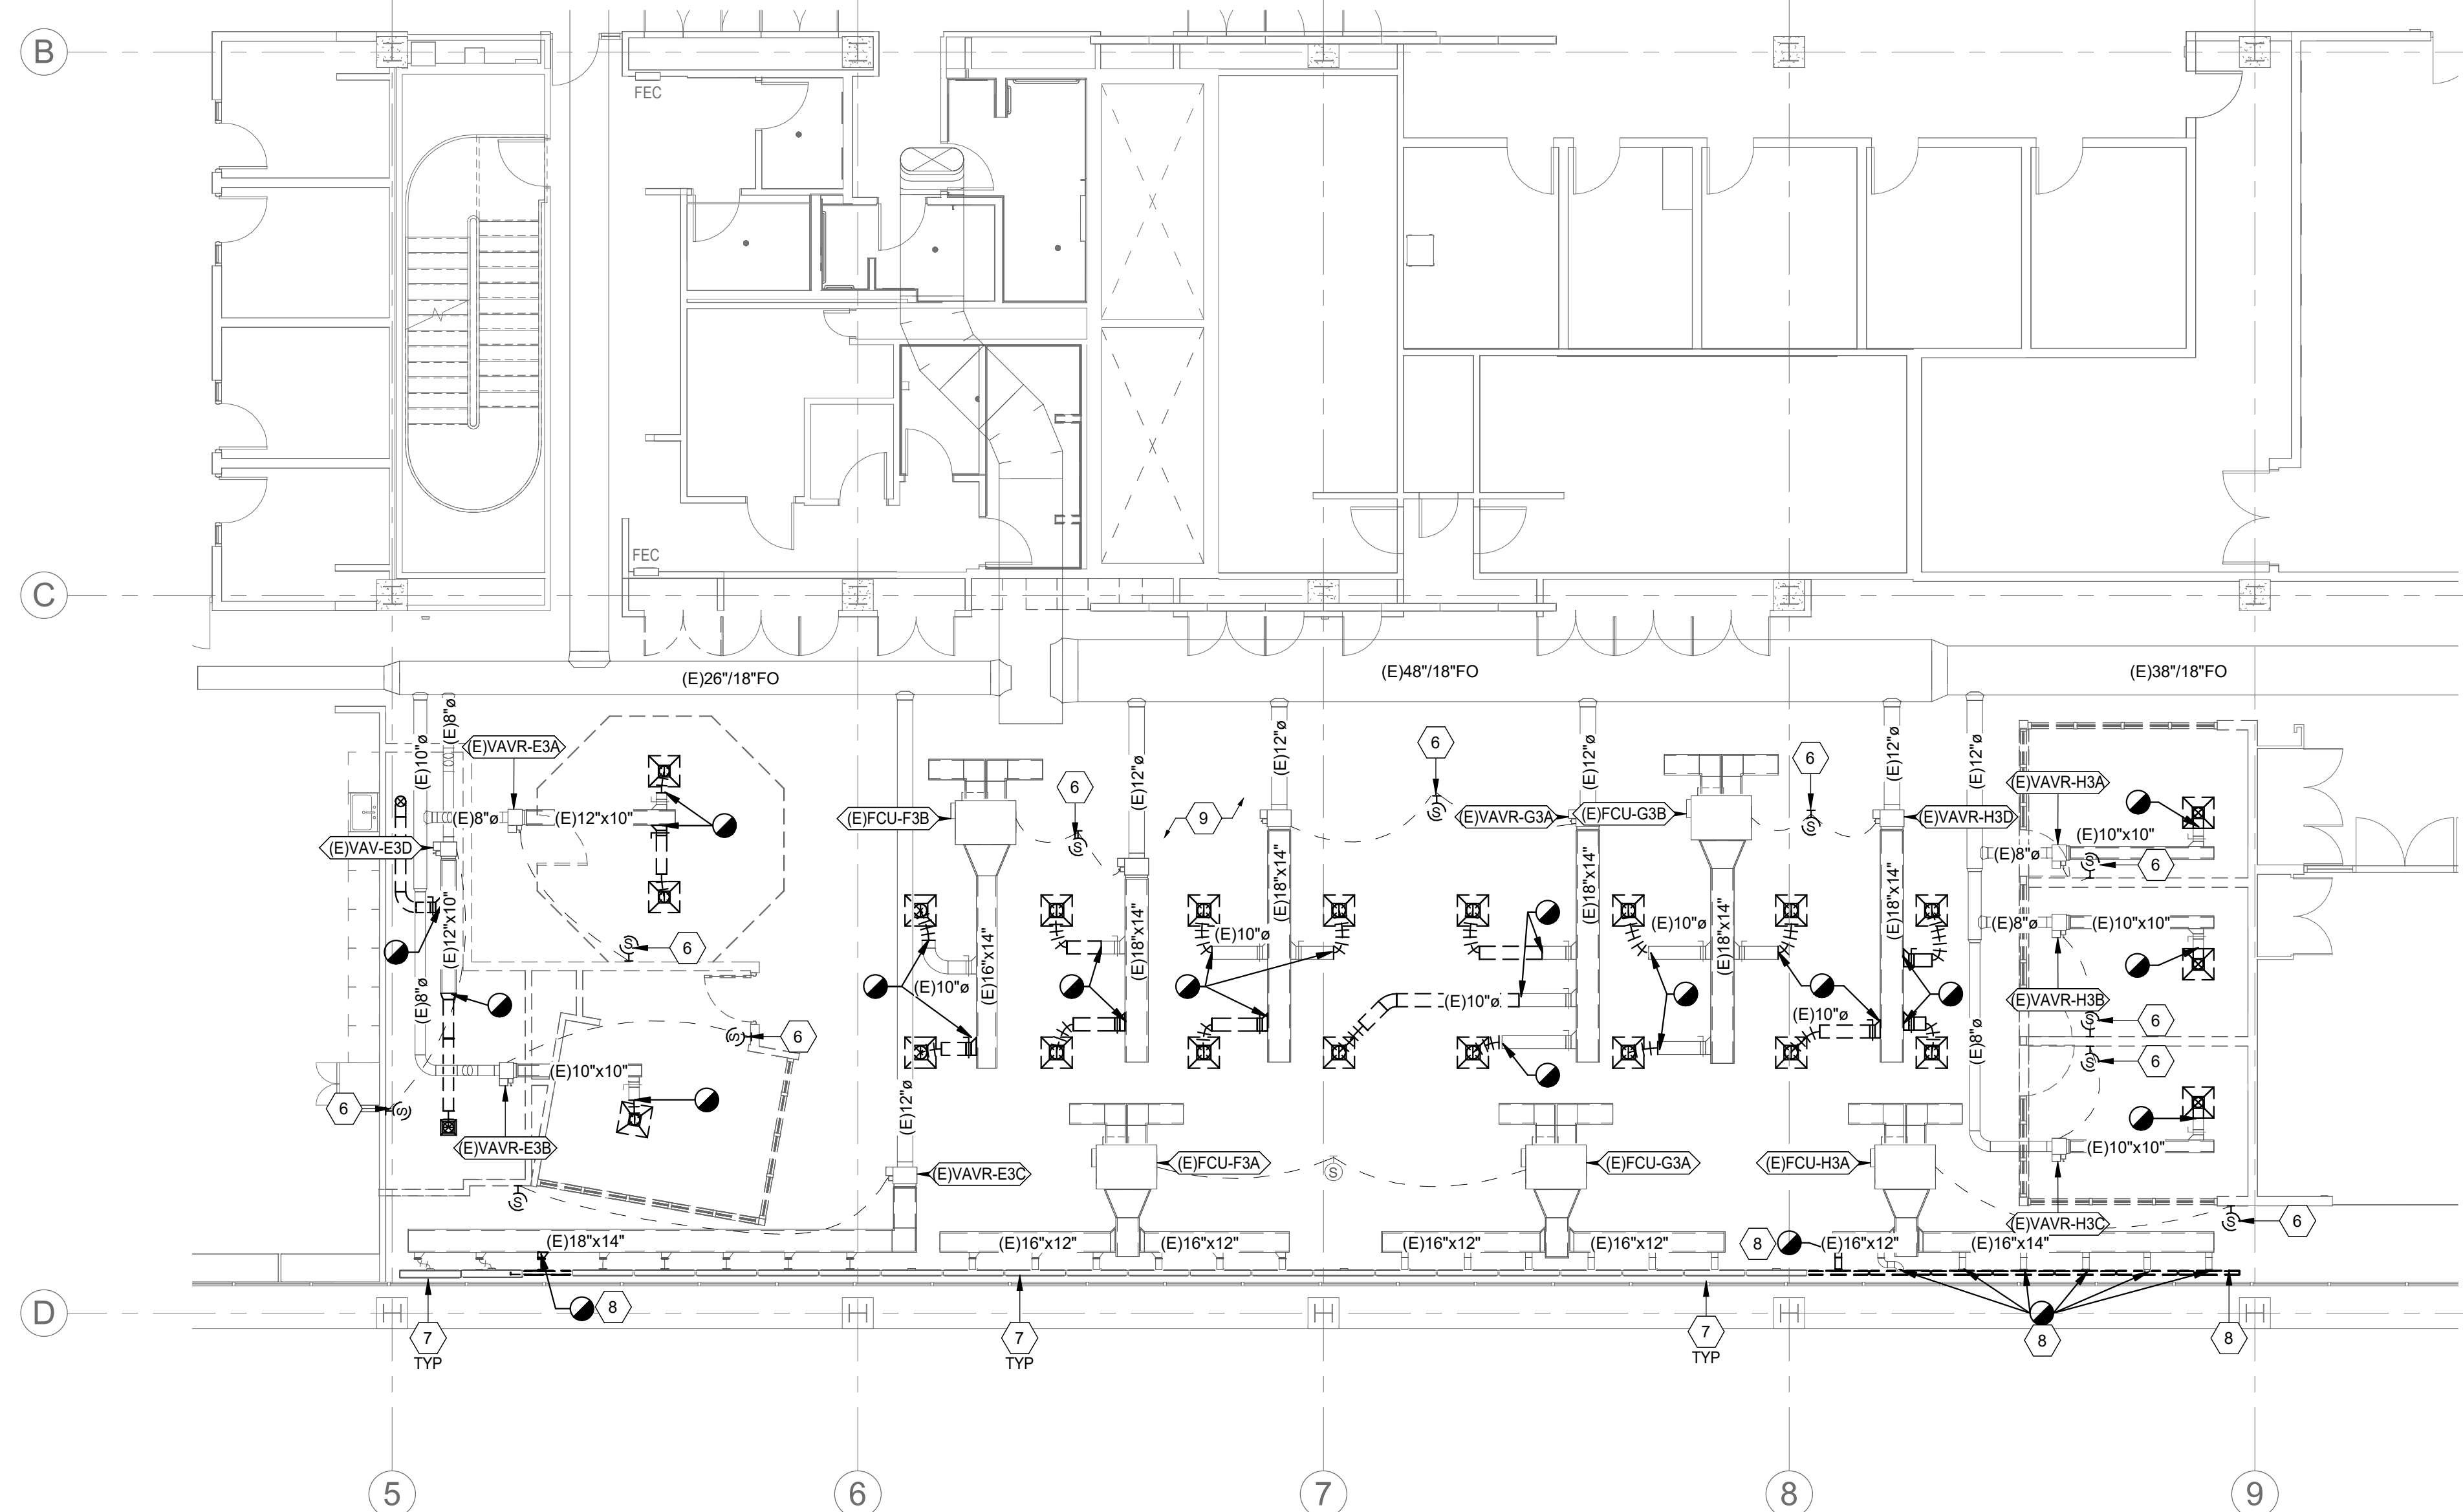

2 LEVEL 4 MECHANICAL DEMOLITION PLAN
SCALE: 1/8" = 1'-0"

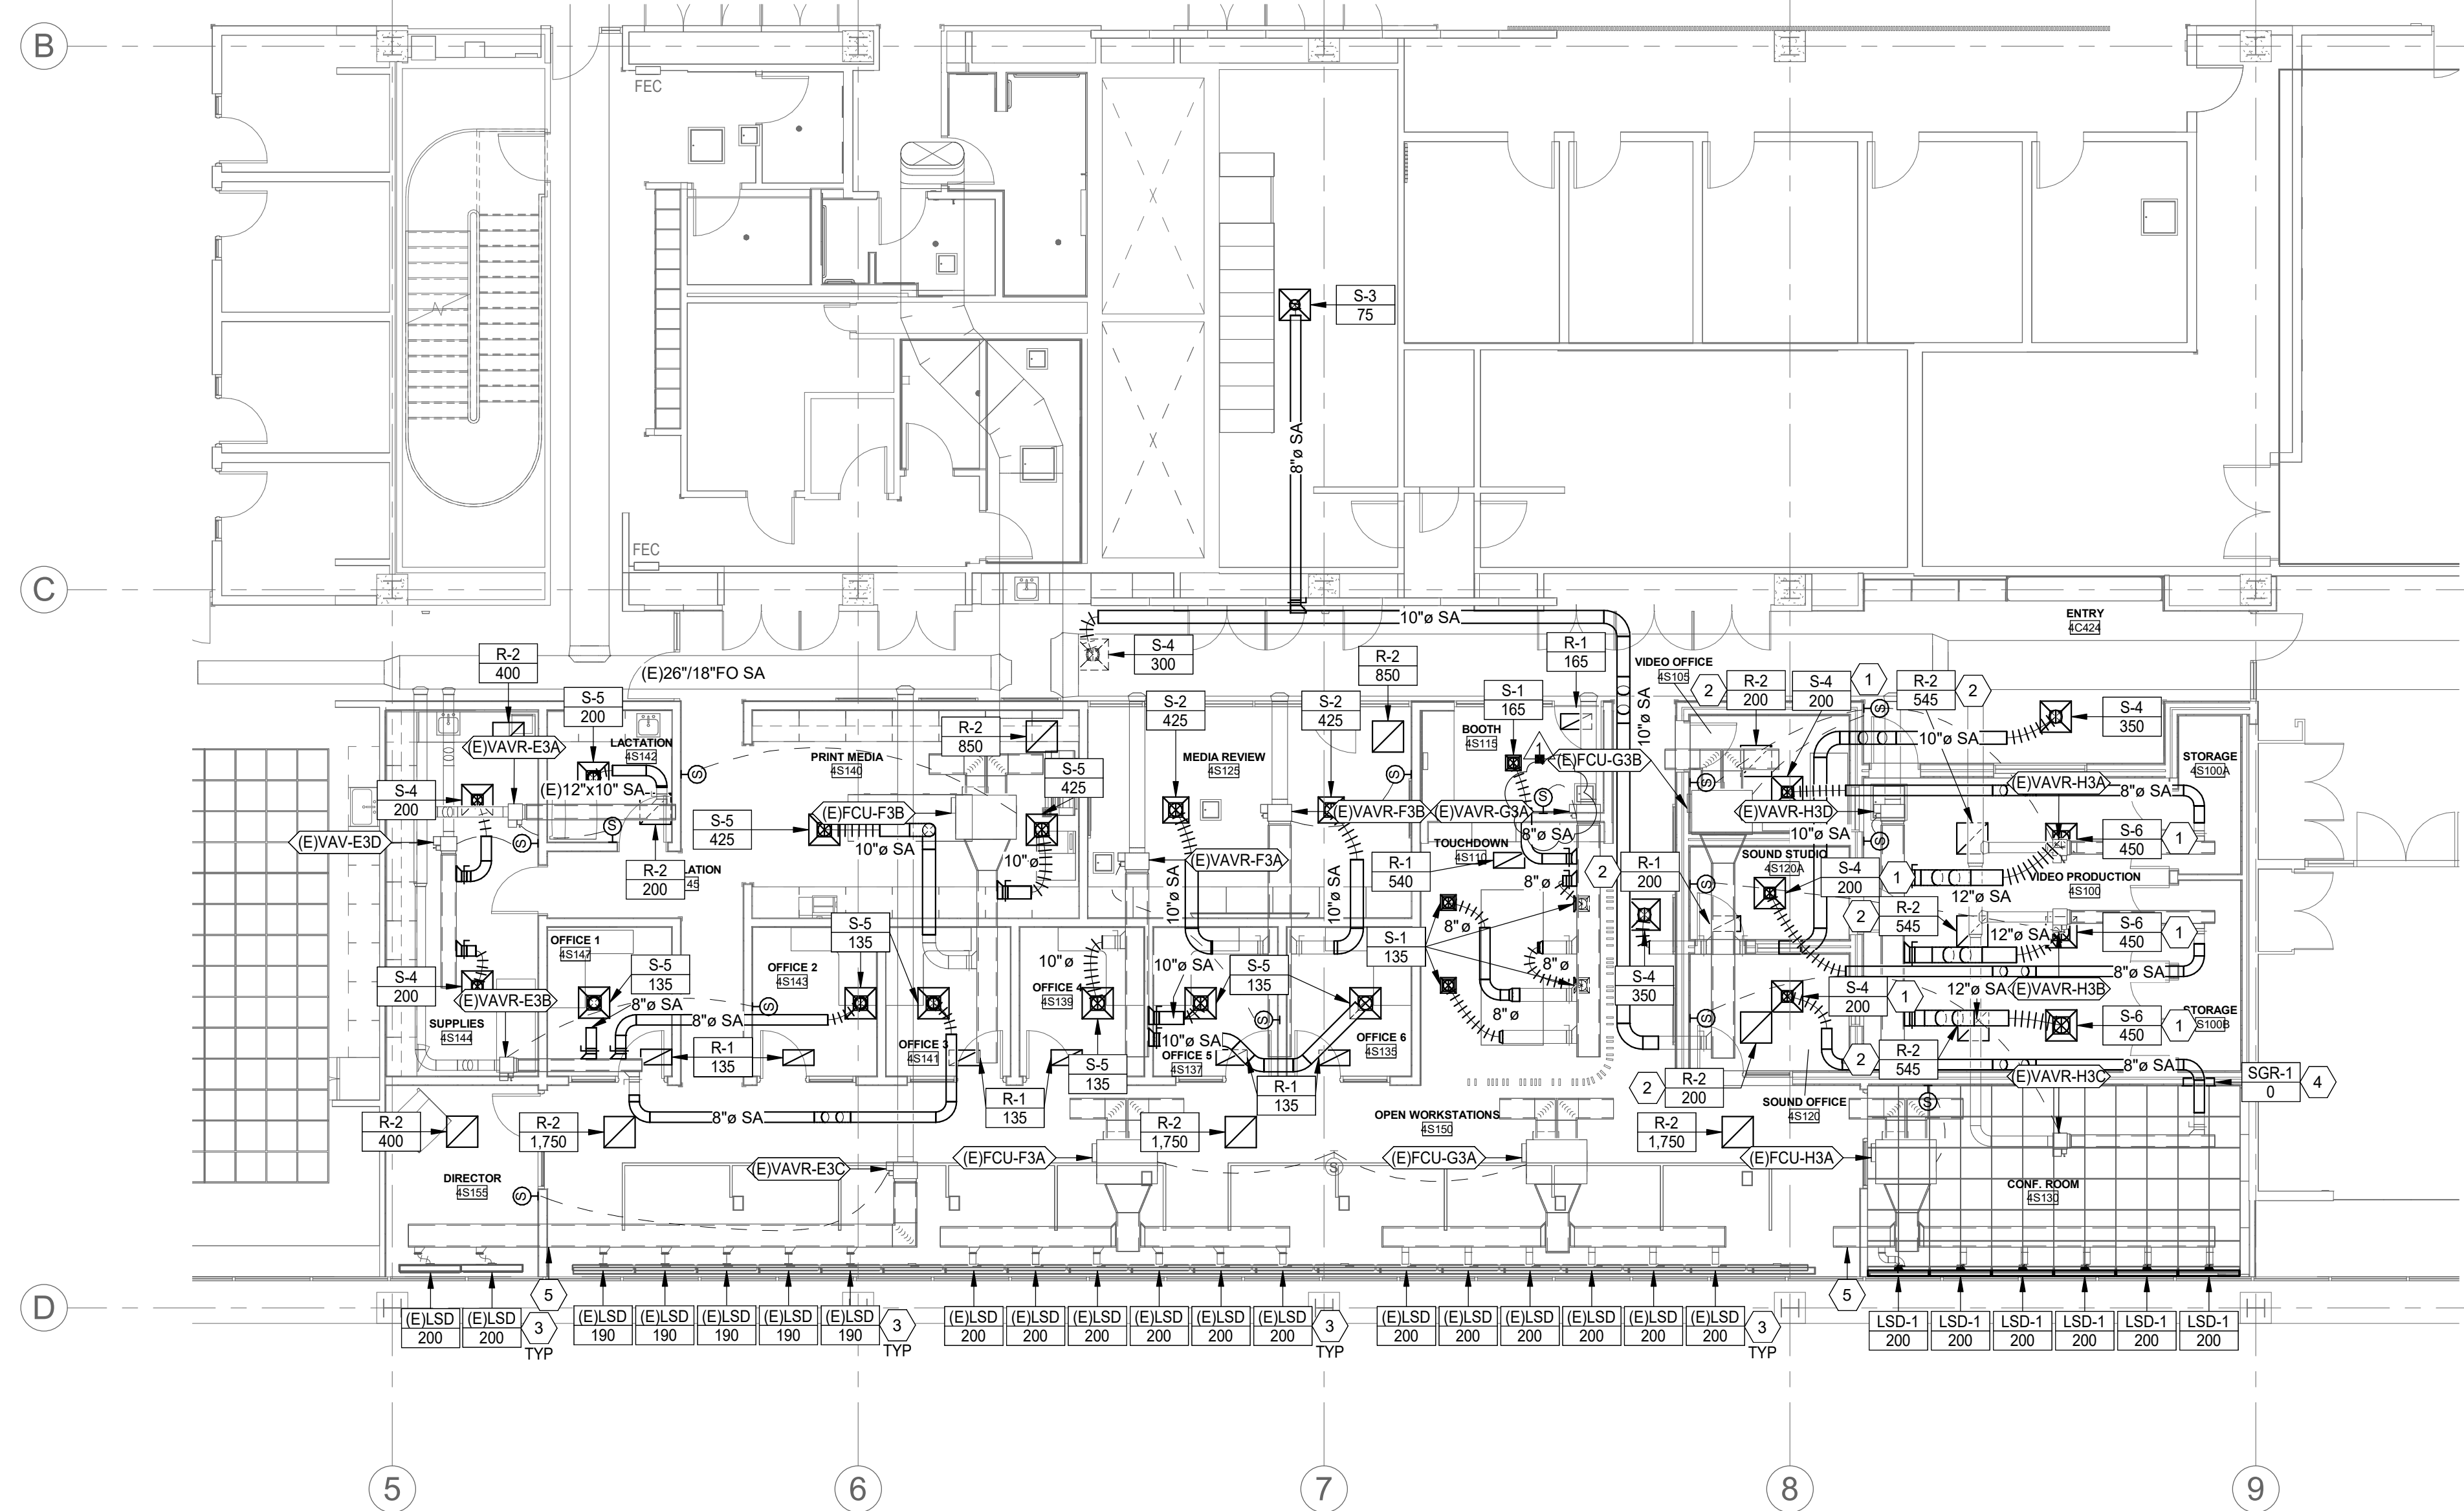

1 LEVEL 4 MECHANICAL PLAN
SCALE: 1/8" = 1'-0"


GENERAL SHEET NOTES

- MECHANICAL GENERAL NOTES:**
- THIS CONTRACTOR SHALL CLOSELY COORDINATE MECHANICAL AND PLUMBING WITH ELECTRICAL, ARCHITECTURAL, AND BUILDING STRUCTURE.
 - ALL LOW PRESSURE RECTANGULAR DUCTWORK TO BE LINED WITH INSULATION WITH AN R-VALUE OF R-6. ALL LOW PRESSURE ROUND DUCTWORK TO BE WRAPPED WITH INSULATION WITH AN R-VALUE OF R-6.
 - ALL MEDIUM PRESSURE DUCTWORK TO BE LINED WITH PERFORATED INTERIOR DUCTWORK. NO DUCT LINER IN OUTSIDE AIR DUCTWORK OR DUCTWORK WITH IN DUCT HUMIDIFIERS.
 - ALL DUCT DIMENSIONS ARE INSIDE CLEAR DIMENSIONS.
 - FLEXIBLE DUCT MAY BE USED AT FINAL TERMINATION OF DUCT TO DIFFUSER OR GRILLE. MAXIMUM FLEXIBLE DUCT LENGTH IS 5'-0". PROVIDE DUCT SUPPORTS EVERY 3 FEET. FLEX DUCT SHALL NOT BE COMPRESSED OR KINKED BY ANY OBJECTS SUCH AS STRUCTURE, PIPING, ETC.
 - GRILLES AND DUCTWORK ARE SIZED INDEPENDENTLY. THE NECK SIZE OF GRILLES MAY NOT MATCH THE ASSOCIATED DUCT SIZE. PROVIDE TRANSITION TO GRILLES AS NECESSARY.
 - PROVIDE BALANCING DAMPER WITH LOCKING QUADRANT IN EACH DUCT BRANCH OF SUPPLY AND EXHAUST DUCTWORK.
 - PROVIDE REMOTE CABLE OPERATED DAMPER SYSTEM FOR ALL DUCTWORK ABOVE HARD LID CEILINGS OR WHERE DAMPER IS INACCESSIBLE OR PROVIDE OPPOSED BLADE DAMPER WITH NYLON BUSHINGS AT GRILLE.
 - PROVIDE ACCESS DOORS FOR ALL SERVICEABLE EQUIPMENT OR VALVES ABOVE HARD LID CEILINGS OR IN WALLS. ALL ACCESS PANELS ARE TO BE PAINTED TO MATCH ADJACENT SURFACES.
 - GC TO HIRE NEBB OR AABC CERTIFIED THIRD PARTY TEST AND BALANCE (TAB) CONTRACTOR. TAB CONTRACTOR SHALL ADJUST SHEAVES, BELTS, DAMPERS, ETC AS NECESSARY TO BALANCE SYSTEM TO AIRFLOWS REQUIRED AT LOWEST POSSIBLE SPEEDS. TAB CONTRACTOR SHALL VERIFY THE OUTSIDE AIR AT EACH RTU IS AS SCHEDULED. FOLLOW PROCEDURES AS LAID FORTH IN THE CURRENT VERSION OF "PROCEDURAL STANDARDS FOR TESTING ADJUSTING AND BALANCING OF ENVIRONMENTAL SYSTEMS" BY NEBB. PROVIDE REPORT ON NEBB FORMS TO ENGINEER FOR REVIEW.
 - ALL MATERIALS WITHIN PLENUMS SHALL BE NONCOMBUSTIBLE OR SHALL BE LISTED AND LABELED AS HAVING A FLAME SPREAD INDEX OF NOT MORE THAN 25 AND A SMOKE DEVELOPED INDEX OF NOT MORE THAN 50 WHEN TESTED IN ACCORDANCE WITH ASTM E 84 OR UL 723.
 - THIS CONTRACTOR SHALL ENGAGE A FIRE PROTECTION DESIGN BUILD CONTRACTOR TO MODIFY THE EXISTING FIRE SPRINKLER SYSTEM. DESIGNER SHALL BE NICET LEVEL III TECHNICIAN. WORKING PLANS AND CALCULATIONS SHALL BE PREPARED ACCORDING TO NFPA 13, AND BE APPROVED BY AUTHORITIES HAVING JURISDICTION, INCLUDING HYDRAULIC CALCULATIONS IF APPLICABLE.
 - PROVIDE NEW QUICK RESPONSE FIRE SPRINKLER HEADS IN ALL AREAS OF WORK. SPRINKLER HEADS TO BE ON FLEXIBLE BRAIDED STAINLESS DROPS. SPRINKLER HEAD TO BE CENTER IN HALF OF TILE.
 - CONTROLS TO MATCH EXISTING JOHNSON METASYS CONTROLS. TIE INTO EXISTING JOHNSON CONTROLS DDC SYSTEM AND UPDATED GRAPHICS. PROVIDE ENGINEER WITH 2 WEEKS OF TRENDS SHOWING PROPER OPERATION OF EQUIPMENT UPON COMPLETION OF PROJECT. TRENDS DATA SHALL INCLUDE THE FOLLOWING DATA AT A MINIMUM: SPACE TEMPERATURE, SPACE SET POINT, HEATING OR COOLING MODE, AIR FLOW (FOR VAV SYSTEMS), & VALVE POSITION (FOR VAV SYSTEMS). SEE SEQUENCE OF OPERATIONS AND CONTROLS REQUIREMENTS ON SCHEDULE SHEETS/SPECIFICATIONS.
 - COORDINATE EXACT THERMOSTAT LOCATIONS WITH FURNITURE AND OWNER. FAILURE TO DO SO MAY REQUIRE MOVING THERMOSTATS AT CONTRACTORS COST.
 - ALL CONTROLS WIRING SHALL BE INSTALLED IN RACEWAYS AND BE THE RESPONSIBILITY OF THE CONTROLS CONTRACTOR. RACEWAYS SHALL CONFORM TO THE FOLLOWING SPECIFICATIONS: HANGERS AND SUPPORTS FOR ELECTRICAL SYSTEMS, RACEWAYS AND BOXES FOR ELECTRICAL SYSTEMS AND SEISMIC CONTROLS FOR ELECTRICAL SYSTEMS.
 - CONTRACTOR SHALL FIELD VERIFY EXISTING FIELD CONDITIONS PRIOR TO ORDERING OR FABRICATING. ADDITIONAL COST WILL NOT BE ALLOWED FOR CONTRACTOR'S FAILURE TO BECOME FAMILIAR WITH EXISTING SITE CONDITIONS.
 - PROVIDE SOUND BOOT ON ALL RETURN GRILLES. SOUND BOOT TO BE SHEET METAL WITH ACOUSTICAL DUCT LINER. DUCT BOARD IS NOT AN APPROVED MATERIAL FOR SOUND BOOT. SOUND BOOT DETAIL.
 - GENERAL CONTRACTOR SHALL HIRE A 3RD PARTY COMMISSIONING AGENT TO COMMISSION NEW HVAC EQUIPMENT. COMMISSIONING AGENT SHALL BE LICENSED MECHANICAL ENGINEER. COMMISSIONING AGENT TO PROVIDE COMMISSIONING PLAN LISTING EQUIPMENT AND TEST TO BE PERFORMED TO ENGINEER FOR REVIEW. COMMISSIONING AGENT SHALL PROVIDE REPORT STATING ANY SYSTEM DEFICIENCIES AND LISTING ANY DEFERRED TESTS.
 - PROVIDE OPERATION AND MAINTENANCE MANUALS (O&M) WITHIN 30 DAYS OF CERTIFICATE OF OCCUPANCY FOR ALL EQUIPMENT IN DIGITAL FORMAT TO ENGINEER FOR REVIEW. O&M SHALL INCLUDE DOCUMENTATION OF ALL WARRANTIES, REPORTS AND TESTS, RECORD DRAWINGS, CONTROLS SEQUENCE OF OPERATIONS WITH DIAGRAMS, & EQUIPMENT INFORMATION. EQUIPMENT INFORMATION INCLUDES MAKE & MODEL, WIRING, PIPING, STARTUP, SHUTDOWN, TROUBLE SHOOTING SYSTEM BALANCING REPORT, FINAL COMMISSIONING REPORT AND MAINTENANCE PROCEDURES.
 - PIPING AND DUCTWORK SHALL NOT BE SUPPORTED FROM THE ROOF DECK, JOIST BRIDGING OR OTHER PIPES. HANG PIPES FROM BEAMS, JOIST OR SUPPLEMENTARY STRUCTURAL MEMBERS. WHERE POSSIBLE INSTALL ALL PIPING AND DUCTWORK WITHIN 12" FROM SUPPORTING STRUCTURE.
 - WHERE JURISDICTION REQUIRES, CONTRACTOR IS RESPONSIBLE FOR PROVIDING SEISMIC RESTRAINT AND SUPPORT ENGINEERED BY A LICENSED STRUCTURAL ENGINEER. PROVIDE DESIGN DRAWINGS TO AUTHORITY HAVING JURISDICTION AND MECHANICAL ENGINEER FOR REVIEW.

SHEET KEYNOTES

- GRILLES AND DIFFUSERS SELECTED FOR A MAXIMUM NC OF 15 FOR SPECIFIED AIRFLOW.
- PROVIDE EXTENDED SOUND BOOT ON RETURN GRILLE.
- REUSE EXISTING LINEAR SLOT DIFFUSER. SHIFT TO MATCH NEW CEILING GRID.
- LOW SIDEWALL RETURN. USE WALL CAVITY FOR RETURN AIR PATH UP TO CEILING PLENUM. MAINTAIN A MINIMUM FREE AREA IN WALL OF 8'X24" UP TO CEILING PLENUM.
- CAP DUCT IN THIS APPROXIMATE LOCATION.
- REMOVE EXISTING SENSOR/THERMOSTAT AND PROVIDE NEW.
- EXISTING LINEAR SLOT DIFFUSER TO BE REMOVED, CLEANED, AND REINSTALLED.
- DEMOLISH EXISTING LINEAR SLOT DIFFUSER.
- DEMOLISH EXISTING DIFFUSERS AND GRILLES IN THIS AREA UNLESS NOTED OTHERWISE.

331 S RIO GRANDE ST
SUITE 307
SLC, UT 84101
PH: 8017395569
BHV.EEG@STUDIOLPARCH.COM

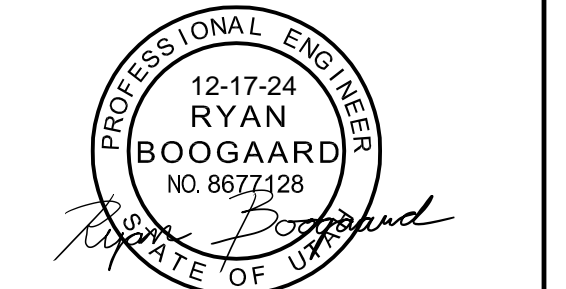

**GENETIC SCIENCE
LEARNING CENTER**

CONSTRUCTION DOCUMENTS

No	Description	Date
1	ADDENDUM 1	12/20/24




GSLC
295 CHIPETA WAY
SALT LAKE CITY, UT 84108

22812
10.30.2024

LEVEL 4
MECHANICAL
PLAN

MH101
Scale As indicated



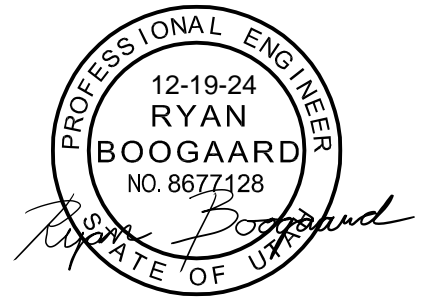

CONSTRUCTION DOCUMENTS

DCM SEAL

No	Description	Date
1	ADDENDUM 1	12/20/24




GSLC
295 CHIPETA WAY
SALT LAKE CITY, UT 84108


22812
10.30.2024

MECHANICAL
DETAILS


ME501
Scale 1/8" = 1'-0"

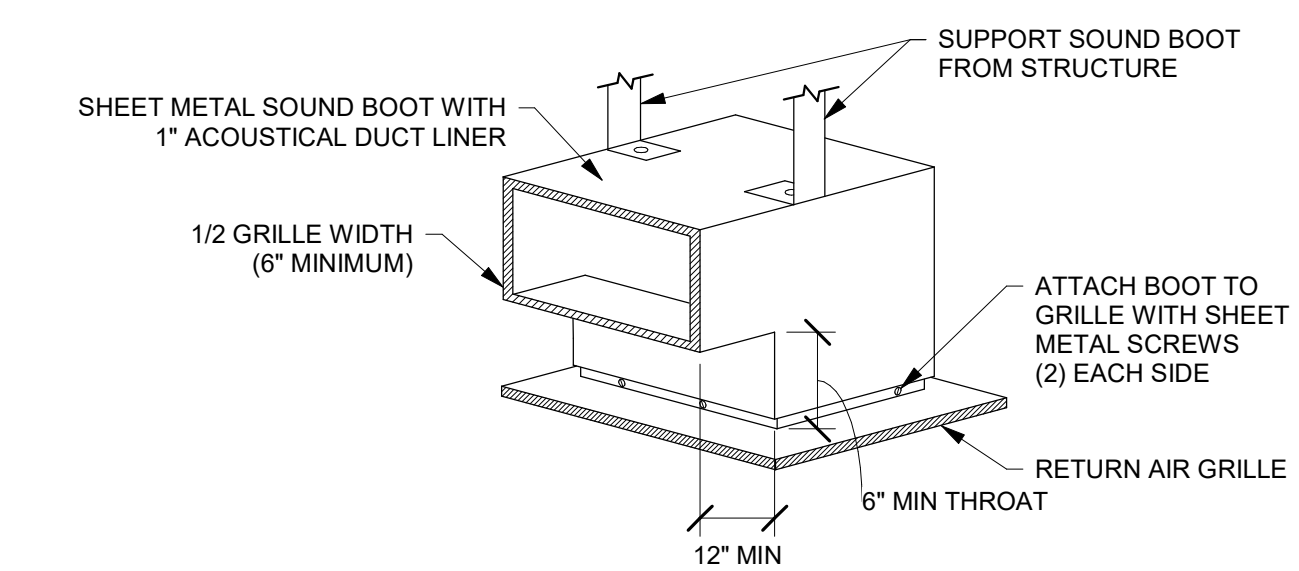


5 RETURN AIR GRILLE WITH SOUND BOOT
SCALE: 1/8" = 1'-0"

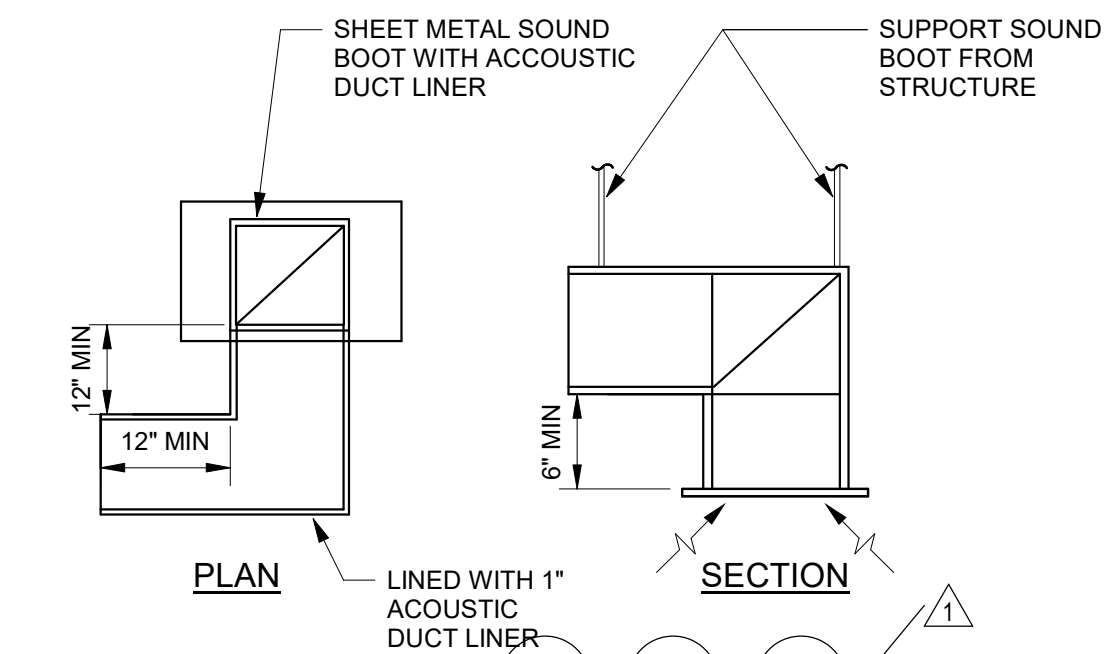


4 R.A. GRILLE WITH EXTENDED SOUND BOOT
SCALE: 1/8" = 1'-0"

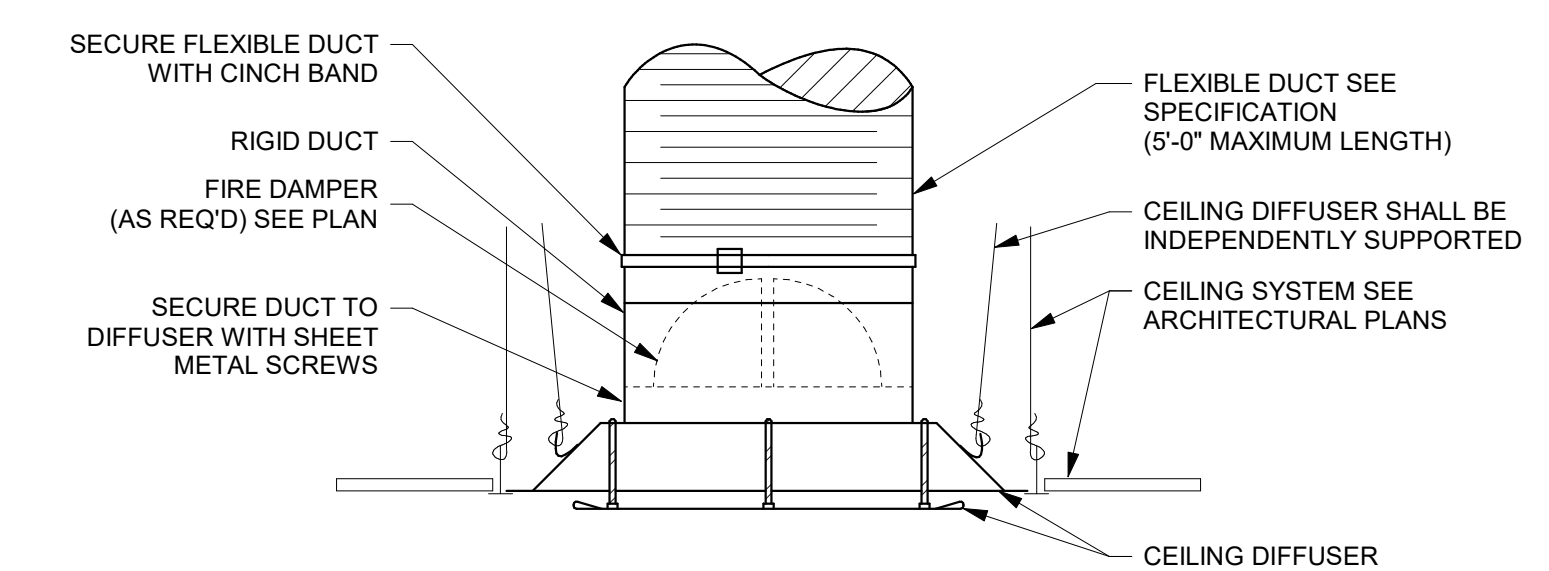

3 CEILING DIFFUSER DETAIL
SCALE: 1/8" = 1'-0"

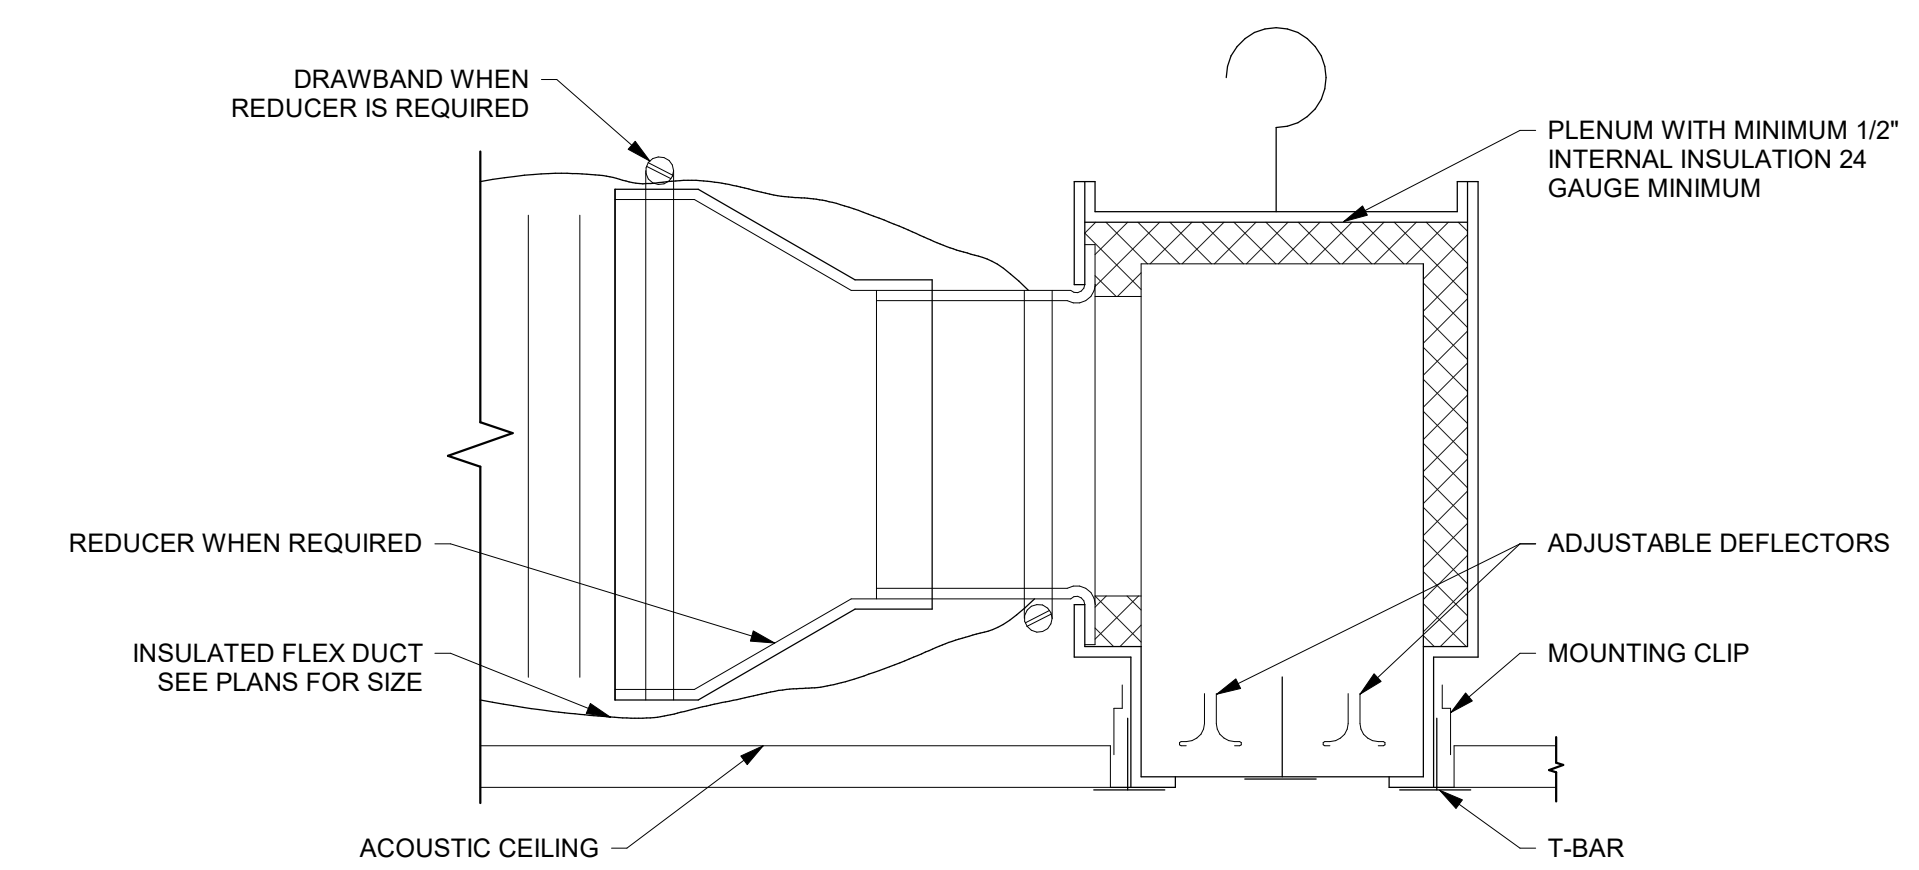

2 LINEAR SLOT DIFFUSER DETAIL
SCALE: 1/8" = 1'-0"

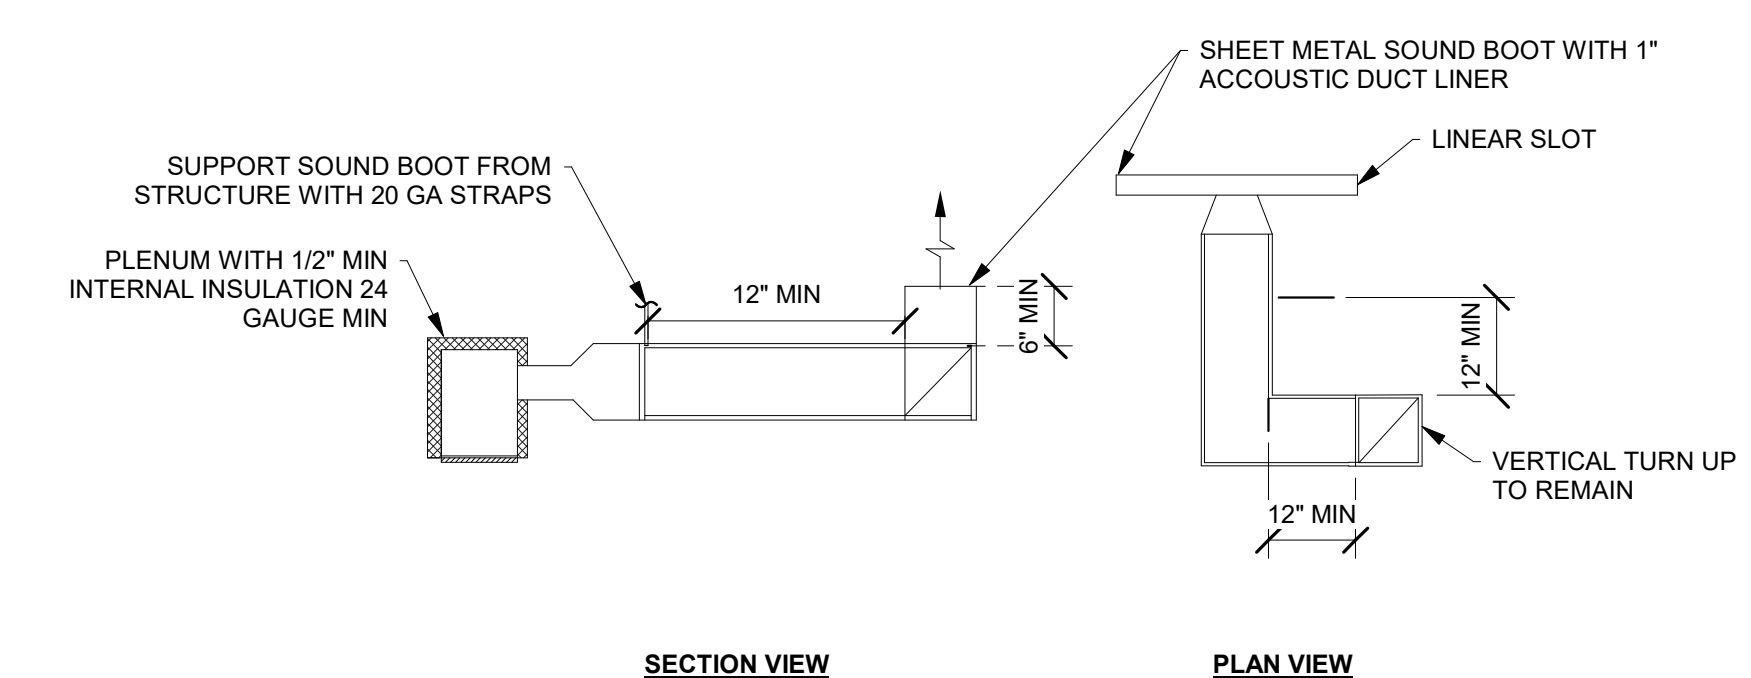

1 LINEAR SLOT RETURN BOOT DETAIL
SCALE: 1/8" = 1'-0"